

July 14, 2025

PROJECT NAME: MULTI-FAMILY - 37 LAUREL PASS

PROJECT NUMBER: 2025030061

APPLICATION: MINOR SITE PLAN #32644

1 DEPARTMENT: ZONE - ZONING DEPARTMENT

REVIEW ITEM: 2.12.6 - Location of water and sewer. Does this need a special use permit? Verify if in primary springs protection zone. Will it need an enhanced septic system?

STATUS OF REVIEW: INFO

REMARKS: Within City of Bellevue service area.

2 DEPARTMENT: ZONE - ZONING DEPARTMENT

REVIEW ITEM: 2.12.32 - Modified environmental assessment or exemption if information is available to the county to indicate no habitat or existence of endangered species or vegetation (Article 6, Division 5, Sec. 6.5.4)

STATUS OF REVIEW: INFO

REMARKS: Initial Review: Provide an environmental assessment consistent with LDC Div. 6.5; or provide a brief exemption request letter consistent with LDC Sec. 6.5.3

6/23/25: Submitted and transmitted to FWC

3 DEPARTMENT: ZONE - ZONING DEPARTMENT

REVIEW ITEM: 4.4.4 - Sign (provisions for advertising signage), if it is a multi occupancy complex like shopping centers they must submit a master sign plan.

STATUS OF REVIEW: INFO

REMARKS: Initial review: Will there be an on-site sign?

6/23/25: No sign proposed by applicant. Otherwise, separate sign permit will be required

4 DEPARTMENT: ENGIN - DEVELOPMENT REVIEW

REVIEW ITEM: 2.12.4.K - List of approved waivers, conditions, date of approval

STATUS OF REVIEW: INFO

REMARKS: 3/25/25-add waivers if requested in future

5 DEPARTMENT: DOH - ENVIRONMENTAL HEALTH

REVIEW ITEM: Additional Health comments

STATUS OF REVIEW: INFO

REMARKS: Central Sewer/Central Water

6 DEPARTMENT: LSCAPE - LANDSCAPE DESIGN AND IRRIGATION

REVIEW ITEM: 2.12.25 - Marion Friendly Landscape Areas

STATUS OF REVIEW: INFO

REMARKS: MFLA not required on this site

7 DEPARTMENT: LSCAPE - LANDSCAPE DESIGN AND IRRIGATION

REVIEW ITEM: 6.7.4 - Shade tree requirements

STATUS OF REVIEW: INFO

REMARKS: No shade tree requirement on this site

8 DEPARTMENT: LSCAPE - LANDSCAPE DESIGN AND IRRIGATION

REVIEW ITEM: 6.8.7 - Parking areas and vehicular use areas

STATUS OF REVIEW: INFO

REMARKS: due to OHE, understory trees used in terminus island

- 9 DEPARTMENT: LSCAPE - LANDSCAPE DESIGN AND IRRIGATION
REVIEW ITEM: 6.8.11 - Landscape installation
STATUS OF REVIEW: INFO
REMARKS: All Landscape to be installed by landscape contractors licensed by Marion County Building Dept, or the State of Florida
- 10 DEPARTMENT: LSCAPE - LANDSCAPE DESIGN AND IRRIGATION
REVIEW ITEM: Additional Landscape comments
STATUS OF REVIEW: INFO
REMARKS: What is sight line triangle shown through part of terminus island?
- 11 DEPARTMENT: LUCURR - LAND USE CURRENT REVIEW
REVIEW ITEM: 2.12.4.L(6) - Gross/wetland/floodplain acreage listed?
STATUS OF REVIEW: INFO
REMARKS: Not in flood zone.
- 12 DEPARTMENT: ENRAA - ACQ AGENT ENG ROW
REVIEW ITEM: Minor Site Plan
STATUS OF REVIEW: INFO
REMARKS: IF APPLICABLE:
Sec. 2.18.1.I - Show connections to other phases.
Sec.2.19.2.H – Legal Documents
Legal documents such as Declaration of Covenants and Restrictions, By-Laws, Articles of Incorporation, ordinances, resolutions, etc.
Sec. 6.3.1.B.1 – Required Right of Way Dedication (select as appropriate)
For Public Streets. "[All streets and rights-of-way shown on this plat or name specifically if less than all] are hereby dedicated for the use and benefit of the public."
Sec. 6.3.1.B.2 – Required Right of Way Dedication
For Non-Public Streets. "[All streets and rights-of-way shown on this plat or name specifically if less than all] are hereby dedicated privately to the [entity name]. All public authorities and their personnel providing services to the subdivision are granted an easement for access. The Board of County Commissioners of Marion County, Florida, shall have no responsibility, duty, or liability whatsoever regarding such streets. Marion County is granted an easement for emergency maintenance in the event of a local, state, or federal state of emergency wherein the declaration includes this subdivision or an emergency wherein the health, safety, or welfare of the public is deemed to be at risk."
Sec. 6.3.1.D.3 - Cross Access Easements
For Cross Access Easements. "All parallel access easements shown on this plat are hereby dedicated for the use and benefit of the public, and maintenance of said easements is the responsibility of [entity name]."
Sec. 6.3.1.C.1 - Utility Easements (select as appropriate)
"[All utility easements shown or noted or name specifically if less than all] are dedicated [private or to the public] for the construction, installation, maintenance, and operation of utilities by any utility provider."
Sec. 6.3.1.C.2 – Utility Easements
"[All utility tracts or identify each tract as appropriate] as shown are dedicated [private or to the public] for the construction and maintenance of such facilities."
Sec.6.3.1.D(c)(1)(2)(3) - Stormwater easements and facilities, select as appropriate:
1 "[All stormwater and drainage easements as shown or noted or name specifically if less than all] are dedicated [private or to the public] for the construction and maintenance of such facilities."
2. "[All stormwater management tracts or identify each tract as appropriate] as shown are dedicated [private or to the public] for the construction and maintenance of such facilities."
3. When any stormwater easement and/or management tract is not dedicated to the public or Marion County directly, the following statement shall be added to the dedication language: "Marion County is granted the

right to perform emergency maintenance on the [stormwater easement and/or management tract, complete accordingly] in the event of a local, state, or federal state of emergency wherein the declaration includes this subdivision or an emergency wherein the health, safety, or welfare of the public is deemed to be at risk."

Sec.6.3.1.D(f) –

If a Conservation Easement is required the following shall be provided: "A conservation easement [as shown or on tract and identify the tract, complete accordingly] is dedicated to [the Board of County Commissioners of Marion County, Florida or entity name, if not Marion County] for the purpose of preservation of [listed species, habitat, Karst feature and/or native vegetation, complete accordingly]."

13 DEPARTMENT: ZONE - ZONING DEPARTMENT

REVIEW ITEM: 2.20.2.B - \$150.00 Minor Site Plan fee payable to Marion County BCC effective July 8, 2019

STATUS OF REVIEW: NO

REMARKS: Initial Review: Provide \$150.00 for Growth Services' zoning review of minor site plan. This item will remain as [NO] until paid.

6/23/25: Not paid at this time

14 DEPARTMENT: ZONE - ZONING DEPARTMENT

REVIEW ITEM: 2.12.24 - Landscape requirements, (buffering) 6.8.6

STATUS OF REVIEW: NO

REMARKS: Initial review: Show required buffer areas labeled by type and dimensions. ROW buffers are not required for Juniper or Laurel Pass because they are classified as local roads. Buffers are not required between Multiple Family uses. Type A Buffer is required adjacent to the existing/vacant commercial properties. Refer to LDC Sec. 6.8.6 for Type A standards and other land use buffer information. Applicant may request a waiver to provide modified buffers or ask for exemption.

6/23/25: Buffers included. Will there be any garbage collection areas? Outdoor AC equipment indicated. In either case, buffering/screening shall be provided per LDC Sec. 6.8.9. Please indicate.

15 DEPARTMENT: ENGTRF - TRAFFIC REVIEW

REVIEW ITEM: 6.12.12 - Sidewalks

STATUS OF REVIEW: NO

REMARKS: 6/27/25 - Sidewalk fee in-lieu-of construction requires a DRC waiver. Contact OCE Customer Service (352) 671-8686 to schedule DRC review.

4/7/25 Sidewalks are required along Laurel Pass and Juniper Rd. Staff supports a waiver for sidewalks along Laurel Pass and a waiver for fee-in-lieu of construction along Juniper Rd. If approved, waiver for fee-in-lieu of construction comes out to \$5,000.00.

16 DEPARTMENT: 911 - 911 MANAGEMENT

REVIEW ITEM: 6.2.1.F - North arrow and graphic drawing and written scale

STATUS OF REVIEW: NO

REMARKS: New Sheet TDC_LE_37LP_IR-01 is missing the North Arrow and Scale.

17 DEPARTMENT: LSCAPE - LANDSCAPE DESIGN AND IRRIGATION

REVIEW ITEM: 6.8.6 - Buffers

STATUS OF REVIEW: NO

REMARKS: 1. Type C buffers are required along roadways (Juniper Rd and Laurel Pass), please show on plan 2. If shade trees will conflict with OHE, evergreen understory trees may be used on a 1:1 basis. 3. Pine trees in buffers and near structures are not recommended, due to issues as they mature. Please consider alternative canopy trees.



**Marion County
Board of County Commissioners**

Office of the County Engineer

412 SE 25th Ave.
Ocala, FL 34471
Phone: 352-671-8686
Fax: 352-671-8687

AR 32644


DEVELOPMENT REVIEW COMMITTEE WAIVER REQUEST FORM

Date: 7/10/2025 Parcel Number(s): 9024-0541-01 Permit Number: 32644

A. PROJECT INFORMATION: Fill in below as applicable:

Project Name: Quadplex- 37 Laurel Pass Commercial ☐ Residential ☒
Subdivision Name (if applicable): _____
Unit _____ Block 541 Lot 1 Tract _____

B. PROPERTY OWNER'S AUTHORIZATION: The property owner's signature authorizes the applicant to act on the owner's behalf for this waiver request. The signature may be obtained by email, fax, scan, a letter from the property owner, or original signature below.

Name (print): Jorge Collado
Signature: 
Mailing Address: 5028 Saint Denis Ct City: Belle Isle
State: FL Zip Code: 32812 Phone # 407-575-8583
Email address: colladoworldwide@gmail.com

C. APPLICANT INFORMATION: The applicant will be the point of contact during this waiver process and will receive all correspondence.

Firm Name (if applicable): Linn Engineering and Design Contact Name: Chad Linn
Mailing Address: P.O. Box 140024 City: Orlando
State: FL Zip Code: 32814 Phone # 407-775-5194
Email address: clinn@linnengineering.com

D. WAIVER INFORMATION:

Section & Title of Code (be specific): _____ Section. 6.12.12- Sidewalks
Reason/Justification for Request (be specific): _____ Fee in lieu of construction

DEVELOPMENT REVIEW USE:

Received By: Email 7/11/25 Date Processed: 7/14/25 BM Project # 2025030061 AR # 32644

ZONING USE: Parcel of record: Yes ☐ No ☐ Eligible to apply for Family Division: Yes ☐ No ☐
Zoned: _____ ESOZ: _____ P.O.M. _____ Land Use: _____ Plat Vacation Required: Yes ☐ No ☐
Date Reviewed: _____ Verified by (print & initial): _____

MINOR SITE PLAN FOR QUAD PLEX

37 LAUREL PASS, OCALA, FLORIDA 34480

MARCH 2025


PARCEL ID# 9024-0541-01


SECTION 12, TOWNSHIP 16, RANGE 22

LEGAL DESCRIPTION
LOT 1 BLOCK 541 SILVER SPRINGS SHORES UNIT 24 ACCORDING TO THE PLAT THEREOF, AS RECORDED IN PLAT BOOK J, PAGE 188 OF THE PUBLIC RECORDS OF MARION COUNTY, FLORIDA.

FLOOD DISCLAIMER
BY PERFORMING A SEARCH WITH THE LOCAL GOVERNING MUNICIPALITY OR WWW.FEMA.GOV, THE PROPERTY APPEARS TO BE LOCATED IN ZONE X. THIS PROPERTY WAS FOUND IN MARION COUNTY UNINCORPORATED AREAS, COMMUNITY NUMBER 120160, PANEL 0735, SUFFIX D, DATED 08/28/2008.

I HEREBY CERTIFY THAT I, MY SUCCESSORS, AND ASSIGNS SHALL PERPETUALLY MAINTAIN THE IMPROVEMENTS AS SHOWN ON THIS PLAN


Signature
Date 6/16/2025
Jorge Collado
Owner
Name
Title

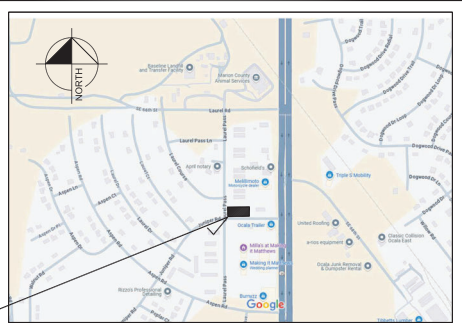

LOCATION MAP
NTS

SITE DATA:
PROJECT AREA: 0.457 AC
ZONING: R-3
FLU: UR
PROPOSE USE: MULTIFAMILY APARTMENTS
2,400 SF/FLOOR

ADJACENT PROPERTIES:

NORTH: R-3; FLU-UR
EAST: B-4; FLU-COM
SOUTH: ROW
WEST: ROW

SITE REQUIREMENTS:
MIN. LOT WIDTH: 100 FT
MIN. LOT AREA: 12,500 SF
MAX DENSITY: MAX. 16 UNITS/AC
MIN. 8 UNITS/AC

BUILDING SETBACKS:
FRONT (WEST)- 25 FT
SIDE (NORTH,SOUTH)- 8 FT SIDE
REAR (EAST)- 25 FT

LANDSCAPE BUFFERS:
FRONT (ROW)- 0 FT
SIDE (R-3,ROW)- 0 FT SIDE
REAR (B-4)- TYPE A 30 FT

PARKING REQUIREMENTS:
2 SPACE/ DWELLING UNIT
24 FT AISLE LENGTH; TWO WAY TRAFFIC; 90'
MIN. 9FT WIDE BY 18 FT LONG PARKING SPACE

UTILITY PROVIDERS
CITY OF BELLEVUE
5525 SE 119TH ST.
BELLEVUE, FL 34420
OFFICE: 352-245-7021

ENGINEER:
LINN ENGINEERING & DESIGN
P.O. BOX 140024
ORLANDO, FL 32814
CONTACT: CHAD S LINN, P.E.
PHONE: 407-775-5194
EMAIL: CLINN@LINNENGINEERING.COM
FL LIC. NO. 57524

SURVEYOR:
LYNX SURVEYING CORP.
302 LAUREL ROAD EAST UNIT 291
LAUREL, FL 34272
OFFICE: 833-721-2907
contact@lynxsurveyors.com

OWNER/APPLICANT:
IDEAL HOUSING INVESTMENTS LLC
JORGE COLLADO
ADDRESS: 5028 SAINT DENIS CT
BELLE ISLE, FL 32812
EMAIL: COLLADOWORLDWIDE@GMAIL.COM

13-May-25
LINN ENGINEERING & DESIGN
P.O. Box 148024, Orlando, FL 32814
Phone: 407-775-5194 • Fax: 407-775-2776
clinn@linnengineering.com • www.linnengineering.com

ITE Trip Generation Rates - 11th Edition
Pass-by rates from ITE Trip Generation Handbook - 2nd Edition

Description/ITE Code	Units	ITE Vehicle Trip Generation Rates								Units	Expected Units	
		(peak hours are for peak hour of adjacent street traffic unless highlighted)										
Apartment 220	DU	Weekday	AM	PM	Pass-By	AM In	AM Out	PM In	PM Out	Independent Variable	4.0	
		6.74	0.40	0.51		24%	76%	63%	37%	DU		
		Total Generated Trips				Total Distribution of Generated Trips						
		Daily	AM Hour	PM Hour	AM In	AM Out	Pass-By	PM In	PM Out	Pass-By		
		27	2	2	0	1	0	1	1	0		

NOTE
1. CONSTRUCTION MATERIALS QUALITY AND WORKMANSHIP SHALL BE IN ACCORDANCE WITH MARION COUNTY SPECIFICATIONS.
2. THE FOLLOWING PROPOSED FACILITIES SHOWN ON THE DEVELOPMENT PLANS ARE FOR REFERENCE PURPOSES ONLY AND EACH SHALL REQUIRE A SEPARATE BUILDING PERMIT. THE LIST INCLUDES, BUT IS NOT LIMITED TO: PROPOSED BUILDINGS, SANITARY LIFT STATIONS, LIGHT FIXTURES (POLES) THAT ARE INDEPENDENT FROM ANY BUILDING STRUCTURE, FENCES, GATES, MONUMENT SIGNS, DUMPSTER ENCLOSURES, AND DECORATIVE/RETAINING WALLS.
3. ANY PROPOSED ROADWAY LANE CLOSURE MUST BE SUBMITTED IN WRITING ACCOMPANIED BY A SPECIFIC NOT PLAN DETAILING THE SIGNAGE/DETOUR PLAN, DURATION OF THE ROAD CLOSURE, NOTIFICATION OF LOCAL EMERGENCY AND LAW ENFORCEMENT OFFICES, NOTIFICATION OF ORANGE COUNTY PUBLIC INFORMATION OFFICE AND ALL AFFECTED LOCAL RESIDENTS MUST BE NOTIFIED OF THE ROAD IN ADVANCE PRIOR TO THE BEGINNING OF ANY CONSTRUCTION ACTIVITY WITHIN THE ROADWAYS. ALL ROADWAY LANE CLOSURE MUST BE DONE IN STAGES WHEREIN ONLY SECTIONS OF ANY COUNTY ROAD WILL BE CLOSED AT A TIME. THIS IS TO KEEP EMERGENCY VEHICLES ROAD ACCESSIBILITY IMPACT TO A MINIMUM.

I HEREBY CERTIFY THAT THESE PLANS AND CALCULATIONS WERE COMPLETED IN ACCORDANCE WITH ALL APPLICABLE REQUIREMENTS OF THE MARION COUNTY LAND DEVELOPMENT CODE (LDC), EXCEPT AS WAIVED

CALL 48 HOURS BEFORE YOU DIG



IT'S THE LAW!
DIAL 811

Know what's below.
Call before you dig.

SUNSHINE STATE ONE CALL OF FLORIDA, INC.

DATE
03/25
PROJECT NO.
36300-25-200
SHEET NUMBER
C01

MINOR SITE PLAN- QUAD PLEX
37 LAUREL PASS
OCALA, FL 34480
MARION COUNTY
FLORIDA

COVER SHEET

DESIGNED BY SAT
DRAWN BY SAT
CHECKED BY CSL
SCALE(S) NOTED
DESIGN ENGINEER
CHAD S. LINN, P.E.
FLORIDA REGISTRATION NUMBER
57524
SEAL
LINN ENGINEERING & DESIGN, INC.
P.O. BOX 140024
ORLANDO, FL 32814
PHONE: 407-775-5194
CLINN@LINNENGINEERING.COM
CA LIC. NO. 17110
REVISED PER ISO/COUNTY COMMENTS
DATE
BY


GENERAL NOTES:

1. LOCATIONS, ELEVATIONS, AND DIMENSIONS OF EXISTING UTILITIES, STRUCTURES AND OTHER FEATURES ARE SHOWN ACCORDING TO THE BEST INFORMATION AVAILABLE AT THE TIME OF PREPARATION OF THESE PLANS. THE EXISTING UTILITY INFORMATION SHOWN IS BASED ON THE BOUNDARY & TOPOGRAPHIC SURVEY PROVIDED BY ERDO SURVEYING GROUP. ALL EXISTING UTILITIES HAVE BEEN FIELD VERIFIED AT ALL POINTS OF CONNECTION AND ARE OF INTEREST.
2. PRIOR TO THE INITIATION OF SITE CONSTRUCTION, THE CONTRACTOR SHALL VERIFY ANY EXISTING UTILITIES IDENTIFIED BY THE BOUNDARY & TOPOGRAPHIC SURVEY, COMMUNICATIONS, SANITARY SEWERS AND STORM DRAINAGE SYSTEMS, ON AND/OR ADJACENT TO THE SITE, REMOVE OR CAP AS NECESSARY.
3. THE CONTRACTOR IS RESPONSIBLE FOR REMEDYING ANY DAMAGE TO EXISTING FACILITIES, ABOVE OR BELOW GROUND, THAT MAY OCCUR AS A RESULT OF THE WORK PERFORMED, BY THE CONTRACTOR OR SUB-CONTRACTORS, AS CALLED FOR IN THESE CONTRACT DOCUMENTS.
4. IF IT IS THE CONTRACTOR'S RESPONSIBILITY TO RECOVER FAMILIAR WITH THE POINT AND INSPECTION REQUIREMENTS SPECIFIED BY THE VARIOUS GOVERNMENT AGENCIES AND THE ENGINEER, THE CONTRACTOR SHALL OBTAIN ALL NECESSARY PERMITS PRIOR TO CONSTRUCTION, AND SCHEDULE INSPECTIONS ACCORDING TO AGENCY REQUIREMENTS.
5. THE CONTRACTOR SHALL SUBMIT SHOP DRAWINGS, ON ALL PRECAST AND MANUFACTURED ITEMS, TO THE OWNER'S ENGINEER FOR APPROVAL. FAILURE TO OBTAIN APPROVAL, BEFORE INSTALLATION, MAY RESULT IN REMOVAL AND REPLACEMENT AT THE CONTRACTOR'S EXPENSE.
6. ALL UTILITY SERVICE STOP-OUTS (WATER, SANITARY SEWER, ETC.) ARE TO BE INSTALLED WITHIN 0' OF BUILDINGS, UNLESS OTHERWISE NOTED ON PLANS.
7. CONTRACTOR TO COORDINATE WITH THE APPLICABLE ELECTRIC UTILITY SUPPLIER REGARDING ANY NECESSARY RELOCATION OF UNDERGROUND AND/OR OVERHEAD ELECTRIC FACILITIES, AND FOR THE LOCATION AND INSTALLATION OF TRANSFORMER PAD(S) AND ASSOCIATED ELECTRIC FACILITIES.
8. SAFETY:
 - a. DURING THE CONSTRUCTION AND/OR MAINTENANCE OF THIS PROJECT, THE CONTRACTOR SHALL BE RESPONSIBLE FOR THE CONTROL AND SAFETY OF THE TRAVELING PUBLIC AND THE SAFETY OF HIS/HER PERSONNEL.
 - b. LABOR SAFETY REGULATIONS SHALL CONFORM TO THE PROVISIONS SET FORTH BY THE FEDERAL REGISTER OF THE DEPARTMENT OF TRANSPORTATION.
 - c. THE MINIMUM STANDARDS AS SET FORTH IN THE CURRENT EDITION OF THE STATE PLANS MANUAL, FOR UTILITY CONTROL, AND SAFE PRACTICES FOR STREET AND HIGHWAY CONSTRUCTION.
 - d. INFORMATION AND UTILITY OPENING SHALL BE FOLLOWED IN THE DESIGN, APPLICATION, INSTALLATION, MAINTENANCE AND REMOVAL OF ALL TRAFFIC DEVICES, INCLUDING SIGNAGE, BARRIERS AND NECESSARY TRAFFIC CONTROL DEVICES, TO PROTECT THE PUBLIC AND CONSTRUCTION PERSONNEL FROM HAZARDS WITHIN THE PROJECT LIMITS.
 - e. ALL TRAFFIC CONTROL, MARKINGS AND DEVICES SHALL CONFORM TO THE PROVISIONS SET FORTH IN THE MANUAL ON UNIFORM TRAFFIC CONTROL DEVICES PREPARED BY THE U.S. DEPARTMENT OF TRANSPORTATION FEDERAL HIGHWAY ADMINISTRATION.
 - f. ALL SURFACE CONSTRUCTION SHALL COMPLY WITH THE "TRENCH SAFETY ACT," THE CONTRACTOR SHALL INFORM THAT THE METHOD OF TRENCH PROTECTION AND CONSTRUCTION IS IN COMPLIANCE WITH THE OCCUPATIONAL SAFETY AND HEALTH ADMINISTRATION (OSHA) REGULATIONS.
9. IT SHALL BE THE SOLE RESPONSIBILITY OF THE CONTRACTOR TO COMPLY AND MAINTAIN THE TRENCH SAFETY ACT. THE ABOVE INFORMATION HAS BEEN PROVIDED FOR THE CONTRACTOR'S INFORMATION ONLY AND DOES NOT IMPLY THAT THE OWNER OR ENGINEER WILL INSPECT AND/OR ENFORCE SAFETY REGULATIONS.
10. IT SHALL BE THE RESPONSIBILITY OF THE CONTRACTOR TO OBTAIN AN ON-SITE STOPPING PERMIT (IF REQUIRED) FOR CONSTRUCTION OF THE PROPOSED UTILITIES. THIS PERMIT MUST BE OBTAINED BY A QUALIFIED PERSONNEL (REGISTERED PROFESSIONAL ENGINEER OR SURVEYOR) PRIOR TO THE START OF CONSTRUCTION. THESE PLANS AND ANY LOCATIONS PLANNED TO BE CONSTRUCTED ARE SUBJECT TO THE REVIEW OF THE ENGINEER, WILL BE SUBJECT TO THE APPROVAL OF CONDITIONS OF THIS PERMIT.
11. THE GRAPHIC INFORMATION DEPICTED ON THESE PLANS HAS BEEN COMPILED TO PROPORTION BY SCALE AS ACCURATELY AS POSSIBLE. HOWEVER, DUE TO THE NATURE OF THE INFORMATION, THE PRESENCE OF REVISIONS, INFORMATION CONTAINED HEREIN IS NOT INTENDED TO BE USED FOR CONSTRUCTION PURPOSES.
12. ALL SPECIFICATIONS AND DOCUMENTS REFERENCED HEREIN SHALL BE OF THE LATEST REVISION.
13. ALL UNDERGROUND UTILITIES MUST BE IN-PLACE, TESTED AND INSPECTED PRIOR TO BASE AND SURFACE CONSTRUCTION.
14. WORK PERFORMED UNDER THIS CONTRACT SHALL INTERFACE SMOOTHLY WITH ANY OTHER WORK BEING PERFORMED ON SITE BY OTHER CONTRACTORS/SUBCONTRACTORS AND UTILITY COMPANIES. IT WILL BE NECESSARY FOR THE GENERAL CONTRACTOR TO COORDINATE AND SCHEDULE HIS/HER ACTIVITIES ACCORDINGLY.
15. WHERE APPLICABLE UTILITY TRENCHES CROSSING PAVEMENT AREAS SHALL BE BACKFILLED WITH GRANULAR MATERIAL IN TWELVE (12) LAYERS AND COMPACTED TO NINETY EIGHT PERCENT (98 %) MAXIMUM DENSITY AS DETERMINED BY ASTM D-1557 OR T-99.
16. ALL DIMENSIONS ARE TO FACE OF CURB.
17. ALL DIMENSIONS AT UTILITY AND STORM STRUCTURES (INLET/MANHOLES WITH ROADWAY TO 3' IN BACK OF CURB) SHALL BE MEAS WITHIN PAVEMENT AREAS, AND A GENIOTY OF 100' FOR 10' AREAS OUTSIDE PAVED AREAS PER ASHTO-100 (MODIFIED) IS REQUIRED.

WATER SYSTEM NOTES:

1. A MINIMUM HORIZONTAL SEPARATION OF SIX (6) FEET (18" (10" FEET) PREFERRED) OUTSIDE TO OUTSIDE SHALL BE MAINTAINED BETWEEN WATER MAINS AND SANITARY SEWER OR SANITARY FORCE MAINS.
2. A MINIMUM HORIZONTAL SEPARATION OF THREE (3) FEET OUTSIDE TO OUTSIDE SHALL BE MAINTAINED BETWEEN GAS LINES AND STORM SEWERS OR RECLAIMED WATER LINES CARRYING UNRESTRICTED PUBLIC ACCESS WATER.
3. IN AREAS WHERE IT IS NOT PRACTICAL TO MAINTAIN THE REQUIRED SEPARATION, THE WATER MAIN SHALL BE LEAD IN A SEPARATE TRENCH OR LAYED OUT ON ONE SIDE OF THE SANITARY SEWER/SEWER, STORM SEWER OR RECLAIMED WATER LINE. THE SEPARATION FROM THE BOTTOM OF THE WATER MAIN IS AT LEAST SIX (6) INCHES ABOVE THE TOP OF THE OTHER LINE.
4. IF THE MINIMUM ALLOWABLE SIX (6) FOOT HORIZONTAL SEPARATION OR SIX (6) INCHES VERTICAL SEPARATION IN A SEPARATE TRENCH CANNOT BE MAINTAINED, THE WATER MAIN TO DUCTILE IRON IF THE OTHER LINE IS A STORM SEWER.

8. IF THE NON-CONFORMING LINE IS A GRAVITY SANITARY SEWER, AND SIX (6) FOOT HORIZONTAL SEPARATION OR SIX (6) INCHES VERTICAL SEPARATION IN A SEPARATE TRENCH CANNOT BE MAINTAINED, UPGRADE THE GRAVITY SANITARY SEWER (IF BEING REPLACED) TO AWWA C900, SDR 18 PVC AND HYDROSTATICALLY TEST IT TO 150 PSI.
9. IF THE OTHER LINE IS A RECLAIMED WATER LINE AND THE ABOVE SEPARATION REQUIREMENTS ARE NOT MET, UPGRADE THE RECLAIMED WATER LINE MATERIAL TO DUCTILE IRON OR ENCASED THE PIPE IN CONCRETE.
10. DEVIATIONS AND OTHER ALTERNATIVES SHALL BE CONSIDERED ON CASE-BY-CASE BASIS AND MUST BE APPROVED BY THE OWNER PRIOR TO IMPLEMENTATION.
11. THERE SHALL BE AT LEAST A SIX (6) FOOT HORIZONTAL SEPARATION BETWEEN WATER MAINS AND SANITARY SEWER FORCE MAINS WITHOUT EXCEPTION. FIELD PROBLEMS SHALL BE REPORTED TO THE ENGINEER. SPECIAL SOLUTIONS MUST BE ACCEPTED BY D.E.P. PRIOR TO IMPLEMENTATION.
12. NO WATER PIPE SHALL PASS THROUGH OR COME IN CONTACT WITH ANY PART OF A SANITARY SEWER MANHOLE OR STORM SEWER STRUCTURE.

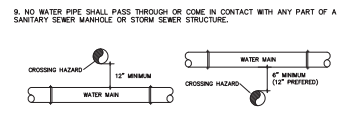

10. A MINIMUM OF WATER SEPARATION OF SIX (6) INCHES (TWELVE (12) INCHES PREFERRED) OUTSIDE TO OUTSIDE SHALL BE MAINTAINED BETWEEN WATER MAIN, SANITARY SEWER, STORM SEWER OR RECLAIMED WATER LINES.
11. THE CROSSING SHALL BE ARRANGED SO THAT THE SEWER JOINTS AND WATER JOINTS SHALL BE EQUIDISTANT FROM THE POINT OF CROSSING WITH NO LESS THAN TWELVE (12) FEET BETWEEN ANY TWO JOINTS. SUPPORT LENDING OF JOINTS MUST BE USED TO PROVIDE A MINIMUM SEPARATION OF 12 FEET BETWEEN ANY TWO (2) JOINTS IN LINE OF THE SAME SIZE AND MATERIAL. THE JOINTS SHALL BE MECHANICALLY JOINTED AT THE POINT OF CROSSING. ALL JOINTS ON THE WATER MAIN WITHIN 20 FEET OF THE CROSSING MUST BE LEAK-TESTED MECHANICALLY. ALL JOINTS WITHIN 10 FEET BETWEEN JOINTS CENTERED AT THE POINT OF CROSSING SHALL BE REQUIRED. THE WATER MAIN SHALL BE PLACED 12 FEET OUTSIDE TO OUTSIDE OF THE POINT OF CROSSING. ADEQUATE STRUCTURAL SUPPORT SHALL BE PROVIDED FOR THE SEWER TO PREVENT DAMAGE TO THE WATER MAIN.

11. ALL CROSSINGS SHALL BE ARRANGED SO THAT THE SEWER PIPE JOINTS AND THE WATER MAIN PIPE JOINTS ARE EQUIDISTANT FROM THE POINT OF CROSSING (4 PIPES CENTERED ON THE CROSSING).
12. WHEN THERE IS LESS THAN 6" VERTICAL CLEARANCE BETWEEN THE WATER MAIN AND STORM SEWER, THE WATER MAIN SHALL BE UPGRADED TO DUCTILE IRON. ONE FULL LENGTH OF PIPE SHALL BE CENTERED AT THE POINT OF CROSSING.
13. IF THE NON-CONFORMING LINE IS A SANITARY GRAVITY SEWER, WHERE THERE IS LESS THAN SIX (6) INCHES VERTICAL CLEARANCE FROM THE WATER MAIN, UPGRADE THE SANITARY GRAVITY SEWER TO AWWA C900, SDR 18 PVC AND HYDROSTATICALLY TEST IT TO 150 PSI. PIPE SHALL BE LOCATED SO THAT JOINTS ARE AS FAR AS POSSIBLE FROM EACH OTHER.
14. SPECIAL STRUCTURAL SUPPORT OR CONCRETE SADDLES MAY BE NECESSARY AT THE CROSSING LOCATION.
15. IT IS PREFERRED TO LAY THE WATER MAIN ABOVE THE CROSSING HAZARD, WHEN BARRIERS MUST BE BELOW OTHER PROPOSED UTILITIES OR SEPARATION.
16. DEVIATIONS AND OTHER ALTERNATIVES SHALL BE CONSIDERED ON CASE-BY-CASE BASIS AND MUST RECEIVE SPECIFIC APPROVAL BY D.E.P. PRIOR TO IMPLEMENTATION.
17. THERE SHALL BE A SIX (6) INCH VERTICAL SEPARATION BETWEEN WATER MAINS AND SANITARY SEWER FORCE MAINS AT CROSSINGS WITHOUT EXCEPTION. CONFLICTS WITH EXISTING LINES, WHERE IT IS NOT POSSIBLE TO MAINTAIN THE REQUIRED SEPARATION, SHALL BE REPORTED TO THE ENGINEER. SPECIAL SOLUTIONS MUST BE ACCEPTED BY D.E.P. PRIOR TO IMPLEMENTATION.
18. ALL WATER MAINS SHALL BE INSTALLED WITH A MINIMUM OF 36 INCHES OF COVER.
19. CONTRACTOR TO INSTALL TEMPORARY BLOWOFFS, AT THE END(S) OF PROPOSED WATER MAINS AND SERVICE LATERALS TO BUILDINGS(S), TO ASSURE ADEQUATE FLUSHING AND DISINFECTION/COLORIMETER.
20. ALL WATER MAINS SHALL BE STERILIZED IN ACCORDANCE WITH THE APPLICABLE SECTION OF THE LATEST ANNA SPECIFICATION 0051 AND MANUFACTURE UTILITY DEPARTMENT SPECIFICATIONS.
21. THE LOCATION OF EXISTING UTILITIES, SUCH AS WATER MAINS, SEWERS, GAS LINES, ETC. AS SHOWN ON THE PLANS HAVE BEEN DETERMINED FROM THE BEST AVAILABLE INFORMATION AND COVER FOR THE CONVENIENCE OF THE CONTRACTOR. HOWEVER, THE ENGINEER AND OWNER DO NOT ASSUME RESPONSIBILITY FOR THE ACCURACY OF THE INFORMATION AND COVER.

22. SPECIAL SAFETY:
 - a. DURING THE CONSTRUCTION AND/OR MAINTENANCE OF THIS PROJECT, THE CONTRACTOR SHALL BE RESPONSIBLE FOR THE CONTROL AND SAFETY OF THE TRAVELING PUBLIC AND THE SAFETY OF HIS/HER PERSONNEL.
 - b. LABOR SAFETY REGULATIONS SHALL CONFORM TO THE PROVISIONS SET FORTH BY THE FEDERAL REGISTER OF THE DEPARTMENT OF TRANSPORTATION.
 - c. THE MINIMUM STANDARDS AS SET FORTH IN THE CURRENT EDITION OF THE STATE PLANS MANUAL, FOR UTILITY CONTROL, AND SAFE PRACTICES FOR STREET AND HIGHWAY CONSTRUCTION.
 - d. INFORMATION AND UTILITY OPENING SHALL BE FOLLOWED IN THE DESIGN, APPLICATION, INSTALLATION, MAINTENANCE AND REMOVAL OF ALL TRAFFIC DEVICES, INCLUDING SIGNAGE, BARRIERS AND NECESSARY TRAFFIC CONTROL DEVICES, TO PROTECT THE PUBLIC AND CONSTRUCTION PERSONNEL FROM HAZARDS WITHIN THE PROJECT LIMITS.
 - e. ALL TRAFFIC CONTROL, MARKINGS AND DEVICES SHALL CONFORM TO THE PROVISIONS SET FORTH IN THE MANUAL ON UNIFORM TRAFFIC CONTROL DEVICES PREPARED BY THE U.S. DEPARTMENT OF TRANSPORTATION FEDERAL HIGHWAY ADMINISTRATION.
 - f. ALL SURFACE CONSTRUCTION SHALL COMPLY WITH THE "TRENCH SAFETY ACT," THE CONTRACTOR SHALL INFORM THAT THE METHOD OF TRENCH PROTECTION AND CONSTRUCTION IS IN COMPLIANCE WITH THE OCCUPATIONAL SAFETY AND HEALTH ADMINISTRATION (OSHA) REGULATIONS.
23. IT SHALL BE THE SOLE RESPONSIBILITY OF THE CONTRACTOR TO COMPLY AND MAINTAIN THE TRENCH SAFETY ACT. THE ABOVE INFORMATION HAS BEEN PROVIDED FOR THE CONTRACTOR'S INFORMATION ONLY AND DOES NOT IMPLY THAT THE OWNER OR ENGINEER WILL INSPECT AND/OR ENFORCE SAFETY REGULATIONS.
24. IT SHALL BE THE RESPONSIBILITY OF THE CONTRACTOR TO OBTAIN AN ON-SITE STOPPING PERMIT (IF REQUIRED) FOR CONSTRUCTION OF THE PROPOSED UTILITIES. THIS PERMIT MUST BE OBTAINED BY A QUALIFIED PERSONNEL (REGISTERED PROFESSIONAL ENGINEER OR SURVEYOR) PRIOR TO THE START OF CONSTRUCTION. THESE PLANS AND ANY LOCATIONS PLANNED TO BE CONSTRUCTED ARE SUBJECT TO THE REVIEW OF THE ENGINEER, WILL BE SUBJECT TO THE APPROVAL OF CONDITIONS OF THIS PERMIT.
25. THE GRAPHIC INFORMATION DEPICTED ON THESE PLANS HAS BEEN COMPILED TO PROPORTION BY SCALE AS ACCURATELY AS POSSIBLE. HOWEVER, DUE TO THE NATURE OF THE INFORMATION, THE PRESENCE OF REVISIONS, INFORMATION CONTAINED HEREIN IS NOT INTENDED TO BE USED FOR CONSTRUCTION PURPOSES.
26. ALL SPECIFICATIONS AND DOCUMENTS REFERENCED HEREIN SHALL BE OF THE LATEST REVISION.
27. ALL UNDERGROUND UTILITIES MUST BE IN-PLACE, TESTED AND INSPECTED PRIOR TO BASE AND SURFACE CONSTRUCTION.
28. WORK PERFORMED UNDER THIS CONTRACT SHALL INTERFACE SMOOTHLY WITH ANY OTHER WORK BEING PERFORMED ON SITE BY OTHER CONTRACTORS/SUBCONTRACTORS AND UTILITY COMPANIES. IT WILL BE NECESSARY FOR THE GENERAL CONTRACTOR TO COORDINATE AND SCHEDULE HIS/HER ACTIVITIES ACCORDINGLY.
29. WHERE APPLICABLE UTILITY TRENCHES CROSSING PAVEMENT AREAS SHALL BE BACKFILLED WITH GRANULAR MATERIAL IN TWELVE (12) LAYERS AND COMPACTED TO NINETY EIGHT PERCENT (98 %) MAXIMUM DENSITY AS DETERMINED BY ASTM D-1557 OR T-99.
30. ALL DIMENSIONS ARE TO FACE OF CURB.
31. ALL DIMENSIONS AT UTILITY AND STORM STRUCTURES (INLET/MANHOLES WITH ROADWAY TO 3' IN BACK OF CURB) SHALL BE MEAS WITHIN PAVEMENT AREAS, AND A GENIOTY OF 100' FOR 10' AREAS OUTSIDE PAVED AREAS PER ASHTO-100 (MODIFIED) IS REQUIRED.

23. WHERE APPLICABLE UTILITY TRENCHES CROSSING PAVEMENT AREAS SHALL BE BACKFILLED WITH GRANULAR MATERIAL IN TWELVE (12) LAYERS AND COMPACTED TO NINETY EIGHT PERCENT (98%) MAXIMUM DENSITY AS DETERMINED BY ASTM D-1557 OR T-99.
24. ALL UNSUITABLE MATERIALS UNDER WATER PIPES THAT IS UNDER PAVEMENT SHALL BE REMOVED AND REPLACED WITH SELECTED BACKFILL COMPACTED TO NINETY EIGHT PERCENT (98%) OF ITS MAXIMUM DENSITY AT TWO PERCENT (2.00) MOORE OR LESS OF OPTIMUM MOISTURE CONTENT AS DETERMINED BY THE MODIFIED PROCTOR TEST (ASTM D1557).
25. ALL UNSUITABLE MATERIALS UNDER WATER PIPES THAT IS NOT UNDER PAVEMENT SHALL BE REMOVED AND REPLACED WITH SELECTED BACKFILL COMPACTED TO NINETY-FIVE PERCENT (95%) OF ITS MAXIMUM DENSITY AT TWO PERCENT (2.00) MOORE OR LESS OF OPTIMUM MOISTURE CONTENT AS DETERMINED BY THE MODIFIED PROCTOR TEST (ASTM D1557).
26. IT MAY BE NECESSARY TO UNDERGROUND UTILITIES AND/OR STRUCTURES SHALL BE REPAIRED AT THE CONTRACTOR'S EXPENSE.
27. ALL MATERIALS AND CONSTRUCTION ARE TO BE IN ACCORDANCE WITH THE CURRENT MANUFACTURE STANDARDS AND SPECIFICATIONS.
28. WHERE APPLICABLE, SIX INCH (6") POLYETHYLENE GLYCOL SEWER LATERALS SHALL HAVE A MINIMUM SLOPE OF ONE PERCENT (1.0%).
29. FIRE SERVICE PIPE SHALL BE POLYETHYLENE GLYCOL PRESSURE PIPE CONFORMING TO AWWA C900 WITH DIMENSION (14) AND A MINIMUM PRESSURE CLASS OF TWO HUNDRED POUNDS PER SQUARE INCH (200 P.S.I.). WATER SERVICE PIPE SHALL BE POLYETHYLENE GLYCOL PRESSURE PIPE CONFORMING TO AWWA C900 WITH DIMENSION RATIO (18) OR (20) AND A MINIMUM PRESSURE CLASS OF TWO HUNDRED FIFTY POUNDS PER SQUARE INCH (250 P.S.I.). ALL COUNTY OWNED WATERMAIN TO BE D.U.P.
30. ALL WATER PIPE SHALL BE DISINFECTED AND HYDROSTATICALLY TESTED IN ACCORDANCE WITH ANNA STANDARDS 0051, 0600, OR W23 FOR POLYETHYLENE GLYCOL PRESSURE PIPE. THE CONTRACTOR SHALL BE RESPONSIBLE FOR THE REQUIRED TESTING. THESE PLANS, THE VARIOUS AGENCIES AND PERMIT CONDITIONS SHOULD ANY RETESTING BE REQUIRED DUE TO THE FAILURE OF ANY TESTS TO MEET THE REQUIREMENTS OF THE CONTRACTOR WILL BEAR ALL COSTS OF SAID RETESTING.

31. ALL ON-SITE WATER, SANITARY SEWER AND STORMWATER IMPROVEMENTS SHALL BE INSTALLED AND WORK COMPLETED BY THE OWNER IN CONFORMANCE WITH THE MUNICIPALITY STANDARDS.
32. CONTRACTOR IS TO ADJUST ANY UTILITY ELEMENT MEANT TO BE FLUSH WITH GRADE (CLEAN OUT MANHOLES, CATCH BASINS, INLETS, ETC.) THAT IS AFFECTED BY SITE WORK OR GRADE CHANGES, WHETHER SPECIALLY NOTED ON PLANS OR NOT.
33. ELECTRICAL, TELEPHONE, GAS AND CABLE TELEVISION SERVICE WILL BE PROVIDED BY THE APPROPRIATE UTILITY COMPANIES. THE CONTRACTOR SHALL COORDINATE LOCATIONS AND SERVICES FOR THESE UTILITIES WITH THE ENTITIES INVOLVED.
34. ALL UTILITIES CONSTRUCTING CONNECTING TO THE MUNICIPALITY SYSTEM SHALL CONFORM TO THE MUNICIPALITY MANUAL OF STANDARDS AND SPECIFICATIONS FOR WATERMAIN AND WATER MAIN CONSTRUCTION.
35. CONTRACTOR SHALL BE RESPONSIBLE FOR THE MUNICIPALITY PUBLIC UTILITIES CONSTRUCTION DEPARTMENT 48 HOURS PRIOR TO ANY UTILITIES CONSTRUCTION.

36. ALL ABOVE GROUND EQUIPMENT NOT MOUNTED ON THE BUILDING MUST BE PAINTED BLACK AND SIGNED WITH LANDSCAPE, EXCEPT ABOVE PREVENTOR AREAS. THE EQUIPMENT MUST BE COMPLETELY PAINTED THE COLOR OF THE CORRESPONDING UTILITY. POTABLE WATER IS BLUE, RECLAIMED WATER IS PURPLE, AND FIRE IS RED.
37. WHERE APPLICABLE UTILITY TRENCHES CROSSING PAVEMENT AREAS SHALL BE BACKFILLED WITH GRANULAR MATERIAL IN TWELVE (12) LAYERS AND COMPACTED TO NINETY EIGHT PERCENT (98%) MAXIMUM DENSITY AS DETERMINED BY ASTM D-1557 OR T-99.
38. ALL UNSUITABLE MATERIALS UNDER WATER PIPES SHALL BE REMOVED AND REPLACED WITH SELECTED BACKFILL COMPACTED TO NINETY-FIVE PERCENT (95%) OF ITS MAXIMUM DENSITY AT TWO PERCENT (2.00) MOORE OR LESS OF OPTIMUM MOISTURE CONTENT AS DETERMINED BY THE MODIFIED PROCTOR TEST (ASTM D1557).
39. CONTRACTOR IS TO ADJUST ANY UTILITY ELEMENT MEANT TO BE FLUSH WITH GRADE (CLEAN OUT MANHOLES, CATCH BASINS, INLETS, ETC.) THAT IS AFFECTED BY SITE WORK OR GRADE CHANGES, WHETHER SPECIALLY NOTED ON PLANS OR NOT.
40. A SIGN SHALL BE PLACED AT IRRIGATED AREAS WITH THE WORDS "IRRIGATION BY REUSE WATER, DO NOT DRINK".
41. CONTRACTOR SHALL NOTIFY THE MUNICIPALITY PUBLIC UTILITIES CONSTRUCTION DEPARTMENT 48 HOURS PRIOR TO ANY UTILITIES CONSTRUCTION.

42. GENERAL CONSTRUCTION BEST MANAGEMENT PRACTICES SHALL BE EMPLOYED TO MINIMIZE SOIL EROSION AND POTENTIAL POOR SOPE. THE CONTRACTOR SHALL BE RESPONSIBLE FOR THE REQUIRED TESTING. THESE PLANS, THE VARIOUS AGENCIES AND PERMIT CONDITIONS SHOULD ANY RETESTING BE REQUIRED DUE TO THE FAILURE OF ANY TESTS TO MEET THE REQUIREMENTS OF THE CONTRACTOR WILL BEAR ALL COSTS OF SAID RETESTING.
43. WHERE APPLICABLE UTILITY TRENCHES CROSSING PAVEMENT AREAS SHALL BE BACKFILLED WITH GRANULAR MATERIAL IN TWELVE (12) LAYERS AND COMPACTED TO NINETY EIGHT PERCENT (98%) MAXIMUM DENSITY AS DETERMINED BY ASTM D-1557 OR T-99.
44. ALL UNSUITABLE MATERIALS UNDER WATER PIPES SHALL BE REMOVED AND REPLACED WITH SELECTED BACKFILL COMPACTED TO NINETY-FIVE PERCENT (95%) OF ITS MAXIMUM DENSITY AT TWO PERCENT (2.00) MOORE OR LESS OF OPTIMUM MOISTURE CONTENT AS DETERMINED BY THE MODIFIED PROCTOR TEST (ASTM D1557).
45. CONTRACTOR IS TO ADJUST ANY UTILITY ELEMENT MEANT TO BE FLUSH WITH GRADE (CLEAN OUT MANHOLES, CATCH BASINS, INLETS, ETC.) THAT IS AFFECTED BY SITE WORK OR GRADE CHANGES, WHETHER SPECIALLY NOTED ON PLANS OR NOT.
46. A SIGN SHALL BE PLACED AT IRRIGATED AREAS WITH THE WORDS "IRRIGATION BY REUSE WATER, DO NOT DRINK".
47. CONTRACTOR SHALL NOTIFY THE MUNICIPALITY PUBLIC UTILITIES CONSTRUCTION DEPARTMENT 48 HOURS PRIOR TO ANY UTILITIES CONSTRUCTION.

48. GENERAL CONSTRUCTION BEST MANAGEMENT PRACTICES SHALL BE EMPLOYED TO MINIMIZE SOIL EROSION AND POTENTIAL POOR SOPE. THE CONTRACTOR SHALL BE RESPONSIBLE FOR THE REQUIRED TESTING. THESE PLANS, THE VARIOUS AGENCIES AND PERMIT CONDITIONS SHOULD ANY RETESTING BE REQUIRED DUE TO THE FAILURE OF ANY TESTS TO MEET THE REQUIREMENTS OF THE CONTRACTOR WILL BEAR ALL COSTS OF SAID RETESTING.
49. WHERE APPLICABLE UTILITY TRENCHES CROSSING PAVEMENT AREAS SHALL BE BACKFILLED WITH GRANULAR MATERIAL IN TWELVE (12) LAYERS AND COMPACTED TO NINETY EIGHT PERCENT (98%) MAXIMUM DENSITY AS DETERMINED BY ASTM D-1557 OR T-99.
50. ALL UNSUITABLE MATERIALS UNDER WATER PIPES SHALL BE REMOVED AND REPLACED WITH SELECTED BACKFILL COMPACTED TO NINETY-FIVE PERCENT (95%) OF ITS MAXIMUM DENSITY AT TWO PERCENT (2.00) MOORE OR LESS OF OPTIMUM MOISTURE CONTENT AS DETERMINED BY THE MODIFIED PROCTOR TEST (ASTM D1557).
51. CONTRACTOR IS TO ADJUST ANY UTILITY ELEMENT MEANT TO BE FLUSH WITH GRADE (CLEAN OUT MANHOLES, CATCH BASINS, INLETS, ETC.) THAT IS AFFECTED BY SITE WORK OR GRADE CHANGES, WHETHER SPECIALLY NOTED ON PLANS OR NOT.
52. A SIGN SHALL BE PLACED AT IRRIGATED AREAS WITH THE WORDS "IRRIGATION BY REUSE WATER, DO NOT DRINK".
53. CONTRACTOR SHALL NOTIFY THE MUNICIPALITY PUBLIC UTILITIES CONSTRUCTION DEPARTMENT 48 HOURS PRIOR TO ANY UTILITIES CONSTRUCTION.

54. GENERAL CONSTRUCTION BEST MANAGEMENT PRACTICES SHALL BE EMPLOYED TO MINIMIZE SOIL EROSION AND POTENTIAL POOR SOPE. THE CONTRACTOR SHALL BE RESPONSIBLE FOR THE REQUIRED TESTING. THESE PLANS, THE VARIOUS AGENCIES AND PERMIT CONDITIONS SHOULD ANY RETESTING BE REQUIRED DUE TO THE FAILURE OF ANY TESTS TO MEET THE REQUIREMENTS OF THE CONTRACTOR WILL BEAR ALL COSTS OF SAID RETESTING.
55. WHERE APPLICABLE UTILITY TRENCHES CROSSING PAVEMENT AREAS SHALL BE BACKFILLED WITH GRANULAR MATERIAL IN TWELVE (12) LAYERS AND COMPACTED TO NINETY EIGHT PERCENT (98%) MAXIMUM DENSITY AS DETERMINED BY ASTM D-1557 OR T-99.
56. ALL UNSUITABLE MATERIALS UNDER WATER PIPES SHALL BE REMOVED AND REPLACED WITH SELECTED BACKFILL COMPACTED TO NINETY-FIVE PERCENT (95%) OF ITS MAXIMUM DENSITY AT TWO PERCENT (2.00) MOORE OR LESS OF OPTIMUM MOISTURE CONTENT AS DETERMINED BY THE MODIFIED PROCTOR TEST (ASTM D1557).
57. CONTRACTOR IS TO ADJUST ANY UTILITY ELEMENT MEANT TO BE FLUSH WITH GRADE (CLEAN OUT MANHOLES, CATCH BASINS, INLETS, ETC.) THAT IS AFFECTED BY SITE WORK OR GRADE CHANGES, WHETHER SPECIALLY NOTED ON PLANS OR NOT.
58. A SIGN SHALL BE PLACED AT IRRIGATED AREAS WITH THE WORDS "IRRIGATION BY REUSE WATER, DO NOT DRINK".
59. CONTRACTOR SHALL NOTIFY THE MUNICIPALITY PUBLIC UTILITIES CONSTRUCTION DEPARTMENT 48 HOURS PRIOR TO ANY UTILITIES CONSTRUCTION.

60. GENERAL CONSTRUCTION BEST MANAGEMENT PRACTICES SHALL BE EMPLOYED TO MINIMIZE SOIL EROSION AND POTENTIAL POOR SOPE. THE CONTRACTOR SHALL BE RESPONSIBLE FOR THE REQUIRED TESTING. THESE PLANS, THE VARIOUS AGENCIES AND PERMIT CONDITIONS SHOULD ANY RETESTING BE REQUIRED DUE TO THE FAILURE OF ANY TESTS TO MEET THE REQUIREMENTS OF THE CONTRACTOR WILL BEAR ALL COSTS OF SAID RETESTING.
61. WHERE APPLICABLE UTILITY TRENCHES CROSSING PAVEMENT AREAS SHALL BE BACKFILLED WITH GRANULAR MATERIAL IN TWELVE (12) LAYERS AND COMPACTED TO NINETY EIGHT PERCENT (98%) MAXIMUM DENSITY AS DETERMINED BY ASTM D-1557 OR T-99.
62. ALL UNSUITABLE MATERIALS UNDER WATER PIPES SHALL BE REMOVED AND REPLACED WITH SELECTED BACKFILL COMPACTED TO NINETY-FIVE PERCENT (95%) OF ITS MAXIMUM DENSITY AT TWO PERCENT (2.00) MOORE OR LESS OF OPTIMUM MOISTURE CONTENT AS DETERMINED BY THE MODIFIED PROCTOR TEST (ASTM D1557).
63. CONTRACTOR IS TO ADJUST ANY UTILITY ELEMENT MEANT TO BE FLUSH WITH GRADE (CLEAN OUT MANHOLES, CATCH BASINS, INLETS, ETC.) THAT IS AFFECTED BY SITE WORK OR GRADE CHANGES, WHETHER SPECIALLY NOTED ON PLANS OR NOT.
64. A SIGN SHALL BE PLACED AT IRRIGATED AREAS WITH THE WORDS "IRRIGATION BY REUSE WATER, DO NOT DRINK".
65. CONTRACTOR SHALL NOTIFY THE MUNICIPALITY PUBLIC UTILITIES CONSTRUCTION DEPARTMENT 48 HOURS PRIOR TO ANY UTILITIES CONSTRUCTION.

66. GENERAL CONSTRUCTION BEST MANAGEMENT PRACTICES SHALL BE EMPLOYED TO MINIMIZE SOIL EROSION AND POTENTIAL POOR SOPE. THE CONTRACTOR SHALL BE RESPONSIBLE FOR THE REQUIRED TESTING. THESE PLANS, THE VARIOUS AGENCIES AND PERMIT CONDITIONS SHOULD ANY RETESTING BE REQUIRED DUE TO THE FAILURE OF ANY TESTS TO MEET THE REQUIREMENTS OF THE CONTRACTOR WILL BEAR ALL COSTS OF SAID RETESTING.
67. WHERE APPLICABLE UTILITY TRENCHES CROSSING PAVEMENT AREAS SHALL BE BACKFILLED WITH GRANULAR MATERIAL IN TWELVE (12) LAYERS AND COMPACTED TO NINETY EIGHT PERCENT (98%) MAXIMUM DENSITY AS DETERMINED BY ASTM D-1557 OR T-99.
68. ALL UNSUITABLE MATERIALS UNDER WATER PIPES SHALL BE REMOVED AND REPLACED WITH SELECTED BACKFILL COMPACTED TO NINETY-FIVE PERCENT (95%) OF ITS MAXIMUM DENSITY AT TWO PERCENT (2.00) MOORE OR LESS OF OPTIMUM MOISTURE CONTENT AS DETERMINED BY THE MODIFIED PROCTOR TEST (ASTM D1557).
69. CONTRACTOR IS TO ADJUST ANY UTILITY ELEMENT MEANT TO BE FLUSH WITH GRADE (CLEAN OUT MANHOLES, CATCH BASINS, INLETS, ETC.) THAT IS AFFECTED BY SITE WORK OR GRADE CHANGES, WHETHER SPECIALLY NOTED ON PLANS OR NOT.
70. A SIGN SHALL BE PLACED AT IRRIGATED AREAS WITH THE WORDS "IRRIGATION BY REUSE WATER, DO NOT DRINK".
71. CONTRACTOR SHALL NOTIFY THE MUNICIPALITY PUBLIC UTILITIES CONSTRUCTION DEPARTMENT 48 HOURS PRIOR TO ANY UTILITIES CONSTRUCTION.

72. GENERAL CONSTRUCTION BEST MANAGEMENT PRACTICES SHALL BE EMPLOYED TO MINIMIZE SOIL EROSION AND POTENTIAL POOR SOPE. THE CONTRACTOR SHALL BE RESPONSIBLE FOR THE REQUIRED TESTING. THESE PLANS, THE VARIOUS AGENCIES AND PERMIT CONDITIONS SHOULD ANY RETESTING BE REQUIRED DUE TO THE FAILURE OF ANY TESTS TO MEET THE REQUIREMENTS OF THE CONTRACTOR WILL BEAR ALL COSTS OF SAID RETESTING.
73. WHERE APPLICABLE UTILITY TRENCHES CROSSING PAVEMENT AREAS SHALL BE BACKFILLED WITH GRANULAR MATERIAL IN TWELVE (12) LAYERS AND COMPACTED TO NINETY EIGHT PERCENT (98%) MAXIMUM DENSITY AS DETERMINED BY ASTM D-1557 OR T-99.
74. ALL UNSUITABLE MATERIALS UNDER WATER PIPES SHALL BE REMOVED AND REPLACED WITH SELECTED BACKFILL COMPACTED TO NINETY-FIVE PERCENT (95%) OF ITS MAXIMUM DENSITY AT TWO PERCENT (2.00) MOORE OR LESS OF OPTIMUM MOISTURE CONTENT AS DETERMINED BY THE MODIFIED PROCTOR TEST (ASTM D1557).
75. CONTRACTOR IS TO ADJUST ANY UTILITY ELEMENT MEANT TO BE FLUSH WITH GRADE (CLEAN OUT MANHOLES, CATCH BASINS, INLETS, ETC.) THAT IS AFFECTED BY SITE WORK OR GRADE CHANGES, WHETHER SPECIALLY NOTED ON PLANS OR NOT.
76. A SIGN SHALL BE PLACED AT IRRIGATED AREAS WITH THE WORDS "IRRIGATION BY REUSE WATER, DO NOT DRINK".
77. CONTRACTOR SHALL NOTIFY THE MUNICIPALITY PUBLIC UTILITIES CONSTRUCTION DEPARTMENT 48 HOURS PRIOR TO ANY UTILITIES CONSTRUCTION.

78. GENERAL CONSTRUCTION BEST MANAGEMENT PRACTICES SHALL BE EMPLOYED TO MINIMIZE SOIL EROSION AND POTENTIAL POOR SOPE. THE CONTRACTOR SHALL BE RESPONSIBLE FOR THE REQUIRED TESTING. THESE PLANS, THE VARIOUS AGENCIES AND PERMIT CONDITIONS SHOULD ANY RETESTING BE REQUIRED DUE TO THE FAILURE OF ANY TESTS TO MEET THE REQUIREMENTS OF THE CONTRACTOR WILL BEAR ALL COSTS OF SAID RETESTING.
79. WHERE APPLICABLE UTILITY TRENCHES CROSSING PAVEMENT AREAS SHALL BE BACKFILLED WITH GRANULAR MATERIAL IN TWELVE (12) LAYERS AND COMPACTED TO NINETY EIGHT PERCENT (98%) MAXIMUM DENSITY AS DETERMINED BY ASTM D-1557 OR T-99.
80. ALL UNSUITABLE MATERIALS UNDER WATER PIPES SHALL BE REMOVED AND REPLACED WITH SELECTED BACKFILL COMPACTED TO NINETY-FIVE PERCENT (95%) OF ITS MAXIMUM DENSITY AT TWO PERCENT (2.00) MOORE OR LESS OF OPTIMUM MOISTURE CONTENT AS DETERMINED BY THE MODIFIED PROCTOR TEST (ASTM D1557).
81. CONTRACTOR IS TO ADJUST ANY UTILITY ELEMENT MEANT TO BE FLUSH WITH GRADE (CLEAN OUT MANHOLES, CATCH BASINS, INLETS, ETC.) THAT IS AFFECTED BY SITE WORK OR GRADE CHANGES, WHETHER SPECIALLY NOTED ON PLANS OR NOT.
82. A SIGN SHALL BE PLACED AT IRRIGATED AREAS WITH THE WORDS "IRRIGATION BY REUSE WATER, DO NOT DRINK".
83. CONTRACTOR SHALL NOTIFY THE MUNICIPALITY PUBLIC UTILITIES CONSTRUCTION DEPARTMENT 48 HOURS PRIOR TO ANY UTILITIES CONSTRUCTION.

84. GENERAL CONSTRUCTION BEST MANAGEMENT PRACTICES SHALL BE EMPLOYED TO MINIMIZE SOIL EROSION AND POTENTIAL POOR SOPE. THE CONTRACTOR SHALL BE RESPONSIBLE FOR THE REQUIRED TESTING. THESE PLANS, THE VARIOUS AGENCIES AND PERMIT CONDITIONS SHOULD ANY RETESTING BE REQUIRED DUE TO THE FAILURE OF ANY TESTS TO MEET THE REQUIREMENTS OF THE CONTRACTOR WILL BEAR ALL COSTS OF SAID RETESTING.
85. WHERE APPLICABLE UTILITY TRENCHES CROSSING PAVEMENT AREAS SHALL BE BACKFILLED WITH GRANULAR MATERIAL IN TWELVE (12) LAYERS AND COMPACTED TO NINETY EIGHT PERCENT (98%) MAXIMUM DENSITY AS DETERMINED BY ASTM D-1557 OR T-99.
86. ALL UNSUITABLE MATERIALS UNDER WATER PIPES SHALL BE REMOVED AND REPLACED WITH SELECTED BACKFILL COMPACTED TO NINETY-FIVE PERCENT (95%) OF ITS MAXIMUM DENSITY AT TWO PERCENT (2.00) MOORE OR LESS OF OPTIMUM MOISTURE CONTENT AS DETERMINED BY THE MODIFIED PROCTOR TEST (ASTM D1557).
87. CONTRACTOR IS TO ADJUST ANY UTILITY ELEMENT MEANT TO BE FLUSH WITH GRADE (CLEAN OUT MANHOLES, CATCH BASINS, INLETS, ETC.) THAT IS AFFECTED BY SITE WORK OR GRADE CHANGES, WHETHER SPECIALLY NOTED ON PLANS OR NOT.
88. A SIGN SHALL BE PLACED AT IRRIGATED AREAS WITH THE WORDS "IRRIGATION BY REUSE WATER, DO NOT DRINK".
89. CONTRACTOR SHALL NOTIFY THE MUNICIPALITY PUBLIC UTILITIES CONSTRUCTION DEPARTMENT 48 HOURS PRIOR TO ANY UTILITIES CONSTRUCTION.

90. GENERAL CONSTRUCTION BEST MANAGEMENT PRACTICES SHALL BE EMPLOYED TO MINIMIZE SOIL EROSION AND POTENTIAL POOR SOPE. THE CONTRACTOR SHALL BE RESPONSIBLE FOR THE REQUIRED TESTING. THESE PLANS, THE VARIOUS AGENCIES AND PERMIT CONDITIONS SHOULD ANY RETESTING BE REQUIRED DUE TO THE FAILURE OF ANY TESTS TO MEET THE REQUIREMENTS OF THE CONTRACTOR WILL BEAR ALL COSTS OF SAID RETESTING.
91. WHERE APPLICABLE UTILITY TRENCHES CROSSING PAVEMENT AREAS SHALL BE BACKFILLED WITH GRANULAR MATERIAL IN TWELVE (12) LAYERS AND COMPACTED TO NINETY EIGHT PERCENT (98%) MAXIMUM DENSITY AS DETERMINED BY ASTM D-1557 OR T-99.
92. ALL UNSUITABLE MATERIALS UNDER WATER PIPES SHALL BE REMOVED AND REPLACED WITH SELECTED BACKFILL COMPACTED TO NINETY-FIVE PERCENT (95%) OF ITS MAXIMUM DENSITY AT TWO PERCENT (2.00) MOORE OR LESS OF OPTIMUM MOISTURE CONTENT AS DETERMINED BY THE MODIFIED PROCTOR TEST (ASTM D1557).
93. CONTRACTOR IS TO ADJUST ANY UTILITY ELEMENT MEANT TO BE FLUSH WITH GRADE (CLEAN OUT MANHOLES, CATCH BASINS, INLETS, ETC.) THAT IS AFFECTED BY SITE WORK OR GRADE CHANGES, WHETHER SPECIALLY NOTED ON PLANS OR NOT.
94. A SIGN SHALL BE PLACED AT IRRIGATED AREAS WITH THE WORDS "IRRIGATION BY REUSE WATER, DO NOT DRINK".
95. CONTRACTOR SHALL NOTIFY THE MUNICIPALITY PUBLIC UTILITIES CONSTRUCTION DEPARTMENT 48 HOURS PRIOR TO ANY UTILITIES CONSTRUCTION.

96. GENERAL CONSTRUCTION BEST MANAGEMENT PRACTICES SHALL BE EMPLOYED TO MINIMIZE SOIL EROSION AND POTENTIAL POOR SOPE. THE CONTRACTOR SHALL BE RESPONSIBLE FOR THE REQUIRED TESTING. THESE PLANS, THE VARIOUS AGENCIES AND PERMIT CONDITIONS SHOULD ANY RETESTING BE REQUIRED DUE TO THE FAILURE OF ANY TESTS TO MEET THE REQUIREMENTS OF THE CONTRACTOR WILL BEAR ALL COSTS OF SAID RETESTING.
97. WHERE APPLICABLE UTILITY TRENCHES CROSSING PAVEMENT AREAS SHALL BE BACKFILLED WITH GRANULAR MATERIAL IN TWELVE (12) LAYERS AND COMPACTED TO NINETY EIGHT PERCENT (98%) MAXIMUM DENSITY AS DETERMINED BY ASTM D-1557 OR T-99.
98. ALL UNSUITABLE MATERIALS UNDER WATER PIPES SHALL BE REMOVED AND REPLACED WITH SELECTED BACKFILL COMPACTED TO NINETY-FIVE PERCENT (95%) OF ITS MAXIMUM DENSITY AT TWO PERCENT (2.00) MOORE OR LESS OF OPTIMUM MOISTURE CONTENT AS DETERMINED BY THE MODIFIED PROCTOR TEST (ASTM D1557).
99. CONTRACTOR IS TO ADJUST ANY UTILITY ELEMENT MEANT TO BE FLUSH WITH GRADE (CLEAN OUT MANHOLES, CATCH BASINS, INLETS, ETC.) THAT IS AFFECTED BY SITE WORK OR GRADE CHANGES, WHETHER SPECIALLY NOTED ON PLANS OR NOT.
100. A SIGN SHALL BE PLACED AT IRRIGATED AREAS WITH THE WORDS "IRRIGATION BY REUSE WATER, DO NOT DRINK".
101. CONTRACTOR SHALL NOTIFY THE MUNICIPALITY PUBLIC UTILITIES CONSTRUCTION DEPARTMENT 48 HOURS PRIOR TO ANY UTILITIES CONSTRUCTION.

102. GENERAL CONSTRUCTION BEST MANAGEMENT PRACTICES SHALL BE EMPLOYED TO MINIMIZE SOIL EROSION AND POTENTIAL POOR SOPE. THE CONTRACTOR SHALL BE RESPONSIBLE FOR THE REQUIRED TESTING. THESE PLANS, THE VARIOUS AGENCIES AND PERMIT CONDITIONS SHOULD ANY RETESTING BE REQUIRED DUE TO THE FAILURE OF ANY TESTS TO MEET THE REQUIREMENTS OF THE CONTRACTOR WILL BEAR ALL COSTS OF SAID RETESTING.
103. WHERE APPLICABLE UTILITY TRENCHES CROSSING PAVEMENT AREAS SHALL BE BACKFILLED WITH GRANULAR MATERIAL IN TWELVE (12) LAYERS AND COMPACTED TO NINETY EIGHT PERCENT (98%) MAXIMUM DENSITY AS DETERMINED BY ASTM D-1557 OR T-99.
104. ALL UNSUITABLE MATERIALS UNDER WATER PIPES SHALL BE REMOVED AND REPLACED WITH SELECTED BACKFILL COMPACTED TO NINETY-FIVE PERCENT (95%) OF ITS MAXIMUM DENSITY AT TWO PERCENT (2.00) MOORE OR LESS OF OPTIMUM MOISTURE CONTENT AS DETERMINED BY THE MODIFIED PROCTOR TEST (ASTM D1557).
105. CONTRACTOR IS TO ADJUST ANY UTILITY ELEMENT MEANT TO BE FLUSH WITH GRADE (CLEAN OUT MANHOLES, CATCH BASINS, INLETS, ETC.) THAT IS AFFECTED BY SITE WORK OR GRADE CHANGES, WHETHER SPECIALLY NOTED ON PLANS OR NOT.
106. A SIGN SHALL BE PLACED AT IRRIGATED AREAS WITH THE WORDS "IRRIGATION BY REUSE WATER, DO NOT DRINK".
107. CONTRACTOR SHALL NOTIFY THE MUNICIPALITY PUBLIC UTILITIES CONSTRUCTION DEPARTMENT 48 HOURS PRIOR TO ANY UTILITIES CONSTRUCTION.

108. GENERAL CONSTRUCTION BEST MANAGEMENT PRACTICES SHALL BE EMPLOYED TO MINIMIZE SOIL EROSION AND POTENTIAL POOR SOPE. THE CONTRACTOR SHALL BE RESPONSIBLE FOR THE REQUIRED TESTING. THESE PLANS, THE VARIOUS AGENCIES AND PERMIT CONDITIONS SHOULD ANY RETESTING BE REQUIRED DUE TO THE FAILURE OF ANY TESTS TO MEET THE REQUIREMENTS OF THE CONTRACTOR WILL BEAR ALL COSTS OF SAID RETESTING.
109. WHERE APPLICABLE UTILITY TRENCHES CROSSING PAVEMENT AREAS SHALL BE BACKFILLED WITH GRANULAR MATERIAL IN TWELVE (12) LAYERS AND COMPACTED TO NINETY EIGHT PERCENT (98%) MAXIMUM DENSITY AS DETERMINED BY ASTM D-1557 OR T-99.
110. ALL UNSUITABLE MATERIALS UNDER WATER PIPES SHALL BE REMOVED AND REPLACED WITH SELECTED BACKFILL COMPACTED TO NINETY-FIVE PERCENT (95%) OF ITS MAXIMUM DENSITY AT TWO PERCENT (2.00) MOORE OR LESS OF OPTIMUM MOISTURE CONTENT AS DETERMINED BY THE MODIFIED PROCTOR TEST (ASTM D1557).
111. CONTRACTOR IS TO ADJUST ANY UTILITY ELEMENT MEANT TO BE FLUSH WITH GRADE (CLEAN OUT MANHOLES, CATCH BASINS, INLETS, ETC.) THAT IS AFFECTED BY SITE WORK OR GRADE CHANGES, WHETHER SPECIALLY NOTED ON PLANS OR NOT.
112. A SIGN SHALL BE PLACED AT IRRIGATED AREAS WITH THE WORDS "IRRIGATION BY REUSE WATER, DO NOT DRINK".
113. CONTRACTOR SHALL NOTIFY THE MUNICIPALITY PUBLIC UTILITIES CONSTRUCTION DEPARTMENT 48 HOURS PRIOR TO ANY UTILITIES CONSTRUCTION.

114. GENERAL CONSTRUCTION BEST MANAGEMENT PRACTICES SHALL BE EMPLOYED TO MINIMIZE SOIL EROSION AND POTENTIAL POOR SOPE. THE CONTRACTOR SHALL BE RESPONSIBLE FOR THE REQUIRED TESTING. THESE PLANS, THE VARIOUS AGENCIES AND PERMIT CONDITIONS SHOULD ANY RETESTING BE REQUIRED DUE TO THE FAILURE OF ANY TESTS TO MEET THE REQUIREMENTS OF THE CONTRACTOR WILL BEAR ALL COSTS OF SAID RETESTING.
115. WHERE APPLICABLE UTILITY TRENCHES CROSSING PAVEMENT AREAS SHALL BE BACKFILLED WITH GRANULAR MATERIAL IN TWELVE (12) LAYERS AND COMPACTED TO NINETY EIGHT PERCENT (98%) MAXIMUM DENSITY AS DETERMINED BY ASTM D-1557 OR T-99.
116. ALL UNSUITABLE MATERIALS UNDER WATER PIPES SHALL BE REMOVED AND REPLACED WITH SELECTED BACKFILL COMPACTED TO NINETY-FIVE PERCENT (95%) OF ITS MAXIMUM DENSITY AT TWO PERCENT (2.00) MOORE OR LESS OF OPTIMUM MOISTURE CONTENT AS DETERMINED BY THE MODIFIED PROCTOR TEST (ASTM D1557).
117. CONTRACTOR IS TO ADJUST ANY UTILITY ELEMENT MEANT TO BE FLUSH WITH GRADE (CLEAN OUT MANHOLES, CATCH BASINS, INLETS, ETC.) THAT IS AFFECTED BY SITE WORK OR GRADE CHANGES, WHETHER SPECIALLY NOTED ON PLANS OR NOT.
118. A SIGN SHALL BE PLACED AT IRRIGATED AREAS WITH THE WORDS "IRRIGATION BY REUSE WATER, DO NOT DRINK".
119. CONTRACTOR SHALL NOTIFY THE MUNICIPALITY PUBLIC UTILITIES CONSTRUCTION DEPARTMENT 48 HOURS PRIOR TO ANY UTILITIES CONSTRUCTION.

120. GENERAL CONSTRUCTION BEST MANAGEMENT PRACTICES SHALL BE EMPLOYED TO MINIMIZE SOIL EROSION AND POTENTIAL POOR SOPE. THE CONTRACTOR SHALL BE RESPONSIBLE FOR THE REQUIRED TESTING. THESE PLANS, THE VARIOUS AGENCIES AND PERMIT CONDITIONS SHOULD ANY RETESTING BE REQUIRED DUE TO THE FAILURE OF ANY TESTS TO MEET THE REQUIREMENTS OF THE CONTRACTOR WILL BEAR ALL COSTS OF SAID RETESTING.
121. WHERE APPLICABLE UTILITY TRENCHES CROSSING PAVEMENT AREAS SHALL BE BACKFILLED WITH GRANULAR MATERIAL IN TWELVE (12) LAYERS AND COMPACTED TO NINETY EIGHT PERCENT (98%) MAXIMUM DENSITY AS DETERMINED BY ASTM D-1557 OR T-99.
122. ALL UNSUITABLE MATERIALS UNDER WATER PIPES SHALL BE REMOVED AND REPLACED WITH SELECTED BACKFILL COMPACTED TO NINETY-FIVE PERCENT (95%) OF ITS MAXIMUM DENSITY AT TWO PERCENT (2.00) MOORE OR LESS OF OPTIMUM MOISTURE CONTENT AS DETERMINED BY THE MODIFIED PROCTOR TEST (ASTM D1557).
123. CONTRACTOR IS TO ADJUST ANY UTILITY ELEMENT MEANT TO BE FLUSH WITH GRADE (CLEAN OUT MANHOLES, CATCH BASINS, INLETS, ETC.) THAT IS AFFECTED BY SITE WORK OR GRADE CHANGES, WHETHER SPECIALLY NOTED ON PLANS OR NOT.
124. A SIGN SHALL BE PLACED AT IRRIGATED AREAS WITH THE WORDS "



SITE DATA

PARCEL ID#:	9024-0541-01
PROJECT AREA:	0.457 ACRES 19,885 SF
EXISTING ZONING:	R-3
PROPOSED USE:	QUAD FLEX-APARTMENTS
BUILDING:	2,400 SF
MAX BUILDING HEIGHT:	40'-0"
PROVIDED BUILDING HEIGHT:	26'-0"
NUMBER OF STORIES:	2
DENSITY:	MAX. 16 UNITS/AC.

DENSITY ALLOWED: MAX. 7 UNITS/AC.
MIN. 2 UNITS/AC.

PROPOSED UNITS:

3 BEDROOMS: 4 UNITS

TOTAL PROPOSED UNITS: 4 UNITS

PARKING REQUIRED:

3 BEDROOM: 2 SPACES/D.U.= 2 X 4 = 8 SPACES

TOTAL REQUIRED PARKING: 8 SPACES

PARKING PROVIDED

REGULAR SPACES (9'x18')	8 SPACES
TOTAL SPACES	8 SPACES

MAXIMUM IMPERVIOUS AREA:

MINOR SITE PLAN 35% IMPERVIOUS MAX. =6967 SF

PROPOSED IMPERVIOUS AREA:



IMPERVIOUS AREA (PARKING, SIDEWALK, ETC.):	3,681 SF
BUILDING:	2,400 SF
TOTAL IMPERVIOUS AREA	6,081 SF

BUILDING SETBACKS:


FRONT	25 FEET
REAR	25 FEET
SIDE	8 FEET
SIDE	8 FEET

LANDSCAPE BUFFER:


FRONT	15 FEET
REAR	0 FEET
SIDE	0 FEET
SIDE	0 FEET

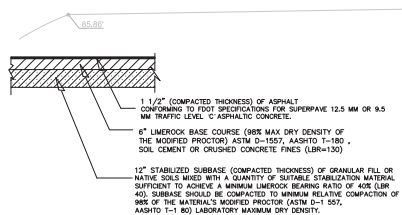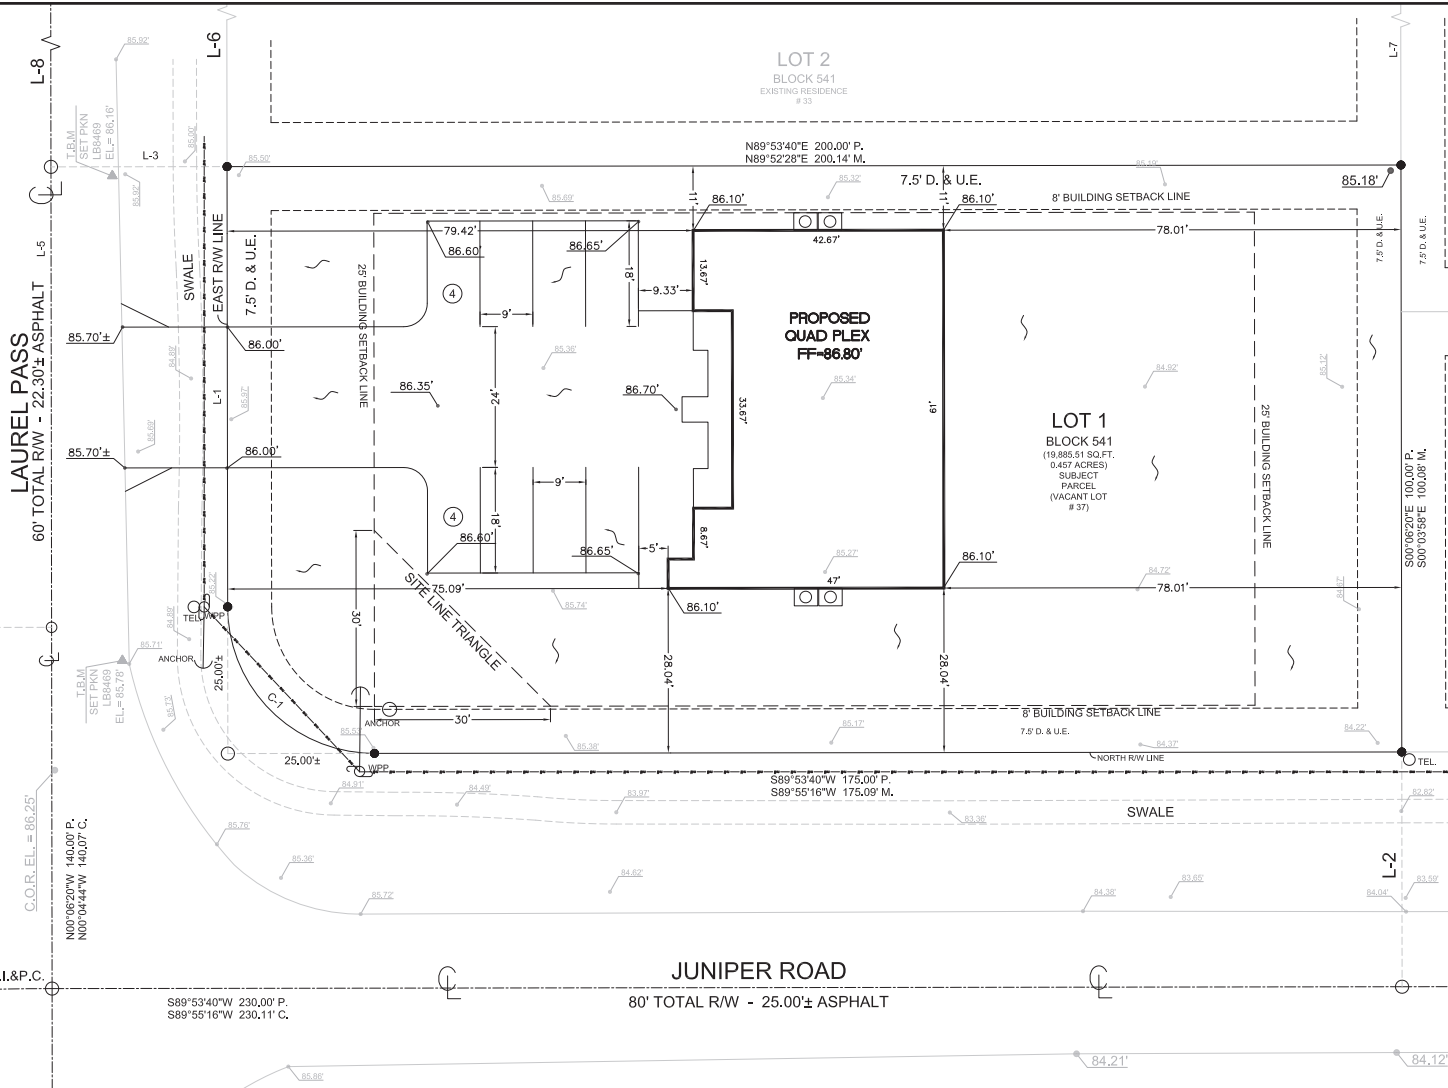

TYPICAL PAVEMENT SECTION
N.T.S.

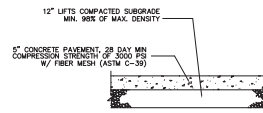

CONCRETE DRIVE ISLE DETAIL ON SITE

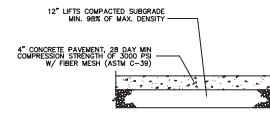

CONCRETE SIDEWALK DETAIL ON SITE

QUAD PLEX 37 LAUREL PASS OCALA, FL 34480 FLORIDA	DATE 03/25		SCALE/AS NOTED DESIGNED BY SAT DRAWN BY SAT CHECKED BY CSL SEAL	DESIGN ENGINEER: CHAD S. LUNN, P.E. FLORIDA REGISTRATION NUMBER 57524	LINN ENGINEERING & DESIGN, INC. P.O. BOX 140094 ORLANDO, FL 32814 PHONE 407/7561194 dlinn@linnengineering.com CAL Lic. No. 211710	LOT # 1	No. _____ REVISIONS _____ DATE _____ BY _____
	PROJECT NO. 363000-25-200						
	SHEET NUMBER C04						
	SITE/GRADING PLAN						

SITE DATA

PARCEL ID: 9024-0541-01
PROJECT AREA: 0.457 ACRES (19,885 SF)
PROPOSED USE: QUADPLEX APARTMENTS
EXISTING ZONING: R-3
BUILDING: 2,400 SF/FLOOR
MAX BUILDING HEIGHT: 40'-0"
PROVIDED BUILDING HEIGHT: 26'-0"
NUMBER OF STORIES: 2
DENSITY: MAX. 16 UNITS/AC
URBAN RESIDENTIAL: MIN. 8 UNITS/AC
DENSITY ALLOWED: MAX. 7 UNITS
MIN. 4 UNITS

BUILDING SETBACKS REQUIRED

FRONT SETBACK 25'
SIDE SETBACK 8'
REAR SETBACK 25'

LANDSCAPE BUFFERS

FRONT BUFFER 0' (WEST ROW)
SIDE BUFFER 0' (NORTH R-3) 0' (SOUTH ROW)
REAR BUFFER 30' TYPE A (EAST B-4)

REQUIRED PARKING SPACES:

4 UNITS: 2 SPACES/DU = 2 X 4 = 8 SPACES
REQUIRED SPACES: 8 SPACES

PARKING PROVIDED:

STANDARD 90' PARKING (9' X 18'): 7
HANDICAP SPACES (12' X 18'): 1
TOTAL SPACES PROVIDED: 8 SPACES

MAXIMUM IMPERVIOUS AREA:

MINOR SITE PLAN 35% IMPERVIOUS MAX = 6,967 SF

PROPOSED IMPERVIOUS AREA:

IMPERVIOUS AREA (PARKING, SIDEWALK, ETC.) 0.088 AC (3,837 SF)
BUILDING 0.055 AC (2,400 SF)
TOTAL IMPERVIOUS AREA: 0.143 AC (6,237 SF) (31%)

1 1/2" (COMPACTED THICKNESS) OF ASPHALT CONFORMING TO FOOT SPECIFICATIONS FOR SUPERPAVE 12.5 MM OR 9.5 MM TRAFFIC LEVEL, "C" ASPHALTIC CONCRETE.
6" LIMEPOCK BASE COURSE (98% MAX DRY DENSITY OF THE MODIFIED PROCTOR) ASTM D-1557, AASHTO T-180, 50% CEMENT OR CRUSHED CONCRETE FINES (USP#100)
12" STABILIZED SUBGRADE (COMPACTED THICKNESS) OF GRANULAR FILL OR NATIVE SOILS MIXED WITH A QUANTITY OF SUITABLE STABILIZATION MATERIAL SUFFICIENT TO ACHIEVE A MINIMUM LIMEPOCK BEARING RATIO OF 40% (LBR 40). SUBGRADE SHOULD BE COMPACTED TO MINIMUM RELATIVE COMPACTION OF 98% OF THE MATERIAL'S MODIFIED PROCTOR (ASTM D-1557, AASHTO T-180) LABORATORY MAXIMUM DRY DENSITY.

TYPICAL PAVEMENT SECTION

N.T.S.

12" LITS COMPACTED SUBGRADE MIN. 98% OF MAX. DENSITY
8" CONCRETE PAVEMENT, 28 DAY MIN COMPRESSION STRENGTH OF 3000 PSI W/ FIBER MESH (ASTM C-39)

CONCRETE DRIVE ISLE DETAIL ON SITE

12" LITS COMPACTED SUBGRADE MIN. 98% OF MAX. DENSITY
4" CONCRETE PAVEMENT, 28 DAY MIN COMPRESSION STRENGTH OF 3000 PSI W/ FIBER MESH (ASTM C-39)


CONCRETE SIDEWALK DETAIL ON SITE

NOTE:

1. PROPERTY IS WITHIN THE PRIMARY SPRINGS PROTECTION OVERLAY ZONE
2. SIDEWALK FEE CONTRIBUTION IN LIEU OF SIDEWALK CONSTRUCTION.
3. THIS PROPOSED PROJECT HAS NOT BEEN GRANTED CONCURRENCY APPROVAL AND/OR GRANTED AND/OR RESERVED ANY PUBLIC FACILITY CAPACITIES. FUTURE RIGHTS TO DEVELOP THE PROPERTY ARE SUBJECT TO A DEFERRED CONCURRENCY DETERMINATION, AND FINAL APPROVAL TO DEVELOP THE PROPERTY HAS NOT BEEN OBTAINED. THE COMPLETION OF CONCURRENCY REVIEW AND/OR APPROVAL HAS BEEN DEFERRED TO LATER DEVELOPMENT REVIEW STAGES, SUCH AS, BUT NOT LIMITED TO, BUILDING PERMIT REVIEW.



SCALE AS SHOWN

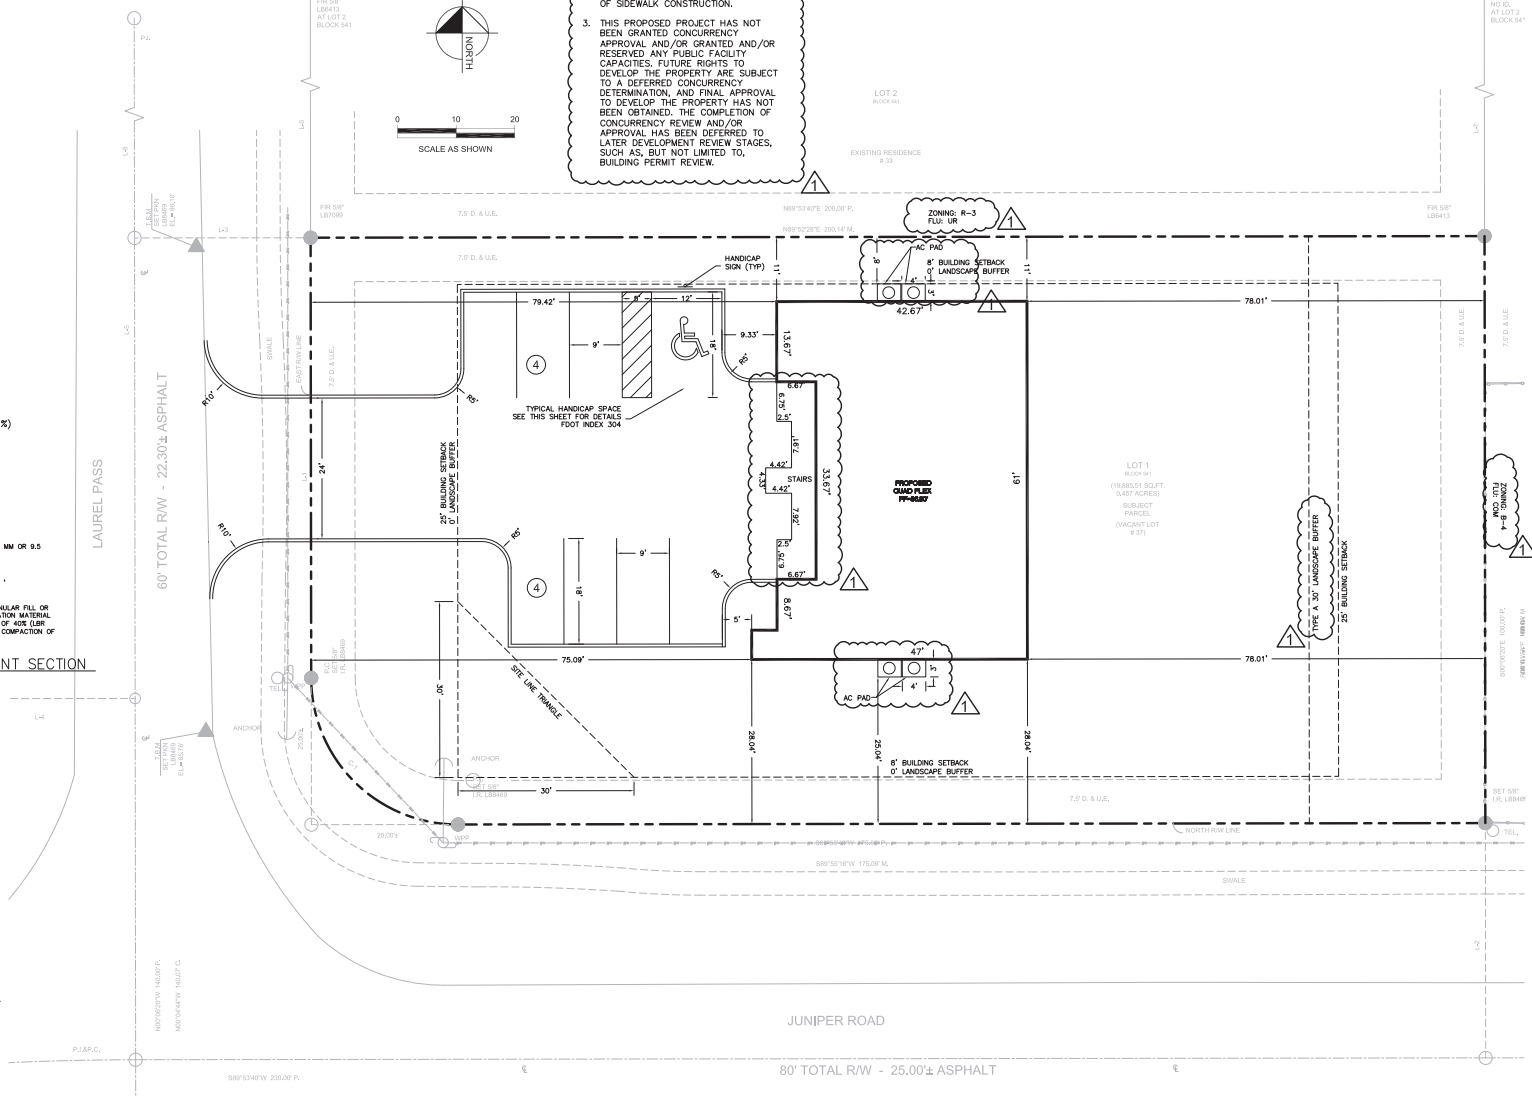


NO.	REVISIONS	DATE	BY

DESIGNED BY: SAT
DRAWN BY: SAT
CHECKED BY: CSJ
SCALE: NOTED
DESIGN ENGINEER: CHAD S. LINN, P.E.
FLORIDA REGISTRATION NUMBER: 57524
SEAL


MINOR SITE PLAN-QUADPLEX
37 LAUREL PASS
OCALA, FL 34480
MARION COUNTY
FLORIDA

SITE PLAN

DATE: 03/25
PROJECT NO: 36300-25-200
SHEET NUMBER: C04

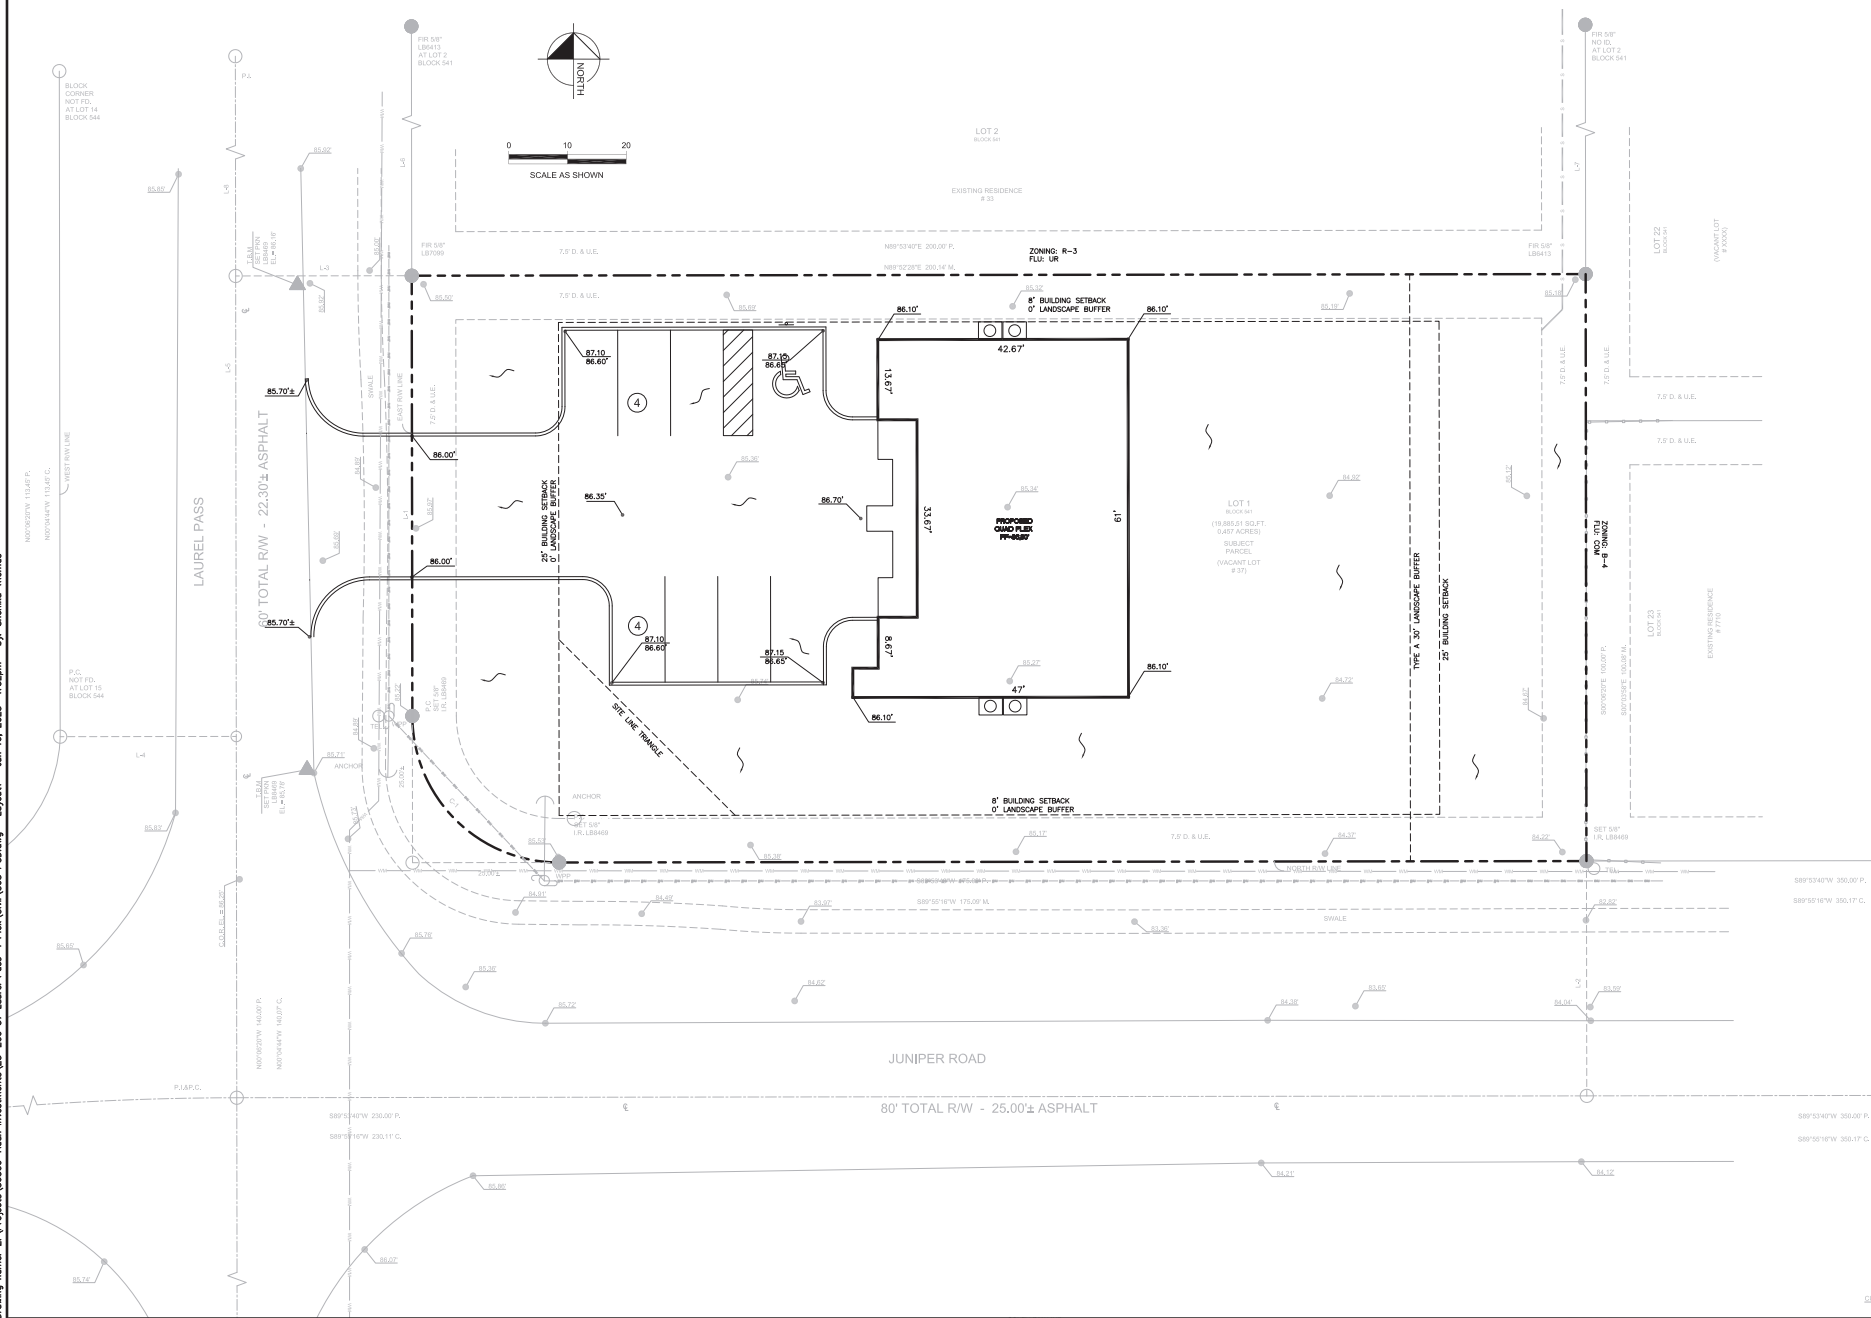


<div> <div>MINOR SITE PLAN- QUADPLEX</div> <div>37 LAUREL PASS</div> <div>OCALA, FL 34480</div> </div>	<div> <div>FLORIDA</div> <div>MARION COUNTY</div> </div>	<div> <div>DATE</div> <div>03/25</div> </div>	<div> <div>PROJECT NO.</div> <div>36300-25-200</div> </div>	<div> <div>SHEET NUMBER</div> <div>C05</div> </div>	<div> <div>SCALE(S) NOTED</div> <div>AS SHOWN</div> </div>	<div> <div>DESIGNER</div> <div>CHAD S. LINN, P.E.</div> </div>	<div> <div>ENGINEER/STAMP</div> <div> <div> <div>CHAD S. LINN, P.E.</div> <div>FLORIDA REGISTRATION NUMBER</div> <div>57524</div> </div> </div> </div>	<div> <div>DESIGNED BY</div> <div>SAT</div> </div>	<div> <div>DRAWN BY</div> <div>SAT</div> </div>	<div> <div>CHECKED BY</div> <div>CSL</div> </div>	<div> <div>SEAL</div> </div>	<div> <div>OWNER</div> <div> <div> <div>CHAD S. LINN, P.E.</div> <div>FLORIDA REGISTRATION NUMBER</div> <div>57524</div> </div> </div> </div>	<div> <div>REVISIONS</div> </div>	<div> <div>DATE</div> </div>	<div> <div>BY</div> </div>	<div> <div>REVISIONS PER FOOT/COUNT</div> <div>COMMENTS</div> </div>
																<div> <div>REVISIONS PER FOOT/COUNT</div> <div>COMMENTS</div> </div>

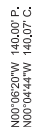


- NOTE: THE AUSA SHALL HAVE THE AUTHORITY TO REFUSE ACCESS TO ANY AREA THAT IS NOT INSTALLED IN AN ACCESSIBLE LOCATION WHERE AN ACCESS TO BE WITHIN A SPECIFIED DISTANCE OF THE PROTECTIVE EQUIPMENT OR DEVICES. FIRE PROTECTION SYSTEMS OR APPLIANCES ARE REQUIRED) (NFPA 70B, SECTION 1307 (NFPA 1, FIRE CODE, 2018 EDITION, ARTICLE 18-2.2.1)). THE CITY OF CHICAGO POLICE DEPARTMENT'S KNOX BOX SYSTEM (KNOX BOX) CAN BE ORDERED THROUGH THE WEB AND MUST BE INSTALLED BY THE CITY OF CHICAGO POLICE DEPARTMENT. THE KNOX BOX SYSTEM THE KEY KEYS ARE THE RESPONSIBILITY OF THE USER OF THE KNOX BOX. OWNER OR CONTRACTOR, THE ACCESS BOX SHALL BE INSTALLED AND LOCATED:
- a. AT OR NEAR THE RECOGNIZED MAIN PUBLIC ENTRANCE ON THE EXTERIOR OF THE STRUCTURE WITH LOCATIONS TO BE APPROVED BY THE FIRE SAFETY DIVISION.
- b. THE ACCESS BOX SHALL BE LOCATED AT A HEIGHT OF NOT LESS THAN SIX (6) FEET ABOVE THE GROUND SURFACE.
- c. THE ACCESS BOX SHALL BE INSTALLED IN ACCORDANCE WITH THE MANUFACTURER'S RECOMMENDATIONS AND LISTING.
- d. NO STOPS, DISPLAYS, SIGNS OR OTHER FIXTURES, OR STRUCTURAL OBSTRUCTIONS SHALL BE LOCATED IN FRONT OF THE BOX, WHICH WOULD ALLOW INTERLUDES TO ACCESS THE BOX WITHOUT ASSISTANCE.
- e. A KNOX BOX SHALL BE LOCATED AT THE ENTRANCE TO THE BUILDINGS FOR ALL OCCUPANCY TYPES WHERE FIRE PROTECTION SYSTEMS OR APPLIANCES ARE REQUIRED. PROVIDE THE KNOX BOX LOCATION TO THE CHICAGO POLICE DEPARTMENT.
- f. IF A NEW HYDRANT IS INSTALLED SHALL BE INSTALLED, TESTED, AND PAINTED WITH RED PAINT. THE CHICAGO POLICE DEPARTMENT WILL BE NOTIFIED BY A MARION COUNTY FIRE INSPECTOR. PLEASE NOTE FIRE HYDRANT LOCATIONS ARE SHOWN ON THE CHICAGO POLICE DEPARTMENT'S MAP OF THE ROADWAY LINE CLOSEST TO THE HYDRANT.
- g. MCD PERSONNEL ARE TO INSPECT ANY WORK PERFORMED ON OR AROUND THE HYDRANT. ANY VIOLATION OF THE RULES OF THE HYDRANT PROGRAM WILL BE HELD A MINIMUM OF 48 HOURS PRIOR TO START OF ANY WORK. ANY VIOLATION OF THE RULES OF THE HYDRANT PROGRAM WILL BE HELD A MINIMUM OF 48 HOURS PRIOR TO START OF ANY WORK. ANY VIOLATION OF THE RULES OF THE HYDRANT PROGRAM WILL BE HELD A MINIMUM OF 48 HOURS PRIOR TO START OF ANY WORK.

[illegible][illegible]

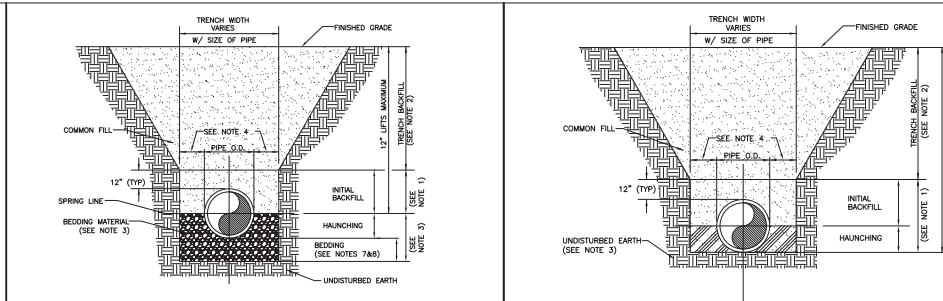

- NOTES:
- INITIAL BACKFILL: COMMON FILL COMPACTED TO 95% (98% UNDER PAVEMENT) OF THE MAXIMUM DENSITY AS PER AASHTO T-180.
 - TRENCH BACKFILL: COMMON FILL COMPACTED TO 95% (98% UNDER PAVEMENT) OF THE MAXIMUM DENSITY AS PER AASHTO T-180.
 - BEDDING MATERIAL SHALL CONFORM TO FOOT NO. 67 AGGREGATE.
 - 15" MAX (12" MIN) FOR PIPE DIAMETER LESS THAN 24" AND 24" MAX (12" MIN) FOR PIPE DIAMETER 24" AND LARGER.
 - WATER SHALL NOT BE PERMITTED IN THE TRENCH DURING CONSTRUCTION.
 - ALL PIPE TO BE INSTALLED WITH BELL FACING UPSTREAM TO THE DIRECTION OF THE FLOW.
 - BEDDING DEPTH SHALL BE 4" MINIMUM FOR PIPE DIAMETER UP TO 12" AND 6" MINIMUM FOR PIPE DIAMETER 16" AND LARGER.
 - DEPTH FOR REMOVAL OF UNSUITABLE MATERIAL SHALL GOVERN DEPTH OF BEDDING ROW BELOW THE PIPE. UTILITIES SHALL DETERMINE IN THE FIELD REQUIRED REMOVAL OF UNSUITABLE MATERIAL TO REACH SUITABLE FOUNDATION.
 - RESTORATION IN IMPROVED AREAS SHALL BE IN COMPLIANCE WITH ALL APPLICABLE REGULATIONS OF COVERING AGENCIES. SURFACE RESTORATION WITHIN MARION COUNTY RIGHT-OF-WAY SHALL COMPLY WITH REQUIREMENTS OF RIGHT-OF-WAY UTILIZATION REGULATIONS AND ROAD CONSTRUCTION SPECIFICATIONS.
 - ONE COMPACTION TEST SHALL BE REQUIRED FOR EACH LIFT NOT TO EXCEED 200'.
- NOTES:
- INITIAL BACKFILL AND HAUNCHING: SELECT COMMON FILL COMPACTED TO 95% (98% UNDER PAVEMENT) OF THE MAXIMUM DENSITY AS PER AASHTO T-180.
 - TRENCH BACKFILL: COMMON FILL COMPACTED TO 95% (98% UNDER PAVEMENT) OF THE MAXIMUM DENSITY AS PER AASHTO T-180.
 - PIPE BEDDING UTILIZING SELECT COMMON FILL OR BEDDING ROCK IN ACCORDANCE WITH BEDDING AND TRENCHING 1 DETAIL MAY BE REQUIRED AS DIRECTED BY MCUL.
 - 15" MAX (12" MIN) FOR PIPE DIAMETER LESS THAN 24" AND 24" MAX (12" MIN) FOR PIPE DIAMETER 24" AND LARGER.
 - WATER SHALL NOT BE PERMITTED IN THE TRENCH DURING CONSTRUCTION.
 - ALL PIPE TO BE INSTALLED WITH BELL FACING UPSTREAM TO THE DIRECTION OF THE FLOW.
 - FINAL RESTORATION IN IMPROVED AREAS SHALL BE IN COMPLIANCE WITH ALL APPLICABLE REGULATIONS OF COVERING AGENCIES. SURFACE RESTORATION WITHIN MARION COUNTY RIGHT-OF-WAY SHALL COMPLY WITH REQUIREMENTS OF RIGHT-OF-WAY UTILIZATION REGULATIONS AND ROAD CONSTRUCTION SPECIFICATIONS.
 - ONE COMPACTION TEST SHALL BE REQUIRED FOR EACH LIFT NOT TO EXCEED 200'.

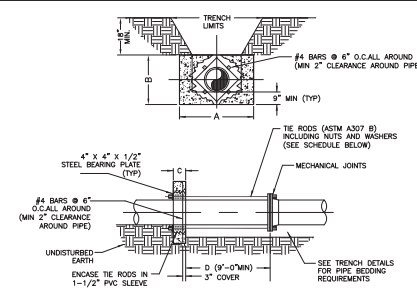

SCHEDULE OF DIMENSIONS AND MATERIALS									
PIPE SIZE (INCHES)	A	B	C	D	DIAM.	NO.			
6	2.0	2.0	1.0		3/4	2			
8	2.5	2.5	1.0		3/4	2			
10	3.5	3.0	1.0		3/4	4			
12	5.0	3.0	1.0		3/4	4			
16	6.0	4.0	1.5		3/4	4			
20	8.0	5.0	1.5		3/4	6			
24	9.0	6.0	1.5		3/4	8			

NOTE: THRUST COLLAR AREA TO BE COMPUTED ON BASIS OF 2000 LB/SQ' SOIL RESTRAINT BEARING.

- NOTES:
- ADDITIONAL REINFORCEMENTS SHALL BE AS SPECIFIED BY THE ENGINEER.
 - MINIMUM COMPRESSIVE STRENGTH FOR CONCRETE SHALL BE 3000 PSI.
 - BEDDING, BACKFILL, AND COMPACTION SHALL BE AS SPECIFIED ELSEWHERE IN THE LAND DEVELOPMENT CODE.
 - ALL FORM BOARDS SHALL BE REMOVED PRIOR TO BACKFILL.
 - NO ALLOWANCE SHALL BE MADE FOR FRICTION BETWEEN THE PIPE WALL AND THE THRUST COLLAR.
 - DESIGN PRESSURE: 150 PSI.

Marion County UTILITIES

MBCC EFFECTIVE 04/13/2023

REVISION # 2

BEDDING AND TRENCHING 1

7.3.2 UT 102

Marion County UTILITIES

MBCC EFFECTIVE 04/13/2023

REVISION # 2

BEDDING AND TRENCHING 2

7.3.2 UT 103


Marion County UTILITIES

MBCC EFFECTIVE 04/13/2023

REVISION # NA

THRUST COLLAR WATER MAINS

7.3.2 UT 201

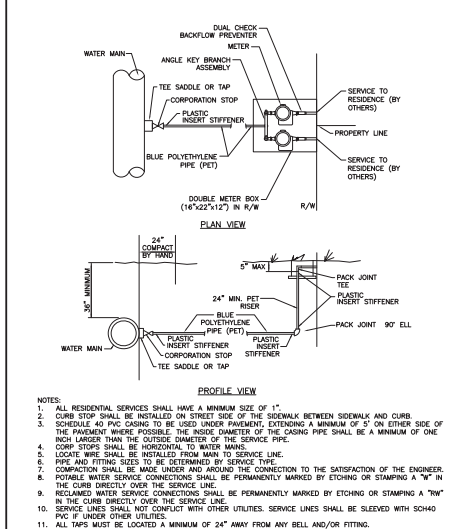

- NOTES:
- RESIDENTIAL SERVICES SHALL HAVE A MINIMUM SIZE OF 12".
 - CURB STOP SHALL BE INSTALLED ON STREET SIDE OF THE SIDEWALK BETWEEN SIDEWALK AND CURB.
 - SOMEWHAT PVC CURB TO BE USED UNDER PAVEMENT, EXTENDING A MINIMUM OF 5' ON EITHER SIDE OF THE PAVEMENT WHERE POSSIBLE. THE INSIDE DIAMETER OF THE CASING PIPE SHALL BE A MINIMUM OF ONE INCH LARGER THAN THE OUTSIDE DIAMETER OF THE SERVICE PIPE.
 - LOCATE WIRE SHALL BE INSTALLED FROM MAIN TO SERVICE LINE.
 - COMP STOPS SHALL BE HORIZONTAL TO WATER MAINS.
 - PIPE AND FITTING SIZES TO BE DETERMINED BY SERVICE TYPE.
 - CONNECTION SHALL BE MADE UNDER AND AROUND THE CONNECTION TO THE SATISFACTION OF THE ENGINEER.
 - POTABLE WATER SERVICE CONNECTIONS SHALL BE PERMANENTLY MARKED BY ETCHING OR STAMPING A "W" IN THE CURB DIRECTLY OVER THE SERVICE LINE.
 - RECLAIMED WATER SERVICE CONNECTIONS SHALL BE PERMANENTLY MARKED BY ETCHING OR STAMPING A "RW" IN THE CURB DIRECTLY OVER THE SERVICE LINE.
 - SERVICE LINES SHALL NOT CONFLICT WITH OTHER UTILITIES. SERVICE LINES SHALL BE SLEEVES WITH 30:40 PVC IF UNDER OTHER UTILITIES.
 - ALL TAPS MUST BE LOCATED A MINIMUM OF 24" AWAY FROM ANY BELL AND/OR FITTING.

Marion County UTILITIES

MBCC EFFECTIVE 04/13/2023

REVISION # 2

WATER AND RECLAIMED WATER SERVICES (TYPICAL)

7.3.2 UT 107


Marion County UTILITIES

MBCC EFFECTIVE 04/13/2023

REVISION # NA

TYPICAL VALVE BOX COVER

7.3.2 UT 110

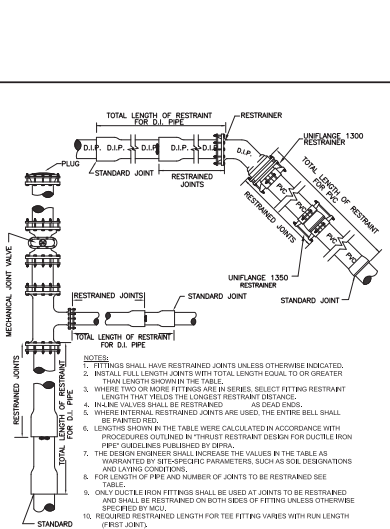

- NOTES:
- FITTINGS SHALL HAVE RESTRAINED JOINTS UNLESS OTHERWISE INDICATED.
 - INSTALL FULL LENGTH JOINTS WITH TOTAL LENGTH EQUAL TO OR GREATER THAN LENGTH SHOWN IN THE TABLE.
 - WHERE TWO OR MORE FITTINGS ARE IN SERIES, SELECT FITTING RESTRAINT LENGTH THAT YIELDS THE LONGEST RESTRAINT DISTANCE.
 - IN-LINE VALVES SHALL BE RESTRAINED.
 - WHERE INTERNAL RESTRAINED JOINTS ARE USED, THE ENTIRE BELL SHALL BE PARTIALLY RESTRAINED.
 - LENGTHS SHOWN IN THE TABLE WERE CALCULATED IN ACCORDANCE WITH PROCEDURES OUTLINED IN THRUST RESTRAINT DESIGN FOR DUCTILE IRON PIPE GUIDELINES PUBLISHED BY CPRI.
 - THE DESIGNER SHALL INCREASE THE VALUES IN THE TABLE AS WARRANTED BY SITE-SPECIFIC PARAMETERS, SUCH AS SOIL DESIGNATIONS AND LAYING CONDITIONS.
 - FOR LENGTH OF PIPE AND NUMBER OF JOINTS TO BE RESTRAINED SEE TABLE.
 - ONLY DUCTILE IRON FITTINGS SHALL BE USED AT JOINTS TO BE RESTRAINED AND SHALL BE RESTRAINED ON BOTH SIDES OF FITTING UNLESS OTHERWISE SPECIFIED BY MCUL.
 - REQUIRED RESTRAINT LENGTH FOR TEE FITTINGS VARIES WITH RUN LENGTH (FIRST JOINT).

Marion County UTILITIES

MBCC EFFECTIVE 04/13/2023

REVISION # NA

RESTRAINED PIPE TABLE

7.3.2 UT 116 A

MINIMUM RESTRAINT LENGTH (FT)

— EACH SIDE OF FITTING AND VALVE

FOR DIP, PE ENCASED DIP OR BARE PVC

WATER MAIN; PRESSURE: 150 PSI; DEPTH OF COVER: 3.0 ft.

HORIZONTAL-UP

VERTICAL-UP

VERTICAL-DOWN

REQUIRED RESTRAINT LENGTH ON WATER MAIN

Joint Type	4"	6"	8"	10"	12"	16"	20"	24"	30"
Angle Description	1	1	1	1	1	1	1	1	1
11-1/2"	2	3	4	5	6	8	10	12	15
20-1/2"	3	4	5	6	8	10	12	15	18
24-1/2"	4	5	6	8	10	12	15	18	22
30-1/2"	5	6	8	10	12	15	18	22	27
36-1/2"	6	8	10	12	15	18	22	27	33
42-1/2"	7	10	12	15	18	22	27	33	40
48-1/2"	8	11	13	16	19	23	28	35	43
54-1/2"	9	12	15	18	21	26	32	40	49
60-1/2"	10	13	16	19	23	28	35	43	53
66-1/2"	11	14	17	21	25	31	38	47	58
72-1/2"	12	15	18	22	27	33	41	51	63
78-1/2"	13	16	19	23	28	35	43	54	67
84-1/2"	14	17	20	24	29	36	45	56	70
90-1/2"	15	18	21	25	30	37	46	58	73
96-1/2"	16	19	22	26	31	38	47	59	76
102-1/2"	17	20	23	27	32	39	48	60	79
600-1/2"	100	103	106	110	115	122	131	143	328

REQUIRED RESTRAINT LENGTH ON STEEL BRANCH

TEE FITTING	Angle of Branch									
	4"	6"	8"	10"	12"	16"	20"	24"	30"	
Diameter of Branch	4"	4"	4"	4"	4"	4"	4"	4"	4"	
	6"	4"	4"	4"	4"	4"	4"	4"	4"	
	8"	4"	4"	4"	4"	4"	4"	4"	4"	
	10"	4"	4"	4"	4"	4"	4"	4"	4"	
	12"	4"	4"	4"	4"	4"	4"	4"	4"	
	16"	4"	4"	4"	4"	4"	4"	4"	4"	
	20"	4"	4"	4"	4"	4"	4"	4"	4"	
	24"	4"	4"	4"	4"	4"	4"	4"	4"	
	30"	4"	4"	4"	4"	4"	4"	4"	4"	
	36"	4"	4"	4"	4"	4"	4"	4"	4"	

REQUIRED RESTRAINT LENGTH ON LUGGER PIPE

TEE FITTING	Angle of Lugger Pipe									
	4"	6"	8"	10"	12"	16"	20"	24"	30"	
Diameter of Branch	4"	4"	4"	4"	4"	4"	4"	4"	4"	
	6"	4"	4"	4"	4"	4"	4"	4"	4"	
	8"	4"	4"	4"	4"	4"	4"	4"	4"	
	10"	4"	4"	4"	4"	4"	4"	4"	4"	
	12"	4"	4"	4"	4"	4"	4"	4"	4"	
	16"	4"	4"	4"	4"	4"	4"	4"	4"	
	20"	4"	4"	4"	4"	4"	4"	4"	4"	
	24"	4"	4"	4"	4"	4"	4"	4"	4"	
	30"	4"	4"	4"	4"	4"	4"	4"	4"	
	36"	4"	4"	4"	4"	4"	4"	4"	4"	

REQUIRED RESTRAINT LENGTH ON STEEL BRANCH

TEE FITTING	Angle of Branch									
	4"	6"	8"	10"	12"	16"	20"	24"	30"	
Diameter of Branch	4"	4"	4"	4"	4"	4"	4"	4"	4"	
	6"	4"	4"	4"	4"	4"	4"	4"	4"	
	8"	4"	4"	4"	4"	4"	4"	4"	4"	
	10"	4"	4"	4"	4"	4"	4"	4"	4"	
	12"	4"	4"	4"	4"	4"	4"	4"	4"	
	16"	4"	4"	4"	4"	4"	4"	4"	4"	
	20"	4"	4"	4"	4"	4"	4"	4"	4"	
	24"	4"	4"	4"	4"	4"	4"	4"	4"	
	30"	4"	4"	4"	4"	4"	4"	4"	4"	
	36"	4"	4"	4"	4"	4"	4"	4"	4"	

REQUIRED RESTRAINT LENGTH ON LUGGER PIPE

TEE FITTING	Angle of Lugger Pipe									
	4"	6"	8"	10"	12"	16"	20"	24"	30"	
Diameter of Branch	4"	4"	4"	4"	4"	4"	4"	4"	4"	
	6"	4"	4"	4"	4"	4"	4"	4"	4"	
	8"	4"	4"	4"	4"	4"	4"	4"	4"	
	10"	4"	4"	4"	4"	4"	4"	4"	4"	
	12"	4"	4"	4"	4"	4"	4"	4"	4"	
	16"	4"	4"	4"	4"	4"	4"	4"	4"	
	20"	4"	4"	4"	4"	4"	4"	4"	4"	
	24"	4"	4"	4"	4"	4"	4"	4"	4"	
	30"	4"	4"	4"	4"	4"	4"	4"	4"	
	36"	4"	4"	4"	4"	4"	4"	4"	4"	

FORCE MAIN:

PRESSURE: 150 PSI.

DEPTH OF COVER: 4.0 ft.

MAJOR EFFECTIVE
DATE 05/20/2023


REVISION A

REINSTATE PIPE TABLE

7.3.2

UT

116

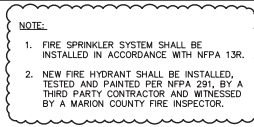

1

MINOR SITE PLAN- QUADPLEX

37 LAUREL PASS

OCALA, FL 34480

MARION COUNTY
FLORIDA

UTILITY PLAN

DATE

03/25

PROJECT NO.

36300-25-200

SHEET NUMBER

C06

DATE

BY

SCALES NOTED

DESIGNED BY SAT

DRAWN BY SAT

CHECKED BY CSL

DESIGN WORKERS

CHAO S. LINN, P.E.

FLORIDA REGISTRATION NUMBER:

57524

SEAL

LINN ENGINEERING

P.O. BOX 14024

DADE COUNTY, FL 33114

PHONE 407/2747194

dtlin@linnengineering.com

CA Lic. No.31710

REVISIONS

NO.

DATE

REVISIONS

NO.

DATE

REVISIONS

NO.

DATE

REVISIONS

NO.

DATE

REVISIONS





NO.

DATE


REVISIONS

NO.

DATE

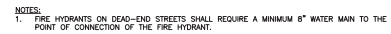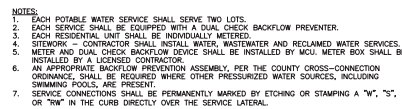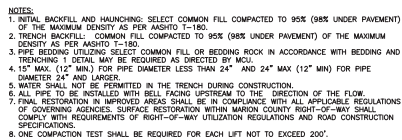
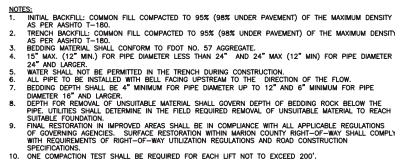


 MARION COUNTY UTILITIES	MCBCC EFFECTIVE 04/13/2023 REVISION # 2	BEDDING AND TRENCHING 1	7.3.2 UT 102	 MARION COUNTY UTILITIES	MCBCC EFFECTIVE 04/13/2023 REVISION # 2	BEDDING AND TRENCHING 2	7.3.2 UT 103	 MARION COUNTY UTILITIES	MCBCC EFFECTIVE 04/13/2023 REVISION # 2	RESIDENTIAL SERVICE LOCATIONS	7.3.2 UT 105	 MARION COUNTY UTILITIES	MCBCC EFFECTIVE 04/13/2023 REVISION # 1	SINGLE FAMILY RESIDENTIAL CUL-DE-SAC UTILITY PLAN	7.3.2 UT 106	60
---	---	-------------------------	--------------------	--	---	-------------------------	--------------------	---	---	-------------------------------	--------------------	---	---	--	--------------------	----




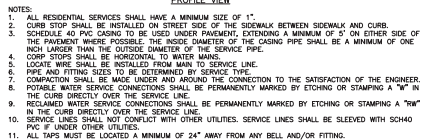


 Marion County OREGON ESTABLISHED 1857	MCBCC EFFECTIVE 04/13/2023 REVISION # 2	WATER AND RECLAIMED WATER SERVICES (TYPICAL)	7.3.2 UT 107	 Marion County OREGON ESTABLISHED 1857	MCBCC EFFECTIVE 04/13/2023 REVISION # NA	TYPICAL VALVE BOX COVER	7.3.2 UT 110	 Marion County OREGON ESTABLISHED 1857	MCBCC EFFECTIVE 04/13/2023 REVISION # 1	SEALED VALVE BOX, ADJUSTABLE	7.3.2 UT 111	 Marion County OREGON ESTABLISHED 1857	MCBCC EFFECTIVE 04/13/2023 REVISION # 1	VALVE BOX PAD	7.3.2 UT 112	DATE 03/25
																PROJECT NO. 36300-25-20

Drawing name: Z:\Projects\35300-Adas Investments\35-200_37 Laurel Pass-4 Plan\CHA\037 Detail.dwg C08 Jun 16, 2025 9:57am by: Shaleka Thomas

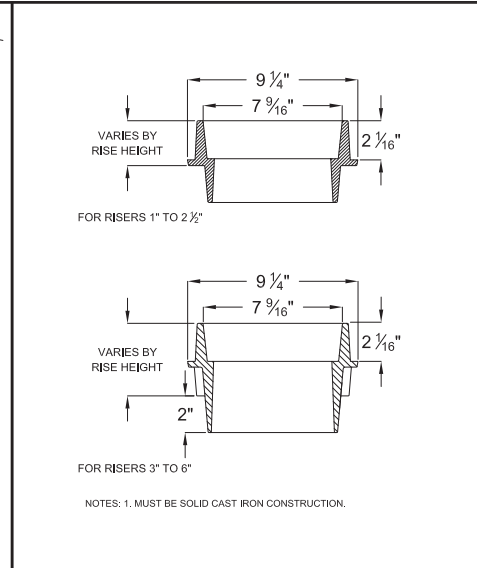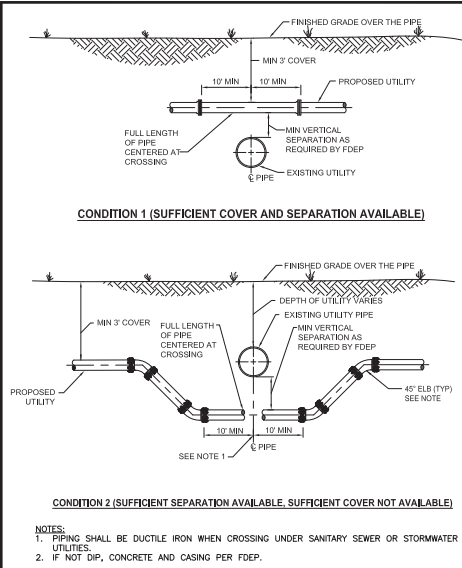

MINIMUM RESTRAINED LENGTH (FT)		H=HORIZONTAL V=VERTICAL-UP FOR DIP, PE ENCASED DIP OR BARE PVC VD=VERTICAL-DOWN	
WATER MAIN: PRESSURE: 150 PSI. DEPTH OF COVER: 3.0 ft.			
REQUIRED RESTRAINED LENGTH ON WATER MAIN		REQUIRED RESTRAINED LENGTH ON TEE BRANCH	
Band Type	Pipe Length (ft)	TEE FITTING	TEE BRANCH
Angle	4" 6" 8" 10" 12" 16" 20" 24"	4" 6" 8" 10" 12" 16" 20" 24"	4" 6" 8" 10" 12" 16" 20" 24"
11-1/4"	2 3 4 5 6 8 9	4" 20 28 18 6	4" 20 28 18 6
22-1/2"	4 6 7 9 10 12 15 17	6" 33 45 28 10	6" 33 45 28 10
40"	12 17 22 27 31 40 48 56	8" 48 63 39 14	8" 48 63 39 14
90"	18 27 36 41 48 61 72 83	10" 66 88 54 20	10" 66 88 54 20
120"	24 36 48 56 67 84 100 116	12" 84 111 72 26	12" 84 111 72 26
150"	30 45 60 72 87 108 129 150	14" 102 135 96 34	14" 102 135 96 34
180"	36 54 72 87 104 126 151 176	16" 120 156 114 42	16" 120 156 114 42
210"	42 63 84 101 121 145 171 198	18" 138 180 132 48	18" 138 180 132 48
240"	48 72 96 115 138 164 192 222	20" 156 204 156 54	20" 156 204 156 54
270"	54 81 108 129 153 181 210 240	22" 174 228 174 60	22" 174 228 174 60
300"	60 90 120 144 171 201 231 264	24" 192 252 192 66	24" 192 252 192 66
330"	66 99 132 158 186 216 246 282	26" 210 276 210 72	26" 210 276 210 72
360"	72 108 144 174 204 234 264 300	28" 228 300 228 78	28" 228 300 228 78
390"	78 117 156 186 216 246 276 312	30" 246 324 246 84	30" 246 324 246 84
420"	84 126 168 198 228 258 288 324	32" 264 348 264 90	32" 264 348 264 90
450"	90 135 180 210 240 270 300 336	34" 282 372 282 96	34" 282 372 282 96
480"	96 144 192 222 252 282 312 348	36" 300 396 300 102	36" 300 396 300 102
510"	102 153 204 234 264 294 324 360	38" 318 420 318 108	38" 318 420 318 108
540"	108 162 216 246 276 306 336 372	40" 336 444 336 114	40" 336 444 336 114
570"	114 171 228 258 288 318 348 384	42" 354 468 354 120	42" 354 468 354 120
600"	120 180 240 270 300 330 360 400	44" 372 492 372 126	44" 372 492 372 126
630"	126 189 252 282 312 342 372 414	46" 390 516 390 132	46" 390 516 390 132
660"	132 198 264 294 324 354 384 426	48" 408 540 408 138	48" 408 540 408 138
690"	138 207 276 306 336 366 396 438	50" 426 564 426 144	50" 426 564 426 144
720"	144 216 288 318 348 378 408 450	52" 444 588 444 150	52" 444 588 444 150
750"	150 225 300 330 360 390 420 462	54" 462 612 462 156	54" 462 612 462 156
780"	156 234 312 342 372 402 432 474	56" 480 636 480 162	56" 480 636 480 162
810"	162 243 324 354 384 414 444 486	58" 498 660 498 168	58" 498 660 498 168
840"	168 252 336 366 396 426 456 504	60" 516 684 516 174	60" 516 684 516 174
870"	174 261 348 378 408 438 468 510	62" 534 708 534 180	62" 534 708 534 180
900"	180 270 360 390 420 450 480 522	64" 552 732 552 186	64" 552 732 552 186
930"	186 279 372 402 432 462 492 534	66" 570 756 570 192	66" 570 756 570 192
960"	192 288 384 414 444 474 504 546	68" 588 780 588 198	68" 588 780 588 198
990"	198 297 396 426 456 486 516 558	70" 606 804 606 204	70" 606 804 606 204
1020"	204 306 408 438 468 498 528 570	72" 624 828 624 210	72" 624 828 624 210
1050"	210 315 420 450 480 510 540 582	74" 642 852 642 216	74" 642 852 642 216
1080"	216 324 432 462 492 522 552 594	76" 660 876 660 222	76" 660 876 660 222
1110"	222 333 444 474 504 534 564 606	78" 678 900 678 228	78" 678 900 678 228
1140"	228 342 456 486 516 546 576 618	80" 696 924 696 234	80" 696 924 696 234
1170"	234 351 468 498 528 558 588 630	82" 714 948 714 240	82" 714 948 714 240
1200"	240 360 480 510 540 570 600 642	84" 732 972 732 246	84" 732 972 732 246
1230"	246 369 492 522 552 582 612 654	86" 750 996 750 252	86" 750 996 750 252
1260"	252 378 504 534 564 594 624 666	88" 768 1020 768 258	88" 768 1020 768 258
1290"	258 387 516 546 576 606 636 678	90" 786 1044 786 264	90" 786 1044 786 264
1320"	264 396 528 558 588 618 648 690	92" 804 1068 804 270	92" 804 1068 804 270
1350"	270 405 540 570 600 630 660 702	94" 822 1092 822 276	94" 822 1092 822 276
1380"	276 414 552 582 612 642 672 714	96" 840 1116 840 282	96" 840 1116 840 282
1410"	282 423 564 594 624 654 684 726	98" 858 1140 858 288	98" 858 1140 858 288
1440"	288 432 576 606 636 666 696 738	100" 876 1164 876 294	100" 876 1164 876 294
1470"	294 441 588 618 648 678 708 750	102" 894 1188 894 300	102" 894 1188 894 300
1500"	300 450 600 630 660 690 720 762	104" 912 1212 912 306	104" 912 1212 912 306
1530"	306 459 612 642 672 702 732 774	106" 930 1236 930 312	106" 930 1236 930 312
1560"	312 468 624 654 684 714 744 786	108" 948 1260 948 318	108" 948 1260 948 318
1590"	318 477 636 666 696 726 756 798	110" 966 1284 966 324	110" 966 1284 966 324
1620"	324 486 648 678 708 738 768 810	112" 984 1308 984 330	112" 984 1308 984 330
1650"	330 495 660 690 720 750 780 822	114" 1002 1332 1002 336	114" 1002 1332 1002 336
1680"	336 504 672 702 732 762 792 834	116" 1020 1356 1020 342	116" 1020 1356 1020 342
1710"	342 513 684 714 744 774 802 846	118" 1038 1380 1038 348	118" 1038 1380 1038 348
1740"	348 522 696 726 756 786 812 858	120" 1056 1404 1056 354	120" 1056 1404 1056 354
1770"	354 531 708 738 768 798 822 870	122" 1074 1428 1074 360	122" 1074 1428 1074 360
1800"	360 540 720 750 780 810 840 882	124" 1092 1452 1092 366	124" 1092 1452 1092 366
1830"	366 549 732 762 792 822 850 894	126" 1110 1476 1110 372	126" 1110 1476 1110 372
1860"	372 558 744 774 804 834 860 906	128" 1128 1500 1128 378	128" 1128 1500 1128 378
1890"	378 567 756 786 816 846 870 918	130" 1146 1524 1146 384	130" 1146 1524 1146 384
1920"	384 576 768 798 828 858 880 930	132" 1164 1548 1164 390	132" 1164 1548 1164 390
1950"	390 585 780 810 840 870 900 936	134" 1182 1572 1182 396	134" 1182 1572 1182 396
1980"	396 594 792 822 852 882 912 948	136" 1200 1596 1200 402	136" 1200 1596 1200 402
2010"	402 603 804 834 864 894 924 960	138" 1218 1620 1218 408	138" 1218 1620 1218 408
2040"	408 612 816 846 876 906 936 972	140" 1236 1644 1236 414	140" 1236 1644 1236 414
2070"	414 621 828 858 888 918 948 984	142" 1254 1668 1254 420	142" 1254 1668 1254 420
2100"	420 630 840 870 900 930 960 996	144" 1272 1692 1272 426	144" 1272 1692 1272 426
2130"	426 639 852 882 912 942 972 1008	146" 1290 1716 1290 432	146" 1290 1716 1290 432
2160"	432 648 864 894 924 954 984 1020	148" 1308 1740 1308 438	148" 1308 1740 1308 438
2190"	438 657 876 906 936 966 996 1032	150" 1326 1764 1326 444	150" 1326 1764 1326 444
2220"	444 666 888 918 948 978 1008 1044	152" 1344 1788 1344 450	152" 1344 1788 1344 450
2250"	450 675 900 930 960 990 1020 1056	154" 1362 1812 1362 456	154" 1362 1812 1362 456
2280"	456 684 912 942 972 1002 1030 1068	156" 1380 1836 1380 462	156" 1380 1836 1380 462
2310"	462 693 924 954 984 1014 1040 1080	158" 1398 1860 1398 468	158" 1398 1860 1398 468
2340"	468 702 936 966 996 1026 1050 1092	160" 1416 1884 1416 474	160" 1416 1884 1416 474
2370"	474 711 948 978 1008 1036 1060 1104	162" 1434 1908 1434 480	162" 1434 1908 1434 480
2400"	480 720 960 990 1020 1046 1070 1116	164" 1452 1932 1452 486	164" 1452 1932 1452 486
2430"	486 729 972 1002 1032 1056 1080 1128	166" 1470 1956 1470 492	166" 1470 1956 1470 492
2460"	492 738 984 1014 1044 1066 1090 1140	168" 1488 1980 1488 498	168" 1488 1980 1488 498
2490"	498 747 996 1026 1056 1076 1100 1152	170" 1506 2004 1506 504	170" 1506 2004 1506 504
2520"	504 756 1008 1036 1066 1086 1110 1164	172" 1524 2028 1524 510	172" 1524 2028 1524 510
2550"	510 765 1020 1046 1076 1096 1120 1176	174" 1542 2052 1542 516	174" 1542 2052 1542 516
2580"	516 774 1032 1056 1086 1106 1130 1188	176" 1560 2076 1560 522	176" 1560 2076 1560 522
2610"	522 783 1044 1066 1096 1116 1140 1194	178" 1578 2100 1578 528	178" 1578 2100 1578 528
2640"	528 792 1056 1076 1106 1126 1150 1206	180" 1596 2124 1596 534	180" 1596 2124 1596 534
2670"	534 801 1068 1086 1116 1136 1160 1218	182" 1614 2148 1614 540	182" 1614 2148 1614 540
2700"	540 810 1080 1106 1126 1146 1170 1230	184" 1632 2172 1632 546	184" 1632 2172 1632 546
2730"	546 819 1092 1116 1136 1156 1180 1242	186" 1650 2196 1650 552	186" 1650 2196 1650 552
2760"	552 828 1104 1126 1146 1166 1190 1254	188" 1668 2220 1668 558	188" 1668 2220 1668 558
2790"	558 837 1116 1136 1156 1176 1200 1266	190" 1686 2244 1686 564	190" 1686 2244 1686 564
2820"	564 846 1128 1146 1166 1186 1210 1278	192" 1704 2268 1704 570	192" 1704 2268 1704 570
2850"	570 855 1140 1156 1176 1196 1220 1290	194" 1722 2292 1722 576	194" 1722 2292 1722 576
2880"	576 864 1152 1166 1186 1206 1230 1302	196" 1740 2316 1740 582	196" 1740 2316 1740 582
2910"	582 873 1164 1176 1196 1216 1240 1314	198" 1758 2340 1758 588	198" 1758 2340 1758 588
2940"	588 882 1176 1186 1206 1226 1250 1326	200" 1776 2364 1776 594	200" 1776 2364 1776 594
2970"	594 891 1188 1196 1216 1236 1260 1338	202" 1794 2388 1794 600	202" 1794 2388 1794 600
3000"	600 900 1200 1206 1226 1246 1270 1350	204" 1812 2412 1812 606	204" 1812 2412 1812 606
3030"	606 909 1212 1216 1236 1256 1280 1362	206" 1830 2436 1830 612	206" 1830 2436 1830 612
3060"	612 918 1224 1226 1246 1266 1290 1374	208" 1848 2460 1848 618	208" 1848 2460 1848 618
3090"	618 927 1236 1236 1256 1276 1300 1386	210" 1866 2484 1866 624	210" 1866 2484 1866 624
3120"	624 936 1248 1246 1266 1286 1310 1398	212" 1884 2508 1884 630	212" 1884 2508 1884 630
3150"	630 945 1260 1256 1276 1296 1320 1410	214" 1902 2532 1902 636	214" 1902 2532 1902 636
3180"	636 954 1272 1266 1286 1306 1330 1422	216" 1920 2556 1920 642	216" 1920 2556 1920 642
3210"	642 963 1284 1276 1296 1316 1340 1434	218" 1938 2580 1938 648	218" 1938 2580 1938 648
3240"	648 972 1296 1286 1306 1326 1350 1446	220" 1956 2604 1956 654	220" 1956 2604 1956 654
3270"	654 981 1308 1296 1316 1336 1360 1458	222" 1974 2628 1974 660	222" 1974 2628 1974 660
3300"	660 990 1320 1306 1326 1346 1370 1470	224" 1992 2652 1992 666	224" 1992 2652 1992 666
3330"	666 999 1332 1316 1336 1356 1380 1482	226" 2010 2676 2010 672	226" 2010 2676 2010 672
3360"	672 1008 1344 1326 1346 1366 1390 1494	228" 2028 2700 2028 678	228" 2028 2700 2028 678
3390"	678 1017 1356 1336 1356 1376 1400 1506	230" 2046 2724 2046 684	230" 2046 2724 2046 684
3420"	684 1026 1368 1346 1366 1386 1410 1518	232" 2064 2748 2064 690	232" 2064 2748 2064 690
3450"	690 1035 1380 1356 1376 1396 1420 1530	234" 2082 2772 2082 696	234" 2082 2772 2082 696
3480"	696 1044 1392 1366 1386 1406 1430 1542	236" 2100 2796 2100 702	236" 2100 2796 2100 702
3510"	702 1053 1404 1376 1396 1416 1440 1554	238" 2118 2820 2118 708	238" 2118 2820 2118 708
3540"	708 1062 1416 1386 1406 14		

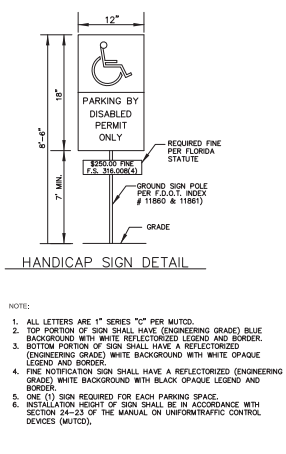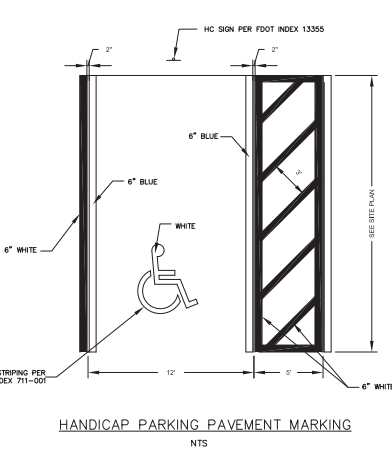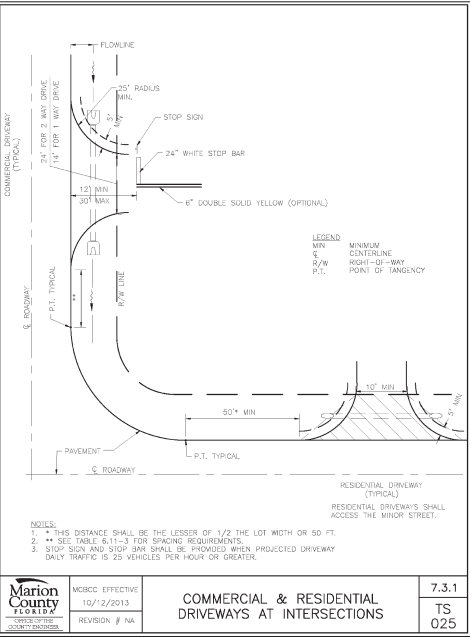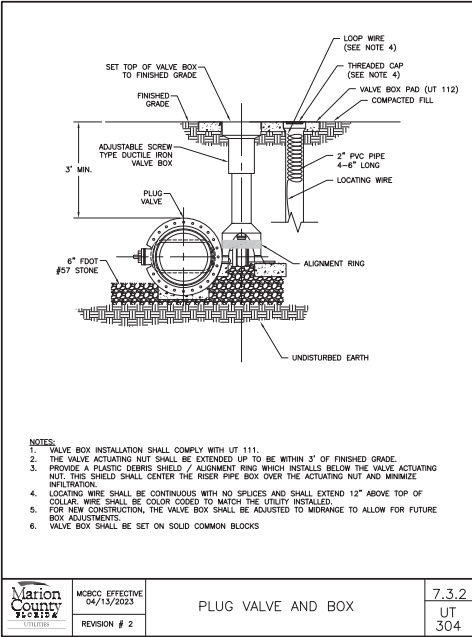

	MCBCC EFFECTIVE 04/13/2023	PLUG VALVE AND BOX	7.3.2
	MCBCC EFFECTIVE 10/12/2013	COMMERCIAL & RESIDENTIAL DRIVEWAYS AT INTERSECTIONS	7.3.1
REVISION # 2	UT 304	TS 025	

MINOR SITE PLAN-QUADPLEX
37 LAUREL PASS
OCALA, FL 34480

FLORIDA

DATE
03/25

PROJECT NO.
36300-25-200

SHEET NUMBER
C09

UTILITY DETAILS

DESIGNED BY SAT
DRAWN BY SAT
CHECKED BY CSL

DESIGN ENGINEER
CHAD S. LINN, P.E.
FLORIDA REGISTRATION NUMBER:
57524

SEAL

LINN ENGINEERING
P.O. BOX 1000
ORLANDO, FL 32814
PHONE: 407-754-1894
FAX: 407-754-1895
CAL. LIC. NO. 31710

DATE
03/2025

REVISIONS

DATE

BY

MAINLINE AND LATERAL LOCATION, WHERE SHOWN, IS FOR GRAPHIC CLARITY PURPOSES ONLY. INSTALL AT THE BACK OF CURB, FRONT OF WALK, BACK OF WALK, OR ADJACENT TO OTHER HARDSCAPES TO FACILITATE FUTURE LOCATION AND TO PROTECT FROM DAMAGE. ENSURE MAINLINE IS INSTALLED ACCORDING FDEP GUIDELINES AND TO IRRIGATION SPECIFICATIONS AND DETAILS.




LANDSCAPE AREA CALCULATIONS:
TOTAL SITE AREA: 13,886 +/- SQ. FT.
TOTAL UPLAND LANDSCAPED AREA: 13,648 +/- SQ. FT.
PLANTING MULCH AREAS: 3,505 +/- SQ. FT.
UNIRRIGATED BAHIA TURF AREA: 10,143 +/- SQ. FT.
20% MFLA REQUIRED= 19,886 X 20% = 3,977 SQ. FT.
IRRIGATED AREAS:
TOTAL IRRIGATED AREA: 1,876 +/- SQ. FT.
HIGH FLOW SPRAY AREA: 0 +/- SQ. FT.
LOW FLOW DRIP AREA: 1,876 +/- SQ. FT. (100%)

NOTE: IRRIGATION SHALL BE IN ACCORDANCE WITH MARION COUNTY CODE. THE SYSTEM IS PROPOSED AS PERMANENT.

IRRIGATION SCHEDULE

SYMBOL	MANUFACTURER MODEL	QTY	ARC	PSI	GPM	RADIUS
	Rain Bird 1800-1400 Flood 1402	14	360	30	0.5	3'
SYMBOL	MANUFACTURER MODEL DESCRIPTION	QTY				
	Rain Bird X2Z-150-LCDR High Flow Control Zone Kit, for Large Commercial Drip Zones. 1-1/2" PESB-R Scrubber Globe Valve with single 1-1/2" Pressure Regulating (RSP) Quick-Check Basket Filter. Flow range: 15-62gpm.	2				
	Area to Receive Drip line within TLOV-09-12 Techline Pressure Compensating Landscape Drip line with Check Valve. 9.9 GPH emitters at 12" O.C. Drip line laterals spaced at 18" apart, with emitters offset for triangular pattern. 17mm.	1,795 lf				
SYMBOL	MANUFACTURER MODEL DESCRIPTION	QTY				
	Febos 82BY 1-1/4" Reduced Pressure Backflow Preventer	1				
	Rain Bird ESP-AME3 4 Station, Hybrid Modular Outdoor Controller. For Residential or Light Commercial Use. LNK WFI Module and Flow Sensor Ready.	1				
	Rain Bird RSD-BEX Rain Sensor, with metal latching bracket, extension wire.	1				
	Water Meter 1"	1				
	Irrigation Lateral Line: PVC Class 200 SDR 21	405.7 lf				
	Irrigation Mainline: PVC Schedule 40	79.8 lf				
	Pipe Sleeve: PVC Schedule 40	26.4 lf				

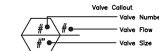

VALVE SCHEDULE (ALL ZONES SHALL RUN INDIVIDUALLY)

NUMBER	MODEL	SIZE	TYPE	GPM	WIRE	PSI	PSI @ POC	PRECIP
1	Rain Bird X2Z-150-LCDR	1-1/2"	Bubbler	14.61	30.6	40.6	51.9	0.96 in/h
2	Rain Bird X2Z-150-LCDR	1-1/2"	Bubbler	19.32	30.6	39.5	52.3	0.96 in/h
	Common Wire				79.8			

CRITICAL ANALYSIS

Generated: 2025-06-11 16:21

P.O.C. NUMBER: 01
Water Source Information:

FLOW AVAILABLE
Water Meter Size: 1"
Flow Available: 20.27 GPM

PRESSURE AVAILABLE
Static Pressure at POC: 60 PSI
Elevation Change: 5.00 ft
Service Line Size: 1"
Length of Service Line: 20.8
Pressure Available: 56 PSI

DESIGN ANALYSIS
Maximum Station Flow: 19.32 GPM
Flow Available at POC: 20.27 GPM
Residual Flow Available: 0.95 GPM

Critical Station: 2
Design Pressure: 30 PSI
Friction Loss: 3.14 PSI
Fittings Loss: 0.31 PSI
Elevation Loss: 0 PSI
Loss through Valve: 6 PSI
Pressure Req. at Critical Station: 39.5 PSI
Loss for Fittings: 0.18 PSI
Loss for Main Line: 1.8 PSI
Loss for POC to Valve Elevation: 0 PSI
Loss for Backflow: 6.76 PSI
Loss for Water Meter: 2.06 PSI
Critical Station Pressure at POC: 52.3 PSI
Pressure Available: 56 PSI
Residual Pressure Available: 3.74 PSI

Sec. 6.5.6. - Completion inspection requirements.

- Irrigation installation professionals shall be accountable for the proper installation and compliance with the conditions of the irrigation permit and approved plans.
- Upon completion of the installation, the contractor or owner shall request an inspection by the irrigation design professional. Prior to the inspection, the irrigation installation professional shall produce a clear and legible as-built diagram which accurately represents the irrigation system was installed. The diagram shall be presented and reviewed during the final inspection. The diagram may be a marked-up copy of the approved irrigation plan and shall include at a minimum:
 - Locations of all mainlines and mainline valves;
 - Locations of all remote control valves;
 - Water demand per zone in GPM, and
 - Total water demand per operating cycle.
- The irrigation installation professional shall also provide to the owner:
 - Irrigation system scheduling information;
 - A copy of the irrigation controller owner's manual;
 - Irrigation system maintenance schedule, which includes:
 - Instructions for seasonal adjustments of controller and sensors.
 - Instructions covering how and when to check for leaks.
 - A schedule for checking for proper irrigation distribution coverage.
 - Within 60 days after installation the irrigation controller shall be adjusted to be set in accordance with the applicable irrigation schedule set forth in this Code.
- Upon completion of the irrigation system installation and the acceptance of the as-built diagram and operational information, a Final Inspection and Landscape/Irrigation Release shall be signed and sealed by the irrigation design professional and submitted to the County's Landscape Architect.

	1	2	3	4	5	6	7	8	9	
	IRRIGATION NOTES & SPECIFICATIONS		WIRING							
	Irrigation design based on the TDC Design Studio Landscape Plan dated 7/19/2021. Contractor shall refer to these plans to coordinate sprinkler and pipe locations.		Irrigation control wire shall be thermoplastic solid copper, single conductor, low voltage irrigation controller wire, suitable for direct burial and continuous operation at rated voltages.		Pipes must cure a minimum of 30 minutes prior to handling and placing into trenches. A longer curing time may be required; refer to the manufacturer's specifications. The pipe must cure a minimum of 24 hours prior to filling with water.		Independent runs of wire shall be located every 30' for straight runs and at every change of direction. Sleeves will be located at end points and every 20' of length. All underground items shall include depth in inch format. These POINTS once collected shall be imported into an AutoCAD DWG geo-referenced base file to be labeled accordingly. The completed AS-Built shall be a Geo-Referenced DWF file delivered to the owner on a compact disk (CD).		2. Controller charts - Upon completion of "as-built" prepare controller charts; one per controller. Indicate on each chart the area controlled by a remote control valve (using a different color for each zone). This chart shall be reduced to a size that will fit inside of the controller door. The reduction shall be geometrically scaled to inside two 2mil pieces of clear plastic.	
F	The system has been designed to conform with the requirements of all applicable codes, laws, ordinances, rules, regulations and conventions. Should any conflict exist, the requirements of the codes shall prevail. It is the responsibility of the owner/installation contractor to ensure the entire system is installed as designed. Irrigation contractor responsible for obtaining all required permits according to federal, state and local laws.		Tape and bundle control wires every 10' and run alongside the mainline. At all turns in direction make a 2" coil of wire. At all valve boxes coil wire around a 3/4" piece of PVC pipe to make a coil using 30 linear inches of wire. Make electrical connections with 3MDEBYV connectors.		Gasketed Pipe: With pipe in the trench, cut pipe square, deburr, and place beveled edge on male portion of pipe, if not using a piece with a factory bevel. Clean pipe and fittings of foreign material; then apply a small amount of pipe grease to the rubber gasket on the female end. Fully insert the male end of the pipe into the bell end of adjacent pipe until the bevel is fully seated into the bell. Restrain pipe as required.		3. Grounding Certification - Provide ground certification results for each controller and pump panel grounding grid installed. This must be on a licensed electrician letter head indicating location tested (using IR plan symbols), date, time, test method, and testing results.		INSPECTIONS AND COORDINATION MEETINGS REQUIRED - Contractor is required to schedule, perform, and attend the following, and demonstrate to the owner and/or owners representative to their satisfaction, as follows:	
	The scope of work is shown on the plans, notes and details. The Irrigation Contractor shall be certified as a CERTIFIED IRRIGATION CONTRACTOR by the Irrigation Association. The certification shall be current and in good standing.		Wire sized, numbered and colored as follows: #14 white for common #14 spare black common #14 individual color coded hot wire #14 spare yellow hot wire		BACK FILL The Back fill 6" below, 6" above, and around all piping shall be of clean sand and anything beyond that in the trench can be of native material but nothing larger than 2" in diameter.		1. Pre-construction meeting - Designer and contractor to review entire install process and schedule with owner/general contractor.		2. Mainline installation inspection(s) - all mainline must be inspected for proper pipe, fittings, depth of coverage, backfill, and installation method	
	THE WORK The work specified in this section consists of furnishing all components necessary for the installation, testing, and delivery of a complete, fully functional automatic landscape irrigation system that complies with the irrigation plans, specifications, notes, and details. This work shall include, but not be limited to, the providing of all required material (if applicable (pump(s), backflows, pipes, valves, fittings, controllers, wire, primer, glue, etc.), layout, protection to the public, excavation, assembly, installation, back filling, compacting, repair of road surfaces, controller and low voltage leads to valves, cleanup, maintenance, guarantee and as-built plans.		Spare wires Leaving each controller, run six spare wires in both directions (twelve spare wires total). Install as 2 common spares (4 total) and 4 hot wires (8 total). Loop these wires into each RCV along their path and terminate in the last valve box controlled by the wires respective controller. The loop into each valve box shall extend up into the valve box a minimum of 8" and be readily accessible by opening the valve box lid. These wires must be all numbered and color coded as required in these plans.		Main line pipe depth measured to the top of pipe shall be: 24" minimum for 3/4"-2 1/2" PVC with a 30" minimum at vehicular crossings; 30" minimum for 3" & 4" PVC with a 36" minimum at vehicular crossings; 36" minimum for 6" PVC with a 36" minimum at vehicular crossings.		3. Mainline pressure test - All mainline shall be pressure tested according to this design's requirements		4. Flow Meter calibration - All flow meters must be calibrated, provide certified calibration report for all flow meters.	
E	All irrigated areas shall provide 100% head-to-head coverage from a fully automatic irrigation system with a rain (and freeze as appropriate) shut off device. If the rain shut off device is a rain sensor, it shall be installed to prevent activation by adjacent heads. Zones are prioritized first by public safety and then by hydraulic concerns. This sequencing will be a mandatory punch list item.		Controller and Pump station Control Panel grounding - Contractor to utilize 4"X8"X5/8" copper grounding plates, 5/8"X10" copper clad grounding rods, "One Strike" CAD wells at all connection points, #8 bare copper wire, and earth contact material. Install these and other required components as outlined in the detail. Contractor to verify that the earth to ground resistance does not exceed 10 ohms. Contractor shall provide a written certification, on a licensed electrical contractors letter head, showing the date of the test, controller/pump location, and test results. Each controller/pump shall be so grounded and tested. Each component must have its own separate grounding grid, unless they are sitting side by side, in which case up to two controllers can share a common grounding grid.		Lateral line depths measured to top of pipe shall be: 18" minimum for 3/4"-3" PVC with a 30" minimum at vehicular crossings; 24" minimum for 4" PVC and above with a 30" minimum at vehicular crossings.		5. USDA Soil Quality Tests for infiltration/texture		6. Coverage and operational test	
	These plans have been designed to satisfy/exceed the Florida Irrigation Society Standards and Specifications for Turf and Landscape Irrigation Systems, fourth edition. All products should be installed per manufacturer's recommendation. Contractor shall verify all underground utilities 72 hours prior to commencement of work.		LAYOUT Lay out irrigation system mainlines and lateral lines. Make the necessary adjustments as required to take into account all site obstructions and limitations prior to excavating trenches.		Contractor shall backfill all piping, both mainline and laterals, prior to performing any pressure tests. The pipe shall be backfilled with the exception of 2" on each side of every joint (bell fittings, 90's, tees, 45's, etc.). These joints shall not be backfilled until all piping has satisfactorily passed its appropriate pressure test as outlined below.		7. Final inspection		8. Punch list inspection	
	It is the responsibility of the irrigation contractor to familiarize themselves with all grade differences, location of walls, retaining walls, structures and utilities. Do not willfully install the sprinkler system as shown on the drawings when it is obvious in the field that unknown obstruction, grade differences or differences in the area dimensions exist that might not have been considered in the engineering. Such obstructions, or differences, should be brought to the attention of the owner's authorized representative. In the event this notification is not performed, the irrigation contractor shall assume full responsibility for any revisions necessary.		Stake all sprinkler head locations. Adjust location and make the necessary modifications to nozzle types, etc. required to ensure 100' head to head coverage. Refer to the Edge of Pavement Detail on the Irrigation Detail Sheet.		FLUSHING Prior to the placement of valves, flush all mainlines for a minimum of 10 minutes or until lines are completely clean of debris, whichever is longer.		FINAL ACCEPTANCE Final acceptance of the irrigation system will be given after the following documents and conditions have been completed and approved. Final payment will not be released until these conditions are satisfied.		1. All above inspections are completed, documented, and approved by owner.	
D	Irrigation contractor shall repair or replace all items damaged by their work. Irrigation contractor shall coordinate their work with other contractors for the location and installation of pipe sleeves and laterals through walls, under roadways and paving, etc.		Spray heads shall be installed 4" from sidewalks or curbed roadways and 12" from uncurbed roadways and building foundations. Rotors shall be installed 4" from sidewalks or curbed roadways, 12" from building foundations, and 36" from uncurbed roadways.		Soil: At a minimum of 2 locations on the site, soil tests for Infiltration and texture shall be performed according to the USDA Soil Quality Test Kit Guide. The tests shall be documented in a USDA Soil Worksheet. (All of the above is available at http://soils.usda.gov/soilresman/!test_kit.html) The completed worksheet shall be submitted to the owners representative for review/approval. Do not proceed without written direction from the owner/owner's representative.		GUARANTEE: The irrigation system shall be guaranteed for a minimum of one calendar year from the time of final acceptance.		2. Completion and acceptance of "as-built" drawings.	
	The contractor shall take immediate steps to repair, replace, or restore all services to any utilities which are disrupted due to their operations. All costs involved in disruption of service and repairs due to negligence on the part of the contractor shall be their responsibility.		Shrub heads shall be installed on 3/4" Sch 40 PVC risers. The risers shall be set at a minimum of 18" off sidewalks, roadway curbing, building foundations, and/or any other hardscaped areas. Shrub heads shall be installed to a standard height of 4" below maintained height of plants and shall be installed a minimum of 6" within planted masses to be less visible and offer protection. Plant all shrub risers with flat black or forest green paint, unless irrigation system will utilize reuse water; in this case the risers shall be purple PVC and shall not be painted.		Mainline: Remove all remote control valves and cap using a threaded cap on SCH 80 nipple. Fill mainline with water and pressurize the system to 125 PSI. Monitor the system pressure at two gauge locations; the gauge locations must be at opposite ends of the mainline. With the same respective pressures, monitor the gauges for two hours. There can be no loss in pressure at either gauge for solvent-welded pipe. For HDPE pipe, see HDPE notes. For gasketed pipe, testing requires measurement of the water pumped into the mainline system, using a hydrostatic pump, to maintain 125 PSI - this water volume shall be no more than the result of the following formula: $L=(ND \cdot P)/7400$		MINIMUM RECOMMENDED IRRIGATION MAINTENANCE PROCEDURES		3. Acceptance of required controller charts and placement inside of controllers.	
	POINT OF CONNECTION (P.O.C.) There is ONE P.O.C. (s)		Locate valves prior to excavation. Ensure that their location provides for easy access and that there is no interference with physical structures, plants, trees, poles, etc. Valve boxes must be placed a minimum of 12" and a maximum of 15" from the edge of pavement, curbs, etc. and the top of the box must be 2" above finish grade. No valve boxes shall be installed in turf areas without approval by the irrigation designer - only in shrub beds. Never install in sport field areas.		where L=Allowable leakage in gallons per hour N=Number of joints in pipe tested D=Nominal diameter of pipe (in inches) P=Average Test Pressure (in PSI)		1. Every irrigation zone should be checked monthly and written reports generated describing the date(s) each zone was inspected, problems identified, date problems repaired, and a list of materials used in the repair. At minimum, these inspections should include the following tasks:		4. All other submittals have been made to the satisfaction of the owner.	
	#1-P.O.C. is a new 1" potable meter & RPZ Backflow (by others) with a 1" service line by others. The P.O.C. must be capable of delivering a minimum of 20.3 GPM at 60 PSI downstream of the water meter.		VALVES Sequence all valves so that the farthest valve from the P.O.C. operates first and the closest to the P.O.C. operates last. The closest valve to the P.O.C. should be the last valve in the programmed sequence.		If these parameters are exceeded, locate the problem; repair it; wait 24 hours and retry the test. This procedure must be followed until the mainline passes the test.		A. Turn on each zone from the controller to verify automatic operation.		5. Check all heads as follows:	
	Contractor to verify these minimum conditions can be met prior to ordering of materials and the beginning of installation. If the conditions can not be met, the contractor must notify the designer prior to proceeding with the work. If the contractor does not do so, the contractor proceeds at their own risk and becomes responsible for any future work required to make the system perform as required.		Adjust the flow control on each RCV to ensure shut off in 10 seconds after deactivation by the irrigation controller.		Lateral Lines: The lateral lines must be fully filled to operational pressure and visually checked for leaks. Any leaks detected must be repaired.		1. Proper set height (top of sprinkler is 1" below mow height)		2. Verify head pop-up height - 6" in turf, 12" in ground cover, and pop-up on riser in shrub beds.	
C	THE PIPE Pipe locations shown on the plan are schematic and shall be adjusted in the field. When laying out mainlines place a maximum of 18" away from either the back of curb, front of walk, back of walk, or other hardscape to allow for ease in locating and protection from physical damage. Install all lateral pipe near edges of pavement or against buildings whenever possible to allow space for plant root bases. Always install piping inside proper property's boundary.		Using an electric branding iron, brand the valve I.D. letter/number on the lid of each valve box. This brand must be 2"-3" tall and easily legible.		Operational Testing - Once the mainline and lateral lines have passed their respective tests, and the system is completely operational, a coverage test and demonstration of the system is required. The irrigation contractor must demonstrate to the owner, or higher representative, that proper coverage is obtained and the system works automatically from the controller. This demonstration requires each zone to be turned on, in the proper sequence as shown on the plans, from the controller. Each zone will be inspected for proper coverage and function. The determination of proper coverage and function is at the sole discretion of the owner or owner's representative.		3. Check wiper seal for leaks - if leaking, clean head and re-inspect. If still leaking, replace head with the appropriate head with pressure regulator and built-in check valve.		4. All nozzles checked for proper pattern, clogging, leaks, correct make & model, etc. - replace as needed	
	All pipes are to be placed in planting beds. If it is necessary to have piping under hardscapes, such as roads, walks, and patios, the pipes must be sleeved using Class 200 PVC with the sleeve diameter being twice the size of the pipe it is carrying with a minimum sleeve size of 2".		EQUIPMENT All pop-up heads and shrub risers shall be pressure compensating. All pop-up heads shall be mounted on flex-type swing joints. All rotors shall be installed with PVC tieup swing joints unless otherwise detailed.		Upon completion of the operational test, run each zone until water begins to puddle or run off. This will allow you to determine the number of irrigation start times necessary to meet the weekly evapotranspiration requirements of the planting material in each zone. In fine sandy soils, it is possible no puddling will occur. If this is experienced, then theoretical calculations for run times will be required for controller programming.		5. Check remote control valve to ensure proper operation.		6. Riser height raised/lowered to accommodate plant growth patterns and ensure proper coverage.	
B	Pipe sizes shall conform to those shown on the drawings. No substitutions of smaller pipe sizes shall be permitted, but substitutions of larger sizes may be approved. All damaged and rejected pipe shall be removed from the site at the time of said rejection.		TRENCHING Excavate straight and vertical trenches with smooth, flat or sloping bottoms. Trench width and depth should be sufficient to allow for the proper vertical and horizontal separation between piping as shown in the pipe installation detail on the detail sheet.		SUBMITTALS Pre-Construction: The contractor must submit for written approval, prior to installation, five (5) copies of the manufacturer's cut sheets/specifications for all components to be used in the irrigation system.		D. Check setting on pressure regulator to verify proper setting, if present.		7. verify the pop-up riser retracts after operation. If not, repair/replace as needed.	
	Mainline shall be Pantone Purple Sch 40 solvent-weld (sized per plan) PVC with Sch 40 PVC solvent-weld fittings.		Protect existing landscaped areas. Remove and replant any damaged plant material upon job completion. The replacement material shall be of the same genus and species, and of the same size as the material it is replacing. The final determination as to what needs to be replaced and the acceptability of the replacement material shall be solely up to the owner or owner's representative.		After project completion: As a condition of final acceptance, the irrigation contractor shall provide the owner with: 1. Irrigations AS-builts - shall be provided utilizing a sub-foot Global Positioning System (GPS) to accurately locate all mainlines, sleeves, remote control valves, gate valves, independent wire runs, wire splice boxes, controllers, high voltage supply sources/conduit path, control mechanisms, sensors, wells and water source connections in Florida East State Plane, NAD 83, and CORS 98 format. The data collected shall be in POINT format and include an ID for each data point with Manufacturer, Type, Size, and Depth. All mainline and		F. Check for leaks - mainline, lateral lines, valves, heads, etc.		8. Check and clean intake screens on all suction lines quarterly, at minimum. Clean and/or repair, as needed.	
	PVC pipe joint compound and primer: The PVC cement shall be Weld-On 711 (grey, slow-drying, heavy duty) and the primer shall be Weld-On P70 (purple tinted, compatible with cement), or approved equals.		ELECTRICAL POWER SUPPLY Electrical supply for irrigation pumps, controllers, sensors, relaysto be provided by irrigation contractor. Irrigation to coordinate with local utilities for the installation of, and connection to, site available power supplies for required electrical components as set forth in the irrigation plans.				G. Check for leaks - mainline, lateral lines, valves, heads, etc.		9. Winterize, if applicable, as weather in your area dictates. Follow manufacturer recommendations and blow out all lines and equipment using compressed air. Perform seasonal startup of system as per manufacturer recommendations.	
A	All electrical work is to comply with the National Electrical Code and any, and all, other applicable electrical codes, laws and regulations. A licensed electrician shall perform all electrical hook-ups. Power for each controller/CCU shall be a dedicated 120 volt, 20 amp circuit unless otherwise specified in the plans. Power for each pump to be according to pump specifications indicated in these plans.						10. Conduct additional inspections, maintenance tasks, etc. that are particular for your site.			
	1	2	3	4	5	6	7	8	9	



PROJECT
37 LAUREL PASS
MARION COUNTY, FL
Prepared For:
IDEAL HOUSING INVESTMENTS


SEAL
CONSULTANTS
REV 12/2021 PERMIT

PROJECT NO. 2025-09
DESIGNED BY TTFV
DRAWN BY TTFV
CHECKED BY TDC/TTFV
DATE 6/11/2025
DRAWING SCALE AS SHOWN

DRAWING TITLE
IRRIGATION
SPECIFICATIONS

DRAWING NUMBER
IR-03
SHEET 3 of 3

3 NUMBER: LS240586

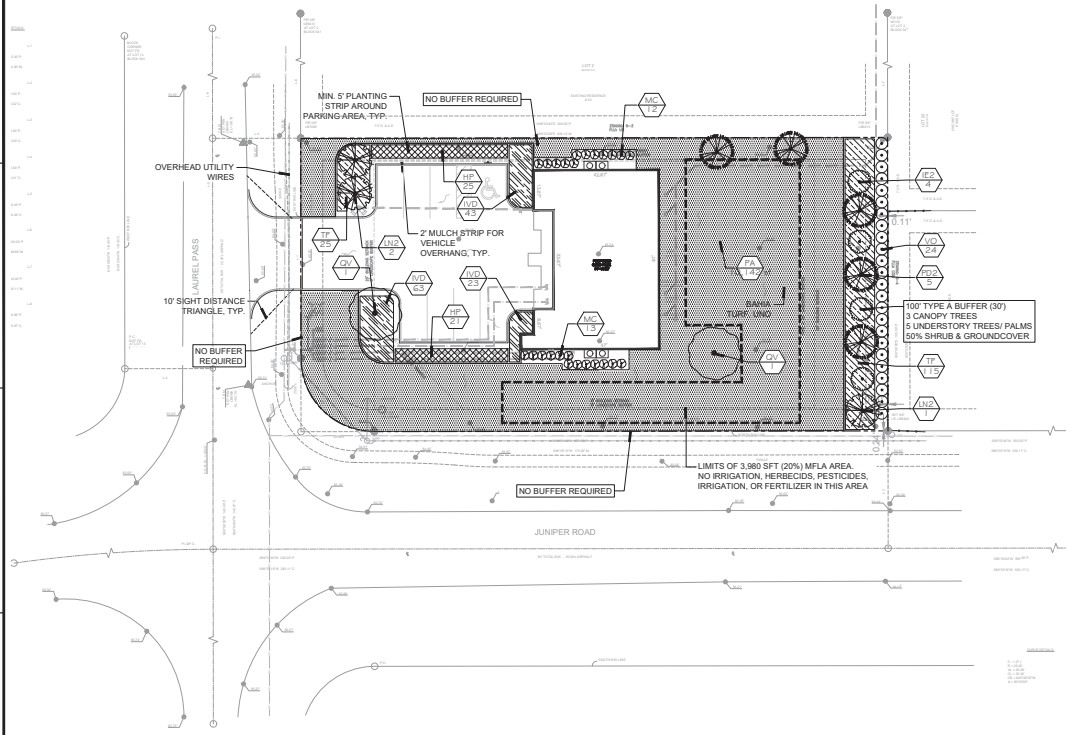

TREE REMOVAL SUMMARY:
NO TREES ON SITE

LANDSCAPE AREA CALCULATIONS:
TOTAL SITE AREA: 19,886 +/- SQ. FT.
TOTAL UPLAND LANDSCAPE AREA: 13,648 +/- SQ. FT.
PLANTING/ MULCH AREAS: 3,506 +/- SQ. FT.
UNIRRIGATED BAHIA TURF AREA: 10,142 +/- SQ. FT.
20% MFLA REQUIRED= 19,886 X 20% = 3,977 SQ. FT.

SHADE TREE CALCULATIONS:
TOTAL SITE AREA: 19,886 +/- SQ. FT.
SHADE TREES PRESERVED: 0
SHADE TREES PROVIDED: 7
19,886 SQ. FT./ 7 TREES= 1 TREE PER 2,840 SQ. FT.
(MINIMUM 1 PER 3,000 SQ. FT.)

TREE PROTECTION NOTE:

PER SEC. 7.6.3. E

TREE PROTECTION SHALL CONTINUE DURING THE COURSE OF CONSTRUCTION. THE FOLLOWING REQUIREMENTS SHALL BE CONDITIONS OF TREE REMOVAL PERMITS. ALL PERMITS FOR CONSTRUCTION IN PUBLIC RIGHTS-OF-WAY, AND ALL DEVELOPMENT PERMITS ISSUED UNDER AND PURSUANT TO THIS CODE:

- (1) THE CLEANING OF CONSTRUCTION EQUIPMENT OR MATERIAL, AND THE DISPOSAL OF WASTE MATERIALS INCLUDING BUT NOT LIMITED TO PAINT, OIL, SOLVENTS, ASPHALT, CONCRETE, AND MORTAR WITHIN THE TPZ OF ANY TREE WHICH IS BEING PROTECTED IS NOT ALLOWED.
- (2) THE MOVEMENT OF EQUIPMENT OR THE STORAGE OF EQUIPMENT, MATERIALS, DEBRIS, OR FILL WITHIN THE TPZ OF ANY TREE WHICH IS BEING PROTECTED IS NOT ALLOWED.
- (3) THE CONTRACTOR SHALL INSPECT ALL TREE PROTECTION BARRICADES AND SIGNS ON A WEEKLY BASIS DURING THE COURSE OF CONSTRUCTION. ANY BARRICADE OR SIGN WHICH HAS BEEN DAMAGED OR IS MISSING SHALL BE REPLACED IMMEDIATELY.
- (4) IF ANY TREE WHICH HAS NOT BEEN APPROVED TO BE REMOVED IS DESTROYED, OR RECEIVES MAJOR DAMAGE DURING CONSTRUCTION, WITH THE EXCEPTION OF NATURAL EVENTS, SO AS TO PLACE ITS LONG TERM SURVIVAL IN QUESTION, THE TREE(S) MUST BE REPLACED AT AN INCH-TO-INCH BASIS OF THE TOTAL (COMBINED) DBH OF THE TREE(S) SO DESTROYED OR DAMAGED. THE REPLACEMENT TREE(S) SHALL BE OF COMPARABLE SPECIES OF THE DESTROYED OR DAMAGED TREE(S) WITH A MINIMUM REPLACEMENT SIZE OF 3.5-INCH CALIPER. THE COUNTY RESERVES THE RIGHT TO ESTABLISH A REPLACEMENT VALUE FOR SUCH TREES AND PAYMENT INTO THE TREE MITIGATION FUND MAY BE AUTHORIZED BY THE COUNTY'S LANDSCAPE ARCHITECT.

SEC. 6.8.12 - LANDSCAPE COMPLETION INSPECTION REQUIREMENTS.

UPON COMPLETION OF THE INSTALLATION, THE CONTRACTOR SHALL REQUEST AN INSPECTION BY THE DESIGN PROFESSIONAL. A LANDSCAPE AND IRRIGATION AS-BUILT CERTIFICATION SHALL BE SIGNED AND SEALED BY THE DESIGN PROFESSIONAL AND SUBMITTED TO THE COUNTY LANDSCAPE ARCHITECT PRIOR TO THE ISSUANCE OF A CERTIFICATE OF OCCUPANCY.

PLANT SCHEDULE

(351/378) 93% NATIVE

THIS IS A "FLORIDA FRIENDLY LANDSCAPE PLAN"

	CODE	BOTANICAL / COMMON NAME	CONT	CAL	SIZE	QTY	MITIGATION INCHES PROVIDED
NATIVE TREES	E2	Ilex x attenuata 'Eagleston' / Eagleston Holly	30 gal	2" STANDARD	8'-10" H x 4'-5" W	4	17.5
	LN2	Lagerstroemia indica x faurei 'Natchez' / Natchez Crape Myrtle	30 gal	2" CAL. FTG.	8'-10" H x 3'-4" W	3	
	PD2	Pinus ellioti var. densa / Densa Slash Pine	45 gal	3.5" Cal	10'-12" H x 5'-6" W	5	
	QV	Quercus virginiana / Southern Live Oak	65 gal	3.5" Cal	12'-14" x 6'-8"	2	
SHRUBS	MC	Myrcianthes fragrans / Simpson's Stopper	3 gal	30" 36"		36" o.c.	25
	VO	Viburnum odoratissimum / Sweet Viburnum	3 gal	24" 30" X 24" 30"		48" o.c.	24
SHRUB AREAS	HP	Hamelia patens 'Compacts' / Dwarf Scarlet Bush	3 gal @	18" 24" x 18" 24"		36" o.c.	48
	IVD	Ilex vomitoria 'Schillings Dwarf' / Schillings Dwarf Holly	3 gal @	10-12" x 10-12"		24" o.c.	129
GROUND COVERS	PA	Paspalum notatum 'Argentine' / Bahia Grass	sod				10,142 sf
	TF	Tripsacum floridanum / Dwarf Fakahatchee Grass	1 gal	18" height, full		36" o.c.	140

PLANTING NOTES:

1. ALL PLANT MATERIAL SIZES ARE MINIMUM SIZES. CONTAINER SIZES SHALL BE INCREASED IF NECESSARY TO PROVIDE OVERALL PLANT SIZED SPECIFIED.
2. FINAL ARRANGEMENT OF PLANT MATERIAL SHALL BE STAKED BY THE CONTRACTOR FOR THE APPROVAL BY THE LANDSCAPE ARCHITECT PRIOR TO INSTALLMENT.
3. THE PLANT QUANTITIES SHOWN ON THE LANDSCAPE CONTRACT DOCUMENTS ARE FOR THE CONVENIENCE OF THE CONTRACTOR. THE CONTRACTOR IS RESPONSIBLE FOR VERIFYING ALL QUANTITIES AND REPORTING ANY DISCREPANCIES TO THE LANDSCAPE ARCHITECT FOR CLARIFICATION PRIOR TO CONTRACT AWARD AND COMMENCEMENT OF WORK.
4. ALL MULCH SHALL BE MEDIUM PINE BARK NUGGETS MULCH 3 INCHES THICK WHEN COMPACTED.
5. CONTRACTOR RESPONSIBLE TO REMOVING ALL INVASIVE OR PROHIBITED PLANT SPECIES ON SITE.
6. ALL LANDSCAPING SHALL CONFORM TO CITY OF MARION COUNTY LANDSCAPE, BUFFER, AND TREE REQUIREMENTS.

SOD NOTE:

1. ALL SOD SHALL BE ARGENTINE BAHIA GRASS (paspalum notatum 'Argentine'). FINAL QUANTITTY TO BE DETERMINED IN FIELD BY CONTRACTOR.

SIGHT DISTANCE NOTE:

1. ALL LANDSCAPING WITHIN SIGHT TRIANGLES SHALL CONFORM TO FOOT STANDARDS.
2. SHRUBS AND GROUNDCOVERS WITHIN SIGHT TRIANGLES SHALL NOT EXCEED 36" IN HEIGHT ABOVE PAVEMENT.
3. TREES IN SIGHT TRIANGLE SHALL HAVE A MINIMUM OF 6 FEET OF CLEAR TRUNK AT INSTALLATION, AND SHALL BE MAINTAINED AT 8 FEET AFTER ESTABLISHMENT.



LANDSCAPE ARCHITECTURE
COMMUNITY PLANNING
URBAN DESIGN

1516 E. HILLCREST STREET STE. 105
ORLANDO, FL 32803 PH: 407.256.2623

NO TREES SHOWN ON THESE PLANS REQUIRE THE USER TO CONSIDER AND OBTAIN NECESSARY PERMITS IN THESE PLANS. IDEAS AND DESIGN: THESE PLANS, IDEAS, AND DESIGN ARE NOT TO BE REPRODUCED, COPIED, OR USED IN ANY MANNER IN ANY MANNER, WHATSOEVER, NOR ARE THEY TO BE ASSIGNED TO ANY THIRD PARTY WITHOUT FIRST OBTAINING THE EXPRESS WRITTEN PERMISSION, CONSENT, AND PROCEEDING APPROPRIATE COMPENSATION TO THE TDC. THE USER'S CONTRACTOR SHALL HAVE PROCEEDED OVER SCALE DIMENSIONS. CONTRACTOR SHALL VERIFY AND BE RESPONSIBLE FOR VERIFYING DIMENSIONS AND CONDITIONS OF THE JOB. TDC IS NOT RESPONSIBLE FOR THE ACCURACY OF DIMENSIONS PROVIDED BY OTHERS AND INCORPORATED IN THESE DRAWINGS. TDC IS TO BE ADVISED IN WRITING OF ANY VIOLATIONS FROM APPEARING ON THESE PLANS. (C) 2024.

37 LAUREL PASS
MARION COUNTY, FL
Prepared For:
IDEAL HOUSING INVESTMENTS

PROJECT	SEAL	CONSULTANTS

ISSUED FOR:	PERMIT
6/11/2025	

PROJECT NO. 2025-09

DESIGNED BY TFW

DRAWN BY TDC/TFW

CHECKED BY 6/11/2025

DATE

DRAWING SCALE 1"=20'



DRAWING TITLE

LANDSCAPE PLAN

DRAWING NUMBER

LS-01

SHEET 1 of 2

