

July 5, 2024

PROJECT NAME: 7-ELEVEN BELLEVIEW

PROJECT NUMBER: 2022080152

APPLICATION: MAJOR SITE PLAN #30884

- 1 DEPARTMENT: ENGDRN - STORMWATER REVIEW
REVIEW ITEM: 6.13.10.B - Copy of NPDES Permit or NOI
STATUS OF REVIEW: INFO
REMARKS: Please provide a copy of the NPDES permit or NOI prior to construction.
- 2 DEPARTMENT: ENGIN - DEVELOPMENT REVIEW
REVIEW ITEM: 2.12.4.K - List of approved waivers, their conditions, and the date of approval
STATUS OF REVIEW: INFO
REMARKS: 12/13/23 - add waivers if requested in the future
- 3 DEPARTMENT: ENGIN - DEVELOPMENT REVIEW
REVIEW ITEM: Additional Development Review Comments
STATUS OF REVIEW: INFO
REMARKS: After approval, plans will be electronically stamped by the County. The applicant will receive an email indicating that approved plans are available for download and are located in the ePlans project Approved folder. For Development Review submittals, with the exception of Final Plats and Minor Site Plans, applicants are required to print, obtain required signatures, and sign and seal two 24"x 36" sets of the electronically stamped approved plan and deliver them to the Office of County Engineer, Development Review Section, located at 412 SE 25th Avenue Ocala, FL 34471. Upon receipt, a development order will be issued. Until such time as that development order is issued, the project does not have final approval and construction, if applicable, shall not commence. For plans requiring As-Builts, As-Builts and associated documentation shall be submitted on paper in accordance with current county requirements.
- 4 DEPARTMENT: DOH - ENVIRONMENTAL HEALTH
REVIEW ITEM: Additional Health comments
STATUS OF REVIEW: INFO
REMARKS: n/a
- 5 DEPARTMENT: LUCURR - LAND USE CURRENT REVIEW
REVIEW ITEM: Additional Planning Items:
STATUS OF REVIEW: INFO
REMARKS: Staff is aware the applicant/developer has been coordinating with the owner of the parcel to the east regarding the relocation of the existing driveway access as shown on the plan.



**Marion County
Board of County Commissioners**

AR 30884

Office of the County Engineer

412 SE 25th Ave.
Ocala, FL 34471
Phone: 352-671-8686
Fax: 352-671-8687

DEVELOPMENT REVIEW PLAN APPLICATION

Date: _____

A. PROJECT INFORMATION:

Project Name: 7-Eleven Belleview
Parcel Number(s): 37515-004-01
Section 19 Township 16 Range 23 Land Use _____ Zoning Classification _____
Commercial Residential Industrial Institutional Mixed Use Other _____
Type of Plan: Major Site Plan
Property Acreage 16.17 Number of Lots _____ Miles of Roads _____
Location of Property with Crossroads NEC SR 35 (SE 58th Ave) & SE 92nd Loop
Additional information regarding this submittal: _____

B. CONTACT INFORMATION (*Check the appropriate box indicating the point for contact for this project. Add all emails to receive correspondence during this plan review.*)

Engineer:
Firm Name: Common Oak Engineering LLC Contact Name: Jeremy Anderson, P.E.
Mailing Address: 4016 Edgewater Dr. City: Orlando State: FL Zip Code: 32804
Phone # (407) 951-5915 Alternate Phone # N/A
Email(s) for contact via ePlans: Jeremy@CommonOakEngineering.com Morgan@CommonOakEngineering.com

Surveyor:
Firm Name: Altamax Surveying Contact Name: _____
Mailing Address: 910 Belle Ave Ste 1100 City: Casselberry State: FL Zip Code: 32708
Phone # 407-677-0200 Alternate Phone # _____
Email(s) for contact via ePlans: _____

Property Owner:
Owner: Anthony & Rebecca Mendola Contact Name: _____
Mailing Address: PO Box 6331 City: Ocala State: FL Zip Code: 34478
Phone # 352-8170-7522 Alternate Phone # _____
Email address: _____

Developer:
Developer: RKM Development Corp Contact Name: William Lloyd
Mailing Address: 147 2nd Ave S, Ste 400 City: St. Petersburg State: FL Zip Code: 33701
Phone # 727-895-2150 Alternate Phone # _____
Email address: _____

Revised 6/2021

PLAN SHEET INDEX

C1.0	COVER SHEET	D1.0	DETAILS (SITE)
C2.0	GENERAL NOTES	D1.1	DETAILS (MOT)
C2.1	GENERAL NOTES	D1.2	DETAILS (FDOT)
C2.2	GENERAL NOTES	D1.3	DETAILS (FDOT)
C3.0	DEMO PLAN	D1.4	DETAILS (FDOT)
C4.0	OVERALL SITE PLAN	D1.5	DETAILS (FDOT)
C4.1	SITE PLAN	D2.0	DETAILS (GRADING)
C4.2	TRUCK ACCESS PLAN	D2.1	DETAILS (GRADING)
C4.3	DRIVEWAY SPACING PLAN	D2.2	DETAILS (GRADING)
C5.0	OVERALL GRADING PLAN	D2.3	DETAILS (KARST)
C5.1	GRADING PLAN	D2.4	DETAILS (PROFILES)
C6.0	UTILITY PLAN	D2.5	DETAILS (PROFILES)
C7.0	OVERALL LANDSCAPE PLAN	D3.0	DETAILS (UTILITY)
C7.1	LANDSCAPE PLAN	D3.1	DETAILS (UTILITY)
C7.2	IRRIGATION PLAN	D3.2	DETAILS (UTILITY)
C8.0	NOT USED	D3.3	DETAILS (LIFT STATION)
C9.0	EROSION CONTROL PLAN	FLOOR PLAN	
C9.1	EROSION CONTROL DETAILS	PHOTOMETRICS SURVEY	

TOTAL SHEETS : 36


LEGEND:

#	:	NO. OF PARKING SPACES
# / C.X.X	:	DETAIL NO. / SHEET
	:	HEAVY DUTY ASPHALT PAVEMENT
	:	PROPOSED CONCRETE SURFACE
W	:	WATER LINE
E	:	ELECTRIC LINE
SS	:	WASTEWATER LINE
FM	:	BURIED FORCE MAIN
TELE	:	TELEPHONE LINE
	:	FIRE HYDRANT
	:	VALVE
M	:	WATER METER
	:	BACKFLOW PREVENTER WITH CONCRETE PAD
75.40	:	TOP OF ASPHALT/CONCRETE SPOT ELEVATION
75.40 / 75.40	:	TOP OF CURB/SIDEWALK (ON TOP) / BOTTOM OF CURB (ON BOTTOM)
→	:	FLOW ARROW
#	:	REVISION NUMBER
FDC	:	FIRE DEPARTMENT CONNECTION

NOTES:

- ALL FUTURE DEVELOPMENTS WILL NEED TO APPLY FOR A PERMIT PRIOR TO CONSTRUCTION
- NO CHANGE TO THE WORK AS SHOWN ON THE APPROVED PLANS SHALL BE MADE WITHOUT NOTIFICATION TO AND APPROVAL BY THE OFFICE OF THE COUNTY ENGINEER
- THIS PROPOSED PROJECT HAS NOT BEEN GRANTED CONCURRENCY APPROVAL AND/OR GRANTED AND/OR RESERVED ANY PUBLIC FACILITY CAPACITIES. FUTURE RIGHTS TO DEVELOP THE PROPERTY ARE SUBJECT TO A DEFERRED CONCURRENCY DETERMINATION, AND FINAL APPROVAL TO DEVELOP THE PROPERTY HAS NOT BEEN OBTAINED. THE COMPLETION OF CONCURRENCY REVIEW AND/OR APPROVAL HAS BEEN DEFERRED TO LATER DEVELOPMENT REVIEW STAGES, SUCH AS, BUT NOT LIMITED TO, MASTER PLAN, PRELIMINARY PLAT, IMPROVEMENT PLAN, FINAL PLAT, SITE PLAN, OR BUILDING PERMIT REVIEW.
- FDOT LANE CLOSURE RESTRICTIONS ARE 4 PM - 6 PM, NORTHBOUND AND SOUTHBOUND.

MAJOR SITE PLAN 7-ELEVEN AT SEC OF SE 92ND LP & SE 58TH AVE, BELLEVIEW, FL 34420 MARION COUNTY PARCEL #: 37515-004-01

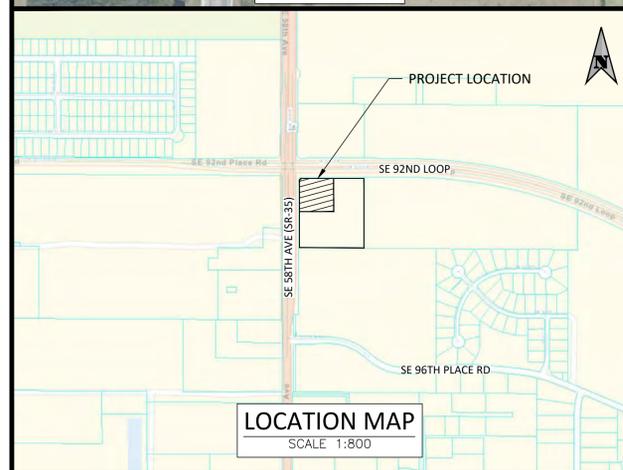

LEGAL DESCRIPTION

PARENT PARCEL:
COMMENCE AT THE SOUTHWEST CORNER OF THE NORTHWEST 1/4 OF SECTION 19, TOWNSHIP 16 SOUTH, RANGE 23 EAST, MARION COUNTY, FLORIDA; RUN THENCE S89°30'56"E ALONG THE SOUTH BOUNDARY OF THE NORTHWEST 1/4 OF SAID SECTION 19, A DISTANCE OF 102.00 FEET TO THE EAST RIGHT-OF-WAY LINE OF COUNTY ROAD C-35 PER OFFICIAL RECORDS BOOK 6125, PAGE 977, PUBLIC RECORDS OF MARION COUNTY, FLORIDA FOR A POINT OF BEGINNING; THENCE N00°01'05"E, ALONG SAID EAST RIGHT-OF-WAY LINE, A DISTANCE OF 623.38 FEET TO A POINT OF CURVATURE CONCAVE SOUTHEASTERLY HAVING A RADIUS OF 25.00 FEET, A CHORD BEARING OF N45°00'47"E AND A CHORD DISTANCE OF 35.35 FEET; RUN THENCE NORTHEASTERLY ALONG THE ARC OF SAID CURVE THROUGH A CENTRAL ANGLE OF 89°59'24" A DISTANCE OF 39.27 FEET TO THE SOUTH RIGHT-OF-WAY LINE OF SE 92ND LOOP PER SAID OFFICIAL RECORDS BOOK 6125, PAGE 977; THENCE S89°59'31"E, ALONG SAID SOUTH RIGHT-OF-WAY LINE, A DISTANCE OF 583.00 FEET; THENCE S00°01'05"W A DISTANCE OF 653.43 FEET TO THE SOUTH BOUNDARY OF SAID NORTHWEST 1/4 OF SECTION 19; THENCE N89°30'56"W, ALONG SAID SOUTH LINE, A DISTANCE OF 608.02 FEET TO THE POINT OF BEGINNING.

PARCEL A:
COMMENCE AT THE SOUTHWEST CORNER OF THE NORTHWEST 1/4 OF SECTION 19, TOWNSHIP 16 SOUTH, RANGE 23 EAST, MARION COUNTY, FLORIDA; RUN THENCE S89°30'56"E ALONG THE SOUTH BOUNDARY OF THE NORTHWEST 1/4 OF SAID SECTION 19, A DISTANCE OF 102.00 FEET TO THE EAST RIGHT-OF-WAY LINE OF COUNTY ROAD C-35 PER OFFICIAL RECORDS BOOK 6125, PAGE 977, PUBLIC RECORDS OF MARION COUNTY, FLORIDA; THENCE N00°01'05"E, ALONG SAID EAST RIGHT-OF-WAY LINE, A DISTANCE OF 337.22 FEET FOR A POINT OF BEGINNING; THENCE CONTINUE N00°01'05"E, ALONG SAID EAST RIGHT-OF-WAY LINE, A DISTANCE OF 286.16 FEET TO A POINT OF CURVATURE CONCAVE SOUTHEASTERLY HAVING A RADIUS OF 25.00 FEET, A CHORD BEARING OF N45°00'47"E AND A CHORD DISTANCE OF 35.35 FEET; RUN THENCE NORTHEASTERLY ALONG THE ARC OF SAID CURVE THROUGH A CENTRAL ANGLE OF 89°59'24" A DISTANCE OF 39.27 FEET TO THE SOUTH RIGHT-OF-WAY LINE OF SE 92ND LOOP PER SAID OFFICIAL RECORDS BOOK 6125, PAGE 977; THENCE S89°59'31"E, ALONG THE SOUTH RIGHT-OF-WAY LINE, A DISTANCE OF 297.96 FEET; THENCE S00°01'05"W A DISTANCE OF 311.16 FEET; THENCE N89°59'31"W A DISTANCE OF 322.96 FEET TO THE POINT OF BEGINNING.

GENERAL REVISION LOG

NO:	DATE:	REVISION / ISSUE:	SHEETS REVISED:	BY:
1	12/04/2024	FDOT DRAINAGE COMMENTS	C5.1	JR
2	12/05/2024	FDOT ACCESS COMMENTS	C1.0, C3.0, C4.0, C4.1, C4.2, C4.3, C7.0, D1.0, D1.1, D2.5, SURVEY	JR
3	12/07/2024	CITY OF BELLEVIEW UTILITY COMMENTS	C6.0, D3.0	JR
4	12/15/2024	MARION COUNTY COMMENTS	C1.0, C4.0, C4.1, C5.0, C5.1, C6.0, C7.0, C7.1, C7.2, C8.0, D3.0, D3.1, 3.2, D3.3, SURVEY	JR
5	02/19/2024	FDOT ACCESS COMMENTS	C1.0, C4.1, C7.0, C7.1, D1.0, D1.5	JR
6	02/26/2024	MARION COUNTY COMMENTS	C1.0, C4.0, C6.0, C7.0, D3.0	JR
7	03/13/2024	CITY OF BELLEVIEW UTILITY COMMENTS	C6.0, D3.0	JR
8	03/13/2024	CLIENT COMMENTS	C4.1, C4.2, C5.0, C5.1, C6.0, C7.0, C7.1, D2.0	JR
9	02/16/2024	FDOT DRAINAGE COMMENTS	C5.1, D2.0	JR
10	04/09/2024	FDOT DRAINAGE COMMENTS	C3.0, C4.1, C5.1, D2.0	JR
11	04/16/2024	CLIENT COMMENTS	C5.1, C6.0	JR
12	04/22/2024	MARION COUNTY COMMENTS	C1.0, C4.1, C5.0, C5.1, D1.0, D1.2, D2.4	JR
13	04/22/2024	FDOT ACCESS COMMENTS	C5.1	JR
14	05/02/2024	FDOT ACCESS COMMENTS	C6.0, D3.0	JR
15	05/09/2024	CLIENT COMMENTS	C6.0	JR

SITE DATA TABLE						
PARENT TRACT						
AREAS	EXISTING CONDITION			PROPOSED CONDITION		
	EXISTING (SF)	ACRES	PERCENT OF TOTAL PROPERTY AREA	PROPOSED (SF)	ACRES	PERCENT OF TOTAL PROPERTY AREA
LOT:	±295,227	±6.78	100%	±295,227	±6.78	100%
IMPERVIOUS (70% MAX):	0	-	-	±21,151	±0.49	7.16%
PERVIOUS:	±295,227	±6.78	100%	±274,076	±6.78	92.84%
7-ELEVEN SITE						
AREAS	EXISTING CONDITION			PROPOSED CONDITION		
	EXISTING (SF)	ACRES	PERCENT OF TOTAL PROPERTY AREA	PROPOSED (SF)	ACRES	PERCENT OF TOTAL PROPERTY AREA
LOT:	±100,357	±2.30	100%	±100,357	±2.30	100%
IMPERVIOUS (70% MAX):	0	-	-	±59,617	±1.37	59.40%
PERVIOUS:	±100,357	±2.30	100%	±40,740	±0.94	40.60%

PROJECT DIRECTORY

OWNER / DEVELOPER:	RKM DEVELOPMENT CORP. 147 2ND AVE S, ST. PETERSBURG, FL 33701 PHONE: (727) 895-2150
CIVIL ENGINEER:	COMMON OAK ENGINEERING, LLC 4016 EDGEWATER DRIVE, ORLANDO, FL 32804 PHONE: (407) 951-5915
GEOTECH ENGINEER:	ARDAMAN & ASSOCIATES, INC. 8008 S. ORANGE AVENUE ORLANDO, FL 32809 PHONE: (407) 855-3860
SURVEYOR:	ALTAMAX SURVEYING 910 BELLE AVENUE, SUITE 1100 CASSELBERRY, FL 32708 PHONE: (407) 677-0200
ARCHITECT:	INTERPLAN, LLC 220 E. CENTRAL PLKWAY, STE 4000 ALTIMONTE SPRINGS, FL 32701 PHONE: (407) 645-5008

OWNER'S CERTIFICATION

I HEREBY CERTIFY THAT I, MY SUCCESSORS, AND ASSIGNS SHALL PERPETUALLY MAINTAIN THE IMPROVEMENTS AS SHOWN ON THIS PLAN

REPRESENTATIVE OWNER, R.K.M. DEVELOPMENT CORP. _____ DATE _____

LICENSED DESIGN PROFESSIONAL CERTIFICATION

I HEREBY CERTIFY THAT THESE PLANS AND CALCULATIONS WERE COMPLETED IN ACCORDANCE WITH ALL APPLICABLE REQUIREMENTS OF THE MARION COUNTY LAND DEVELOPMENT CODE, EXCEPT AS WAIVED

71636
JEREMY R. ANDERSON, P.E. _____ P.E. LICENSE NO. _____ DATE _____

UTILITY PROVIDERS

WATER & SEWER:	CITY OF BELLEVIEW UTILITIES 5525 E 119TH ST BELLEVIEW, FL 34420 LELZI MERRITT DUFF PUBLIC WORKS DEPARTMENT PHONE: (352) 245-7021
ELECTRIC:	DUKE ENERGY 9700 DAVID TAYLOR DRIVE CHARLOTTE, NC PHONE: (863) 582-6345
GAS:	TECO PEOPLES GAS 316 SW 30RD AVE, OCALA, FL 34474 CHUCK HUMPHREY - COMMERCIAL ACCOUNT MANAGER PHONE: (352) 427-0743 CMHUMPHREY@TECOENERGY.COM
STORM:	MARION COUNTY OFFICE OF THE COUNTY ENGINEER 412 SE 25TH AVENUE OCALA, FL 34471 JAMES HULSEY PHONE: (352) 671-8686 JAMES.HULSEY@MARIONCOUNTYFL.ORG
COMMUNICATIONS:	CENTURYLINK A LUMEN TECHNOLOGIES COMPANY 555 LAKE BORDER DR. APOPKA FL 32703 MINETTA CROSIER PHONE: (352) 573-6008 MINETTA.CROSIER@LUMEN.COM

Jeremy R. Anderson, State of Florida, Professional Engineer, License No. 71636

This item has been digitally signed and sealed by Jeremy R. Anderson, PE, on the date indicated here.

Printed copies of this document are not considered signed and sealed and the signature must be verified on any electronic copies.

R.K.M. DEVELOPMENT CORP.



COMMON OAK ENGINEERING
4016 EDGEWATER DRIVE
ORLANDO, FL 32804
(407) 951-5915
CERTIFICATE OF AUTHORIZATION: 32844

MAJOR SITE PLAN
7-ELEVEN
AT SEC OF SE 92ND LP
&
SE 58TH AVE
BELLEVIEW, FL
MARION COUNTY


NO.	DATE	REVISION / ISSUE:	BY:
1	12/04/2024	FDOT ACCESS COMMENTS	JR
2	12/05/2024	FDOT ACCESS COMMENTS	JR
3	12/07/2024	CITY OF BELLEVIEW UTILITY COMMENTS	JR
4	12/15/2024	MARION COUNTY COMMENTS	JR
5	02/19/2024	FDOT ACCESS COMMENTS	JR
6	02/26/2024	MARION COUNTY COMMENTS	JR
7	03/13/2024	CITY OF BELLEVIEW UTILITY COMMENTS	JR
8	03/13/2024	CLIENT COMMENTS	JR

ENGINEER'S NAME & PE#
JEREMY R. ANDERSON, P.E.
P.E. LICENSE NO. 71636


PROJECT # 222.108

DATE SHEET
05/13/2024
SCALE
N.T.S.

COVER SHEET

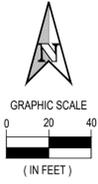

1 inch = 40 ft.
ELEVATIONS BASED ON
NAVD 88 VERTICAL DATUM
CONVERSION:
NGVD29 - NAVD88 = 0.919'

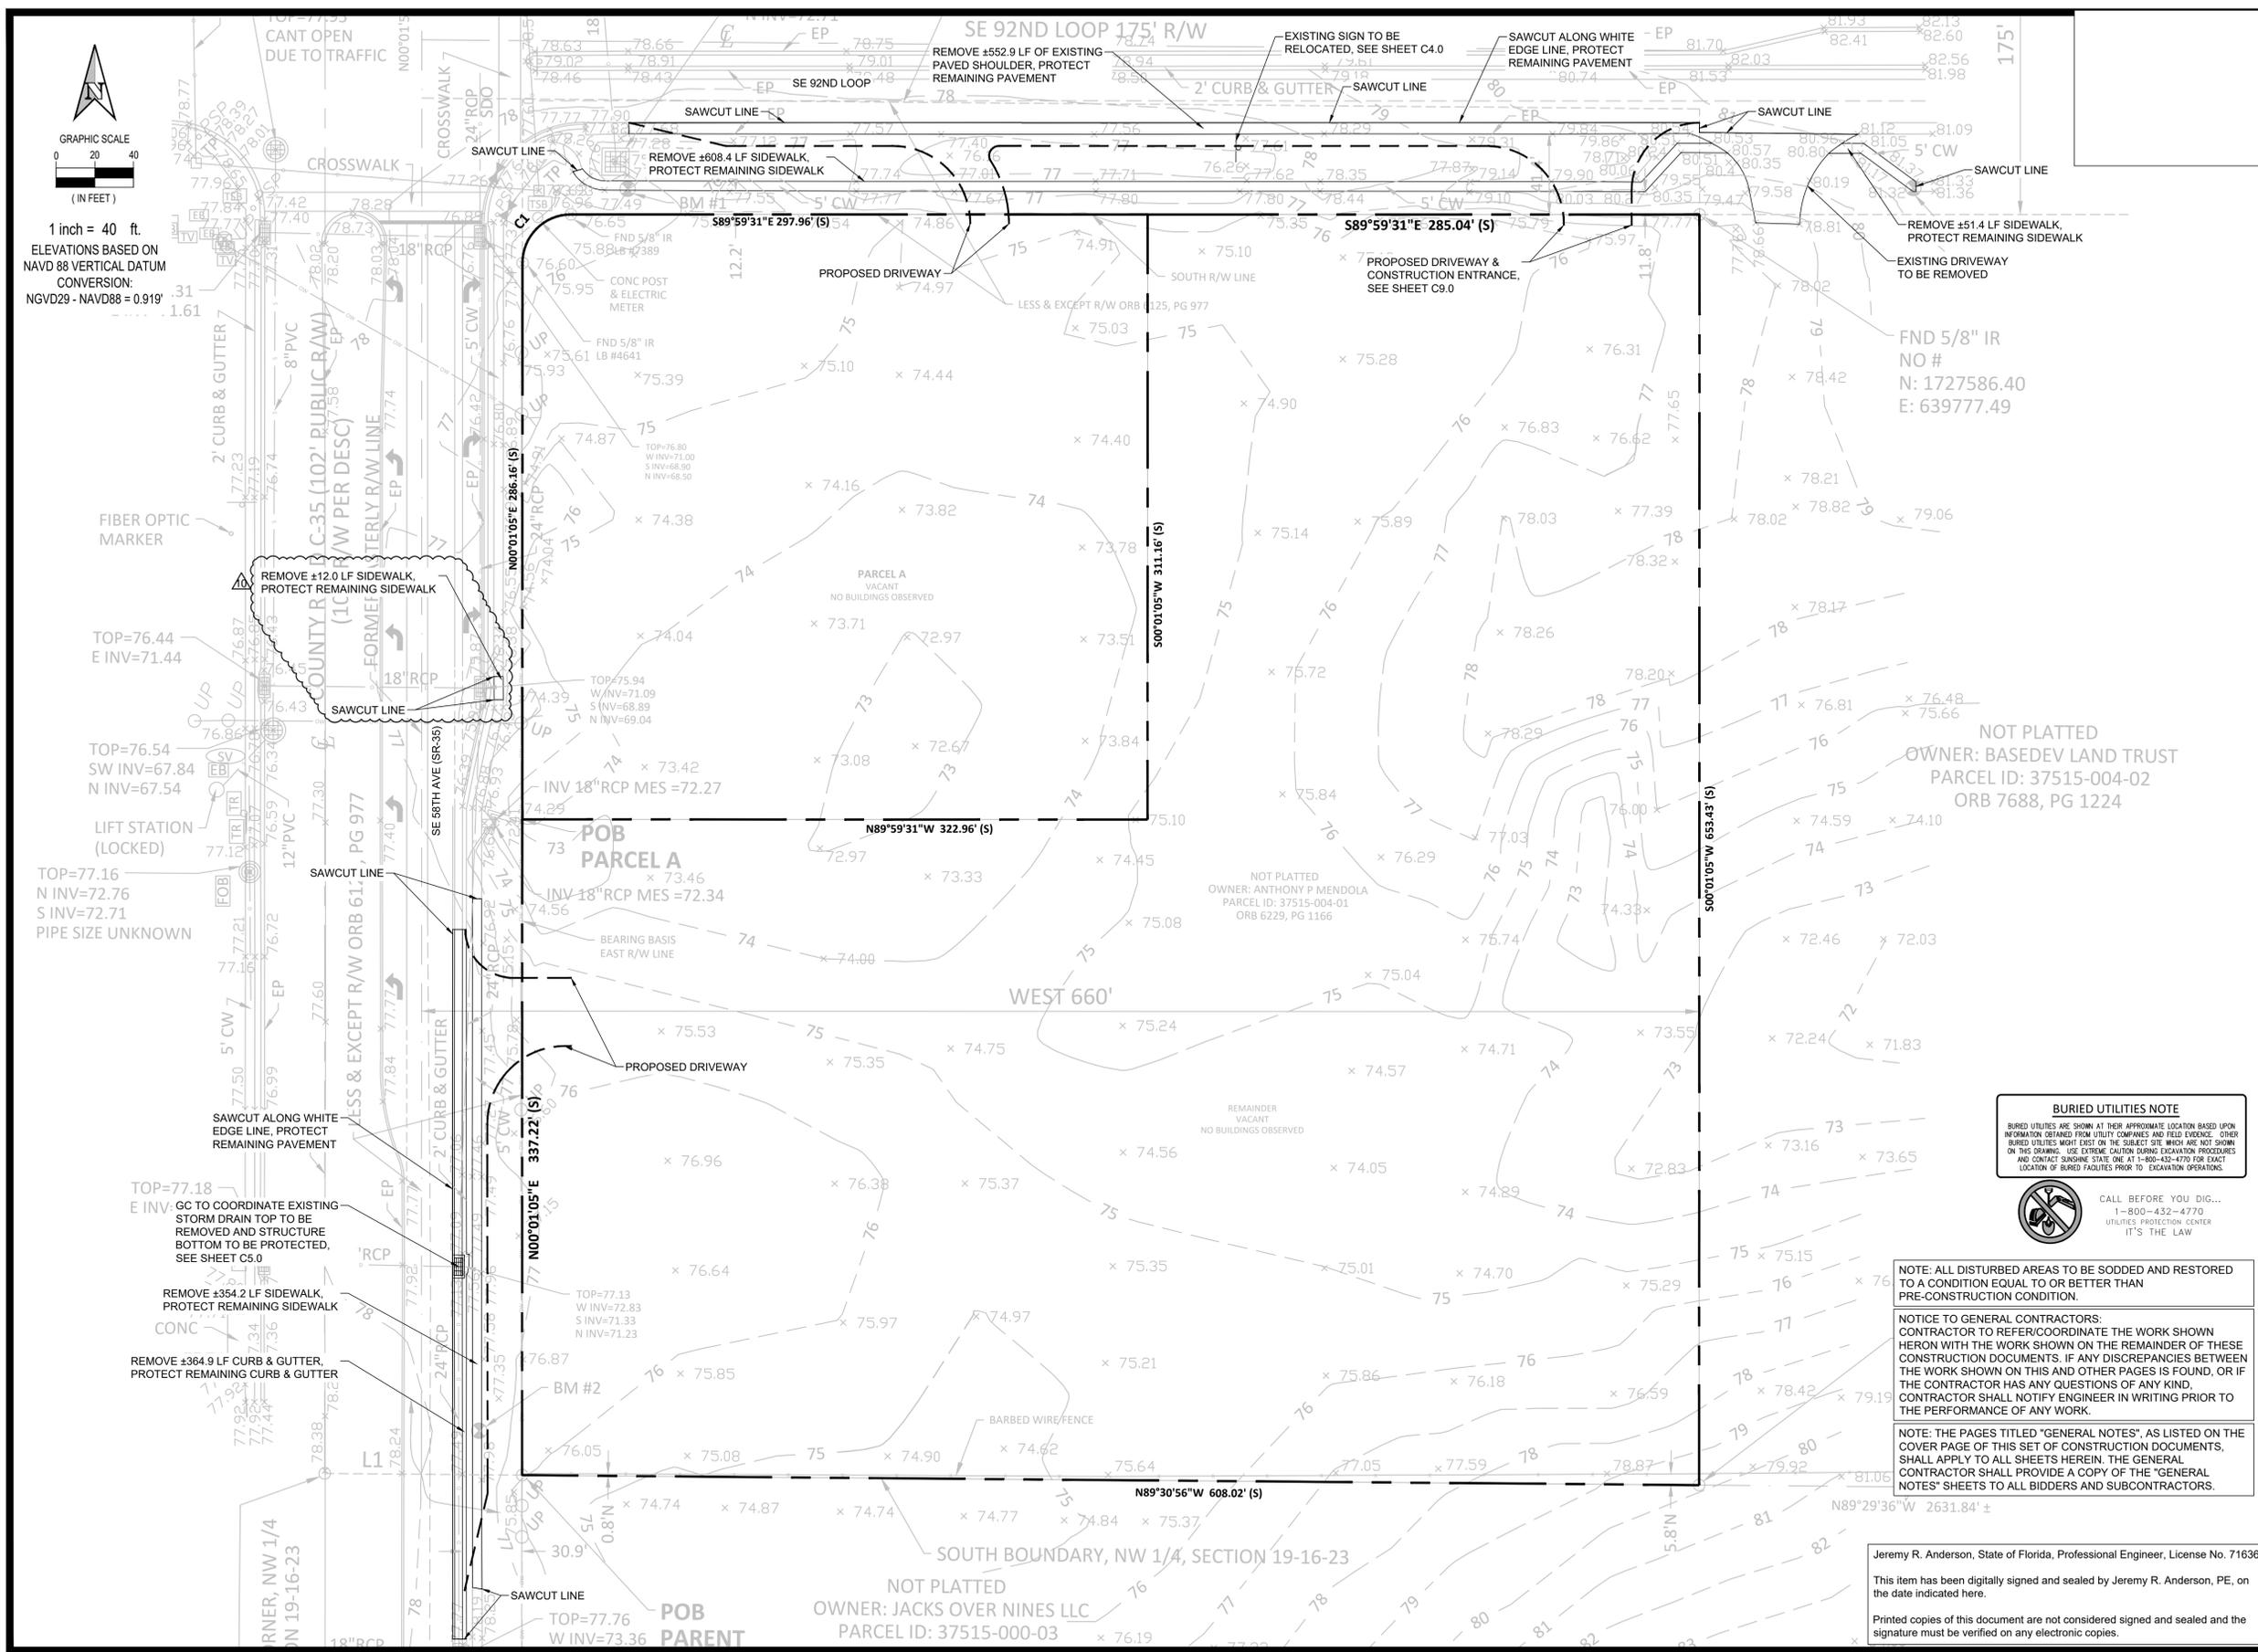

REMOVE ±12.0 LF SIDEWALK, PROTECT REMAINING SIDEWALK

GC TO COORDINATE EXISTING STORM DRAIN TOP TO BE REMOVED AND STRUCTURE BOTTOM TO BE PROTECTED, SEE SHEET C5.0

REMOVE ±354.2 LF SIDEWALK, PROTECT REMAINING SIDEWALK

REMOVE ±364.9 LF CURB & GUTTER, PROTECT REMAINING CURB & GUTTER

BURIED UTILITIES NOTE
BURIED UTILITIES ARE SHOWN AT THEIR APPROXIMATE LOCATION BASED UPON INFORMATION OBTAINED FROM UTILITY COMPANIES AND FIELD EVIDENCE. OTHER BURIED UTILITIES MIGHT EXIST ON THE SUBJECT SITE WHICH ARE NOT SHOWN ON THIS DRAWING. USE EXTREME CAUTION DURING EXCAVATION PROCEDURES AND CONTACT SUNSHINE STATE ONE AT 1-800-432-4770 FOR EXACT LOCATION OF BURIED FACILITIES PRIOR TO EXCAVATION OPERATIONS.



NOTE: ALL DISTURBED AREAS TO BE SODED AND RESTORED TO A CONDITION EQUAL TO OR BETTER THAN PRE-CONSTRUCTION CONDITION.

NOTICE TO GENERAL CONTRACTORS:
CONTRACTOR TO REFER/COORDINATE THE WORK SHOWN HERON WITH THE WORK SHOWN ON THE REMAINDER OF THESE CONSTRUCTION DOCUMENTS. IF ANY DISCREPANCIES BETWEEN THE WORK SHOWN ON THIS AND OTHER PAGES IS FOUND, OR IF THE CONTRACTOR HAS ANY QUESTIONS OF ANY KIND, THE CONTRACTOR SHALL NOTIFY ENGINEER IN WRITING PRIOR TO THE PERFORMANCE OF ANY WORK.

NOTE: THE PAGES TITLED "GENERAL NOTES", AS LISTED ON THE COVER PAGE OF THIS SET OF CONSTRUCTION DOCUMENTS, SHALL APPLY TO ALL SHEETS HEREIN. THE GENERAL CONTRACTOR SHALL PROVIDE A COPY OF THE "GENERAL NOTES" SHEETS TO ALL BIDDERS AND SUBCONTRACTORS.

Jeremy R. Anderson, State of Florida, Professional Engineer, License No. 71636
This item has been digitally signed and sealed by Jeremy R. Anderson, PE, on the date indicated here.

Printed copies of this document are not considered signed and sealed and the signature must be verified on any electronic copies.

R.K.M. DEVELOPMENT CORP.



COMMON OAK ENGINEERING
4016 EDGEWATER DRIVE
ORLANDO, FL 32804
(407) 951-5915
CERTIFICATE OF AUTHORIZATION: 32844

MAJOR SITE PLAN
7-ELEVEN
AT SEC OF SE 92ND LP
&
SE 58TH AVE
BELLEVUE, FL
MARION COUNTY

NO.	DATE	REVISION / ISSUE	BY	JR	JR	JR
1	12/05/2024	POST ACCESS COMMENTS	JR			
2	12/05/2024	POST ACCESS COMMENTS	JR			
3	12/05/2024	POST DRAINAGE COMMENTS	JR			
4						
5						
6						
7						
8						
9						
10						

ENGINEER'S NAME & PE#

JEREMY R. ANDERSON, P.E.
P.E. LICENSE NO. 71636

PROJECT # 222.108


DATE 05/13/2024
SCALE 1" = 40'

SHEET C3.0
DEMO PLAN

NOT PLATTED
OWNER: BASEDEV LAND TRUST
PARCEL ID: 37515-004-02
ORB 7688, PG 1224

NOT PLATTED
OWNER: ANTHONY P. MENDOLA
PARCEL ID: 37515-004-01
ORB 6229, PG 1166

NOT PLATTED
OWNER: JACKS OVER NINES LLC
PARCEL ID: 37515-000-03

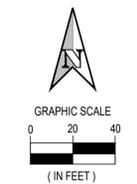


1 inch = 40 ft.
 ELEVATIONS BASED ON
 NAVD 88 VERTICAL DATUM
 CONVERSION:
 NGVD29 - NAVD88 = 0.919

LEGEND

- CONCRETE
- STANDARD ASPHALT PAVEMENT
- HEAVY DUTY ASPHALT PAVEMENT
- FOOT SPECIFICATION ASPHALT PAVEMENT
- ASPHALT PAVEMENT
- CROSS ACCESS EASEMENT

CURVE	RADIUS	ARC LENGTH	CHORD LENGTH	CHORD BEARING	DELTA ANGLE
C1	25.00'	39.27'	35.35'	N45°00'18"E	89°59'24"

BURIED UTILITIES NOTE
 BURIED UTILITIES ARE SHOWN AT THEIR APPROXIMATE LOCATION BASED UPON INFORMATION OBTAINED FROM UTILITY COMPANIES AND FIELD EVIDENCE. OTHER BURIED UTILITIES MIGHT EXIST ON THE SUBJECT SITE WHICH ARE NOT SHOWN ON THIS DRAWING. USE EXTREME CAUTION DURING EXCAVATION PROCEDURES AND CONTACT SUNDANCE STATE ONE AT 1-800-432-4770 FOR EXACT LOCATION OF BURIED FACILITIES PRIOR TO EXCAVATION OPERATIONS.

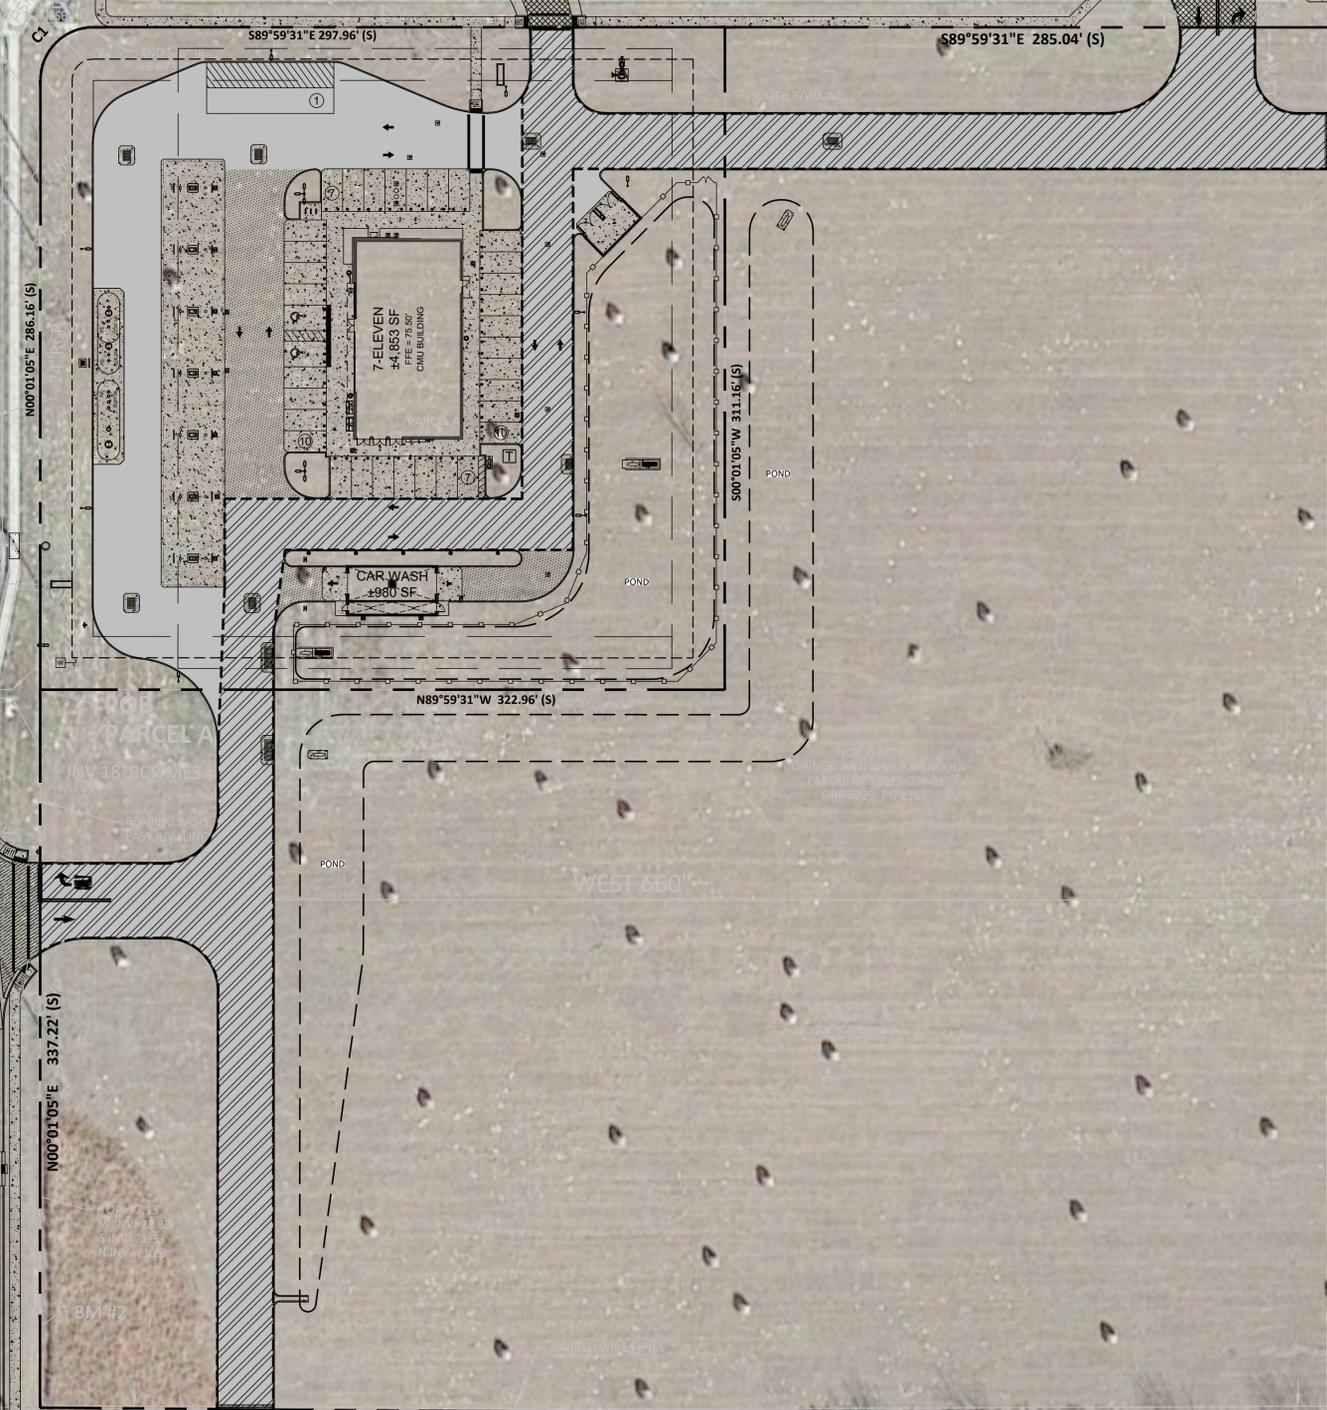

SITE DATA TABLE

PROJECT DESCRIPTION
 THIS PROJECT CONSISTS OF A CONVENIENCE STORE WITH PARKING, A STAND ALONE CAR WASH, FUELING STATIONS WITH A CANOPY, AND ON-SITE STORMWATER MANAGEMENT.

LOCATION & LAND USE
 TAX PARCEL #S: 37515-004-01
 ZONING DISTRICT: B-2 (WITHIN PRIMARY SPRING PROTECTION ZONE)
 FUTURE LAND USE: COM - COMMERCIAL

ADJACENT ZONING / FLU:
 WEST (FRONT): B-5 / COM
 NORTH (SIDE): B-2 / COM
 EAST (REAR): PUD / COM
 SOUTH (SIDE): R-1 / COM

DEVELOPER'S AGREEMENT (COUNTY) - OR BOOK 3996, PAGES 789-792
 DEVELOPER'S AGREEMENT (BELLEVUE) - PENDING (WATER & SEWER CONNECTIONS)

AREAS

7-ELEVEN AREAS	PROPOSED (SF)	ACRES	PERCENT OF TOTAL PROPERTY AREA
LOT:	±100,357	±2.30	100%
TOTAL IMPERVIOUS (70% MAX):	±59,617	±1.37	59.40%
BUILDING FOOTPRINT:	±4,853	±0.11	4.83%
CAR WASH FOOTPRINT:	±980	±0.02	0.98%
PAVEMENT, LOADING & SIDEWALKS:	±53,784	±1.23	53.59%
TOTAL PERVIOUS AREA:	±40,740	±0.94	40.60%
FLOOR AREA RATIO (1.0 MAX):	±0.048	OPEN SPACE (20% MIN):	40.60%

PARENT TRACT AREAS	PROPOSED (SF)	ACRES	PERCENT OF TOTAL PROPERTY AREA
LOT:	±295,257	±6.78	100%
TOTAL IMPERVIOUS (70% MAX):	±21,151	±0.49	7.16%
TOTAL PERVIOUS AREA:	±274,106	±6.29	92.84%
FLOOR AREA RATIO (1.0 MAX):	N / A	OPEN SPACE (20% MIN):	92.84%

SETBACKS & BUFFERS

BUILDING SETBACKS:	REQUIRED / PERMITTED:	PROPOSED:
WEST (FRONT):	10' (MIN)	148.0' (MIN FROM PROPERTY LINE)
NORTH (SIDE):	65' (MIN)	99.5' (MIN FROM PROPERTY LINE)
EAST (REAR):	25' (MIN)	123.6' (MIN FROM PROPERTY LINE)
SOUTH (SIDE):	10' (MIN)	117.7' (MIN FROM PROPERTY LINE)

LANDSCAPE BUFFERS:	REQUIRED / PERMITTED:	PROPOSED:
WEST (FRONT):	15' (MIN)	15' (FROM PROPERTY LINE)
NORTH (SIDE):	15' (MIN)	15' (FROM PROPERTY LINE)
EAST (REAR):	15' (MIN)	15' (FROM PROPERTY LINE)
SOUTH (SIDE):	15' (MIN)	15' (FROM PROPERTY LINE)

PARKING

PARKING REQUIRED: ONE (1) SPACE FOR EVERY 300SF OF GROSS FLOOR AREA. BASED ON A 4,853SF CONVENIENCE STORE, A TOTAL OF SIXTEEN (17) PARKING SPACES ARE REQUIRED.

PARKING CALCULATIONS: 4,853 / 300 = 16.18 17 REQUIRED STALLS
 PROPOSED PARKING STALLS: 33
 PROPOSED ADA STALLS: 2
 TOTAL: 35 SPACES

FEMA

FLOOD ZONE: X	FLOOD MAP #12083C0733D	EFFECTIVE AUGUST 28, 2008
---------------	------------------------	---------------------------

NOTES:

- ALL ASPHALT DIMENSIONS ARE TO FACE OF CURB, UNLESS NOTED OTHERWISE
- ALL RADII ARE 3' UNLESS OTHERWISE SPECIFIED
- BUILDING SETBACKS ARE TO CONCRETE CORNER OF BUILDING
- ALL AFFECTED SIDEWALKS, RAMPS AND CROSSWALKS, WILL BE BUILT AND INSPECTED TO MEET CURRENT ADA REQUIREMENTS
- CONTRACTOR SHALL FIELD VERIFY UTILITY POINT OF CONNECTIONS LOCATION, ELEVATION AND TYPE PRIOR TO CONSTRUCTION AND NOTIFY ENGINEER OF RECORD OF ANY DISCREPANCIES BETWEEN THE PLANS AND EXISTING FACILITIES
- ALL DISTURBED AREAS TO BE SODDED AND RESTORED TO A CONDITION EQUAL TO OR BETTER THAN PRE-CONSTRUCTION CONDITION
- ALL IMPROVEMENTS ARE PARALLEL AND PERPENDICULAR TO NORTH (SIDE) PROPERTY LINE (BEARING S90°00'00"E) UNLESS OTHERWISE SHOWN.
- ALL CONSTRUCTION IN THE FDOT ROW SHALL CONFORM TO THE LATEST EDITIONS OF THE FDOT DESIGN STANDARDS (INDEXES), THE FDOT STANDARD SPECIFICATIONS FOR ROAD AND BRIDGE CONSTRUCTION, AND THE FDOT UTILITY ACCOMMODATION MANUAL
- THE PAGES TITLED "GENERAL NOTES", AS LISTED ON THE COVER PAGE OF THIS SET OF CONSTRUCTION DOCUMENTS, SHALL APPLY TO ALL SHEETS HEREIN. THE GENERAL CONTRACTOR SHALL PROVIDE A COPY OF THE "GENERAL NOTES" SHEETS TO ALL BIDDERS AND SUBCONTRACTORS.
- THE EOR WILL BE FULLY RESPONSIBLE TO UPDATE / ADD / REMOVE ANY SIGNS OR PAVEMENT MARKINGS THAT NEED TO BE UPDATED / ADDED / REMOVED IN THE FIELD WITH THE PROPOSED CHANGES EVEN IF THE FDOT COMMENTS ARE NOT COMPREHENSIVE AND DO NOT COVER EVERY ONE OF THE CHANGES REQUIRED.
- IF THE PERMITTED CONNECTION POSES A CURRENT OR POTENTIAL OPERATIONAL PROBLEM THAT ENDANGERS THE HEALTH, SAFETY, OR WELFARE OF THE PUBLIC, THE OWNER / PERMITTEE WILL BE RESPONSIBLE FOR ALL COSTS ASSOCIATED WITH THE REQUIRED MODIFICATION PER FAC GUIDELINES.

Jeremy R. Anderson, State of Florida, Professional Engineer, License No. 71636
 This item has been digitally signed and sealed by Jeremy R. Anderson, PE, on the date indicated here.

Printed copies of this document are not considered signed and sealed and the signature must be verified on any electronic copies.

R.K.M. DEVELOPMENT CORP.



COMMON OAK ENGINEERING
 4016 EDGEWATER DRIVE
 ORLANDO, FL 32804
 (407) 951-5915
 CERTIFICATE OF AUTHORIZATION: 32844

MAJOR SITE PLAN
 7-ELEVEN
 AT SEC OF SE 92ND LP
 SE 58TH AVE
 BELLEVUE, FL
 MARION COUNTY

NO.	DATE	REVISION / ISSUE:
1	12/08/2024	FOOT ACCESS COMMENTS
2	02/28/2024	MARION COUNTY COMMENTS
3	02/28/2024	MARION COUNTY COMMENTS
4	02/28/2024	MARION COUNTY COMMENTS
5	02/28/2024	MARION COUNTY COMMENTS
6	02/28/2024	MARION COUNTY COMMENTS

ENGINEER'S NAME & PE#

JEREMY R. ANDERSON, P.E.
 P.E. LICENSE NO. 71636
 PROJECT # **222.108**

DATE SHEET
 05/13/2024
 SCALE
 1" = 40'
OVERALL SITE PLAN

R.K.M. DEVELOPMENT CORP.



COMMON OAK ENGINEERING
4016 EDGEWATER DRIVE
ORLANDO, FL 32804
(407) 951-5915
CERTIFICATE OF AUTHORIZATION: 32844

MAJOR SITE PLAN
7-ELEVEN
&
AT SEC OF SE 92ND LP
SE 58TH AVE
BELLEVUE, FL
MARION COUNTY





NO.	DATE	REVISION / ISSUE	BY	DATE	REVISION / ISSUE
1	12/05/2024	POB ACCESS COMMENTS	JR		
2	05/13/2024	CLIENT COMMENTS	JR		

ENGINEER'S NAME & PE#
JEREMY R. ANDERSON, P.E.
P.E. LICENSE NO. 71636

PROJECT # 222.108

DATE SHEET
05/13/2024
SCALE
NTS
TRUCK ACCESS PLAN


Jeremy R. Anderson, State of Florida, Professional Engineer, License No. 71636
This item has been digitally signed and sealed by Jeremy R. Anderson, PE, on the date indicated here.
Printed copies of this document are not considered signed and sealed and the signature must be verified on any electronic copies.

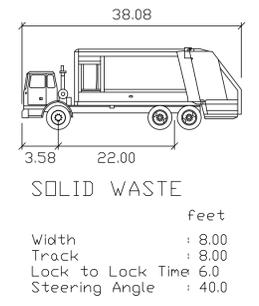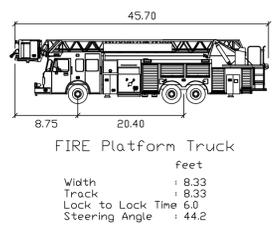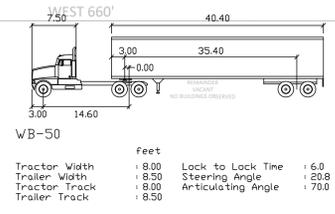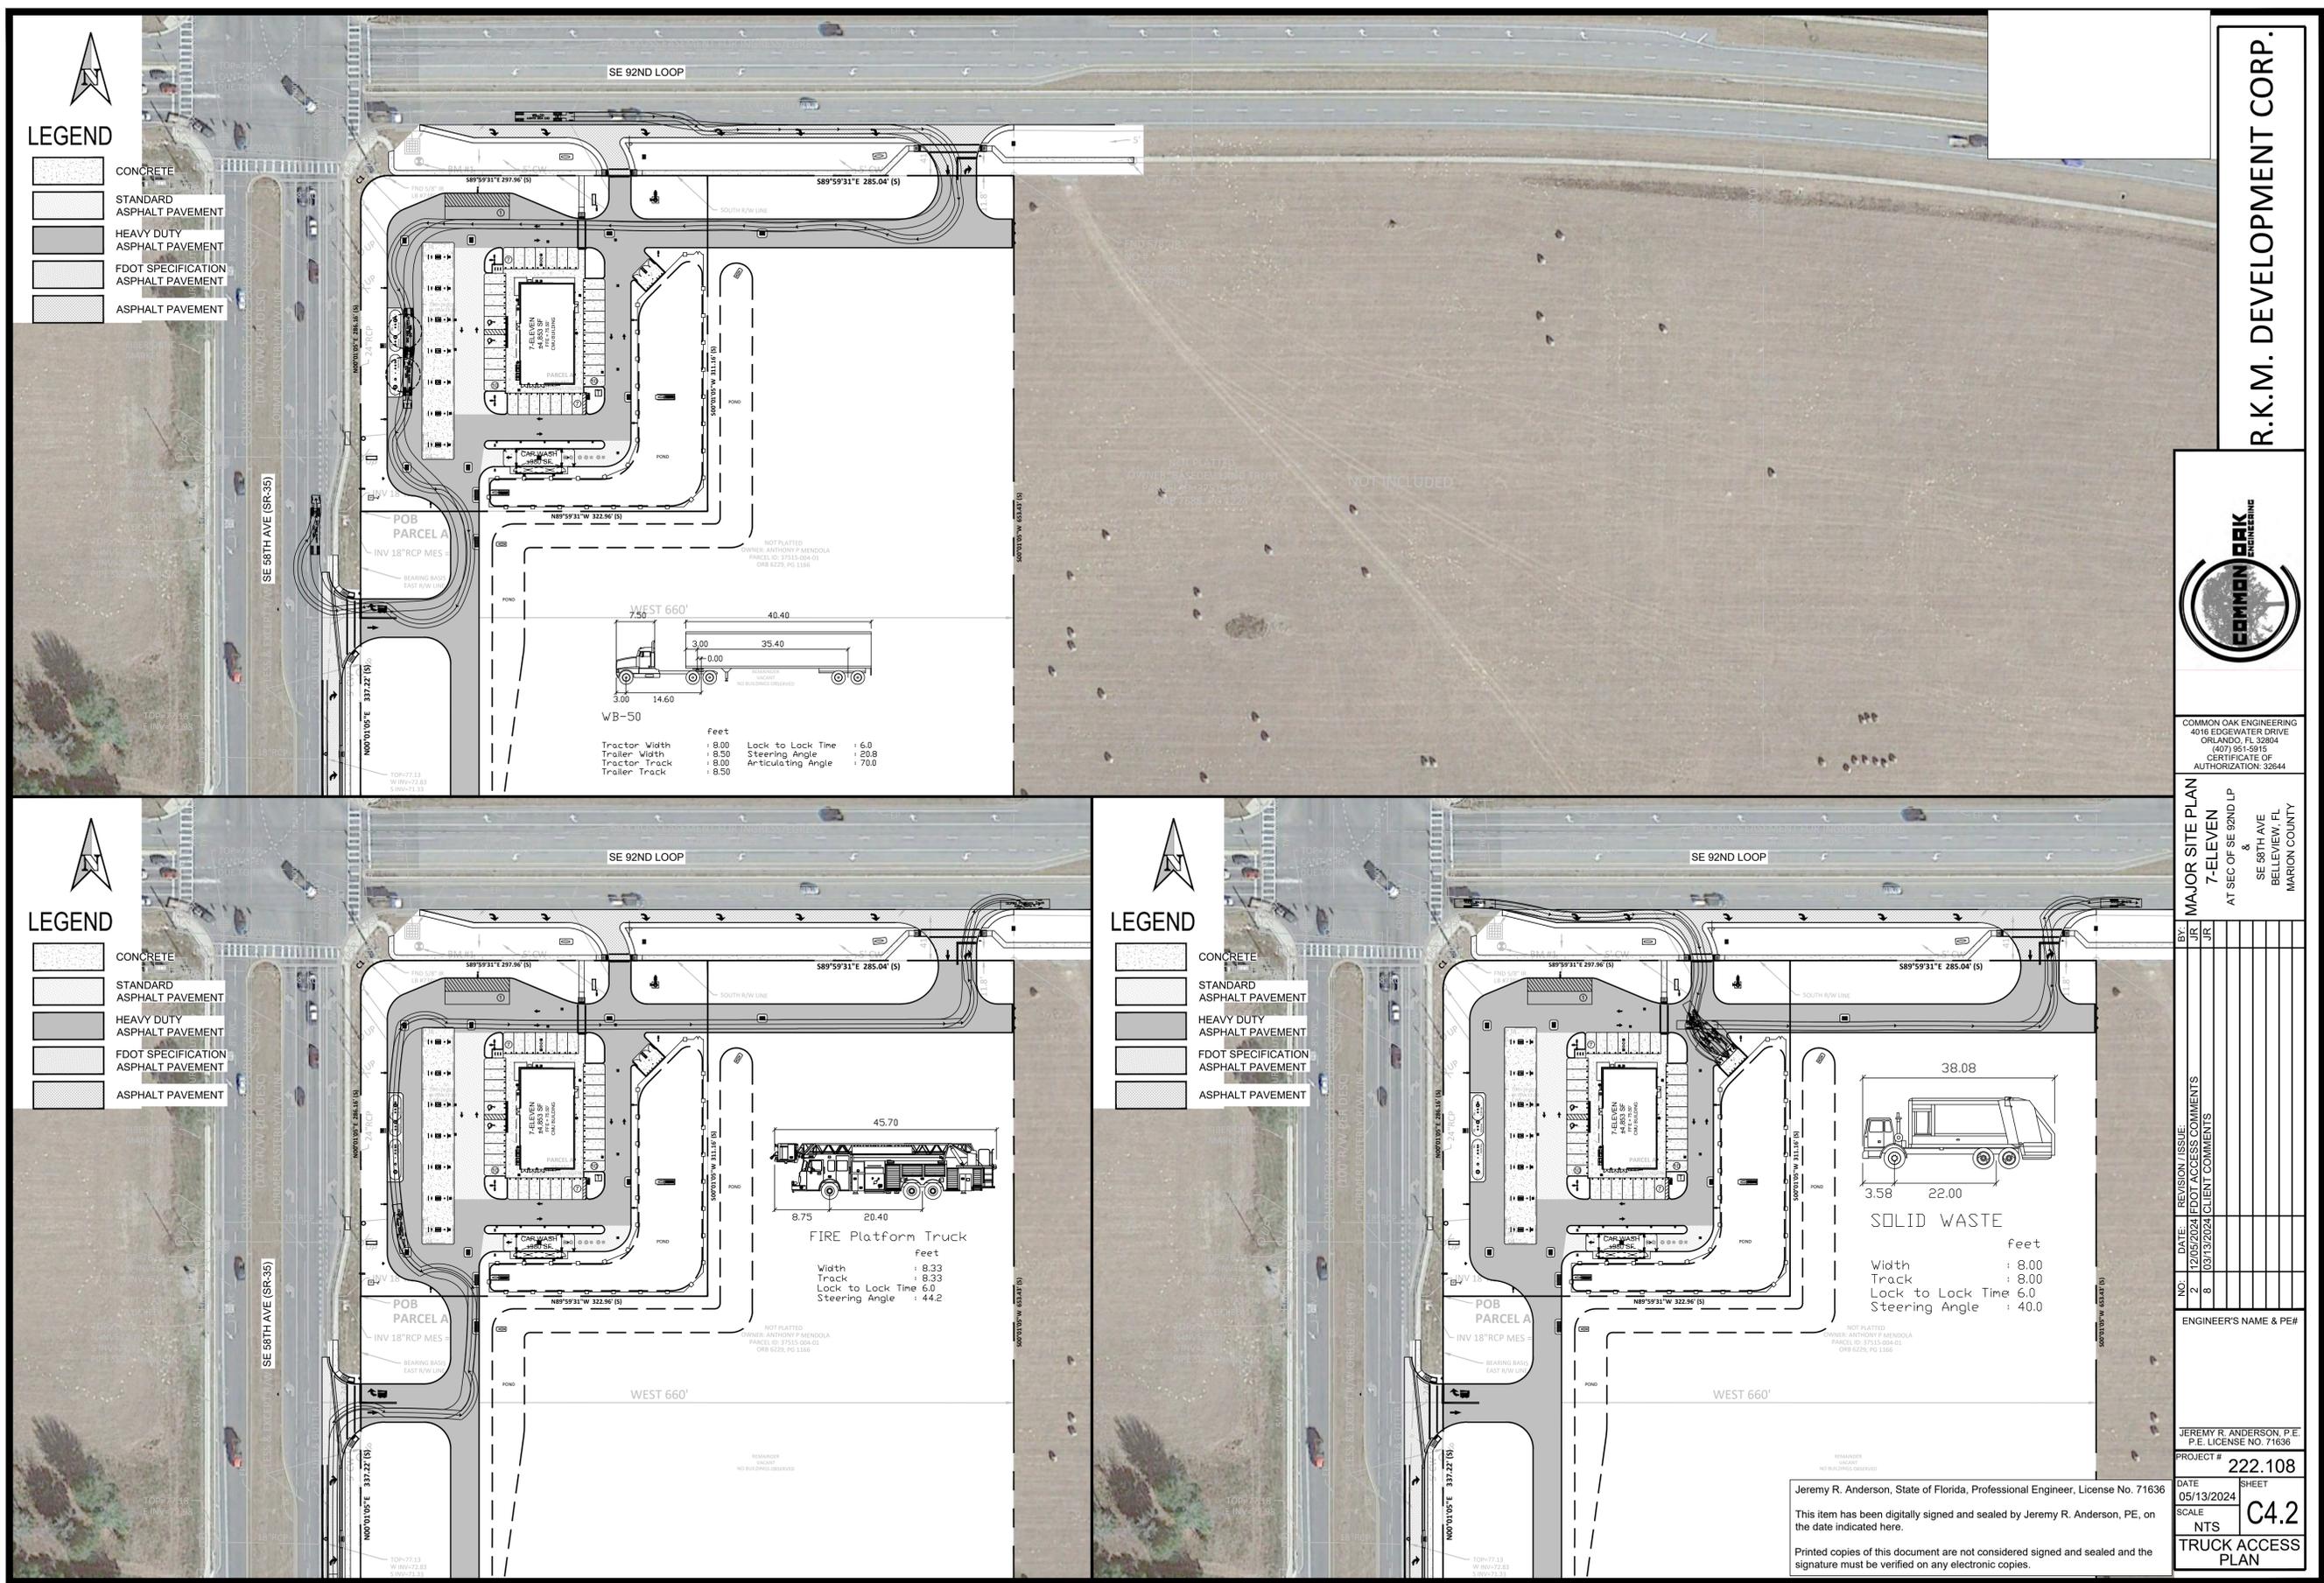

- LEGEND
- CONCRETE
 - STANDARD ASPHALT PAVEMENT
 - HEAVY DUTY ASPHALT PAVEMENT
 - FDOT SPECIFICATION ASPHALT PAVEMENT
 - ASPHALT PAVEMENT

- LEGEND
- CONCRETE
 - STANDARD ASPHALT PAVEMENT
 - HEAVY DUTY ASPHALT PAVEMENT
 - FDOT SPECIFICATION ASPHALT PAVEMENT
 - ASPHALT PAVEMENT

- LEGEND
- CONCRETE
 - STANDARD ASPHALT PAVEMENT
 - HEAVY DUTY ASPHALT PAVEMENT
 - FDOT SPECIFICATION ASPHALT PAVEMENT
 - ASPHALT PAVEMENT

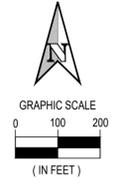

1 inch = 200 ft.
 ELEVATIONS BASED ON
 NAVD 88 VERTICAL DATUM
 CONVERSION:
 NGVD29 - NAVD88 = 0.919'



R.K.M. DEVELOPMENT CORP.



COMMON OAK ENGINEERING
 4016 EDGEWATER DRIVE
 ORLANDO, FL 32804
 (407) 951-5915
 CERTIFICATE OF
 AUTHORIZATION: 32844

MAJOR SITE PLAN
 7-ELEVEN
 &
 AT SEC OF SE 92ND LP
 SE 68TH AVE
 BELLEVUE, FL
 MARION COUNTY

BY: JR

NO.	DATE	REVISION / ISSUE	FOOT ACCESS COMMENTS
2	12/05/2024		

ENGINEER'S NAME & PE#


JEREMY R. ANDERSON, P.E.
 P.E. LICENSE NO. 71636

PROJECT # 222.108

DATE 05/13/2024
 SHEET C4.3


SCALE 1" = 200'
 DRIVEWAY SPACING PLAN

Jeremy R. Anderson, State of Florida, Professional Engineer, License No. 71636
 This item has been digitally signed and sealed by Jeremy R. Anderson, PE, on the date indicated here.
 Printed copies of this document are not considered signed and sealed and the signature must be verified on any electronic copies.

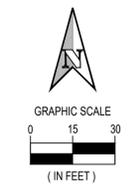

LEGEND

- CONCRETE
- HEAVY DUTY ASPHALT PAVEMENT
- FDOT SPECIFICATION ASPHALT PAVEMENT
- ASPHALT PAVEMENT

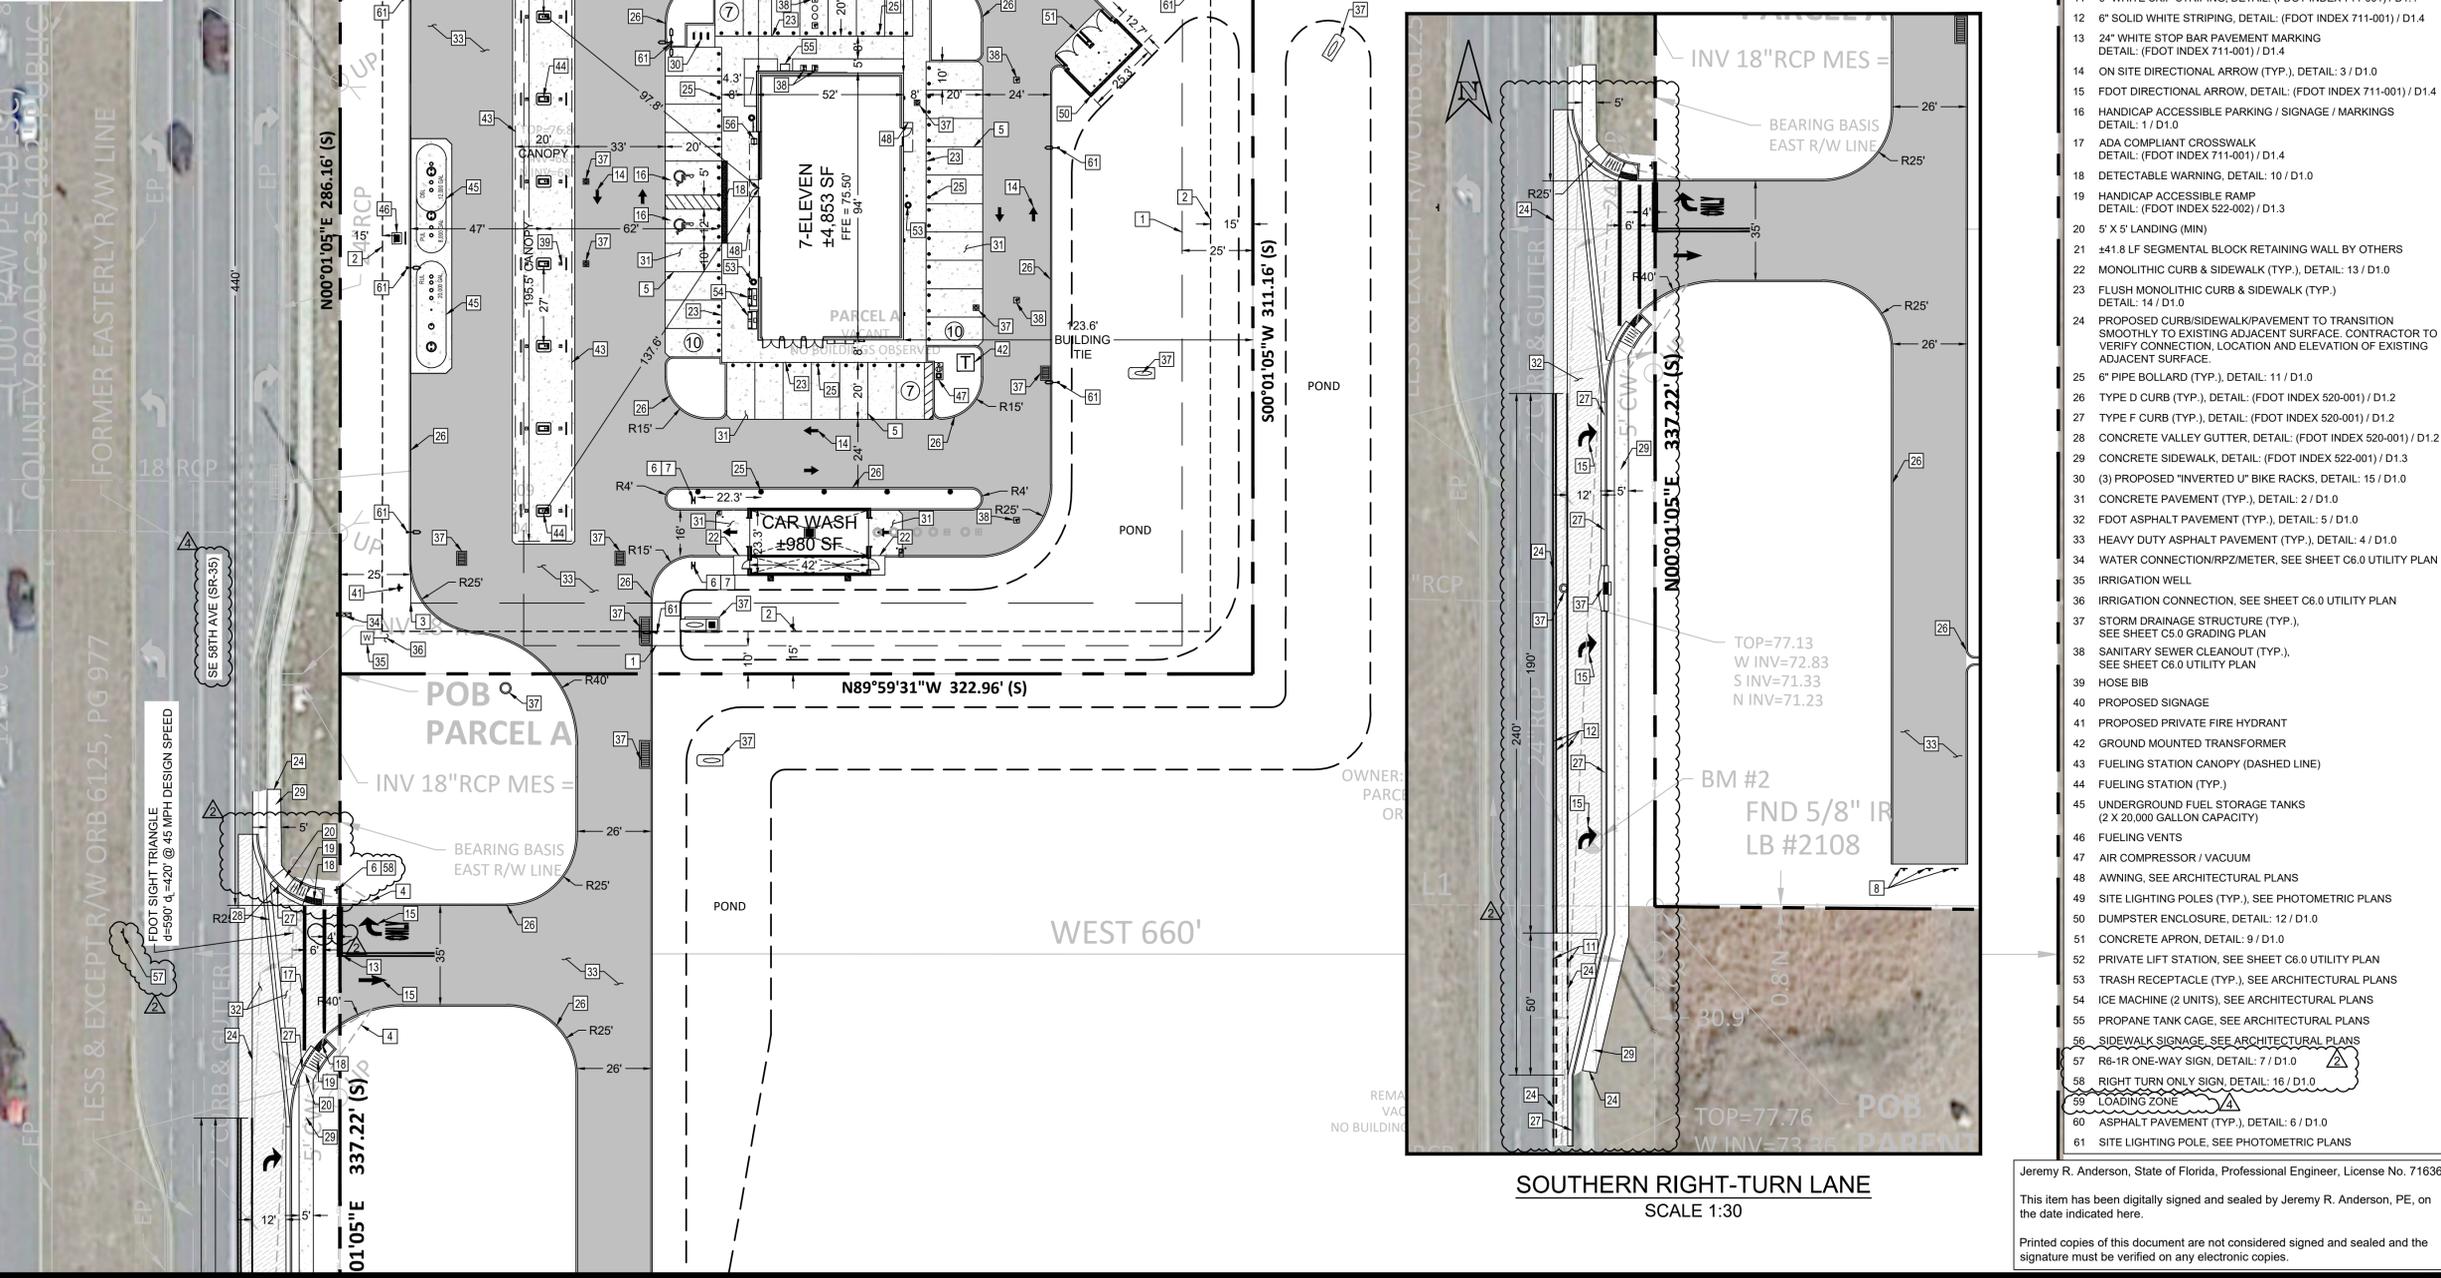

SITE PLAN NOTES

- 1 BUILDING SETBACK
- 2 LANDSCAPE BUFFER
- 3 ACCESSORY SETBACK
- 4 20' PEDESTRIAN SIGHT TRIANGLE
- 5 6" WHITE STRIPING (TYP.)
- 6 STOP SIGN & POST, DETAIL: 7 / D1.0
- 7 "DO NOT ENTER" SIGN & POST, DETAIL: 7 / D1.0
- 8 OM4-1 SIGN & POST, DETAIL: 8 / D1.0
- 9 RELOCATED 50 MPH SPEED LIMIT SIGN & POST
- 10 5' WIDE PAVED SHOULDER, DETAIL: 6 / D1.0
- 11 6" WHITE SKIP STRIPING, DETAIL: (FDOT INDEX 711-001) / D1.4
- 12 6" SOLID WHITE STRIPING, DETAIL: (FDOT INDEX 711-001) / D1.4
- 13 24" WHITE STOP BAR PAVEMENT MARKING DETAIL: (FDOT INDEX 711-001) / D1.4
- 14 ON SITE DIRECTIONAL ARROW (TYP.), DETAIL: 3 / D1.0
- 15 FDOT DIRECTIONAL ARROW, DETAIL: (FDOT INDEX 711-001) / D1.4
- 16 HANDICAP ACCESSIBLE PARKING / SIGNAGE / MARKINGS DETAIL: 1 / D1.0
- 17 ADA COMPLIANT CROSSWALK DETAIL: (FDOT INDEX 711-001) / D1.4
- 18 DETECTABLE WARNING, DETAIL: 10 / D1.0
- 19 HANDICAP ACCESSIBLE RAMP DETAIL: (FDOT INDEX 522-002) / D1.3
- 20 5' X 5' LANDING (MIN)
- 21 ±41.8 LF SEGMENTAL BLOCK RETAINING WALL BY OTHERS
- 22 MONOLITHIC CURB & SIDEWALK (TYP.), DETAIL: 13 / D1.0
- 23 FLUSH MONOLITHIC CURB & SIDEWALK (TYP.) DETAIL: 14 / D1.0
- 24 PROPOSED CURB/SIDEWALK/PAVEMENT TO TRANSITION SMOOTHLY TO EXISTING ADJACENT SURFACE. CONTRACTOR TO VERIFY CONNECTION, LOCATION AND ELEVATION OF EXISTING ADJACENT SURFACE.
- 25 6" PIPE BOLLARD (TYP.), DETAIL: 11 / D1.0
- 26 TYPE D CURB (TYP.), DETAIL: (FDOT INDEX 520-001) / D1.2
- 27 TYPE F CURB (TYP.), DETAIL: (FDOT INDEX 520-001) / D1.2
- 28 CONCRETE VALLEY GUTTER, DETAIL: (FDOT INDEX 520-001) / D1.2
- 29 CONCRETE SIDEWALK, DETAIL: (FDOT INDEX 522-001) / D1.3
- 30 (3) PROPOSED "INVERTED U" BIKE RACKS, DETAIL: 15 / D1.0
- 31 CONCRETE PAVEMENT (TYP.), DETAIL: 2 / D1.0
- 32 FDOT ASPHALT PAVEMENT (TYP.), DETAIL: 5 / D1.0
- 33 HEAVY DUTY ASPHALT PAVEMENT (TYP.), DETAIL: 4 / D1.0
- 34 WATER CONNECTION/RPZ/METER, SEE SHEET C6.0 UTILITY PLAN
- 35 IRRIGATION WELL
- 36 IRRIGATION CONNECTION, SEE SHEET C6.0 UTILITY PLAN
- 37 STORM DRAINAGE STRUCTURE (TYP.), SEE SHEET C6.0 GRADING PLAN
- 38 SANITARY SEWER CLEANOUT (TYP.), SEE SHEET C6.0 UTILITY PLAN
- 39 HOSE BIB
- 40 PROPOSED SIGNAGE
- 41 PROPOSED PRIVATE FIRE HYDRANT
- 42 GROUND MOUNTED TRANSFORMER
- 43 FUELING STATION CANOPY (DASHED LINE)
- 44 FUELING STATION (TYP.)
- 45 UNDERGROUND FUEL STORAGE TANKS (2 X 20,000 GALLON CAPACITY)
- 46 FUELING VENTS
- 47 AIR COMPRESSOR / VACUUM
- 48 AWNING, SEE ARCHITECTURAL PLANS
- 49 SITE LIGHTING POLES (TYP.), SEE PHOTOMETRIC PLANS
- 50 DUMPSTER ENCLOSURE, DETAIL: 12 / D1.0
- 51 CONCRETE APRON, DETAIL: 9 / D1.0
- 52 PRIVATE LIFT STATION, SEE SHEET C6.0 UTILITY PLAN
- 53 TRASH RECEPTACLE (TYP.), SEE ARCHITECTURAL PLANS
- 54 ICE MACHINE (2 UNITS), SEE ARCHITECTURAL PLANS
- 55 PROPANE TANK CAGE, SEE ARCHITECTURAL PLANS
- 56 SIDEWALK SIGNAGE, SEE ARCHITECTURAL PLANS
- 57 R6-1R ONE-WAY SIGN, DETAIL: 7 / D1.0
- 58 RIGHT TURN ONLY SIGN, DETAIL: 16 / D1.0
- 59 LOADING ZONE
- 60 ASPHALT PAVEMENT (TYP.), DETAIL: 6 / D1.0
- 61 SITE LIGHTING POLE, SEE PHOTOMETRIC PLANS

R.K.M. DEVELOPMENT CORP.



COMMON OAK ENGINEERING
4016 EDGEWATER DRIVE
ORLANDO, FL 32804
(407) 951-5915
CERTIFICATE OF AUTHORIZATION: 32944

MAJOR SITE PLAN
7-ELEVEN
SE 58TH AVE
BELLEVUE, FL
MARION COUNTY


NO.	DATE	REVISION / ISSUE	FOOT ACCESS COMMENTS
1	12/15/2024	MAJOR SITE PLAN	
2	12/15/2024	FOOT ACCESS COMMENTS	
4			

ENGINEER'S NAME & PE#
JEREMY R. ANDERSON, P.E.
P.E. LICENSE NO. 71636
PROJECT # 222.108

DATE SHEET
02/08/2024
SCALE
1" = 30'
C4.1
SITE PLAN

Jeremy R. Anderson, State of Florida, Professional Engineer, License No. 71636
This item has been digitally signed and sealed by Jeremy R. Anderson, PE, on the date indicated here.
Printed copies of this document are not considered signed and sealed and the signature must be verified on any electronic copies.

SOUTHERN RIGHT-TURN LANE
SCALE 1:30

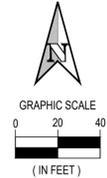

1 inch = 40 ft.
ELEVATIONS BASED ON
NAVD 88 VERTICAL DATUM
CONVERSION:
NGVD29 - NAVD88 = 0.919'

TOP=77.31
E INV=71.61

TOP=76.44
E INV=71.44

TOP=76.54
SW INV=67.84
N INV=67.54

LIFT STATION
(LOCKED)


TOP=77.16
N INV=72.76
S INV=72.71
PIPE SIZE UNKNOWN

TOP=77.18
E INV=72.98

TOP=77.13
W INV=72.83
S INV=71.23
N INV=71.23

TOP=77.13
W INV=72.83
S INV=71.23
N INV=71.23

TOP=77.13
W INV=72.83
S INV=71.23
N INV=71.23

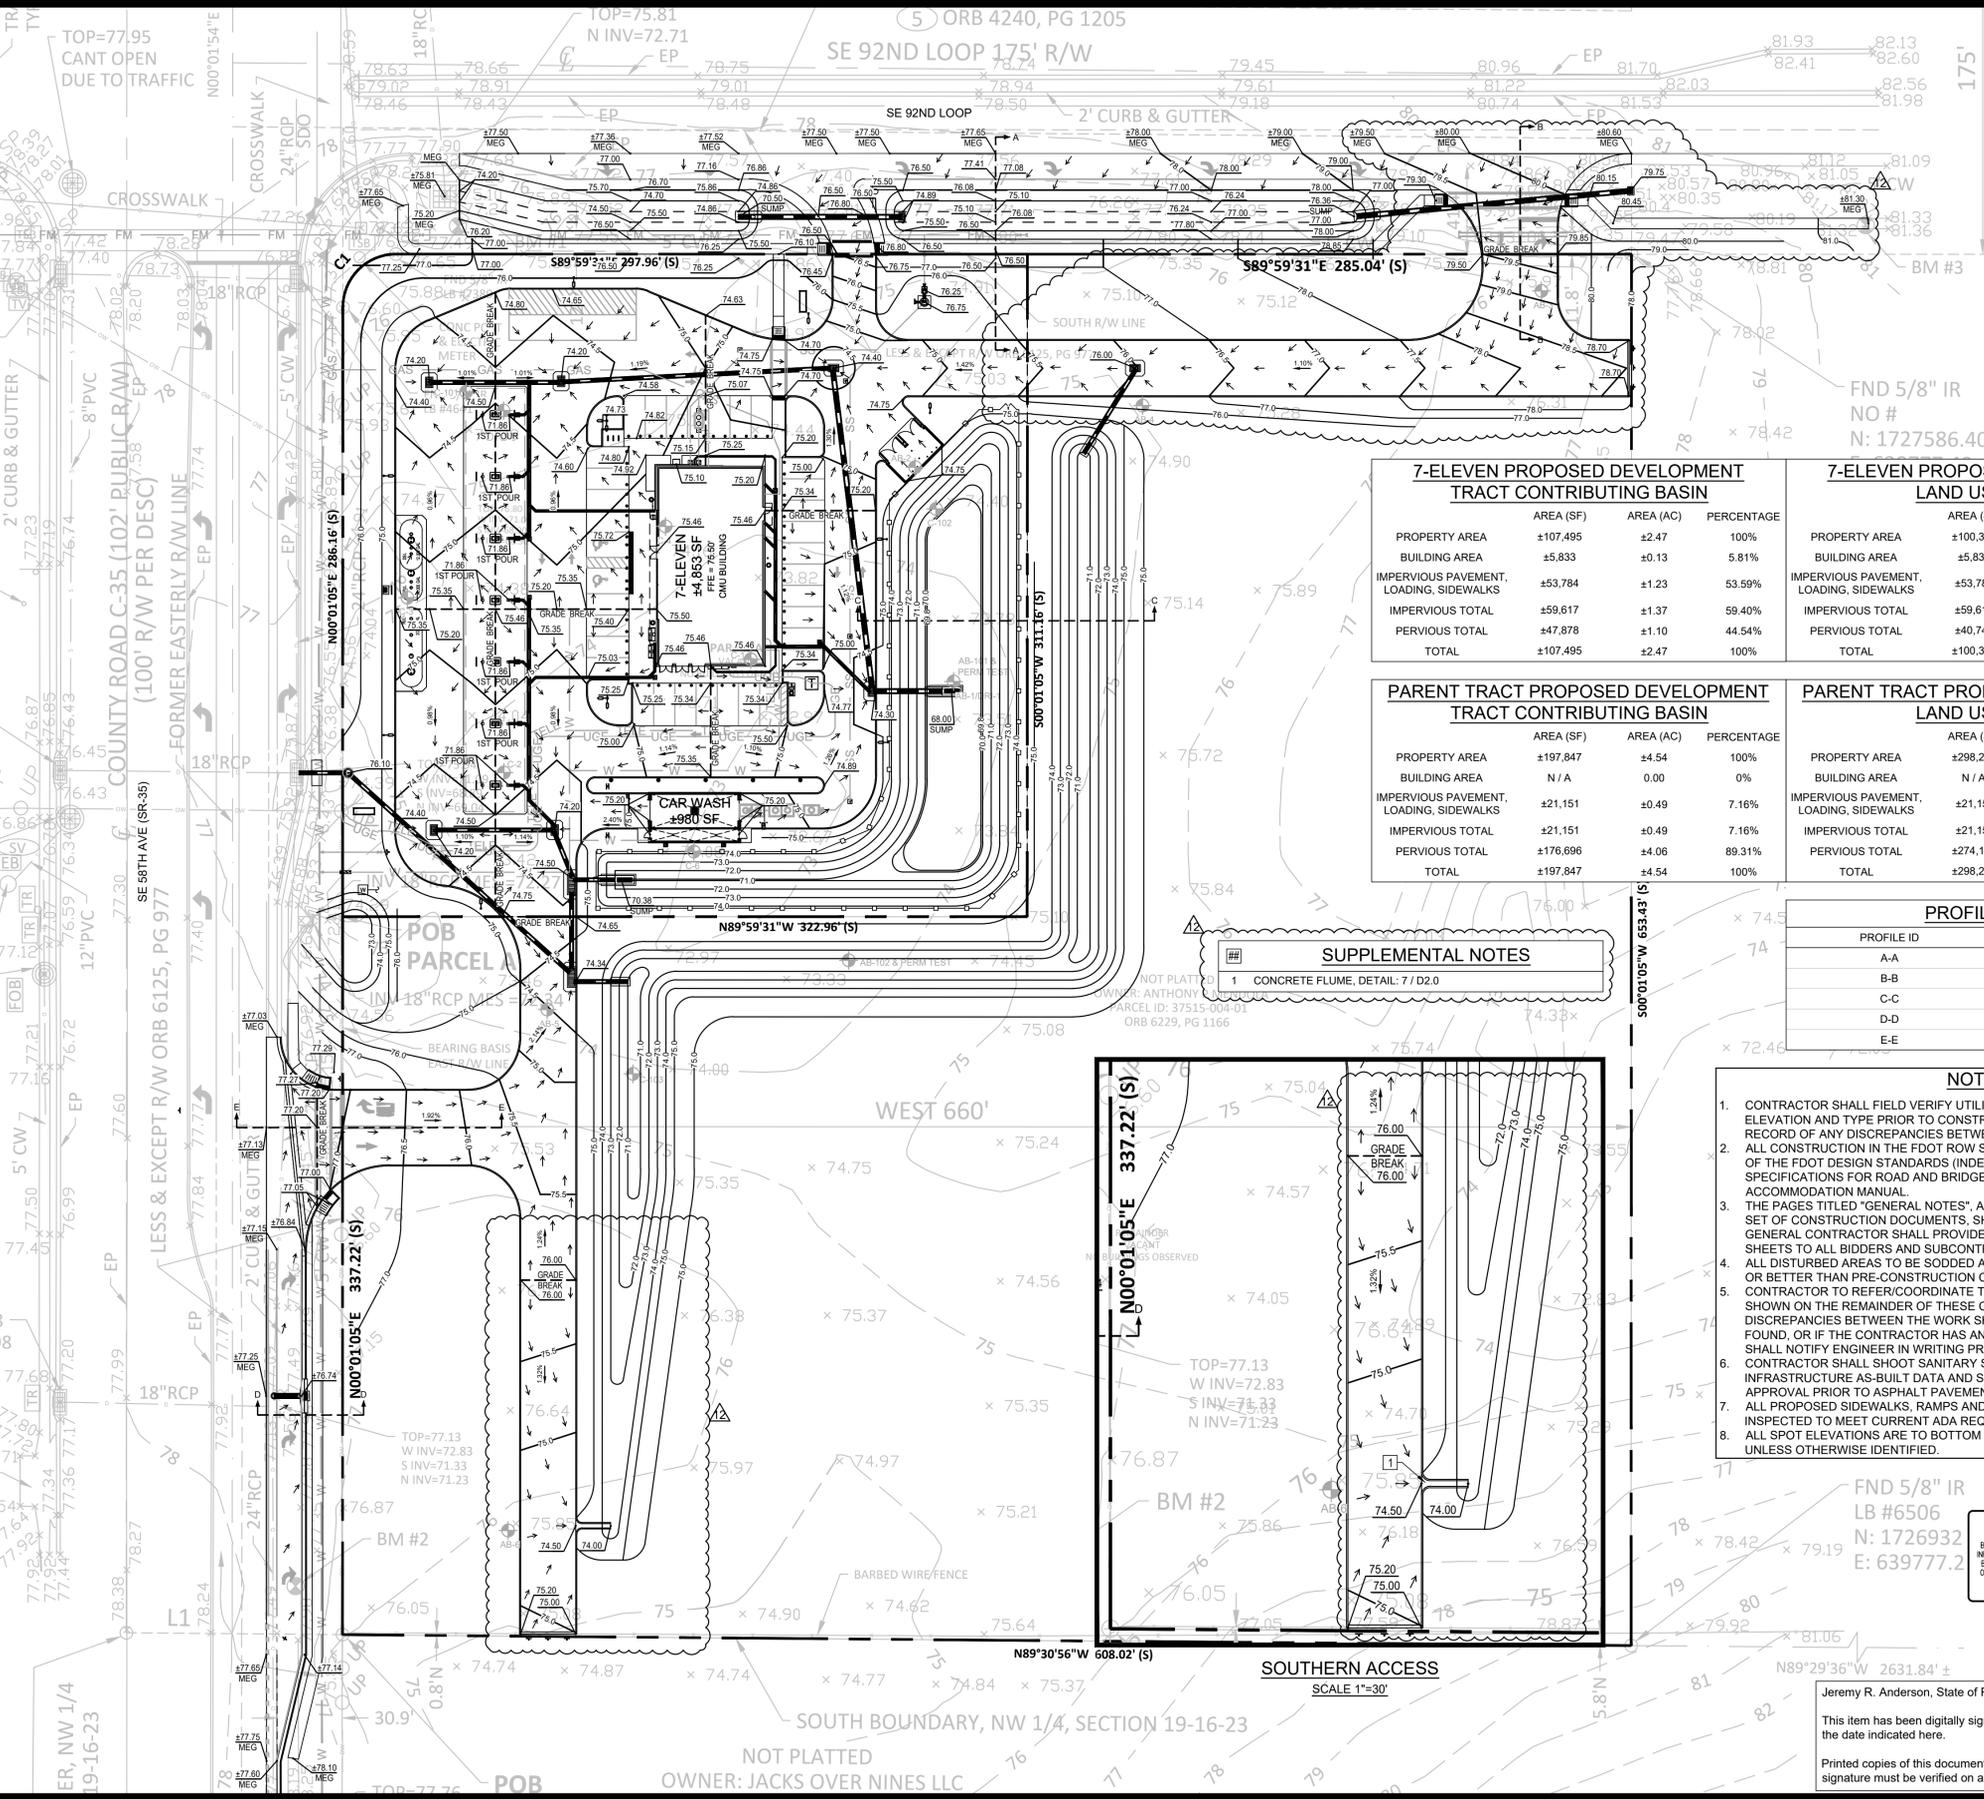

7-ELEVEN PROPOSED DEVELOPMENT TRACT CONTRIBUTING BASIN			
	AREA (SF)	AREA (AC)	PERCENTAGE
PROPERTY AREA	±107,495	±2.47	100%
BUILDING AREA	±5,833	±0.13	5.81%
IMPERVIOUS PAVEMENT, LOADING, SIDEWALKS	±53,784	±1.23	53.59%
IMPERVIOUS TOTAL	±59,617	±1.37	59.40%
PERVIOUS TOTAL	±47,878	±1.10	44.54%
TOTAL	±107,495	±2.47	100%

7-ELEVEN PROPOSED DEVELOPMENT LAND USE AREAS			
	AREA (SF)	AREA (AC)	PERCENTAGE
PROPERTY AREA	±100,357	±2.30	100%
BUILDING AREA	±5,833	±0.13	5.81%
IMPERVIOUS PAVEMENT, LOADING, SIDEWALKS	±53,784	±1.23	53.59%
IMPERVIOUS TOTAL	±59,617	±1.37	59.40%
PERVIOUS TOTAL	±40,740	±0.94	40.60%
TOTAL	±100,357	±2.30	100%

PARENT TRACT PROPOSED DEVELOPMENT TRACT CONTRIBUTING BASIN			
	AREA (SF)	AREA (AC)	PERCENTAGE
PROPERTY AREA	±197,847	±4.54	100%
BUILDING AREA	N/A	0.00	0%
IMPERVIOUS PAVEMENT, LOADING, SIDEWALKS	±21,151	±0.49	7.16%
IMPERVIOUS TOTAL	±21,151	±0.49	7.16%
PERVIOUS TOTAL	±176,696	±4.06	89.31%
TOTAL	±197,847	±4.54	100%

PARENT TRACT PROPOSED DEVELOPMENT LAND USE AREAS			
	AREA (SF)	AREA (AC)	PERCENTAGE
PROPERTY AREA	±298,257	±6.78	100%
BUILDING AREA	N/A	0.00	0%
IMPERVIOUS PAVEMENT, LOADING, SIDEWALKS	±21,151	±0.49	7.16%
IMPERVIOUS TOTAL	±21,151	±0.49	7.16%
PERVIOUS TOTAL	±274,106	±6.29	92.84%
TOTAL	±298,257	±6.78	100%

SUPPLEMENTAL NOTES

1 CONCRETE FLUME, DETAIL: 7 / D2.0

PROFILE INDEX	
PROFILE ID	SHEET
A-A	D2.4
B-B	D2.4
C-C	D2.4
D-D	D2.5
E-E	D2.5


- NOTES:**
- CONTRACTOR SHALL FIELD VERIFY UTILITY POINT OF CONNECTIONS LOCATION, ELEVATION AND TYPE PRIOR TO CONSTRUCTION AND NOTIFY ENGINEER OF RECORD OF ANY DISCREPANCIES BETWEEN THE PLANS AND EXISTING FACILITIES.
 - ALL CONSTRUCTION IN THE FDOT ROW SHALL CONFORM TO THE LATEST EDITIONS OF THE FDOT DESIGN STANDARDS (INDEXES), THE FDOT STANDARD SPECIFICATIONS FOR ROAD AND BRIDGE CONSTRUCTION, AND THE FDOT UTILITY ACCOMMODATION MANUAL.
 - THE PAGES TITLED "GENERAL NOTES", AS LISTED ON THE COVER PAGE OF THIS SET OF CONSTRUCTION DOCUMENTS, SHALL APPLY TO ALL SHEETS HEREIN. THE GENERAL CONTRACTOR SHALL PROVIDE A COPY OF THE "GENERAL NOTES" SHEETS TO ALL BIDDERS AND SUBCONTRACTORS.
 - ALL DISTURBED AREAS TO BE SODDED AND RESTORED TO A CONDITION EQUAL TO OR BETTER THAN PRE-CONSTRUCTION CONDITION.
 - CONTRACTOR TO REFER/COORDINATE THE WORK SHOWN HEREIN WITH THE WORK SHOWN ON THE REMAINDER OF THESE CONSTRUCTION DOCUMENTS. IF ANY DISCREPANCIES BETWEEN THE WORK SHOWN ON THIS AND OTHER PAGES IS FOUND, OR IF THE CONTRACTOR HAS ANY QUESTIONS OF ANY KIND, CONTRACTOR SHALL NOTIFY ENGINEER IN WRITING PRIOR TO THE PERFORMANCE OF ANY WORK.
 - CONTRACTOR SHALL SHOOT SANITARY SEWER AND STORM WATER INFRASTRUCTURE AS-BUILT DATA AND SUBMIT TO ENGINEER OF RECORD FOR APPROVAL PRIOR TO ASPHALT PAVEMENT AND BASE COURSE INSTALLATION.
 - ALL PROPOSED SIDEWALKS, RAMPS AND CROSSWALKS SHALL BE BUILT AND INSPECTED TO MEET CURRENT ADA REQUIREMENTS, SEE "GENERAL NOTES".
 - ALL SPOT ELEVATIONS ARE TO BOTTOM OF CURB (TOP OF ASPHALT/CONCRETE) UNLESS OTHERWISE IDENTIFIED.

BURIED UTILITIES NOTE

BURIED UTILITIES ARE SHOWN AT THEIR APPROXIMATE LOCATION BASED UPON INFORMATION OBTAINED FROM UTILITY COMPANIES AND FIELD CHECKS. OTHER BURIED UTILITIES MIGHT EXIST ON THE SUBJECT SITE WHICH ARE NOT SHOWN ON THIS DRAWING. USE EXTREME CAUTION DURING EXCAVATION PROCEDURES AND CONTACT SUNDANCE, STATE ONE AT 1-800-432-4770 FOR EXACT LOCATION OF BURIED FACILITIES PRIOR TO EXCAVATION OPERATIONS.



CALL BEFORE YOU DIG...
1-800-432-4770
UTILITY PROTECTION CENTER
IT'S THE LAW

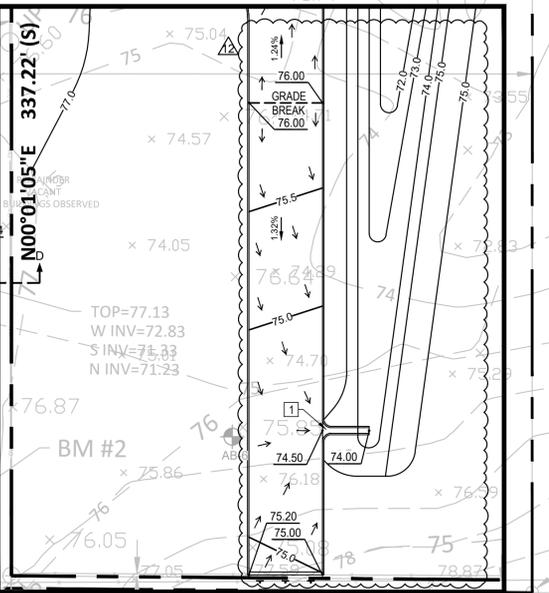

SOUTHERN ACCESS
SCALE 1"=30'

R.K.M. DEVELOPMENT CORP.

COMMON OAK ENGINEERING

COMMON OAK ENGINEERING
4016 EDGEWATER DRIVE
ORLANDO, FL 32804
(407) 951-5915
CERTIFICATE OF AUTHORIZATION: 32844

MAJOR SITE PLAN
7-ELEVEN
AT SEC OF SE 92ND LP
&
SE 58TH AVE
BELLEVUE, FL
MARION COUNTY

BY: JR	REVISION/ISSUE:	DATE:	NO:	ENGINEER'S NAME & PE#
JR	MARION COUNTY COMMENTS	12/15/2024	1	JEREMY R. ANDERSON, P.E. P.E. LICENSE NO. 71636
JR	MARION COUNTY COMMENTS	03/22/2024	2	PROJECT #
JR	MARION COUNTY COMMENTS	04/22/2024	12	222.108

DATE: 05/13/2024
SHEET: C5.0
SCALE: 1" = 40'
OVERALL GRADING PLAN

Jeremy R. Anderson, State of Florida, Professional Engineer, License No. 71636

This item has been digitally signed and sealed by Jeremy R. Anderson, PE, on the date indicated here.

Printed copies of this document are not considered signed and sealed and the signature must be verified on any electronic copies.





COMMON OAK ENGINEERING
4016 EDGEWATER DRIVE
ORLANDO, FL 32834
(407) 951-5915
CERTIFICATE OF
AUTHORIZATION: 32844

MAJOR SITE PLAN
7-ELEVEN
AT SEC OF SE 92ND LP
&
SE 58TH AVE
BELLEVUE, FL
MARION COUNTY

NO.	DATE	REVISION / ISSUE	ENGINEER'S NAME & PE#
1	12/15/2024	MARION COUNTY COMMENTS	JEREMY R. ANDERSON, P.E. LICENSE NO. 71636
2	01/16/2024	FEED DRAINAGE COMMENTS	
3	02/08/2024	FEED DRAINAGE COMMENTS	
4	04/16/2024	CLIENT COMMENTS	
5	04/23/2024	FEED ACCESS COMMENTS	




PROJECT # 222.108
SHEET C5.1
DATE 05/13/2024
SCALE 1" = 30'

GRADING PLAN

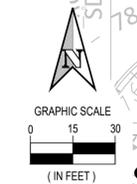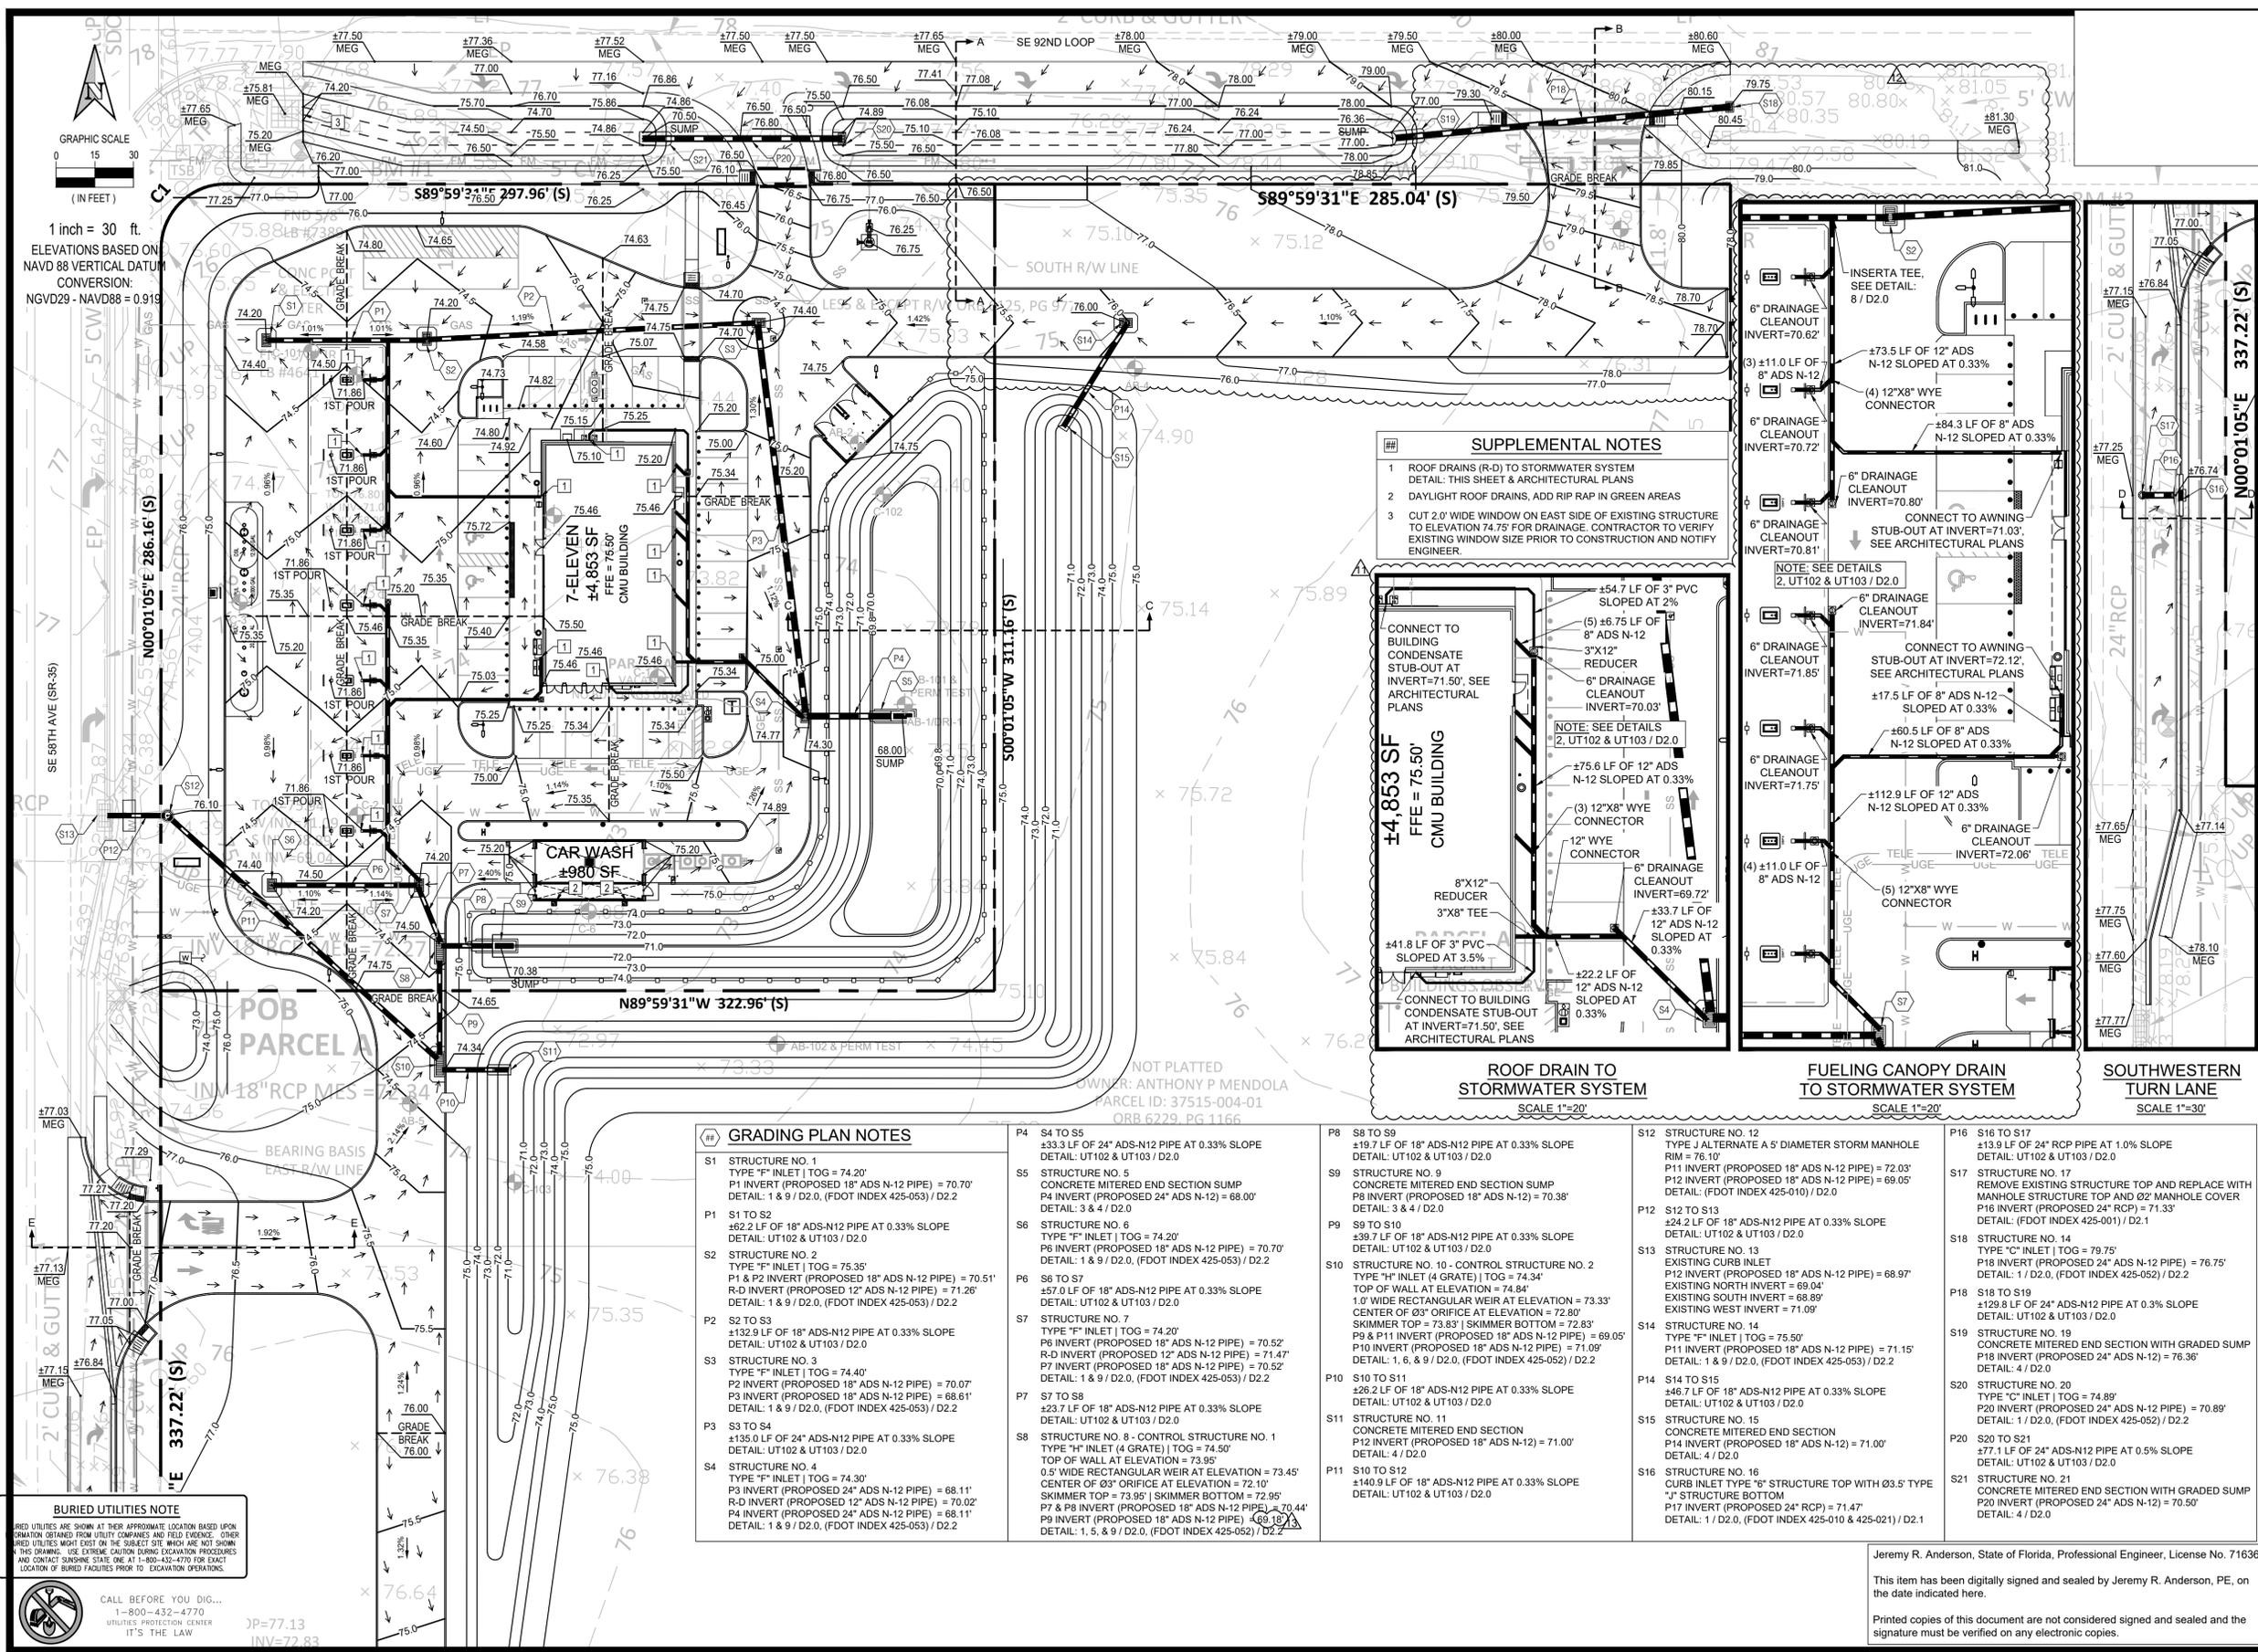

1 inch = 30 ft.
ELEVATIONS BASED ON
NAVD 88 VERTICAL DATUM
CONVERSION:
NGVD29 - NAVD88 = 0.913

- SUPPLEMENTAL NOTES**
- ROOF DRAINS (R-D) TO STORMWATER SYSTEM
DETAIL: THIS SHEET & ARCHITECTURAL PLANS
 - DAYLIGHT ROOF DRAINS, ADD RIP RAP IN GREEN AREAS
 - CUT 2.0' WIDE WINDOW ON EAST SIDE OF EXISTING STRUCTURE TO ELEVATION 74.75' FOR DRAINAGE. CONTRACTOR TO VERIFY EXISTING WINDOW SIZE PRIOR TO CONSTRUCTION AND NOTIFY ENGINEER.

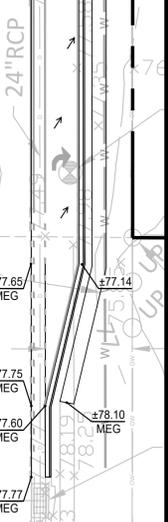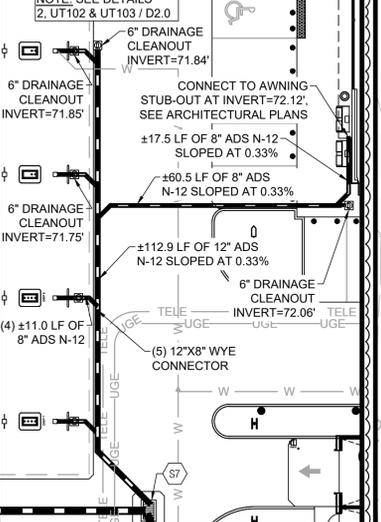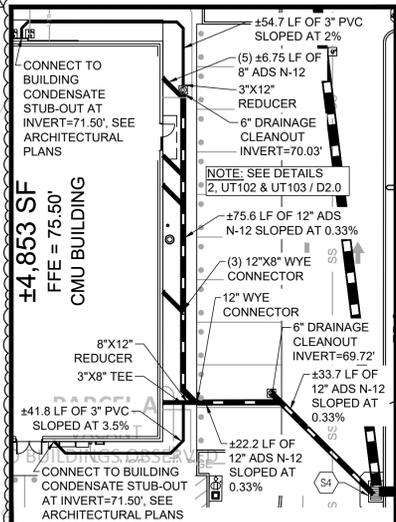

GRADING PLAN NOTES

- S1 STRUCTURE NO. 1
TYPE "F" INLET | TOG = 74.20'
P1 INVERT (PROPOSED 18" ADS N-12 PIPE) = 70.70'
DETAIL: 1 & 9 / D2.0, (FDOT INDEX 425-053) / D2.2
- S2 STRUCTURE NO. 2
TYPE "F" INLET | TOG = 75.35'
P1 & P2 INVERT (PROPOSED 18" ADS N-12 PIPE) = 70.51'
R-D INVERT (PROPOSED 12" ADS N-12 PIPE) = 71.26'
DETAIL: 1 & 9 / D2.0, (FDOT INDEX 425-053) / D2.2
- S3 STRUCTURE NO. 3
TYPE "F" INLET | TOG = 74.40'
P2 INVERT (PROPOSED 18" ADS N-12 PIPE) = 70.07'
P3 INVERT (PROPOSED 18" ADS N-12 PIPE) = 68.61'
DETAIL: 1 & 9 / D2.0, (FDOT INDEX 425-053) / D2.2
- S4 STRUCTURE NO. 4
TYPE "F" INLET | TOG = 74.30'
P3 INVERT (PROPOSED 24" ADS N-12 PIPE) = 68.11'
R-D INVERT (PROPOSED 12" ADS N-12 PIPE) = 70.02'
P4 INVERT (PROPOSED 24" ADS N-12 PIPE) = 68.11'
DETAIL: 1 & 9 / D2.0, (FDOT INDEX 425-053) / D2.2

- P4 S4 TO S5
±33.3 LF OF 24" ADS-N12 PIPE AT 0.33% SLOPE
DETAIL: UT102 & UT103 / D2.0
- S5 STRUCTURE NO. 5
CONCRETE MITERED END SECTION SUMP
P4 INVERT (PROPOSED 24" ADS N-12) = 68.00'
DETAIL: 3 & 4 / D2.0
- S6 STRUCTURE NO. 6
TYPE "F" INLET | TOG = 74.20'
P6 INVERT (PROPOSED 18" ADS N-12 PIPE) = 70.70'
DETAIL: 1 & 9 / D2.0, (FDOT INDEX 425-053) / D2.2
- S7 STRUCTURE NO. 7
TYPE "F" INLET | TOG = 74.20'
P6 INVERT (PROPOSED 18" ADS N-12 PIPE) = 70.52'
P7 INVERT (PROPOSED 18" ADS N-12 PIPE) = 70.52'
DETAIL: 1 & 9 / D2.0, (FDOT INDEX 425-052) / D2.2
- S8 STRUCTURE NO. 8 - CONTROL STRUCTURE NO. 1
TYPE "H" INLET (4 GRATE) | TOG = 74.50'
TOP OF WALL AT ELEVATION = 73.95'
0.5' WIDE RECTANGULAR WEIR AT ELEVATION = 72.10'
SKIMMER TOP = 73.95' | SKIMMER BOTTOM = 72.95'
P7 & P8 INVERT (PROPOSED 18" ADS N-12 PIPE) = 70.44'
P9 INVERT (PROPOSED 18" ADS N-12 PIPE) = 69.18'
DETAIL: 1, 5, & 9 / D2.0, (FDOT INDEX 425-052) / D2.2

- S9 STRUCTURE NO. 9
CONCRETE MITERED END SECTION SUMP
P8 INVERT (PROPOSED 18" ADS N-12) = 70.38'
DETAIL: 3 & 4 / D2.0
- S10 STRUCTURE NO. 10 - CONTROL STRUCTURE NO. 2
TYPE "H" INLET (4 GRATE) | TOG = 74.34'
TOP OF WALL AT ELEVATION = 74.84'
1.0' WIDE RECTANGULAR WEIR AT ELEVATION = 73.33'
CENTER OF ORIFICE AT ELEVATION = 72.80'
SKIMMER TOP = 73.83' | SKIMMER BOTTOM = 72.83'
P9 & P11 INVERT (PROPOSED 18" ADS N-12 PIPE) = 69.05'
P10 INVERT (PROPOSED 18" ADS N-12 PIPE) = 71.09'
DETAIL: 1, 6, & 9 / D2.0, (FDOT INDEX 425-052) / D2.2
- S11 STRUCTURE NO. 11
CONCRETE MITERED END SECTION
P12 INVERT (PROPOSED 18" ADS N-12) = 71.00'
DETAIL: 4 / D2.0
- S12 STRUCTURE NO. 12
TYPE "J" ALTERNATE A 5' DIAMETER STORM MANHOLE
RIM = 76.10'
P11 INVERT (PROPOSED 18" ADS N-12 PIPE) = 72.03'
P12 INVERT (PROPOSED 18" ADS N-12 PIPE) = 69.05'
DETAIL: (FDOT INDEX 425-010) / D2.0
- S13 STRUCTURE NO. 13
EXISTING CURB INLET
P12 INVERT (PROPOSED 18" ADS N-12 PIPE) = 68.97'
EXISTING NORTH INVERT = 69.04'
EXISTING SOUTH INVERT = 68.89'
EXISTING WEST INVERT = 71.09'
- S14 STRUCTURE NO. 14
TYPE "F" INLET | TOG = 75.50'
P11 INVERT (PROPOSED 18" ADS N-12 PIPE) = 71.15'
DETAIL: 1 & 9 / D2.0, (FDOT INDEX 425-053) / D2.2
- S15 STRUCTURE NO. 15
CONCRETE MITERED END SECTION
P14 INVERT (PROPOSED 18" ADS N-12) = 71.00'
DETAIL: 4 / D2.0
- S16 STRUCTURE NO. 16
CURB INLET TYPE "6" STRUCTURE TOP WITH Ø3.5' TYPE "J" STRUCTURE BOTTOM
P17 INVERT (PROPOSED 24" RCP) = 71.47'
DETAIL: 1 / D2.0, (FDOT INDEX 425-010 & 425-021) / D2.1

- S17 STRUCTURE NO. 17
REMOVE EXISTING STRUCTURE TOP AND REPLACE WITH MANHOLE STRUCTURE TOP AND Ø2' MANHOLE COVER
P16 INVERT (PROPOSED 24" RCP) = 71.33'
DETAIL: (FDOT INDEX 425-001) / D2.1
- S18 STRUCTURE NO. 18
TYPE "C" INLET | TOG = 79.75'
P18 INVERT (PROPOSED 24" ADS N-12 PIPE) = 76.75'
DETAIL: 1 / D2.0, (FDOT INDEX 425-052) / D2.2
- S19 STRUCTURE NO. 19
CONCRETE MITERED END SECTION WITH GRADED SUMP
P18 INVERT (PROPOSED 24" ADS N-12) = 76.36'
DETAIL: 4 / D2.0
- S20 STRUCTURE NO. 20
TYPE "C" INLET | TOG = 74.89'
P20 INVERT (PROPOSED 24" ADS N-12 PIPE) = 70.89'
DETAIL: 1 / D2.0, (FDOT INDEX 425-052) / D2.2
- S21 STRUCTURE NO. 21
CONCRETE MITERED END SECTION WITH GRADED SUMP
P20 INVERT (PROPOSED 24" ADS N-12) = 70.50'
DETAIL: 4 / D2.0



BURIED UTILITIES NOTE
BURIED UTILITIES ARE SHOWN AT THEIR APPROXIMATE LOCATION BASED UPON INFORMATION OBTAINED FROM UTILITY COMPANIES AND FIELD EVIDENCE. OTHER BURIED UTILITIES MIGHT EXIST ON THE SUBJECT SITE WHICH ARE NOT SHOWN IN THIS DRAWING. USE EXTREME CAUTION DURING EXCAVATION PROCEDURES AND CONTACT SUNDING STATE ONE 811-888-432-4770 FOR EXACT LOCATION OF BURIED FACILITIES PRIOR TO EXCAVATION OPERATIONS.



CALL BEFORE YOU DIG...
1-800-432-4770
UTILITIES PROTECTION CENTER
IT'S THE LAW

Jeremy R. Anderson, State of Florida, Professional Engineer, License No. 71636
This item has been digitally signed and sealed by Jeremy R. Anderson, PE, on the date indicated here.

Printed copies of this document are not considered signed and sealed and the signature must be verified on any electronic copies.

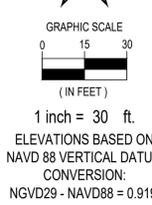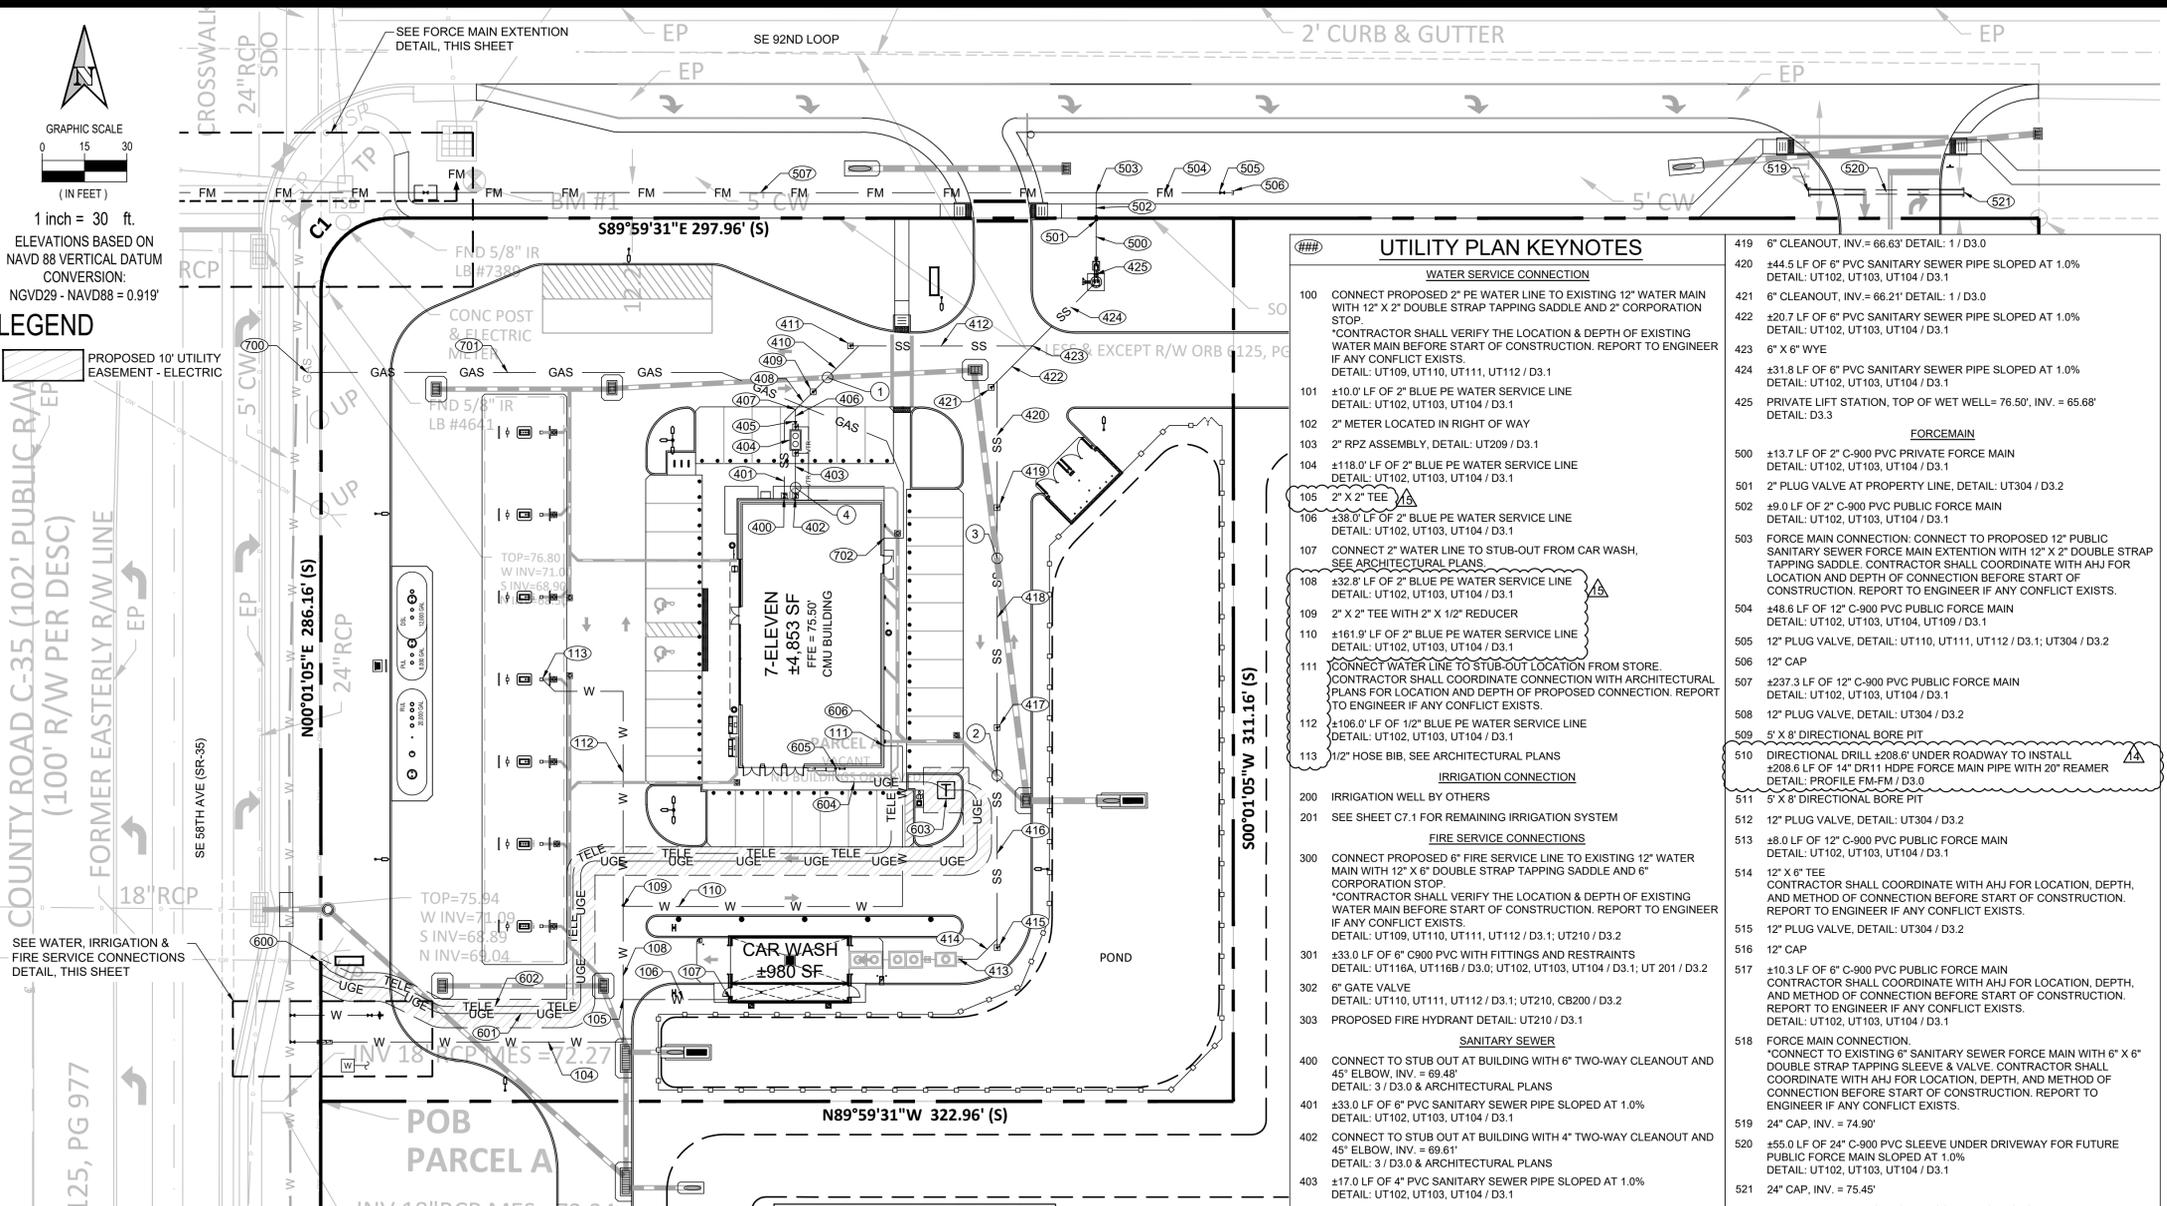

LEGEND



- NOTES:**
- CONTRACTOR SHALL FIELD VERIFY UTILITY POINTS OF CONNECTION LOCATION, ELEVATION AND TYPE PRIOR TO CONSTRUCTION AND NOTIFY ENGINEER OF RECORD OF ANY DISCREPANCIES BETWEEN THE PLANS AND EXISTING FACILITIES.
 - ALL CONSTRUCTION IN THE FDOT ROW SHALL CONFORM TO THE LATEST EDITIONS OF THE FDOT DESIGN STANDARDS (INDEXES), THE FDOT STANDARD SPECIFICATIONS FOR ROAD AND BRIDGE CONSTRUCTION, AND THE FDOT UTILITY ACCOMMODATION MANUAL.
 - ALL PROFILES SHOWING EXISTING UTILITIES: LOCATION OF EXISTING UTILITIES SHOWN ON THESE PLANS ARE PROVIDED BASED ON UTILITY LOCATION SERVICE FIELD MARKINGS WHICH WERE LOCATED BY THE SURVEYOR. CONTRACTOR TO CONFIRM DEPTH OF EXISTING UTILITIES AND NOTIFY ENGINEER IF ANY CONFLICTS ARE ANTICIPATED.
 - THE PAGES TITLED "GENERAL NOTES", AS LISTED ON THE COVER PAGE OF THIS SET OF CONSTRUCTION DOCUMENTS, SHALL APPLY TO ALL SHEETS HEREIN. THE GENERAL CONTRACTOR SHALL PROVIDE A COPY OF THE "GENERAL NOTES" SHEETS TO ALL BIDDERS AND SUBCONTRACTORS.
 - ALL DISTURBED AREAS TO BE SODDED AND RESTORED TO A CONDITION EQUAL TO OR BETTER THAN PRE-CONSTRUCTION CONDITION. WHEN RESTORING GRASS AREA WITHIN THE RIGHT OF WAY, USE ONLY MESH FREE ARGENTINE BAHIA SOD.
 - CONTRACTOR TO REFER/COORDINATE THE WORK SHOWN HEREIN WITH THE WORK SHOWN ON THE REMAINDER OF THESE CONSTRUCTION DOCUMENTS. IF ANY DISCREPANCIES BETWEEN THE WORK SHOWN ON THIS AND OTHER PAGES IS FOUND, OR IF THE CONTRACTOR HAS ANY QUESTIONS OF ANY KIND, CONTRACTOR SHALL NOTIFY ENGINEER IN WRITING PRIOR TO THE PERFORMANCE OF ANY WORK.
 - CONTRACTOR SHALL SHOOT SANITARY SEWER AND STORM WATER INFRASTRUCTURE AS-BUILT DATA AND SUBMIT TO ENGINEER OF RECORD FOR APPROVAL PRIOR TO ASPHALT PAVEMENT AND BASE COURSE INSTALLATION.
 - ALL PIPE BENDS ARE 45° UNLESS NOTED OTHERWISE.
 - DIRECTIONAL DRILLING SHALL MEET THE REQUIREMENTS OF SECTION 555 OF THE FDOT STANDARD SPECIFICATIONS. JACKING AND BORING SHALL MEET THE REQUIREMENTS OF SECTION 556 OF THE FDOT STANDARD SPECIFICATIONS.
 - ANY NEW HYDRANT INSTALLED SHALL BE FLOW TESTED AND PAINTED ACCORDING TO NFPA 291. FLOW TEST SHALL BE WITNESSED BY A FIRE INSPECTOR.
 - CAR WASH TO PROVIDE RECIRCULATION SYSTEMS AT 80% OR MORE REUSED.
 - CAR WASH TO INSTALL OIL AND SAND INTERCEPTOR IN ACCORDANCE WITH CITY CODE SEC 86-225(2).
 - IT IS THE RESPONSIBILITY OF THE CONTRACTOR TO ENSURE THERE ARE NO FDOT ITS INFRASTRUCTURE CONFLICTS, INCLUSIVE OF FIELD VERIFYING EXACT LOCATIONS. (ITS INFRASTRUCTURE MAY NOT BE INCLUDED IN 811) CONFLICTS THAT REQUIRE RELOCATION SHOULD BE COORDINATED WITH DANIEL SIMPSON - 321 257 7271 FOR APPROVAL.



GREASE TRAP CALCULATION:

S=NUMBER OF SEATS
GS=GALLONS WASTEWATER PER SEAT
HR=NUMBER OF HOURS OPEN
LP=LOADING FACTOR

$$(S)(GS)(HR)(12)(LP)=GALLONS$$

$$(6)(25)(2)(0.8)=240 GALLONS$$

750 GALLON (MIN) REQUIRED BY CODE




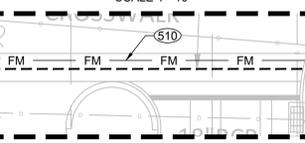
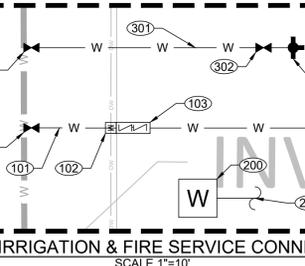


UTILITY PLAN KEYNOTES

- WATER SERVICE CONNECTION**
- CONNECT PROPOSED 2" PE WATER LINE TO EXISTING 12" WATER MAIN WITH 12" X 2" DOUBLE STRAP TAPPING SADDLE AND 2" CORPORATION STOP. *CONTRACTOR SHALL VERIFY THE LOCATION & DEPTH OF EXISTING WATER MAIN BEFORE START OF CONSTRUCTION. REPORT TO ENGINEER IF ANY CONFLICT EXISTS. DETAIL: UT109, UT110, UT111, UT112 / D3.1
 - ±10.0' LF OF 2" BLUE PE WATER SERVICE LINE DETAIL: UT102, UT103, UT104 / D3.1
 - 2" METER LOCATED IN RIGHT OF WAY
 - 2" RPZ ASSEMBLY, DETAIL: UT209 / D3.1
 - ±118.0' LF OF 2" BLUE PE WATER SERVICE LINE DETAIL: UT102, UT103, UT104 / D3.1
 - 2" X 2" TEE
 - ±38.0' LF OF 2" BLUE PE WATER SERVICE LINE DETAIL: UT102, UT103, UT104 / D3.1
 - CONNECT 2" WATER LINE TO STUB-OUT FROM CAR WASH. SEE ARCHITECTURAL PLANS
 - ±32.8' LF OF 2" BLUE PE WATER SERVICE LINE DETAIL: UT102, UT103, UT104 / D3.1
 - 2" X 2" TEE WITH 2" X 1/2" REDUCER
 - ±161.9' LF OF 2" BLUE PE WATER SERVICE LINE DETAIL: UT102, UT103, UT104 / D3.1
 - CONNECT WATER LINE TO STUB-OUT LOCATION FROM STORE. CONTRACTOR SHALL COORDINATE CONNECTION WITH ARCHITECTURAL PLANS FOR LOCATION AND DEPTH OF PROPOSED CONNECTION. REPORT TO ENGINEER IF ANY CONFLICT EXISTS.
 - ±106.0' LF OF 1/2" BLUE PE WATER SERVICE LINE DETAIL: UT102, UT103, UT104 / D3.1
 - 1/2" HOSE BIB, SEE ARCHITECTURAL PLANS
- IRRIGATION CONNECTION**
- IRRIGATION WELL BY OTHERS
 - SEE SHEET C7.1 FOR REMAINING IRRIGATION SYSTEM
- FIRE SERVICE CONNECTIONS**
- CONNECT PROPOSED 6" FIRE SERVICE LINE TO EXISTING 12" WATER MAIN WITH 12" X 6" DOUBLE STRAP TAPPING SADDLE AND 6" CORPORATION STOP. *CONTRACTOR SHALL VERIFY THE LOCATION & DEPTH OF EXISTING WATER MAIN BEFORE START OF CONSTRUCTION. REPORT TO ENGINEER IF ANY CONFLICT EXISTS. DETAIL: UT109, UT110, UT111, UT112 / D3.1; UT210 / D3.2
 - ±33.0 LF OF 6" C900 PVC WITH FITTINGS AND RESTRAINTS DETAIL: UT116A, UT116B / D3.0; UT102, UT103, UT104 / D3.1; UT 201 / D3.2
 - 6" GATE VALVE DETAIL: UT110, UT111, UT112 / D3.1; UT210, CB200 / D3.2
 - PROPOSED FIRE HYDRANT DETAIL: UT210 / D3.1
- SANITARY SEWER**
- CONNECT TO STUB OUT AT BUILDING WITH 6" TWO-WAY CLEANOUT AND 45° ELBOW, INV. = 69.48' DETAIL: 3 / D3.0 & ARCHITECTURAL PLANS
 - ±33.0 LF OF 6" PVC SANITARY SEWER PIPE SLOPED AT 1.0% DETAIL: UT102, UT103, UT104 / D3.1
 - CONNECT TO STUB OUT AT BUILDING WITH 4" TWO-WAY CLEANOUT AND 45° ELBOW, INV. = 69.61' DETAIL: 3 / D3.0 & ARCHITECTURAL PLANS
 - ±17.0 LF OF 4" PVC SANITARY SEWER PIPE SLOPED AT 1.0% DETAIL: UT102, UT103, UT104 / D3.1
 - 750 GALLON GREASE TRAP INFLUENT INV. = 69.44'; EFFLUENT INV. = 69.23' DETAIL: 4 / D3.0, UT310 / D3.2
 - 4" X 6" ECCENTRIC REDUCER
 - ±7.1 LF OF 6" PVC SANITARY SEWER PIPE SLOPED AT 1.0% DETAIL: UT102, UT103, UT104 / D3.1
 - 6" X 6" WYE
 - ±8.9 LF OF 6" PVC SANITARY SEWER PIPE SLOPED AT 1.0% DETAIL: UT102, UT103, UT104 / D3.1
 - 6" DROP CLEANOUT HIGH INV. = 69.08', LOW INV. = 66.87', DETAIL: 2 / D3.0
 - ±22.8 LF OF 6" PVC SANITARY SEWER PIPE SLOPED AT 1.0% DETAIL: UT102, UT103, UT104 / D3.1
 - 6" CLEANOUT, INV. = 66.64', DETAIL: 1 / D3.0
 - ±64.4 LF OF 6" PVC SANITARY SEWER PIPE SLOPED AT 1.0% DETAIL: UT102, UT103, UT104 / D3.1
 - CONNECT TO UNDERGROUND CAR WASH SYSTEM SANITARY STUB-OUT DETAIL: 5 / D3.0 & ARCHITECTURAL PLANS
 - ±16.3 LF OF 6" PVC SANITARY SEWER PIPE SLOPED AT 1.0% DETAIL: UT102, UT103, UT104 / D3.1
 - 6" CLEANOUT, INV. = 68.18', DETAIL: 1 / D3.0
 - ±77.5 LF OF 6" PVC SANITARY SEWER PIPE SLOPED AT 1.0% DETAIL: UT102, UT103, UT104 / D3.1
 - 6" CLEANOUT, INV. = 67.40', DETAIL: 1 / D3.0
 - ±77.5 LF OF 6" PVC SANITARY SEWER PIPE SLOPED AT 1.0% DETAIL: UT102, UT103, UT104 / D3.1

UTILITY PLAN KEYNOTES

- 6" CLEANOUT, INV. = 66.63' DETAIL: 1 / D3.0
 - ±44.5 LF OF 6" PVC SANITARY SEWER PIPE SLOPED AT 1.0% DETAIL: UT102, UT103, UT104 / D3.1
 - 6" CLEANOUT, INV. = 66.21' DETAIL: 1 / D3.0
 - ±20.7 LF OF 6" PVC SANITARY SEWER PIPE SLOPED AT 1.0% DETAIL: UT102, UT103, UT104 / D3.1
 - 6" X 6" WYE
 - ±31.8 LF OF 6" PVC SANITARY SEWER PIPE SLOPED AT 1.0% DETAIL: UT102, UT103, UT104 / D3.1
 - PRIVATE LIFT STATION, TOP OF WET WELL = 76.50', INV. = 65.68' DETAIL: D3.3
- FORCEMAIN**
- ±13.7 LF OF 2" C-900 PVC PRIVATE FORCE MAIN DETAIL: UT102, UT103, UT104 / D3.1
 - 2" PLUG VALVE AT PROPERTY LINE, DETAIL: UT304 / D3.2
 - ±9.0 LF OF 2" C-900 PVC PUBLIC FORCE MAIN DETAIL: UT102, UT103, UT104 / D3.1
 - 503 FORCE MAIN CONNECTION: CONNECT TO PROPOSED 12" PUBLIC SANITARY SEWER FORCE MAIN EXTENSION WITH 12" X 2" DOUBLE STRAP TAPPING SADDLE. CONTRACTOR SHALL COORDINATE WITH AHJ FOR LOCATION AND DEPTH OF CONNECTION BEFORE START OF CONSTRUCTION. REPORT TO ENGINEER IF ANY CONFLICT EXISTS.
 - ±48.6 LF OF 12" C-900 PVC PUBLIC FORCE MAIN DETAIL: UT102, UT103, UT104, UT109 / D3.1
 - 12" PLUG VALVE, DETAIL: UT110, UT111, UT112 / D3.1; UT304 / D3.2
 - 12" CAP
 - ±237.3 LF OF 12" C-900 PVC PUBLIC FORCE MAIN DETAIL: UT102, UT103, UT104 / D3.1
 - 12" PLUG VALVE, DETAIL: UT304 / D3.2
 - 508 5' X 8' DIRECTIONAL BORE PIT
 - 510 DIRECTIONAL DRILL ±208.6' UNDER ROADWAY TO INSTALL ±208.6 LF OF 14" DR11 HDPE FORCE MAIN PIPE WITH 20" REAMER DETAIL: PROFILE FM-FM / D3.0
 - 5' X 8' DIRECTIONAL BORE PIT
 - 12" PLUG VALVE, DETAIL: UT304 / D3.2
 - ±8.0 LF OF 12" C-900 PVC PUBLIC FORCE MAIN DETAIL: UT102, UT103, UT104 / D3.1
 - 12" X 6" TEE
 - CONTRACTOR SHALL COORDINATE WITH AHJ FOR LOCATION, DEPTH, AND METHOD OF CONNECTION BEFORE START OF CONSTRUCTION. REPORT TO ENGINEER IF ANY CONFLICT EXISTS.
 - 12" PLUG VALVE, DETAIL: UT304 / D3.2
 - 12" CAP
 - ±10.3 LF OF 6" C-900 PVC PUBLIC FORCE MAIN CONTRACTOR SHALL COORDINATE WITH AHJ FOR LOCATION, DEPTH, AND METHOD OF CONNECTION BEFORE START OF CONSTRUCTION. REPORT TO ENGINEER IF ANY CONFLICT EXISTS.
 - ±55.0 LF OF 24" C-900 PVC SLEEVE UNDER DRIVEWAY FOR FUTURE PUBLIC FORCE MAIN SLOPED AT 1.0% DETAIL: UT102, UT103, UT104 / D3.1
 - 24" CAP, INV. = 75.45'
- ELECTRIC AND COMMUNICATIONS**
- COORDINATE ELECTRIC AND TELEPHONE SERVICE CONNECTION WITH APPROPRIATE SERVICE PROVIDERS. REFER TO ARCHITECTURAL DRAWINGS FOR SPECIFIC CONNECTION LOCATIONS AND REQUIREMENTS.
- PROPOSED APPROXIMATE ELECTRIC, TELEPHONE, AND DATA SERVICE CONNECTION POINT. CONTRACTOR TO VERIFY LOCATION OF ELECTRIC SERVICE CONNECTION BEFORE CONSTRUCTION.
 - ±318.3 LF OF 0" OF UNDERGROUND ELECTRICAL SERVICE LINE FROM SERVICE CONNECTION POINT TO GROUND MOUNTED TRANSFORMER
 - ±297.9 LF OF 0" OF UNDERGROUND TELEPHONE AND DATA SERVICE LINE FROM PROPERTY LINE TO BUILDING CONNECTION
 - GROUND MOUNTED TRANSFORMER
 - ±43.7 LF OF 0" OF UNDERGROUND ELECTRICAL SERVICE LINE FROM GROUND MOUNTED TRANSFORMER TO BUILDING CONNECTION
 - APPROXIMATE ELECTRICAL CONNECTION TO BUILDING, SEE ARCHITECTURAL PLANS.
 - APPROXIMATE TELEPHONE CONNECTION TO BUILDING, SEE ARCHITECTURAL PLANS.
- GAS**
- PROPOSED APPROXIMATE GAS SERVICE CONNECTION POINTS TO EXISTING GAS LINE. CONTRACTOR TO FIELD VERIFY AND COORDINATE LOCATION GAS SERVICE CONNECTION POINTS BEFORE CONSTRUCTION.
 - ±257.9 LF OF 2" DR 11 HDPE GAS LINE, DETAIL: UT102, UT103, UT104 / D3.1
 - APPROXIMATE GAS SERVICE CONNECTION TO BUILDING. CONTRACTOR SHALL COORDINATE CONNECTION WITH ARCHITECTURAL PLANS FOR LOCATION AND DEPTH OF PROPOSED CONNECTION. REPORT TO ENGINEER IF ANY CONFLICT EXISTS.

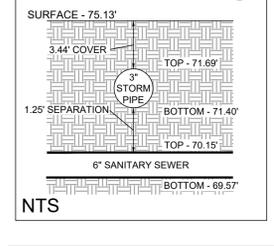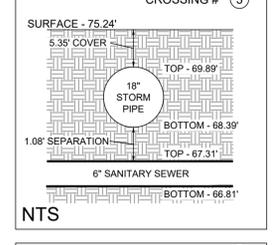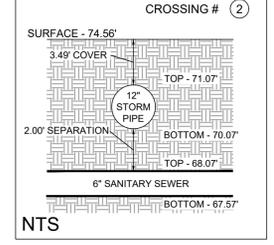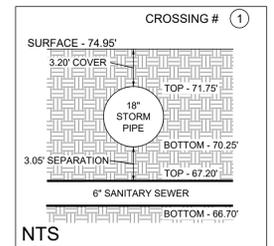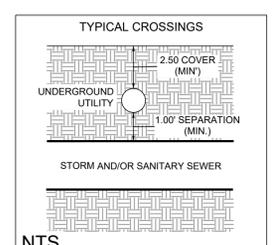

BURIED UTILITIES NOTE

BURIED UTILITIES ARE SHOWN AT THEIR APPROXIMATE LOCATION BASED UPON INFORMATION OBTAINED FROM UTILITY COMPANIES AND FIELD EVIDENCE. OTHER BURIED UTILITIES MAY EXIST ON THE SUBJECT SITE WHICH ARE NOT SHOWN ON THIS DRAWING. USE EXTREME CAUTION DURING EXCAVATION PROCEDURES AND CONTACT SINGING STATE ONE AT 1-800-432-4770 FOR EXACT LOCATION OF BURIED FACILITIES PRIOR TO EXCAVATION OPERATIONS.



7-11 BELLEVUE NEEDED FIRE FLOW CALCULATIONS

BUILDING	BUILDING TYPE	BUILDING SQUARE FOOTAGE	NEEDED FLOW (GPM)*	FLOW DURATION (HOURS)	SPRINKLER PROTECTION	NEEDED FIRE FLOW AFTER 70% REDUCTION FOR SPRINKLER (GPM)	NEEDED FIRE FLOW (GPM)
BUILDING	VB	4,853	2,000	2	NO	N/A	2,000

*REQUIRED FIRE FLOW VALUES TAKEN FROM NFPA TABLE 18.4.4.2.1

Jeremy R. Anderson, State of Florida, Professional Engineer, License No. 71636

This item has been digitally signed and sealed by Jeremy R. Anderson, PE, on the date indicated here.

Printed copies of this document are not considered signed and sealed and the signature must be verified on any electronic copies.

R.K.M. DEVELOPMENT CORP.

COMMON OAK ENGINEERING
ORLANDO, FL 32804
(407) 951-5915
CERTIFICATE OF AUTHORIZATION: 32844

MAJOR SITE PLAN
7-ELEVEN
AT SEC OF SE 92ND LP
&
SE 92ND AVE
BELLEVUE, FL
MARION COUNTY

NO.	DATE	REVISION / ISSUE	BY: (JR)	FOR: (JR)
1	12/05/2024	PLOT ACCESS COMMENTS	JR	JR
2	12/10/2024	MARION COUNTY COMMENTS	JR	JR
3	12/10/2024	MARION COUNTY COMMENTS	JR	JR
4	12/26/2024	MARION COUNTY COMMENTS	JR	JR
5	03/13/2024	CITY OF BELLEVUE UTILITY COMMENTS	JR	JR
6	03/13/2024	CITY OF BELLEVUE UTILITY COMMENTS	JR	JR
7	03/13/2024	CITY OF BELLEVUE UTILITY COMMENTS	JR	JR
8	04/16/2024	CLIENT COMMENTS	JR	JR
9	04/16/2024	CLIENT COMMENTS	JR	JR
10	05/09/2024	CLIENT COMMENTS	JR	JR
11	05/09/2024	CLIENT COMMENTS	JR	JR
12	05/09/2024	CLIENT COMMENTS	JR	JR
13	05/09/2024	CLIENT COMMENTS	JR	JR
14	05/09/2024	CLIENT COMMENTS	JR	JR
15	05/09/2024	CLIENT COMMENTS	JR	JR

ENGINEER'S NAME & PE#
JEREMY R. ANDERSON, P.E.
P.E. LICENSE NO. 71636


PROJECT # **222.108**

DATE **05/13/2024**

SHEET **C6.0**

SCALE **1" = 30'**


UTILITY PLAN

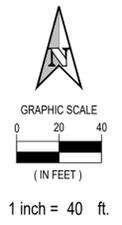

1 inch = 40 ft.

BURIED UTILITIES NOTE
 BURIED UTILITIES ARE SHOWN AT THEIR APPROXIMATE LOCATION BASED UPON INFORMATION OBTAINED FROM UTILITY COMPANIES AND FIELD EVIDENCE. OTHER BURIED UTILITIES MIGHT EXIST ON THE SUBJECT SITE WHICH ARE NOT SHOWN ON THIS DRAWING. USE EXTREME CAUTION DURING EXCAVATION PROCEDURES AND CONTACT FLORIDA STATE ONE AT 1-800-432-4770 FOR EXACT LOCATION OF BURIED FACILITIES PRIOR TO EXCAVATION OPERATIONS.

CALL BEFORE YOU DIG...
 1-800-432-4770
 UTILITIES PROTECTION CENTER
 IT'S THE LAW


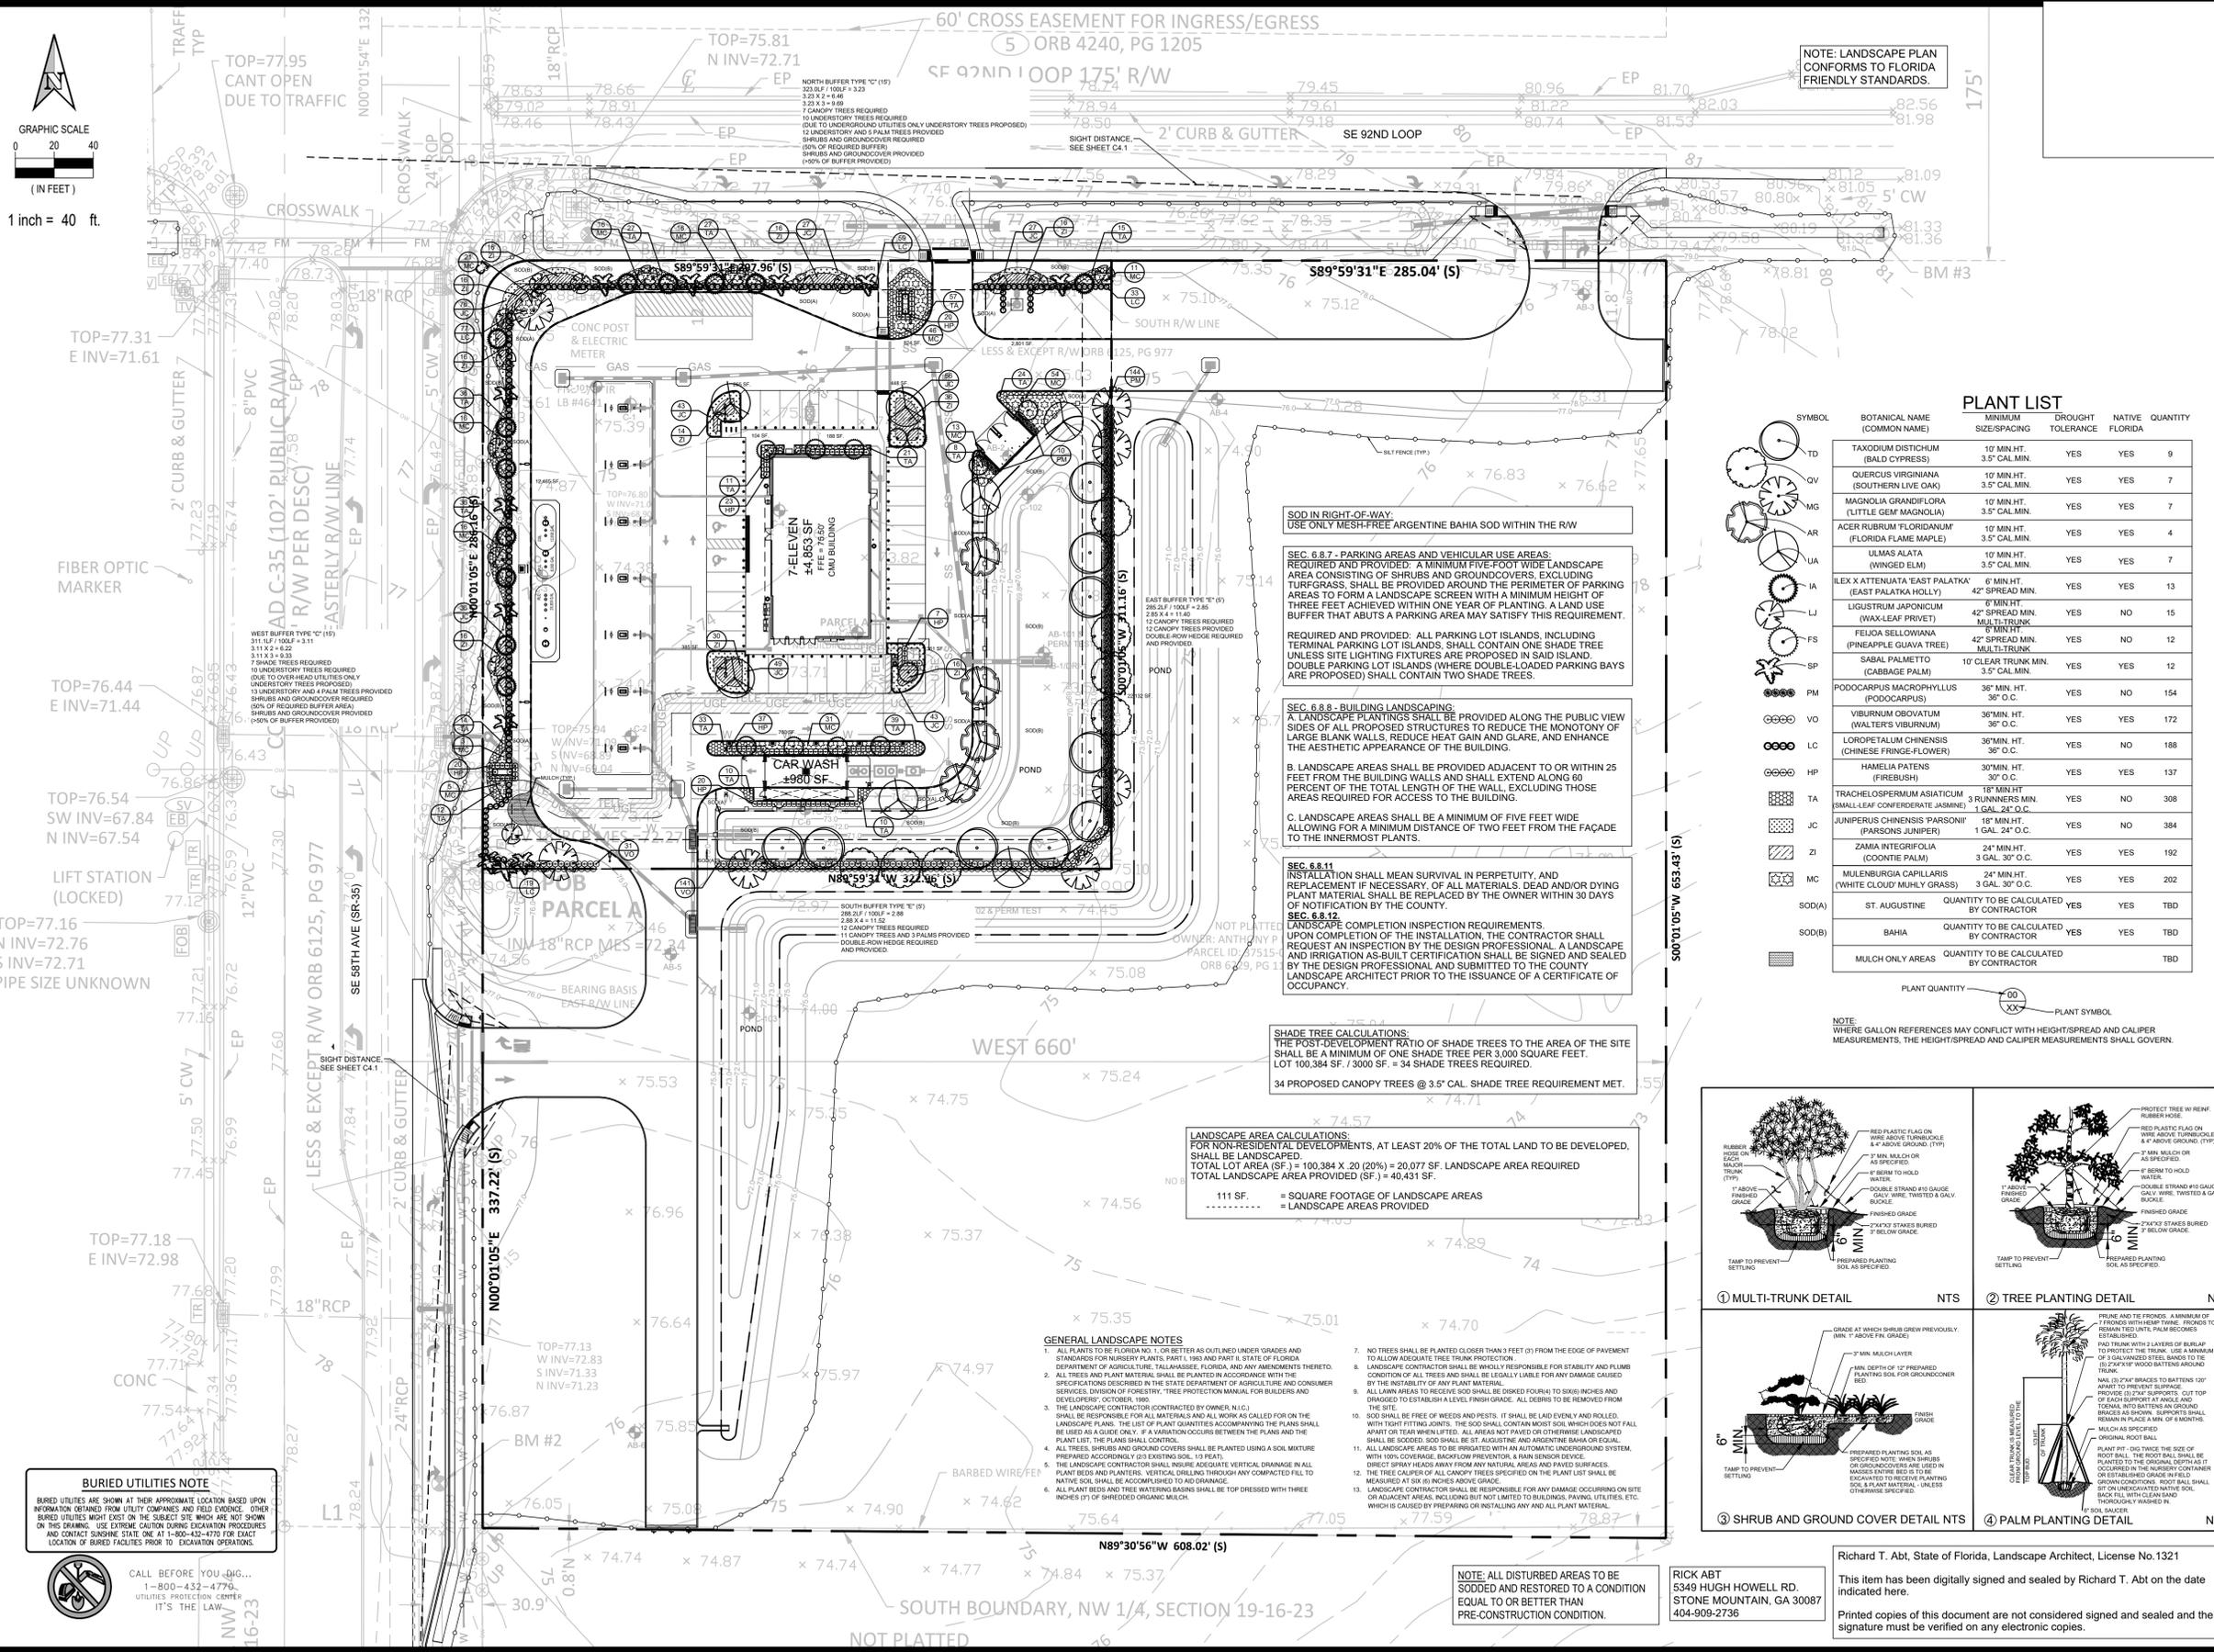


NOTE: LANDSCAPE PLAN CONFORMS TO FLORIDA FRIENDLY STANDARDS.

PLANT LIST

SYMBOL	BOTANICAL NAME (COMMON NAME)	MINIMUM SIZESPACING	DROUGHT TOLERANCE	NATIVE FLORIDA	QUANTITY
TD	TAXODIUM DISTICHUM (BALD CYPRESS)	10' MIN. HT. 3.5" CAL. MIN.	YES	YES	9
QV	QUERCUS VIRGINIANA (SOUTHERN LIVE OAK)	10' MIN. HT. 3.5" CAL. MIN.	YES	YES	7
MG	MAGNOLIA GRANDIFLORA (LITTLE LEM MAGNOLIA)	10' MIN. HT. 3.5" CAL. MIN.	YES	YES	4
AR	ACER RUBRUM FLORIDANUM (FLORIDA FLAME MAPLE)	10' MIN. HT. 3.5" CAL. MIN.	YES	YES	7
UA	ULMAS ALATA (WINGED ELM)	10' MIN. HT. 3.5" CAL. MIN.	YES	YES	7
IA	ILEX X ATTENUATA 'EAST PALATKA' (EAST PALATKA HOLLY)	6' MIN. HT. 42" SPREAD MIN.	YES	YES	13
LJ	LIGUSTRUM JAPONICUM (WAX-LEAF PRIVET)	42" SPREAD MIN. MULTITRUNK	YES	NO	15
FS	FELDOA SELLOWIANA (PINEAPPLE GUAVA TREE)	6' MIN. HT. 42" SPREAD MIN. MULTITRUNK	YES	NO	12
SP	SABAL PALMETTO (CABBAGE PALM)	10' CLEAR TRUNK MIN. 3.5" CAL. MIN.	YES	YES	12
PM	PODOCARPUS MACROPHYLLUS (PODOCARPUS)	36" MIN. HT. 36" O.C.	YES	NO	154
VO	VIBURNUM OBOVATUM (WALTERS VIBURNUM)	36" MIN. HT. 36" O.C.	YES	YES	172
LC	LOKOPETALUM CHINENSIS (CHINESE FRINGE-FLOWER)	36" MIN. HT. 36" O.C.	YES	NO	188
HP	HAMELIA PATENS (FIREBUSH)	30" MIN. HT. 36" O.C.	YES	YES	137
TA	TRACHELOSPERMUM ASIATICUM (SMALL-LEAF CONFEDERATE JASMINE)	18" MIN. HT. 3 RUNNERS MIN. 1 GAL. 24" O.C.	YES	NO	308
ZJ	JUNIPERUS CHINENSIS 'PARSONI' (PARSONS JUNIPER)	18" MIN. HT. 1 GAL. 24" O.C.	YES	NO	384
JC	ZAMA INTEGRIFOLIA (COONTIE PALM)	24" MIN. HT. 3 GAL. 36" O.C.	YES	YES	192
MC	MULEBURGIA CAPILLARIS (WHITE CLOUD MUHLY GRASS)	24" MIN. HT. 3 GAL. 36" O.C.	YES	YES	202
SOD(A)	ST. AUGUSTINE	QUANTITY TO BE CALCULATED BY CONTRACTOR	YES	YES	TBD
SOD(B)	BAHIA	QUANTITY TO BE CALCULATED BY CONTRACTOR	YES	YES	TBD
	MULCH ONLY AREAS	QUANTITY TO BE CALCULATED BY CONTRACTOR			TBD

PLANT QUANTITY: 00 PLANT SYMBOL
 NOTE: WHERE GALLON REFERENCES MAY CONFLICT WITH HEIGHT/SPREAD AND CALIPER MEASUREMENTS, THE HEIGHT/SPREAD AND CALIPER MEASUREMENTS SHALL GOVERN.

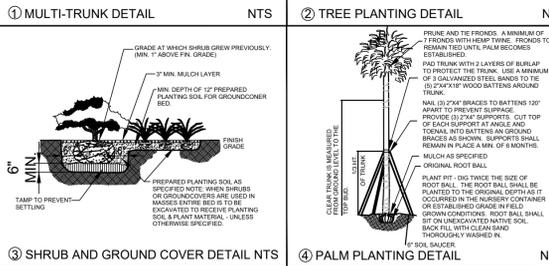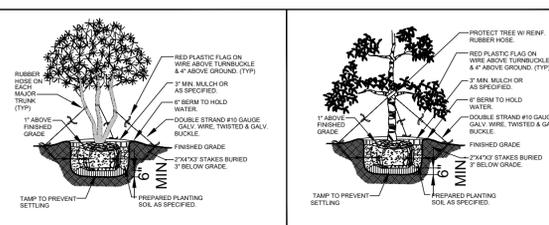

SOD IN RIGHT-OF-WAY:
 USE ONLY MESH-FREE ARGENTINE BAHIA SOD WITHIN THE R/W

SEC. 6.8.7 - PARKING AREAS AND VEHICULAR USE AREAS:
 REQUIRED AND PROVIDED: A MINIMUM FIVE-FOOT WIDE LANDSCAPE AREA CONSISTING OF SHRUBS AND GROUNDCOVERS, EXCLUDING TURFGRASS, SHALL BE PROVIDED AROUND THE PERIMETER OF PARKING AREAS TO FORM A LANDSCAPE SCREEN WITH A MINIMUM HEIGHT OF THREE FEET ACHIEVED WITHIN ONE YEAR OF PLANTING. A LAND USE BUFFER THAT ABUTS A PARKING AREA MAY SATISFY THIS REQUIREMENT.
 REQUIRED AND PROVIDED: ALL PARKING LOT ISLANDS, INCLUDING TERMINAL PARKING LOT ISLANDS, SHALL CONTAIN ONE SHADE TREE UNLESS SITE LIGHTING FIXTURES ARE PROPOSED IN SAID ISLAND. DOUBLE PARKING LOT ISLANDS (WHERE DOUBLE-LOADED PARKING BAYS ARE PROPOSED) SHALL CONTAIN TWO SHADE TREES.

SEC. 6.8.8 - BUILDING LANDSCAPING:
 A. LANDSCAPE PLANTINGS SHALL BE PROVIDED ALONG THE PUBLIC VIEW SIDES OF ALL PROPOSED STRUCTURES TO REDUCE THE MONOTONY OF LARGE BLANK WALLS, REDUCE HEAT GAIN AND CLARE, AND ENHANCE THE AESTHETIC APPEARANCE OF THE BUILDING.
 B. LANDSCAPE AREAS SHALL BE PROVIDED ADJACENT TO OR WITHIN 25 FEET FROM THE BUILDING WALLS AND SHALL EXTEND ALONG 60 PERCENT OF THE TOTAL LENGTH OF THE WALL, EXCLUDING THOSE AREAS REQUIRED FOR ACCESS TO THE BUILDING.
 C. LANDSCAPE AREAS SHALL BE A MINIMUM OF FIVE FEET WIDE ALLOWING FOR A MINIMUM DISTANCE OF TWO FEET FROM THE FAÇADE TO THE INNERMOST PLANTS.

SEC. 6.8.11
 INSTALLATION SHALL MEAN SURVIVAL IN PERPETUITY, AND REPLACEMENT IF NECESSARY. OF ALL MATERIALS, DEAD AND/OR DYING PLANT MATERIAL SHALL BE REPLACED BY THE OWNER WITHIN 30 DAYS OF NOTIFICATION BY THE COUNTY.
SEC. 6.8.12
 LANDSCAPE COMPLETION INSPECTION REQUIREMENTS. UPON COMPLETION OF THE INSTALLATION, THE CONTRACTOR SHALL REQUEST AN INSPECTION BY THE DESIGN PROFESSIONAL. A LANDSCAPE AND IRRIGATION AS-BUILT CERTIFICATE SHALL BE SIGNED AND SEALED BY THE DESIGN PROFESSIONAL AND SUBMITTED TO THE COUNTY LANDSCAPE ARCHITECT PRIOR TO THE ISSUANCE OF A CERTIFICATE OF OCCUPANCY.

SHADE TREE CALCULATIONS:
 THE POST-DEVELOPMENT RATIO OF SHADE TREES TO THE AREA OF THE SITE SHALL BE A MINIMUM OF ONE SHADE TREE PER 3,000 SQUARE FEET. LOT 100.384 SF / 3000 SF. = 34 SHADE TREES REQUIRED.
 34 PROPOSED CANOPY TREES @ 3.5" CAL. SHADE TREE REQUIREMENT MET.

LANDSCAPE AREA CALCULATIONS:
 FOR NON-RESIDENTIAL DEVELOPMENTS, AT LEAST 20% OF THE TOTAL LAND TO BE DEVELOPED, SHALL BE LANDSCAPED.
 TOTAL LOT AREA (SF) = 100,384 X .20 (20%) = 20,077 SF. LANDSCAPE AREA REQUIRED TOTAL LANDSCAPE AREA PROVIDED (SF) = 40,451 SF.
 111 SF. = SQUARE FOOTAGE OF LANDSCAPE AREAS
 = LANDSCAPE AREAS PROVIDED

- GENERAL LANDSCAPE NOTES**
- ALL PLANTS TO BE FLORIDA NO. 1, OR BETTER AS OUTLINED UNDER GRADES AND STANDARDS FOR NURSERY PLANTS, PART 199 AND PART 8, STATE OF FLORIDA DEPARTMENT OF AGRICULTURE, TALLAHASSEE, FLORIDA, AND ANY AMENDMENTS THERETO.
 - ALL TREES AND PLANT MATERIAL SHALL BE PLANTED IN ACCORDANCE WITH THE SPECIFICATIONS DESCRIBED IN THE STATE DEPARTMENT OF AGRICULTURE AND CONSUMER SERVICES, DIVISION OF FORESTRY, "TREE PROTECTION MANUAL FOR BUILDERS AND DEVELOPERS," OCTOBER, 1985.
 - THE LANDSCAPE CONTRACTOR (CONTRACTED BY OWNER, N.C.) SHALL BE RESPONSIBLE FOR ALL MATERIALS AND ALL WORK AS CALLED FOR ON THE LANDSCAPE PLANS. THE SET OF PLANT QUANTITIES ACCOMPANYING THE PLANS SHALL BE USED AS A GUIDE ONLY. IF A VARIATION OCCURS BETWEEN THE PLANS AND THE PLANT LIST, THE PLANS SHALL CONTROL.
 - ALL TREES, SHRUBS AND GROUND COVERS SHALL BE PLANTED USING A SOIL MIXTURE PREPARED ACCORDING TO EXISTING SOIL TO PLANT.
 - THE LANDSCAPE CONTRACTOR SHALL INSURE ADEQUATE VERTICAL DRAINAGE IN ALL PLANT BEDS AND PLANTERS. VERTICAL DRAINAGE THROUGH ANY COMPACTED FILL TO NATIVE SOIL SHALL BE ACCOMPLISHED TO AID DRAINAGE.
 - ALL PLANT BEDS AND TREE WATERING BASINS SHALL BE TOP DRESSED WITH THREE INCHES (3") OF BLENDED ORGANIC MULCH.
 - NO TREES SHALL BE PLANTED CLOSER THAN 3 FEET (3') FROM THE EDGE OF PAVEMENT TO ALLOW ADEQUATE TREE TRUNK PROTECTION.
 - LANDSCAPE CONTRACTOR SHALL BE FULLY RESPONSIBLE FOR STABILITY AND PLUMB CONDITION OF ALL TREES AND SHALL BE LEGALLY LIABLE FOR ANY DAMAGE CAUSED BY THE INSTABILITY OF ANY PLANT MATERIAL.
 - ALL LAWN AREAS TO RECEIVE SOOD SHALL BE DISKED FOUR (4) TO SIX (6) INCHES AND DRAGGED TO ESTABLISH A LEVEL FINISH GRADE. ALL DEBRIS TO BE REMOVED FROM THE SITE.
 - SOOD SHALL BE FREE OF WEEDS AND PESTS. IT SHALL BE LAID EVENLY AND ROLLED, WITH TIGHT FITTING JOINTS. THE SOOD SHALL CONTAIN MOST SOIL WHICH DOES NOT FALL APART OR TEAR WHEN LIFTED. ALL AREAS NOT PAVED OR OTHERWISE LANDSCAPED SHALL BE SOODED. SOOD SHALL BE ST. AUGUSTINE AND ARGENTINE BAHIA OR EQUAL.
 - ALL LANDSCAPE AREAS TO BE SPRIGGATED WITH AN AUTOMATIC UNDERDRAINAGE SYSTEM, WITH 100% COVERABLE BACKFLOW PREVENTION, & MAIN SENSOR DEVICE.
 - DIRECT SPRAY HEADS AWAY FROM ANY NATURAL AREAS AND PAVED SURFACES.
 - THE TREE CALIPER OF ALL CANOPY TREES SPECIFIED ON THE PLANT LIST SHALL BE MEASURED AT SIX (6) INCHES ABOVE GRADE.
 - LANDSCAPE CONTRACTOR SHALL BE RESPONSIBLE FOR ANY DAMAGE OCCURRING ON SITE OR ADJACENT AREAS INCLUDING BUT NOT LIMITED TO BUILDINGS, PAVEMENT, UTILITIES, ETC. WHICH IS CAUSED BY PREPARING OR INSTALLING ANY AND ALL PLANT MATERIAL.

NOTE: ALL DISTURBED AREAS TO BE SOODED AND RESTORED TO A CONDITION EQUAL TO OR BETTER THAN PRE-CONSTRUCTION CONDITION.

Richard T. Abt, State of Florida, Landscape Architect, License No. 1321
 5349 HUGH HOWELL RD.
 STONE MOUNTAIN, GA 30087
 404-909-2736

This item has been digitally signed and sealed by Richard T. Abt on the date indicated here.
 Printed copies of this document are not considered signed and sealed and the signature must be verified on any electronic copies.

R.K.M. DEVELOPMENT CORP.



COMMON OAK ENGINEERING
 4016 EDGEWATER DRIVE
 ORLANDO, FL 32804
 (407) 951-5915
 CERTIFICATE OF AUTHORIZATION: 32644

MAJOR SITE PLAN
 7-ELEVEN
 AT SEC OF SE 92ND LP
 SE 58TH AVE
 BELLEVUE, FL
 MARION COUNTY

NO.	DATE	REVISION / ISSUE	MARION COUNTY COMMENTS	CLIENT COMMENTS
1	12/15/2024	ISSUE		
2	01/07/2025	REVISION		
3	03/13/2024	REVISION		



ENGINEER'S NAME & PE#
 PROJECT # 222.108
 DATE 05/13/2024
 SHEET C7.0
 SCALE 1" = 40'
 OVERALL LANDSCAPE PLAN



COMMON OAK ENGINEERING
4016 EDGEWATER DRIVE
ORLANDO, FL 32804
(407) 951-5915
CERTIFICATE OF AUTHORIZATION: 32644

MAJOR SITE PLAN
7-ELEVEN
AT SEC OF SE 92ND LP
&
SE 58TH AVE
BELLEVUE, FL
MARION COUNTY

NO.	DATE	REVISION / ISSUE	BY
1	12/15/2024	MARION COUNTY COMMENTS	JR
2	01/07/2025	MARION COUNTY COMMENTS	JR
3	03/13/2024	CLIENT COMMENTS	CS
4			
5			

ENGINEER'S NAME & PE#

PROJECT # 222.108

DATE 05/13/2024
 SCALE 1" = 30'

SHEET C7.1
 LANDSCAPE PLAN

PLANT KEY

SYMBOL	BOTANICAL NAME (COMMON NAME)	MINIMUM SIZE/SPACING	DROUGHT TOLERANCE	NATIVE FLORIDA
TD	TAXODIUM DISTICHUM (BALD CYPRESS)	10' MIN. HT. 3.5" CAL. MIN.	YES	YES
QV	QUERUS VIRGINIANA (SOUTHERN LIVE OAK)	10' MIN. HT. 3.5" CAL. MIN.	YES	YES
MG	MAGNOLIA GRANDIFLORA (LITTLE LEAF MAGNOLIA)	10' MIN. HT. 3.5" CAL. MIN.	YES	YES
AR	ACER RUBRUM FLORIDANUM (FLORIDA FLAME MAPLE)	10' MIN. HT. 3.5" CAL. MIN.	YES	YES
IA	ILIAS ALATA (WINGED ELM)	10' MIN. HT. 3.5" CAL. MIN.	YES	YES
IA	ILEX XANTHOPHYLLA (EAST PALATKA HOLLY)	6" MIN. HT. 42" SPREAD MIN.	YES	YES
U	LIGUSTRUM JAPONICUM (WAX LEAF PRIVET)	10' MIN. HT. 3" CAL. MIN.	YES	NO
FS	FELDA BELLIFLORA (PINEAPPLE GUAVA TREE)	42" SPREAD MIN. MULTI TRUNK	YES	NO
SP	SABAL PALMETTO (CABBAGE PALM)	10' CLEAR TRUNK MIN. 3.5" CAL. MIN.	YES	YES
PM	PODOCARPUS MACROPHYLLUS (PODOCARPUS)	36" MIN. HT. 30" O.C.	YES	NO
VO	VIBURNUM OBOVATUM (WALTER'S VIBURNUM)	36" MIN. HT. 30" O.C.	YES	YES
LC	LOROPETALUM CHINENSIS (CHINESE FRINGE FLOWER)	36" MIN. HT. 30" O.C.	YES	NO
HP	HAMELIA PATENS (FIREBUSH)	30" MIN. HT. 30" O.C.	YES	YES
TA	TRACHELOSPERMUM ASIATICUM (SMALL LEAF CONFESSIONAL AGAVE)	18" MIN. HT. 3 RUNNERS MIN. 1 GAL. 2E O.C.	YES	NO
JC	JUNIPERUS CHINENSIS PARSONII (PARSONS JUNIPER)	18" MIN. HT. 1 GAL. 24" O.C.	YES	NO
ZI	ZAMIA INTERSECTA (COGATE PALM)	24" MIN. HT. 3 GAL. 30" O.C.	YES	YES
MC	MILEMBURGIA CAPILLARIS (WHITE CLOUD MUHLY GRASS)	24" MIN. HT. 3 GAL. 30" O.C.	YES	YES
S00(A)	ST. AUGUSTINE	QUANTITY TO BE CALCULATED BY CONTRACTOR	YES	YES
S00(B)	BAHA	QUANTITY TO BE CALCULATED BY CONTRACTOR	YES	YES

NOTE: WHERE GALLON REFERENCES MAY CONFLICT WITH HEIGHT/SPREAD AND CALIPER MEASUREMENTS, THE HEIGHT/SPREAD AND CALIPER MEASUREMENTS SHALL GOVERN.

BURIED UTILITIES NOTE
 BURIED UTILITIES ARE SHOWN AT THEIR APPROXIMATE LOCATION BASED UPON INFORMATION OBTAINED FROM UTILITY COMPANIES AND FIELD EVIDENCE. OTHER BURIED UTILITIES MAY EXIST ON THE SUBJECT SITE WHICH ARE NOT SHOWN ON THIS DRAWING. USE EXTREME CAUTION DURING EXCAVATION PROCEDURES AND CONTACT SANSHE, STATE ONE AT 1-800-432-4770 FOR EXACT LOCATION OF BURIED FACILITIES PRIOR TO EXCAVATION OPERATIONS.

CALL BEFORE YOU DIG... IT'S THE LAW
 1-800-432-4770
 UTILITIES PROTECTION CENTER



NOTE: ALL DISTURBED AREAS TO BE SODDED AND RESTORED TO A CONDITION EQUAL TO OR BETTER THAN PRE-CONSTRUCTION CONDITION.

NOTE: LANDSCAPE PLAN CONFORMS TO FLORIDA FRIENDLY STANDARDS.

RICK ABT
 5349 HUGH HOWELL RD.
 STONE MOUNTAIN, GA 30087
 404-909-2736

Richard T. Abt, State of Florida, Landscape Architect, License No. 1321
 This item has been digitally signed and sealed by Richard T. Abt on the date indicated here.

Printed copies of this document are not considered signed and sealed and the signature must be verified on any electronic copies.

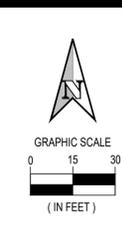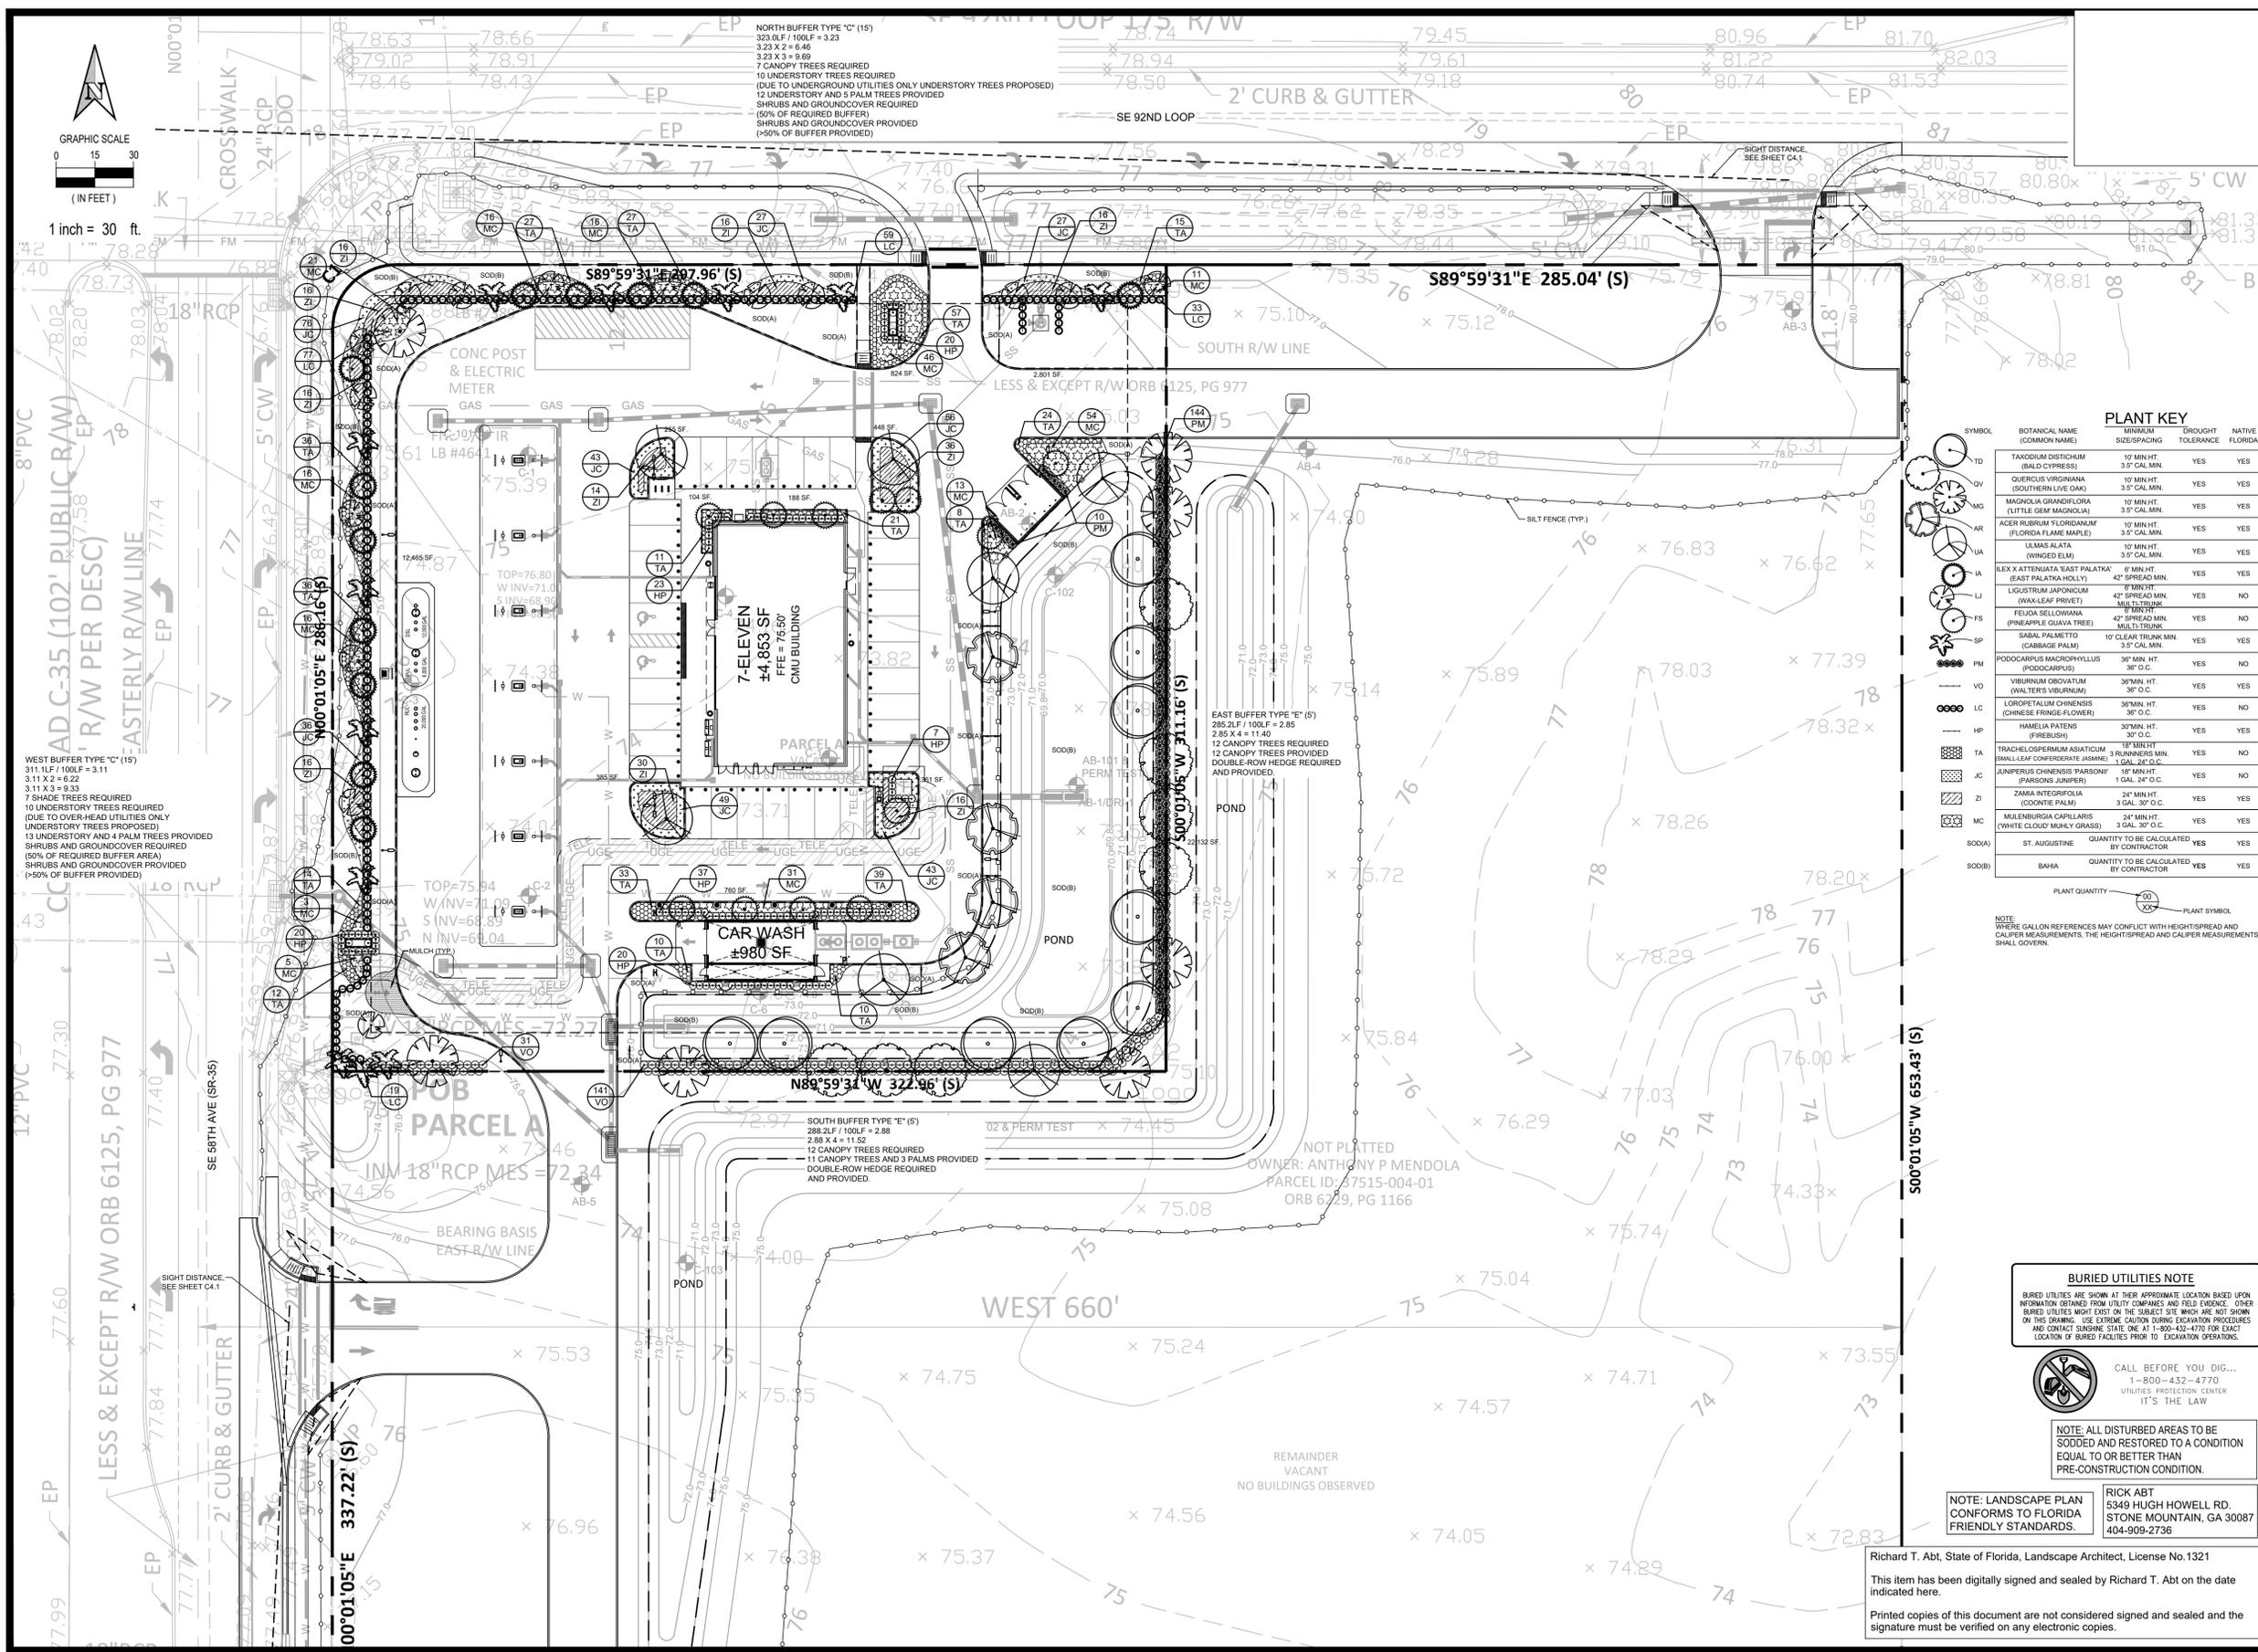

1 inch = 30 ft.
(IN FEET)

WEST BUFFER TYPE "C" (15)
 311 2LF / 100LF = 3.11
 3.11 X 2 = 6.22
 7 SHADE TREES REQUIRED
 10 UNDERSTORY TREES REQUIRED
 (DUE TO OVER-HEAD UTILITIES ONLY UNDERSTORY TREES PROPOSED)
 SHRUBS AND GROUND COVER REQUIRED (50% OF REQUIRED BUFFER AREA)
 SHRUBS AND GROUND COVER PROVIDED (50% OF BUFFER PROVIDED)

WEST BUFFER TYPE "E" (9)
 285 2LF / 100LF = 2.85
 2.85 X 4 = 11.40
 12 CANOPY TREES REQUIRED
 12 CANOPY TREES PROVIDED
 DOUBLE ROW HEDGE REQUIRED AND PROVIDED


SOUTH BUFFER TYPE "E" (5)
 288 2LF / 100LF = 2.88
 2.88 X 4 = 11.52
 12 CANOPY TREES REQUIRED
 11 CANOPY TREES AND 3 PALMS PROVIDED
 DOUBLE ROW HEDGE REQUIRED AND PROVIDED

EAST BUFFER TYPE "E" (9)
 285 2LF / 100LF = 2.85
 2.85 X 4 = 11.40
 12 CANOPY TREES REQUIRED
 12 CANOPY TREES PROVIDED
 DOUBLE ROW HEDGE REQUIRED AND PROVIDED


NORTH BUFFER TYPE "C" (15)
 323 0LF / 100LF = 3.23
 3.23 X 2 = 6.46
 3.23 X 3 = 9.69
 7 CANOPY TREES REQUIRED
 10 UNDERSTORY TREES REQUIRED
 (DUE TO UNDERGROUND UTILITIES ONLY UNDERSTORY TREES PROPOSED)
 12 UNDERSTORY AND 5 PALM TREES PROVIDED
 SHRUBS AND GROUND COVER REQUIRED (50% OF REQUIRED BUFFER)
 SHRUBS AND GROUND COVER PROVIDED (50% OF BUFFER PROVIDED)

REMAINDER VACANT
 NO BUILDINGS OBSERVED

NOT PLATTED
 OWNER: ANTHONY P MENDOLA
 PARCEL ID: 67515-004-01
 ORB 6229, PG 1166

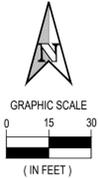

1 inch = 30 ft.

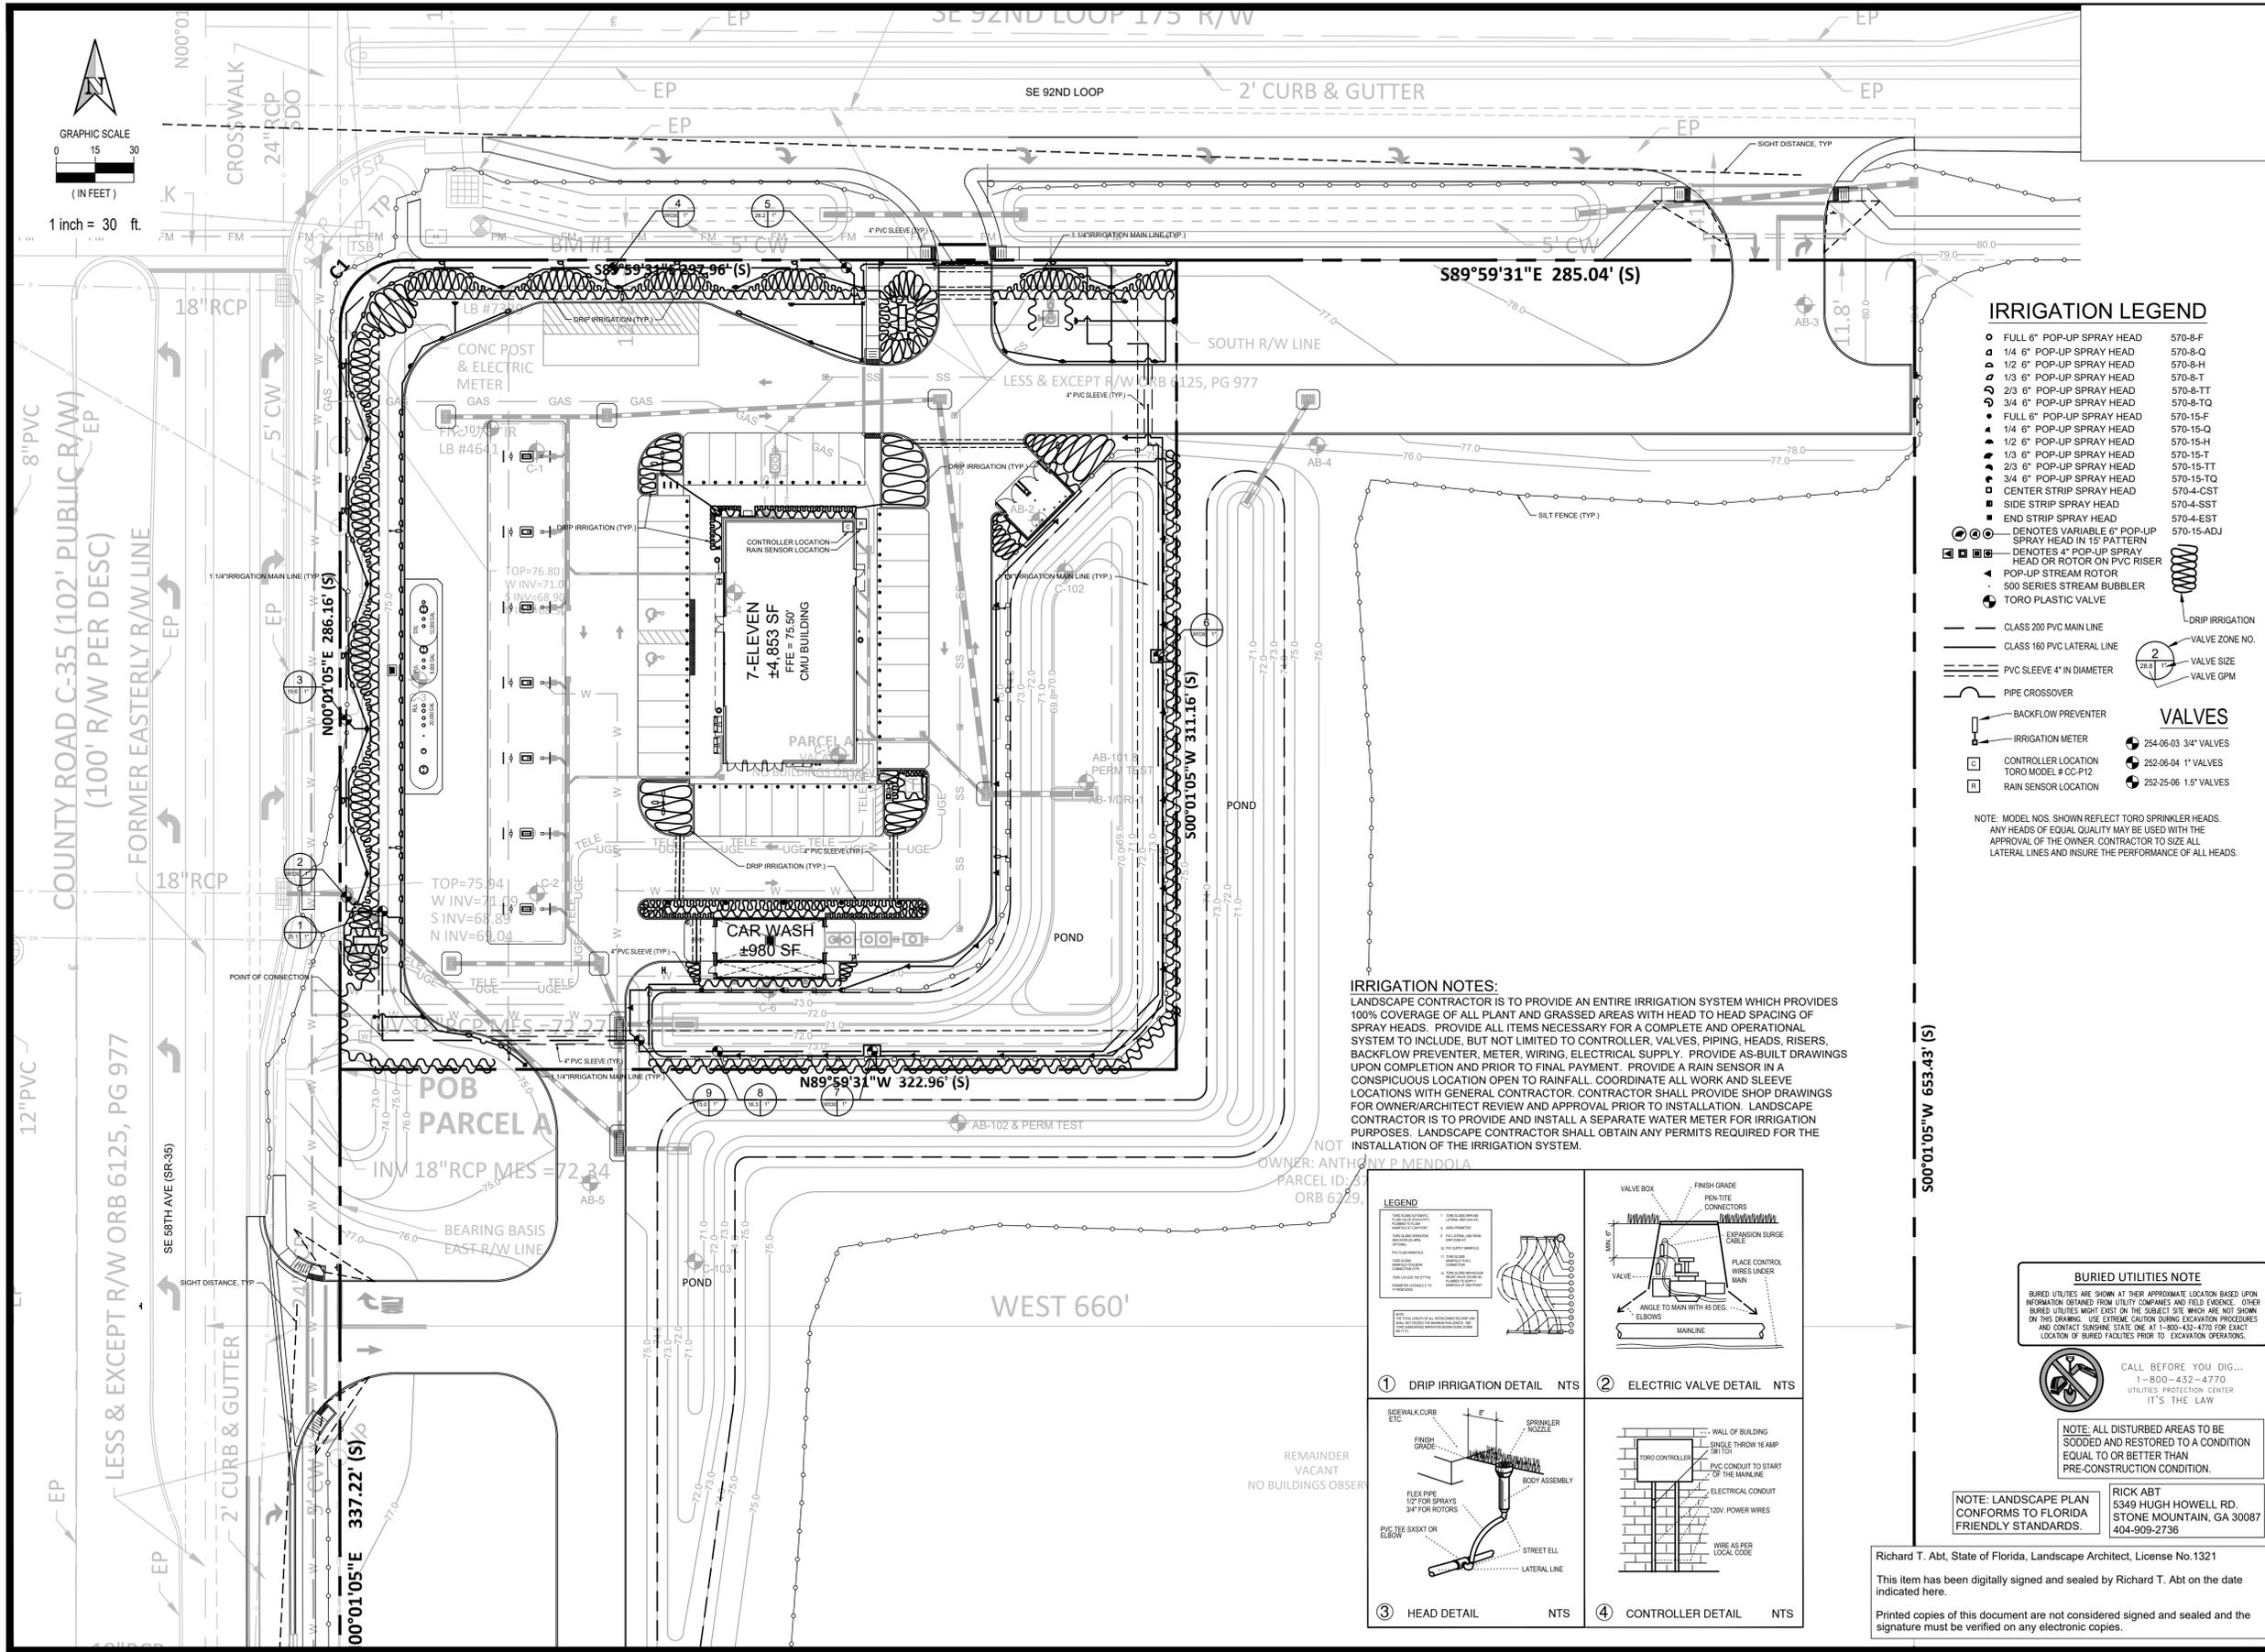


IRRIGATION LEGEND

- FULL 6" POP-UP SPRAY HEAD 570-8-F
 - 1/4" 6" POP-UP SPRAY HEAD 570-8-Q
 - 1/2" 6" POP-UP SPRAY HEAD 570-8-H
 - 2/3" 6" POP-UP SPRAY HEAD 570-8-T
 - 3/4" 6" POP-UP SPRAY HEAD 570-8-TT
 - 3/4" 6" POP-UP SPRAY HEAD 570-8-TQ
 - FULL 6" POP-UP SPRAY HEAD 570-15-F
 - 1/4" 6" POP-UP SPRAY HEAD 570-15-Q
 - 1/2" 6" POP-UP SPRAY HEAD 570-15-H
 - 2/3" 6" POP-UP SPRAY HEAD 570-15-T
 - 3/4" 6" POP-UP SPRAY HEAD 570-15-TT
 - 3/4" 6" POP-UP SPRAY HEAD 570-15-TQ
 - CENTER STRIP SPRAY HEAD 570-4-CST
 - SIDE STRIP SPRAY HEAD 570-4-SST
 - END STRIP SPRAY HEAD 570-4-EST
 - DENOTES VARIABLE 6" POP-UP SPRAY HEAD IN 15' PATTERN 570-15-ADJ
 - DENOTES 4" POP-UP SPRAY HEAD OR ROTOR ON PVC RISER
 - POP-UP STREAM ROTOR
 - 500 SERIES STREAM BUBBLER
 - TORO PLASTIC VALVE
- CLASS 200 PVC MAIN LINE
CLASS 160 PVC LATERAL LINE
PVC SLEEVE 4" IN DIAMETER
PIPE CROSSOVER
BACKFLOW PREVENTER
IRRIGATION METER
CONTROLLER LOCATION TORO MODEL # CC-P12
RAIN SENSOR LOCATION
- VALVE ZONE NO.
VALVE SIZE
VALVE GPM
- VALVES
254-06-03 3/4" VALVES
252-06-04 1" VALVES
252-25-06 1.5" VALVES

NOTE: MODEL NOS. SHOWN REFLECT TORO SPRINKLER HEADS. ANY HEADS OF EQUAL QUALITY MAY BE USED WITH THE APPROVAL OF THE OWNER. CONTRACTOR TO SIZE ALL LATERAL LINES AND INSURE THE PERFORMANCE OF ALL HEADS.

IRRIGATION NOTES:
LANDSCAPE CONTRACTOR IS TO PROVIDE AN ENTIRE IRRIGATION SYSTEM WHICH PROVIDES 100% COVERAGE OF ALL PLANT AND GRASSED AREAS WITH HEAD TO HEAD SPACING OF SPRAY HEADS. PROVIDE ALL ITEMS NECESSARY FOR A COMPLETE AND OPERATIONAL SYSTEM TO INCLUDE, BUT NOT LIMITED TO CONTROLLER, VALVES, PIPING, HEADS, RISERS, BACKFLOW PREVENTER, METER, WIRING, ELECTRICAL SUPPLY. PROVIDE AS-BUILT DRAWINGS UPON COMPLETION AND PRIOR TO FINAL PAYMENT. PROVIDE A RAIN SENSOR IN A CONSPICUOUS LOCATION OPEN TO RAINFALL. COORDINATE ALL WORK AND SLEEVE LOCATIONS WITH GENERAL CONTRACTOR. CONTRACTOR SHALL PROVIDE SHOP DRAWINGS FOR OWNER/ARCHITECT REVIEW AND APPROVAL PRIOR TO INSTALLATION. LANDSCAPE CONTRACTOR IS TO PROVIDE AND INSTALL A SEPARATE WATER METER FOR IRRIGATION PURPOSES. LANDSCAPE CONTRACTOR SHALL OBTAIN ANY PERMITS REQUIRED FOR THE INSTALLATION OF THE IRRIGATION SYSTEM.

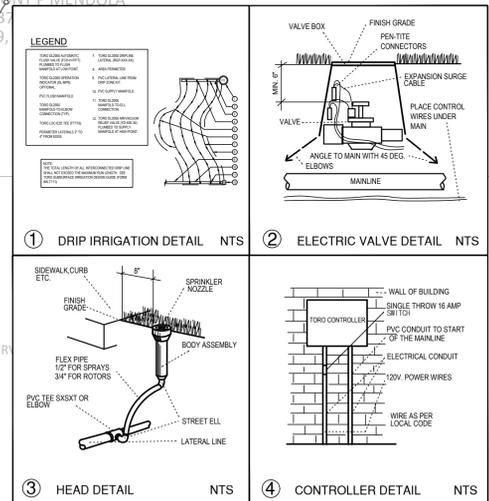

BURIED UTILITIES NOTE
BURIED UTILITIES ARE SHOWN AT THEIR APPROXIMATE LOCATION BASED UPON INFORMATION OBTAINED FROM UTILITY COMPANIES AND FIELD EVIDENCE. OTHER BURIED UTILITIES MAY EXIST ON THE SUBJECT SITE WHICH ARE NOT SHOWN ON THIS DRAWING. USE EXTREME CAUTION DURING EXCAVATION PROCEDURES AND CONTACT SANSHE, STATE ONE AT 1-800-432-4770 FOR EXACT LOCATION OF BURIED UTILITIES PRIOR TO EXCAVATION OPERATIONS.

CALL BEFORE YOU DIG...
1-800-432-4770
UTILITIES PROTECTION CENTER
IT'S THE LAW

NOTE: ALL DISTURBED AREAS TO BE SODDED AND RESTORED TO A CONDITION EQUAL TO OR BETTER THAN PRE-CONSTRUCTION CONDITION.

NOTE: LANDSCAPE PLAN CONFORMS TO FLORIDA FRIENDLY STANDARDS.

RICK ABT
5349 HUGH HOWELL RD.
STONE MOUNTAIN, GA 30087
404-909-2736

Richard T. Abt, State of Florida, Landscape Architect, License No. 1321
This item has been digitally signed and sealed by Richard T. Abt on the date indicated here.

Printed copies of this document are not considered signed and sealed and the signature must be verified on any electronic copies.

R.K.M. DEVELOPMENT CORP.



COMMON OAK ENGINEERING
4016 EDGEWATER DRIVE
ORLANDO, FL 32804
(407) 951-5915
CERTIFICATE OF AUTHORIZATION: 32644

MAJOR SITE PLAN
7-ELEVEN
&
AT SEC OF SE 92ND LP
SE 58TH AVE
BELLEVUE, FL
MARION COUNTY

NO.	DATE	REVISION / ISSUE	MARION COUNTY COMMENTS
4	12/15/2024		



ENGINEER'S NAME & PE#

PROJECT # 222.108

DATE 05/13/2024 SHEET

SCALE 1" = 30' C7.2

IRRIGATION PLAN

EROSION AND SEDIMENT CONTROL NOTES

- CLEARING AND GRUBBING OPERATIONS SHALL BE CONTROLLED SO AS TO MINIMIZE UNPROTECTED ERODIBLE AREAS EXPOSED TO WEATHER. GENERAL EROSION CONTROL BMPs SHALL BE EMPLOYED TO MINIMIZE SOIL EROSION AND OFF-SITE SEDIMENTATION WHILE THE VARIOUS SEDIMENTATION CONTROL MEASURES ARE BEING INSTALLED. THEY SHOULD BE EMPLOYED PRIOR TO ANY CONSTRUCTION ACTIVITY. SEDIMENT CONTROL CONSISTS OF SILT FENCING, HAY BALES, AND FLOATING TURBIDITY BARRIERS PER CURRENT FOOT SPECIFICATIONS. EROSION CONTROL CONSISTS OF SEEDING AND MULCHING, SOODING, WETTING SURFACES, PLACEMENT OF COARSE AGGREGATE, TEMPORARY PAWING.
- CONTRACTOR SHALL RESPOND TO EROSION AND SEDIMENT CONTROL MAINTENANCE REQUIREMENTS OR IMPLEMENT ADDITIONAL MEASURES TO CONTROL EROSIONS ORDERED BY OWNER OR GOVERNING AUTHORITIES WITHIN 48 HOURS OR SOONER IF REQUIRED AT NO ADDITIONAL COST TO THE OWNER.
- EXCAVATED MATERIAL WILL NOT BE DEPOSITED IN LOCATIONS WHERE IT COULD BE WASHED AWAY BY HIGH WATER OR STORM WATER RUNOFF. STOCKPILED MATERIAL SHALL BE COVERED OR ENCRUSTED WITH SEDIMENT CONTAINMENT DEVICES.
- STABILIZATION MEASURES SHALL BE INITIATED FOR EROSION AND SEDIMENT CONTROL ON DISTURBED AREAS AS SOON AS PRACTICABLE IN PORTIONS OF THE SITE WHERE CONSTRUCTION ACTIVITIES HAVE TEMPORARILY OR PERMANENTLY CEASED. CLEARED SITE DEVELOPMENT AREAS WHICH WILL REMAIN AT GRADE FOR 14 DAYS OR MORE SHOULD BE STABILIZED IMMEDIATELY BY COVERING WITH ADEQUATE AMOUNT OF HAY, COVER SEEDED AND PERIODICALLY WATERED SUFFICIENT TO STABILIZE THE TEMPORARY GROUND COVER, OR BY THE USE OF AN APPROPRIATE ALTERNATIVE BMP.
- ALL GRASS SLOPES CONSTRUCTED STEEPER THAN 4H:1V SHALL BE SOODED IMMEDIATELY AFTER FINAL GRADE IS ESTABLISHED.
- WHERE REQUIRED TO PREVENT EROSION FROM SHEET FLOW ACROSS BARE GROUND FROM ENTERING A LAKE OR SWALE, A TEMPORARY SEDIMENT SUMP SHALL BE CONSTRUCTED. THE TEMPORARY SEDIMENT SUMP SHALL REMAIN IN PLACE UNTIL VEGETATION IS ESTABLISHED ON THE GROUND DRAINING TO THE SUMP.
- PERMANENT SOIL EROSION CONTROL MEASURES FOR ALL SLOPES, CHANNELS, DITCHED OR ANY DISTURBED LAND AREAS SHALL BE COMPLETED IMMEDIATELY AFTER FINAL GRADING. WHEN IT IS NOT POSSIBLE TO PERMANENTLY PROTECT A DISTURBED AREA IMMEDIATELY AFTER GRADING OPERATIONS, TEMPORARY EROSION CONTROL MEASURES SHALL BE INSTALLED. ALL TEMPORARY PROTECTION SHALL BE MAINTAINED UNTIL PERMANENT MEASURES ARE IN PLACE AND ESTABLISHED. CONTRACTOR WILL BE REQUIRED TO INCORPORATE PERMANENT EROSION CONTROL FEATURES INTO PROJECT AT EARLIEST PRACTICAL TIME TO MINIMIZE NEED FOR TEMPORARY CONTROLS.
- IT IS THE CONTRACTOR'S RESPONSIBILITY TO DESIGNATE AN AREA WITHIN THE PROJECT LIMITS FOR CONCRETE TRUCK WASHOUT ACTIVITIES. THIS AREA SHALL PROVIDE EROSION CONTROL DEVICES THAT PREVENT CONTACT BETWEEN CONCRETE WASHOUT MATERIALS AND STORMWATER AND/OR SURFACE WATERS.
- IN ADDITION TO THOSE RESPONSIBILITIES OUTLINED WITHIN THE CONSTRUCTION PLANS AND DOCUMENTS, THE CONTRACTOR SHALL BE RESPONSIBLE FOR THE FOLLOWING MEASURES:
 - PROJECT SCHEDULE WITH EROSION AND SEDIMENT CONTROL INSTALLATION AND MAINTENANCE TIED TO THE SPECIFIC DATES OR CONSTRUCTION ACTIVITIES.
 - ALTERATIONS TO THE DESIGN EROSION AND SEDIMENT CONTROLS DUE TO DIFFERENCE BETWEEN THE DESIGN PLANS AND ANTICIPATED CONSTRUCTION PHASING AND THE CONTRACTOR'S CONSTRUCTION METHODS.
 - NAME AND PHONE NUMBER OF CONTRACTOR'S REPRESENTATIVE RESPONSIBLE FOR EROSION AND SEDIMENT CONTROL INSTALLATION AND MAINTENANCE ON A 24 HOUR BASIS.
 - THE CONTRACTOR WILL FURNISH, INSTALL, MAINTAIN AND SUBSEQUENTLY REMOVE ALL NECESSARY EROSION CONTROL. THE CONTRACTOR WILL FURNISH AND INSTALL ALL NECESSARY PERMANENT EROSION CONTROLS.
 - THE DEVELOPMENT OF THE APPLICABLE BMPs TO ENSURE THE CONTROL OF OFF-SITE TRACKING/SPLASH, SANITARY WASTE, FERTILIZERS & PESTICIDES, SOLID WASTE DISPOSAL, AND NON-STORMWATER DISCHARGES & HAZARDOUS WASTE. WHEN THE CONTRACTOR ENCOUNTERS A SPILL, CONSTRUCTION WILL STOP AND WORK WILL NOT RESUME UNTIL DIRECTED BY THE PROJECT ENGINEER. DISPOSITION OF HAZARDOUS WASTE WILL BE MADE IN ACCORDANCE WITH ANY REQUIREMENTS AND REGULATIONS OF ANY LOCAL, STATE OR FEDERAL AGENCY HAVING JURISDICTION. THE CONTRACTOR IS ADVISED THAT THE CONTRACT DRAWINGS ONLY INDICATE EROSION, SEDIMENT AND TURBIDITY CONTROLS AT LOCATIONS DETERMINED IN THE DESIGN PROCESS. HOWEVER, THE CONTRACTOR IS REQUIRED TO PROVIDE ANY ADDITIONAL CONTROLS NECESSARY TO PREVENT THE POSSIBILITY OF SILTING ANY ADJACENT LOWLAND PARCEL OR RECEIVING WATER.
 - INSPECT EROSION AND SEDIMENT CONTROLS WEEKLY OR IMMEDIATELY FOLLOWING A RAIN EVENT OF 1/2 INCH OR GREATER DURING CONSTRUCTION. REMOVE ANY SEDIMENT BUILD-UP, REPAIR AND REINSTALL ANY DAMAGED OR MISSING SEDIMENT CONTROL MEASURES. INSTALL ADDITIONAL MEASURES IF INSPECTION REVEALS ADDITIONAL SEDIMENTATION CONTROL IS NECESSARY.
- EROSION AND SEDIMENT CONTROL BARRIERS SHALL BE PLACED ADJACENT TO ALL WETLAND AREAS WHERE THERE IS POTENTIAL FOR DOWNSTREAM WATER QUALITY DEGRADATION.
- ANY DISCHARGE FROM DEWATERING ACTIVITY SHALL BE FILTERED AND CONVEYED TO THE OUTFALL IN A MANNER WHICH PREVENTS EROSION AND TRANSPORTATION OF SUSPENDED SOLIDS TO RECEIVING OUTFALL.
- DE-WATERING PUMPS SHALL NOT EXCEED THE CAPACITY OF THAT WHICH REQUIRES A CONSUMPTIVE USE PERMIT FROM THE WATER MANAGEMENT DISTRICT.
- ALL DE-WATERING, EROSION, AND SEDIMENT CONTROL TO REMAIN IN PLACE AFTER COMPLETION OF CONSTRUCTION AND REMOVED ONLY WHEN AREAS HAVE BEEN STABILIZED.
- THE CONTRACTOR SHALL BE REQUIRED TO RESPOND TO ALL WATER MANAGEMENT DISTRICT, FLORIDA DEPARTMENT OF ENVIRONMENTAL PROTECTION (FDEP) AND ANY GOVERNING JURISDICTIONS REQUIRES RELATIVE TO COMPLIANCE FOR EROSION AND SEDIMENTATION CONTROL. THE COST OF THIS COMPLIANCE SHALL BE PART OF THE CONTRACT.
- ALL FILL SLOPES SHALL HAVE SILT FENCE AT THE TOP OF SLOPES.
- ALL SLOPES STEEPER THAN 2:1 AND WITH A HEIGHT OF 10' FEET OR GREATER, AND CUTS AND FILLS WITH STREAM BUFFERS SHALL BE STABILIZED WITH APPROPRIATE EROSION CONTROL MATTING OR BLANKETS AND ACCORDING TO FLORIDA E.P.D. REQUIREMENTS.
- FOR ADDITIONAL INFORMATION ON SEDIMENT AND EROSION CONTROL REFER TO "THE FLORIDA DEVELOPMENT MANUAL - A GUIDE TO SOUND LAND AND WATER MANAGEMENT" FROM THE STATE OF FLORIDA DEPARTMENT OF ENVIRONMENTAL REGULATION (F.D.E.R.) CHAPTER 6.

PROTECTION OF SURFACE WATERS

- WHERE APPROPRIATE OR WHEN REQUIRED BY STATE, FEDERAL OR LOCAL AGENCIES, DOWNSTREAM RECEIVING WATERS SHALL BE MONITORED THROUGHOUT CONSTRUCTION FOR TURBIDITY AND PH. A BACKGROUND SAMPLE SHALL BE TAKEN PRIOR TO COMMENCEMENT OF CONSTRUCTION.
- WHERE PRACTICAL, STORMWATER SHALL BE CONVEYED BY SWALES. SWALES SHALL BE CONSTRUCTED AS SHOWN ON PLANS.
- EXCAVATED MATERIAL WILL NOT BE DEPOSITED IN LOCATIONS WHERE IT COULD BE WASHED AWAY BY HIGH WATER OR STORM WATER RUNOFF. STOCKPILED MATERIAL SHALL BE COVERED OR ENCRUSTED WITH SEDIMENT CONTAINMENT DEVICES.
- EROSION CONTROL MEASURES SHALL BE EMPLOYED TO MINIMIZE TURBIDITY OF SURFACE WATERS LOCATED DOWNSTREAM OF ANY CONSTRUCTION ACTIVITY. WHILE THE VARIOUS MEASURES REQUIRED WILL BE SITE SPECIFIC, THEY SHALL BE EMPLOYED AS NEEDED IN ACCORDANCE WITH THE FOLLOWING:
 - IN GENERAL, EROSION SHALL BE CONTROLLED AT THE FURTHEST PRACTICAL UPSTREAM LOCATION.
 - NEW AND EXISTING STORMWATER INLETS AND OUTFALL STRUCTURES SHALL BE PROTECTED DURING CONSTRUCTION. PROTECTION MEASURES SHALL BE EMPLOYED IMMEDIATELY AS REQUIRED DURING THE VARIOUS STAGES OF CONSTRUCTION.
 - PERMANENT EROSION CONTROL DEVICES SHALL BE INSTALLED PRIOR TO LAND DISTURBANCE AND SHALL REMAIN IN PLACE UNTIL FINAL SITE STABILIZATION HAS BEEN ESTABLISHED.
- HEAVY CONSTRUCTION EQUIPMENT PARKING AND MAINTENANCE AREAS SHALL BE DESIGNED TO PREVENT OIL, GREASE, AND LUBRICANTS FROM ENTERING SITE DRAINAGE FEATURES INCLUDING STORMWATER COLLECTION SYSTEMS. CONTRACTORS SHALL PROVIDE BROAD BRIMS OR SILT SCREENS AROUND, AND SEDIMENT SUMPS WITHIN, SUCH AREAS AS REQUIRED TO CONTAIN SPILLS OF OIL, GREASE, LUBRICANTS, OR OTHER CONTAMINANTS. CONTRACTORS SHALL HAVE AVAILABLE, AND SHALL USE, ABSORBENT FILTER PADS TO CLEAN UP SPILLS IMMEDIATELY AFTER ANY OCCURRENCE.

CONTROL OF FUGITIVE DUST AND WIND EROSION

- THESE NOTES ARE PROVIDED TO PREVENT BLOWING AND MOVEMENT OF DUST FROM EXPOSED SOIL SURFACES, TO REDUCE ON AND OFF SITE DAMAGE AND HEALTH HAZARDS, AND TO IMPROVE TRAFFIC SAFETY ON THE CONSTRUCTION SITE.
- THIS PRACTICE IS APPLICABLE TO AREAS SUBJECT TO DUST BLOWING AND MOVEMENT WHERE ON AND OFF SITE DAMAGE IS LIKELY WITHOUT TREATMENT. THE CONTRACTOR SHALL PROVIDE ANY ADDITIONAL MEASURES AS APPROPRIATE AND AS DIRECTED BY THE ENGINEER.
- THE FOLLOWING METHODS SHOULD BE CONSIDERED FOR CONTROLLING DUST:
 - MULCHES - SEE STANDARDS FOR STABILIZATION WITH MULCHES ONLY
 - VEGETATIVE COVER - SEE STANDARDS FOR TEMPORARY VEGETATIVE COVER, PERMANENT VEGETATIVE COVER, AND PERMANENT STABILIZATION WITH SOO.
 - SPRAY ON ADHESIVES (SEE CHART BELOW) - ON MINERAL SOILS (NOT EFFECTIVE ON MUCK SOILS), KEEP TRAFFIC OFF THESE AREAS

MATERIAL	WATER DILUTION	TYPE OF NOZZLE	APPL. GALLONS/ACRE
AMINIC ASPHALT EMULSION	7:1	COARSE SPRAY	1200
LATES EMULSION	12.5:1	FINE SPRAY	235
RESIN IN WATER	4:1	FINE SPRAY	300
POLYACRYLAMIDE (PAM) - SPRAY ON			
POLYACRYLAMIDE (PAM) - DRY SPRAY	WATER DILUTION	APPLY ACCORDING TO MANUFACTURER'S INSTRUCTIONS. MAY ALSO BE USED AS AN ADDITIVE TO SEDIMENT BASINS TO FLOCCULATE AND PRECIPITATE SUSPENDED SOLIDS. SEE SEDIMENT BASIN STANDARDS.	
AGULMATED SOY BEAN SGP STICK	NONE	COARSE SPRAY	1200

- TILLAGE - TO ROUGHEN SURFACE AND BRING CLODS TO SURFACE. THIS IS A TEMPORARY EMERGENCY MEASURE WHICH SHOULD BE USED BEFORE SOIL BLOWING STARTS. BEGIN FLOWING ON WINDWARD SIDE OF SITE. CHISEL-TYPE PLOWS SPACED ABOUT 12' APART, AND SPRING TOOTHED HARROWS ARE EXAMPLES OF EQUIPMENT WHICH MAY PRODUCE THE DESIRED EFFECT.
 - SPRINKLING - SITE IS SPRINKLED UNTIL THE SURFACE IS WET.
 - BARRIERS - SOLID BOARD FENCES, SNOW FENCES, BURLAP FENCES, CRATE WALLS, BALES OF HAY, AND SIMILAR MATERIAL CAN BE USED TO CONTROL AIR CURRENTS AND SOIL BLOWING.
 - CALCIUM CHLORIDE - SHALL BE IN THE FORM OF LOOSE, DRY GRANULES OR FLAKES FINE ENOUGH TO FEED THROUGH COMMONLY USED SPREADERS TO A RATE THAT WILL KEEP ENOUGH SURFACE MOIST BUT NOT CAUSE POLLUTION OR PLANT DAMAGE. IF USED ON STEEPER SLOPES, THEN USE OTHER PRACTICES TO PREVENT WASHING INTO STREAMS OR ACCUMULATION AROUND PLANTS.
 - STONE - COVER SURFACES WITH CRUSHED STONE OR COARSE GRAVEL.
- PREVENT THE GENERATION OF DUST IN PREFERENCE TO APPLYING DUST SUPPRESSION MEASURES. ENSURE IN THE PROJECT SCHEDULE THAT THE AREA OF CLEARED LAND IS MINIMIZED DURING THE EARLY MONTHS OF THE YEAR, WHEN DUST GENERATION IS AT ITS GREATEST.
 - THE SOIL SHALL BE MAINTAINED IN A SUFFICIENTLY DAMP CONDITION TO PREVENT LOOSE GRAINS OF SOIL FROM BECOMING DISLODGED. THE SOIL SHALL BE COMPLETELY CRUSTED OVER BY APPLICATION OF WATER OR COMPLETELY COVERED WITH CLEAN GRAVEL OR TREATED WITH AN APPROVED DUST SUPPRESSANT.
 - PAVE AND WATER HAIL ROADS. THE FREQUENCY OF WATERING WILL BE DETERMINED BY WEATHER CONDITIONS AND THE ERODIBILITY OF THE SOIL. IF ADDITIONS IN THE WATER ARE USED TO INCREASE ITS DUST SUPPRESSION PROPERTIES, THE CHEMICAL SHOULD HAVE NO ADVERSE ENVIRONMENTAL IMPACT ON ADJACENT WATER BODIES.
 - WATER AREAS OTHER THAN HAIL ROADS, IF THEY ARE A SOURCE OF DUST.
 - ENSURE THAT SMOOTH SURFACES ARE DEEP RIPPLED AND LEFT ROUGH AND CLOUDY TO REDUCE THE WIND VELOCITY AT THE SOIL SURFACE.
 - CONSTRUCT WIND FENCES IF THIS IS APPROPRIATE FOR THE SITE. AS A CONTINGENCY MEASURE, IN AREAS THAT DO NOT HAVE ACCESS TO A WATER SUPPLY, WATER STORED ON SITE SHOULD NEVER BE LESS THAN FIFTY PERCENT OF DISTURBED LAND SURFACE. WHEREVER WATERING IS USED TO SUPPRESS DUST, ENSURE IT DOES NOT CREATE CONTAMINATED RUN-OFF THAT WILL CONTAMINATE SURFACE WATERS.
 - USE BARRIERS WHERE REQUIRED TO PREVENT THE MIGRATION OF SAWDUST OR PARTICULATES FROM SANDING OR SURFACE PREPARATION ACTIVITIES DURING CONSTRUCTION.
 - BARE EARTH AREAS SHALL BE WATERED DURING CONSTRUCTION AS NECESSARY TO MINIMIZE THE TRANSPORT OF FUGITIVE DUST. IT MAY BE NECESSARY TO LIMIT CONSTRUCTION VEHICLE SPEED IF BARE EARTH HAS NOT BEEN EFFECTIVELY WATERED. IN NO CASE SHALL FUGITIVE DUST BE ALLOWED TO LEAVE THE SITE UNDER CONSTRUCTION.

- AS REQUIRED AFTER COMPLETION OF CONSTRUCTION, BARE EARTH AREAS SHALL BE VEGETATED.
 - AT ANY TIME BOTH DURING AND AFTER SITE CONSTRUCTION THAT WINDING AND/OR VEGETATION ARE NOT EFFECTIVE IN CONTROLLING WIND EROSION AND/OR TRANSPORT OF FUGITIVE DUST, OTHER METHODS AS ARE NECESSARY FOR SUCH CONTROL, SHALL BE EMPLOYED. THESE METHODS MAY INCLUDE ERECTION OF DUST CONTROL FENCES. IF REQUIRED, DUST CONTROL FENCES SHALL BE CONSTRUCTED IN ACCORDANCE WITH THE DETAIL FOR A SILT FENCE EXCEPT THE MINIMUM HEIGHT SHALL BE 4 FEET.
- POLLUTION PREVENTION NOTES:**
- OFF SITE SURFACE WATER DISCHARGES, OR DISCHARGES TO ON-SITE WETLANDS OR SURFACE WATERS WITH TURBIDITY IN EXCESS OF 20 NEPHELOMETRIC TURBIDITY UNITS (NTU) ABOVE GROUND LEVEL SHALL BE IMMEDIATELY CORRECTED. SUCH INCIDENTS SHALL BE REPORTED TO WATER RESOURCES WITHIN 24 HOURS OF THE OCCURRENCE. THE REPORT SHALL INCLUDE THE CAUSE OF DISCHARGE AND CORRECTIVE ACTIONS TAKEN.
 - FUEL AND OTHER PETROLEUM PRODUCT SPILLS THAT ENTER STORMWATER DRAINS OR WATERBODIES, OR FUEL AND OTHER PETROLEUM PRODUCT SPILLS THAT ARE IN EXCESS OF 25 GALLONS SHALL BE CONTAINED, CLEANED UP, AND IMMEDIATELY REPORTED TO WATER RESOURCES. SMALLER GROUND SURFACE SPILLS SHALL BE CLEANED UP AS SOON AS PRACTICAL.
 - IF CONTAMINATED SOLID GROUNDWATER IS DISCOVERED DURING DEVELOPMENT OF THE SITE, ALL ACTIVITY IN THE VICINITY OF THE CONTAMINATION SHALL IMMEDIATELY CEASE, AND WATER RESOURCES SHALL BE CONTACTED.
 - PRIOR TO DEMOLITION OF EXISTING ON-SITE STRUCTURES AN ASBESTOS SURVEY AND/OR ASBESTOS NOTIFICATION MAY BE REQUIRED.
 - THE DISCHARGE OF GROUNDWATER PRODUCED THROUGH DEWATERING, TO SURFACE WATERS, OR ANY PORTION OF THE MSW WILL REQUIRE SEPARATE PERMITTING FROM THE FLORIDA DEPARTMENT OF ENVIRONMENTAL PROTECTION (FDEP). PERMITS SHALL BE OBTAINED PRIOR TO THE COMMENCEMENT OF DEWATERING.

EROSION AND SEDIMENT CONTROLS BMPs

IT IS THE CONTRACTOR'S RESPONSIBILITY TO IMPLEMENT THE EROSION AND TURBIDITY CONTROLS AS SHOWN ON THE EROSION AND TURBIDITY CONTROL PLAN. IT IS ALSO THE CONTRACTOR'S RESPONSIBILITY TO ENSURE THESE CONTROLS ARE PROPERLY INSTALLED, MAINTAINED AND FUNCTIONING PROPERLY TO PREVENT TURBID OR POLLUTED WATER FROM LEAVING THE PROJECT SITE. THE CONTRACTOR WILL ADJUST THE EROSION AND TURBIDITY CONTROLS SHOWN ON THE EROSION AND TURBIDITY CONTROL PLAN AND ADD ADDITIONAL CONTROL MEASURES AS REQUIRED TO ENSURE THE SITE MEETS ALL FEDERAL, STATE AND LOCAL EROSION AND TURBIDITY CONTROL REQUIREMENTS. THE FOLLOWING BEST MANAGEMENT PRACTICES WILL BE IMPLEMENTED BY THE CONTRACTOR AS REQUIRED BY THE EROSION AND TURBIDITY CONTROL PLAN AND AS REQUIRED TO MEET THE EROSION AND TURBIDITY REQUIREMENTS IMPOSED ON THE PROJECT SITE BY THE REGULATORY AGENCIES.

- EROSION AND SEDIMENT CONTROLS STABILIZATION PRACTICES:**
- HAY BALE BARRIER - HAY BALE BARRIERS CAN BE USED BELOW DISTURBED AREAS SUBJECT TO SHEET AND RILL EROSION WITH THE FOLLOWING LIMITATIONS:
 - WHERE THE MAXIMUM SLOPE BEYOND THE BARRIER IS 33 PERCENT
 - IN MINOR SWALES OR DITCH LINES WHERE THE MAXIMUM CONTRIBUTING DRAINAGE AREA IS NO GREATER THAN 2 ACRES, WHERE EFFECTIVENESS IS REQUIRED FOR LESS THAN 3 MONTHS, EVERY EFFORT SHOULD BE MADE TO LIMIT THE USE OF STRAW BALE BARRIERS. CONSTRUCTED LINE STREAMS OR IN SWALES WHERE THERE IS THE POSSIBILITY OF A WASHOUT, PROTECTION MEASURES SHALL BE TAKEN TO PROPERLY ANCHOR BALES TO INSURE AGAINST WASHOUT.
 - FILTER FABRIC BARRIER - FILTER FABRIC BARRIERS CAN BE USED BELOW DISTURBED AREAS SUBJECT TO SHEET AND RILL EROSION WITH THE FOLLOWING LIMITATIONS:
 - WHERE THE MAXIMUM SLOPE BEYOND THE BARRIER IS 33 PERCENT
 - WHERE THE MAXIMUM SLOPE BEYOND THE BARRIER IS GREATER THAN 2 ACRES
 - BRUSH BARRIER WITH FILTER FABRIC - BRUSH BARRIER MAY BE USED BELOW DISTURBED AREAS SUBJECT TO SHEET AND RILL EROSION WHERE ENOUGH RESIDUE MATERIAL IS AVAILABLE ON SITE.
 - LEVEL SPREADER - A LEVEL SPREADER MAY BE USED WHERE SEDIMENT-FREE STORM RUNOFF IS INTERCEPTED AND DIVERTED AWAY FROM THE GRADED AREAS ONTO UNDISTURBED STABILIZED AREAS. THIS PRACTICE APPLIES ONLY IN THOSE SITUATIONS WHERE THE SPREADER CAN BE CONSTRUCTED ON UNDISTURBED SOIL AND THE AREA BELOW THE LEVEL LIP IS STABILIZED. THE WATER SHOULD NOT BE ALLOWED TO RECONCENTRATE AFTER RELEASE.
 - STOCKPILING MATERIAL - NO EXCAVATED MATERIAL SHALL BE STOCKPILED IN SUCH A MANNER AS TO DIRECT RUNOFF DIRECTLY OFF THE PROJECT SITE INTO ANY ADJACENT WATER BODY OR STORM WATER COLLECTION FACILITY.
 - EXPOSED AREA LIMITATION - THE SURFACE AREA OF OPEN, RAW ERODIBLE SOIL EXPOSED BY CLEARING AND GRUBBING OPERATIONS OR EXCAVATION AND FILLING OPERATIONS SHALL NOT EXCEED 1000 SQ. YD. PER 1000 SQ. YD. OF COVERED AREA. PROTECTS WITH AN EROSION CONTROL PLAN WHICH DEMONSTRATES THAT OPENING OF ADDITIONAL AREAS WILL NOT SIGNIFICANTLY AFFECT OFF-SITE DEPOSIT OF SEDIMENTS.
 - INLET PROTECTION - INLETS AND CATCH BASINS WHICH DISCHARGE DIRECTLY OFF-SITE SHALL BE PROTECTED FROM SEDIMENT-LADEN STORM RUNOFF UNTIL THE COMPLETION OF ALL CONSTRUCTION OPERATIONS THAT MAY CONTRIBUTE SEDIMENT TO THE INLET.
 - TEMPORARY SEEDING - AREAS OPENED BY CONSTRUCTION OPERATIONS AND THAT ARE NOT ANTICIPATED TO BE RE-EXCAVATED OR DRESSED AND RECEIVE FINAL GRASSING TREATMENT WITHIN 30 DAYS SHALL BE SEEDING WITH A GOOD GROWING GRASS SPECIES WHICH WILL PROVIDE AN EARLY COVER DURING THE SEASON IN WHICH IT IS PLANTED AND WILL NOT LATER COMPETE WITH THE PERMANENT GRASSING.
 - TEMPORARY SEEDING AND MULCHING - SLOPES STEEPER THAN 6:1 THAT FALL WITHIN THE CATEGORY ESTABLISHED IN PARAGRAPH 4 ABOVE SHALL ADDITIONALLY RECEIVE MULCHING OF APPROXIMATELY 2 INCHES LOOSE MEASURE OF MULCH MATERIAL CUT INTO THE SOIL OF THE SEEDING AREA ADEQUATE TO PREVENT MOVEMENT OF SEED AND MULCH.
 - TEMPORARY GRASSING - THE SEEDING OR SEEDING AND MULCHED AREAS(S) SHALL BE ROLLED AND WATERED OR HYDROMULCHED OR OTHER SUITABLE METHODS IF REQUIRED TO ASSURE OPTIMUM GROWING CONDITIONS FOR THE ESTABLISHMENT OF A GOOD GRASS COVER. TEMPORARY GRASSING SHALL BE THE SAME MIX & AMOUNT REQUIRED FOR PERMANENT GRASSING IN THE CONTRACT SPECIFICATIONS.
 - TEMPORARY REGRESSING - IF, AFTER 14 DAYS FROM SEEDING, THE TEMPORARY GRASSING AREAS HAVE NOT ATTAINED A MINIMUM OF 85 PERCENT UNIFORM GOOD GRASS COVER, THE AREA WILL BE REWORKED AND ADDITIONAL SEED APPLIED SUFFICIENT TO ESTABLISH THE DESIRED VEGETATIVE COVER.
 - MAINTENANCE - ALL FEATURES OF THE PROJECT DESIGNED AND CONSTRUCTED TO PREVENT EROSION AND SEDIMENT SHALL BE MAINTAINED DURING THE LIFE OF THE CONSTRUCTION SO AS TO FUNCTION AS THEY WERE ORIGINALLY DESIGNED AND CONSTRUCTED.
 - PERMANENT EROSION CONTROL - THE EROSION CONTROL FACILITIES OF THE PROJECT SHOULD BE DESIGNED TO MINIMIZE THE IMPACT ON THE OFFSITE FACILITIES.
 - PERMANENT SEEDING - ALL AREAS WHICH HAVE BEEN DISTURBED BY CONSTRUCTION WILL AS A MINIMUM, BE SEEDING MIX MUST PROVIDE BOTH LONG-TERM VEGETATION AND RAPID GROWTH SEASONAL VEGETATION. SLOPES STEEPER THAN 4:1 SHALL BE SEEDING AND MULCHED OR SOODED.

- STRUCTURAL PRACTICES**
- TEMPORARY DIVERSION DIKE - TEMPORARY DIVERSION DIKES MAY BE USED TO DIVERT RUNOFF THROUGH A SEDIMENT-TRAPPING FACILITY.
 - TEMPORARY SEDIMENT TRAP - A SEDIMENT TRAP SHALL BE INSTALLED IN AN DRAINAGEWAY AT A STORM DRAIN INLET OR AT OTHER POINTS OF DISCHARGE FROM A DISTURBED AREA. THE FOLLOWING SEDIMENT TRAPS MAY BE CONSTRUCTED EITHER INDEPENDENTLY OR IN CONJUNCTION WITH A TEMPORARY DIVERSION DIKE:
 - BLOCK & GRAVEL SEDIMENT FILTER - THIS PRACTICE IS APPLICABLE WHERE HEAVY FLOWS AND/OR WHERE AN OVERFLOW CAPACITY IS NECESSARY TO PREVENT EXCESSIVE PONDING AROUND THE STRUCTURE.
 - GRAVEL SEDIMENT TRAP - THIS PRACTICE IS APPLICABLE WHERE HEAVY CONCENTRATED FLOWS ARE EXPECTED, BUT NOT WHERE PONDING AROUND THE STRUCTURE MIGHT CAUSE EXCESSIVE INCONVENIENCE OR DAMAGE TO ADJACENT STRUCTURES UNPROTECTED AREAS.
 - DROP INLET SEDIMENT TRAP - THIS PROTECTION IS APPLICABLE WHERE THE INLET DRAINS A RELATIVELY FLAT AREA (< 1%) AND WHERE SHEET OR OVERLAND FLOWS (< 1/2 CFS) ARE TYPICAL. THIS METHOD SHALL NOT APPLY TO INLETS RECEIVING CONCENTRATED FLOWS SUCH AS IN STREET OR HIGHWAY MEDIANS.
 - OUTLET PROTECTION - APPLICABLE TO THE OUTLETS OF ALL PIPES AND PAVED CHANNEL SECTIONS WHERE THE FLOW COULD CAUSE EROSION & SEDIMENT PROTECTION TO THE RECEIVING WATER BODY. SILT FENCES & HAY BALES ARE TO BE INSTALLED IMMEDIATELY DOWNSTREAM OF THE DISCHARGING STRUCTURE AS SHOWN ON THE OUTLET PROTECTION DETAIL.
 - SEDIMENT BASIN - WILL BE CONSTRUCTED AT THE COMMON DRAINAGE LOCATIONS THAT SERVE AN AREA WITH 10 OR MORE DISTURBED ACRES AT ONE TIME. THE PROPOSED STORM WATER POND(S) OR TEMPORARY POND(S) WILL BE CONSTRUCTED FOR USE AS SEDIMENT BASINS. THESE SEDIMENT BASINS MUST PROVIDE A MINIMUM OF 3.00 CUBIC FEET OF STORAGE PER ACRE DRAINED UNTIL FINAL STABILIZATION OF THE SITE.

DETAILED NOTES:

- NO CONSTRUCTION MATERIAL SHALL BE DISCHARGED TO WATERS OF THE STATE UNLESS AUTHORIZED BY A SECTION 404 PERMIT UNDER THE STATE OF FLORIDA ENVIRONMENTAL RECONSTRUCTION PERMIT. ALL CONSTRUCTION DEBRIS SHALL BE DISPOSED OF IN AN APPROVED UPLAND LOCATION. BUILDING MATERIAL SHALL NOT BE DISPOSED OF IN WETLANDS OR BURIED ON-SITE.
- IT IS THE RESPONSIBILITY OF THE CONTRACTOR TO DEVELOP AN EROSION CONTROL PLAN THAT PROVIDES A DETAILED DESCRIPTION OF ALL EROSION AND SEDIMENT CONTROLS. BEST MANAGEMENT PRACTICES AND MEASURES THAT WILL BE IMPLEMENTED AT THE CONSTRUCTION SITE FOR EACH ACTIVITY IDENTIFIED IN SECTION 1.B. SEQUENCE OF SOIL DISTURBING ACTIVITIES. CONTRACTOR IS RESPONSIBLE FOR PROVIDING THE FRAMES IN WHICH THE CONTROLS WILL BE IMPLEMENTED, MAINTAINED AND REMOVED. THIS INFORMATION SHALL BE KEPT AT THE PROJECT FIELD OFFICE IN ORDER FOR THE PROJECT TO BE CONSIDERED IN COMPLIANCE WITH FDEP GENERAL PERMIT FOR STORMWATER DISCHARGE FROM LARGE AND SMALL CONSTRUCTION SITES.
- THE CONTRACTOR IS RESPONSIBLE FOR ENSURING THE FOLLOWING ITEMS ARE ON SITE:
 - COPY OF THE STORMWATER POLLUTION PREVENTION PLAN WITH THE ORIGINAL CERTIFICATION SIGNATURES.
 - COPY OF CONTRACTOR'S EROSION CONTROL PLAN.
 - HAZARDOUS SPILL CONTROL PLAN WITH GUIDELINES ON CONTACTING THE 24 HOUR EMERGENCY RESPONSE PROGRAM FOR HAZARDOUS MATERIAL SPILLS. THIS SHALL INCLUDE COPIES OF DISCHARGE NOTIFICATIONS THAT HAVE OCCURRED WITHIN THE PROJECT LIMITS.
 - COMPLETE INSPECTIONS FORM.
- THE CONTRACTOR IS RESPONSIBLE FOR SUBMITTING THE FOLLOWING ITEMS TO FLORIDA DEPARTMENT OF ENVIRONMENTAL PROTECTION IN ORDER FOR THE NPDES PERMIT TO BE PROCESSED:
 - FDEP FORM 62-621 (300)(b) - NOTICE OF INTENT TO USE GENERAL PERMIT FOR STORMWATER DISCHARGE FROM LARGE AND SMALL CONSTRUCTION ACTIVITIES. THIS NOTICE OF INTENT SHALL BE SIGNED BY THE CONTRACTOR.
 - THE CONTRACTOR IS REQUIRED TO SUBMIT A COPY OF THIS LOG ALONG WITH A NOTICE OF TERMINATION TO THE FLORIDA DEPARTMENT OF ENVIRONMENTAL PROTECTION UPON THE COMPLETION OF CONSTRUCTION.
 - CONTRACTOR IS REQUIRED TO RETAIN ALL RECORDS FOR A PERIOD OF NO LESS THAN 3 YEARS FOLLOWING THE NOTICE OF TERMINATION.
- IT IS THE CONTRACTOR'S RESPONSIBILITY TO SUBMIT THE N10 TO FDEP NO LESS THAN 48 HOURS PRIOR TO THE START OF CONSTRUCTION. CONTRACTOR SHALL BE RESPONSIBLE FOR PROVIDING PROOF OF MAIL TO THE PROJECT ADMINISTRATOR.
- STABILIZED CONSTRUCTION ENTRANCES AND CONSTRUCTION ROADS, IF APPROPRIATE, SHALL BE IMPLEMENTED IN ORDER TO REDUCE OFFSITE TRACKING.
- LOADED HAIL TRUCKS SHALL BE COVERED WITH TARPULIN. EXCESS DIRT ON THE ROAD SHALL BE REMOVED DAILY.
- IF CONTAMINATED SOIL OR GROUNDWATER IS ENCOUNTERED DURING CONSTRUCTION, THE CONTRACTOR IS TO CEASE OPERATIONS IN THAT AREA. THE CONTRACTOR SHALL CONTACT THE ENGINEER OF RECORD IMMEDIATELY WHO WILL NOTIFY THE DISTRICT CONTAMINATION IMPACT COORDINATOR.








NOTICE TO GENERAL CONTRACTORS:

- BMPs (INCLUDING SILT FENCE INSTALLED IN PHASE 1) SHALL NOT BE REMOVED UNTIL FINAL STABILIZATION HAS BEEN ACHIEVED. CONTRACTOR SHALL REFERENCE THE SEQUENCE OF CONSTRUCTION.
- PRIOR TO CONSTRUCTION, GC MUST CLEARLY DELINEATE AND MARK OFF AREAS IDENTIFIED IN THE S1/P P.P. OR IN THE FIELD TO CLEARLY BE PROTECTED (SUCH AS NATURAL BUFFERS, TREES, HABITATS OF ENDANGERED/THREATENED SPECIES, HISTORIC PROPERTIES ETC.).

CERTIFICATION OF COMPLIANCE WITH FEDERAL, STATE AND LOCAL REGULATIONS

IN AN EFFORT TO ENSURE COMPLIANCE WITH FEDERAL, STATE, AND LOCAL LAWS REGARDING EROSION AND TURBIDITY CONTROLS, THE FOLLOWING PERMITS HAVE BEEN OBTAINED:

D.E.P. DREDGE/FILL PERMIT _____ N/A
 C.O.E. DREDGE/FILL PERMIT _____ N/A
 WATER MANAGEMENT PERMIT _____ XXXXXXXXX

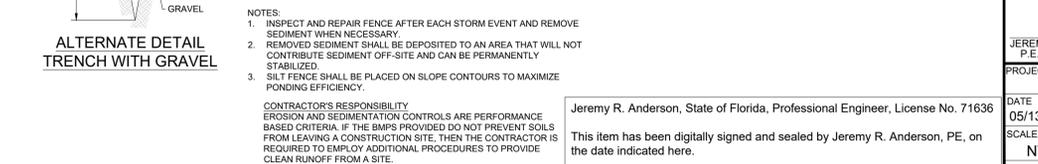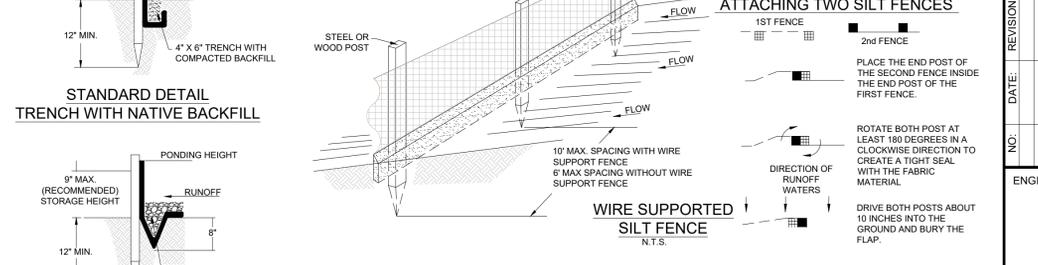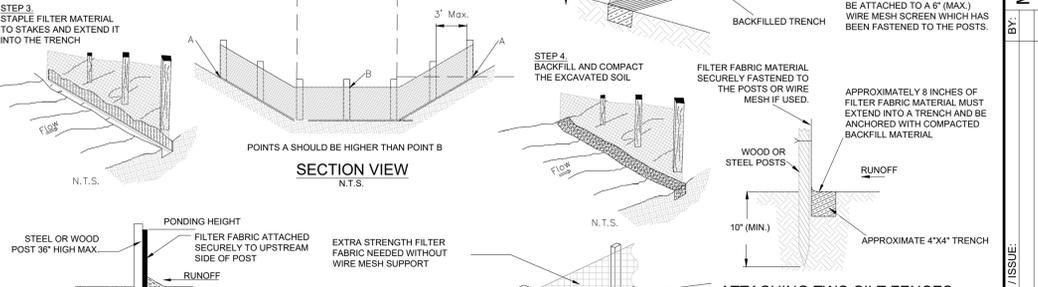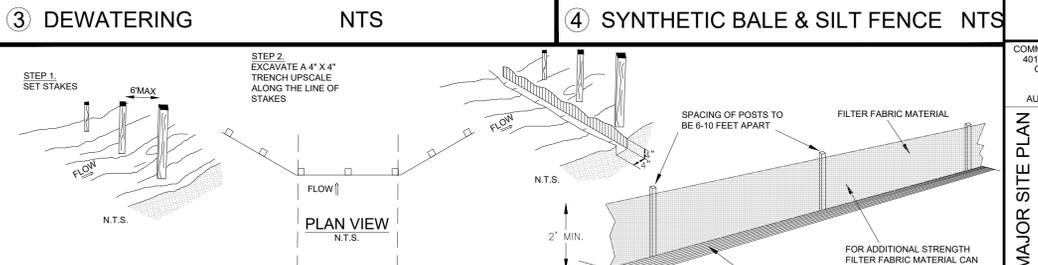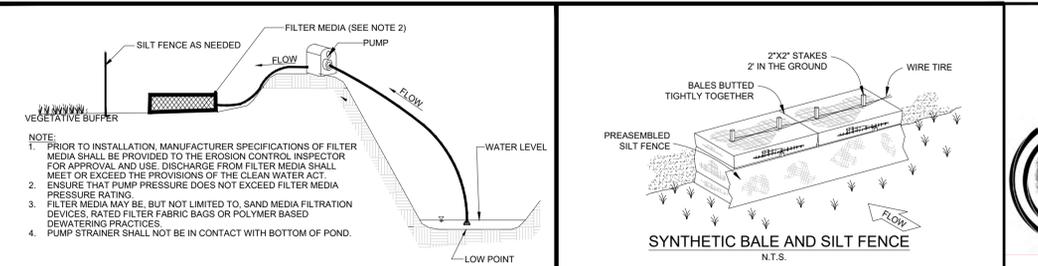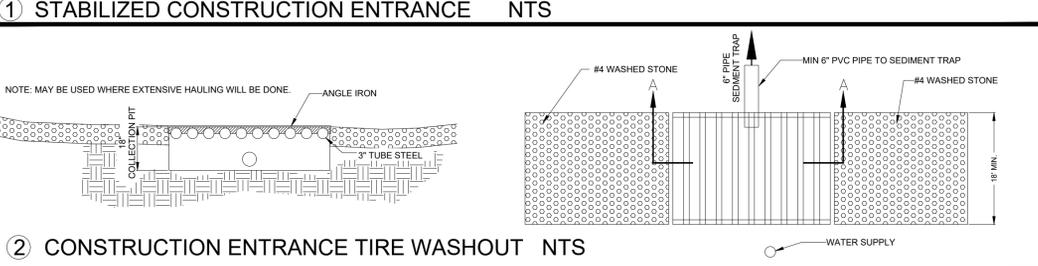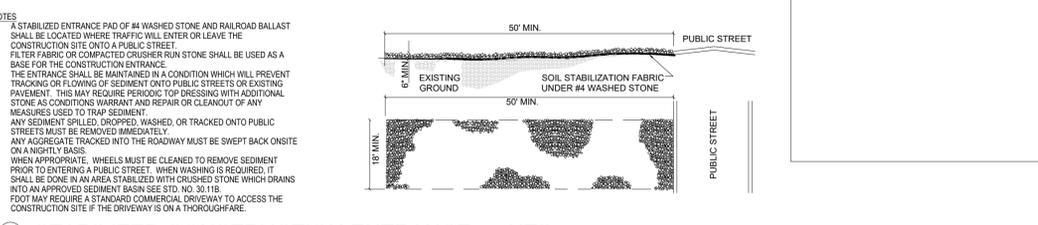

CONTRACTOR'S RESPONSIBILITY
 EROSION AND SEDIMENTATION CONTROLS ARE PERFORMANCE BASED CRITERIA. IF THE BMPs PROVIDED DO NOT PREVENT SOILS FROM LEAVING A CONSTRUCTION SITE, THEN THE CONTRACTOR IS REQUIRED TO EMPLOY ADDITIONAL PROCEDURES TO PROVIDE CLEAN RUNOFF FROM A SITE.

R.K.M. DEVELOPMENT CORP.



COMMON OAK ENGINEERING
 4016 EDGEWATER DRIVE
 ORLANDO, FL 32804
 (407) 951-5915
 CERTIFICATE OF AUTHORIZATION: 32644


MAJOR SITE PLAN
 7-ELEVEN
 AT SEC OF SE 92ND LP
 SE 58TH AVE
 BELLEVUE, FL
 MARION COUNTY

BY:	
DATE:	
NO.:	
REVISION/ISSUE:	
ENGINEER'S NAME & PE#	


JEREMY R. ANDERSON, P.E.
 P.E. LICENSE NO. 71636
 PROJECT #

222.108
 SHEET
 05/13/2024
 SCALE
 NTS
 C9.1
 EROSION CONTROL DETAILS


Jeremy R. Anderson, State of Florida, Professional Engineer, License No. 71636
 This item has been digitally signed and sealed by Jeremy R. Anderson, PE, on the date indicated here.
 Printed copies of this document are not considered signed and sealed and the signature must be verified on any electronic copies.

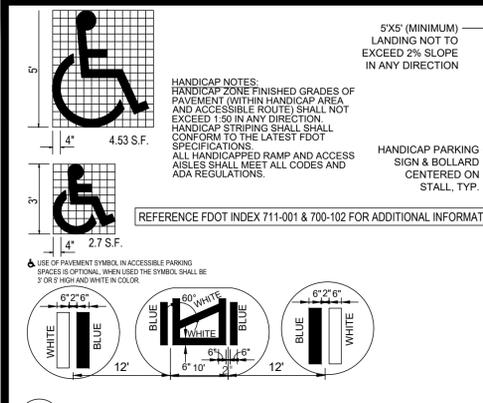


1 HANDICAP STRIPING AND BOLLARD NTS
 CONCRETE 28 DAY STRENGTH SHALL BE 3,000 PSI (MIN)

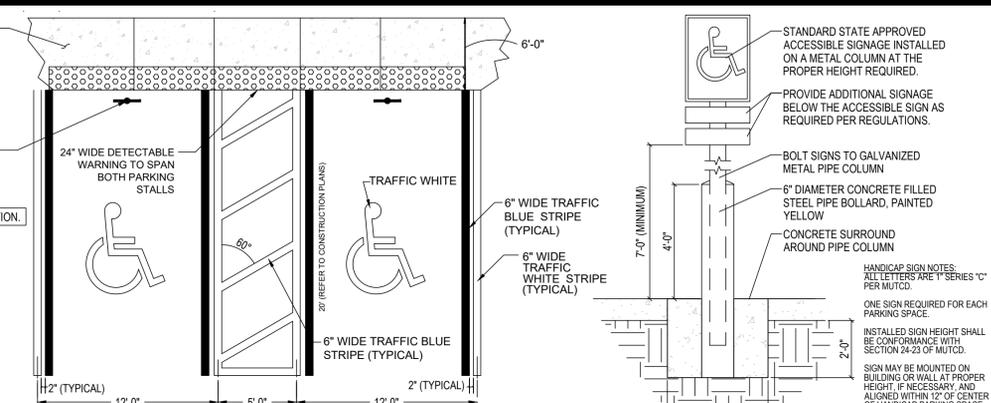


2 CONCRETE PAVING SECTION NTS

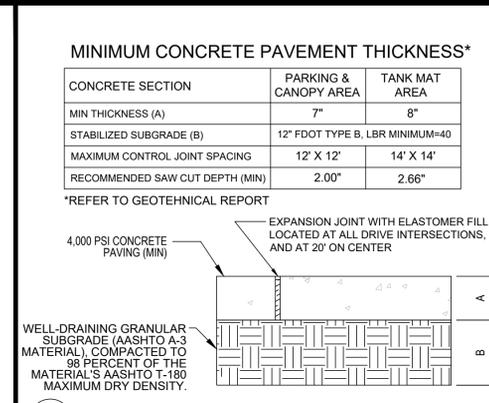


3 ON-SITE DIRECTIONAL ARROW NTS

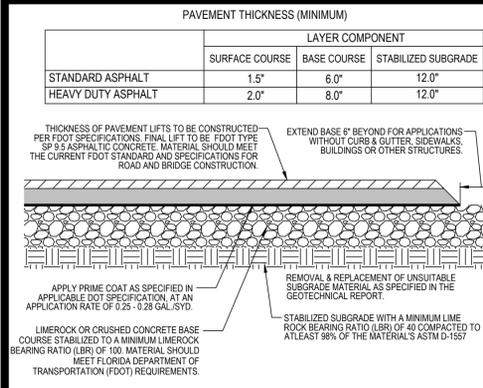


4 ASPHALT PAVING SECTION NTS
 (ON-SITE)

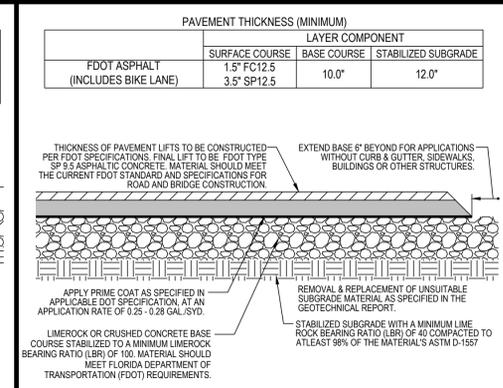


5 FDOT ASPHALT PAVING SECTION NTS
 (SR 35 RIGHT OF WAY)

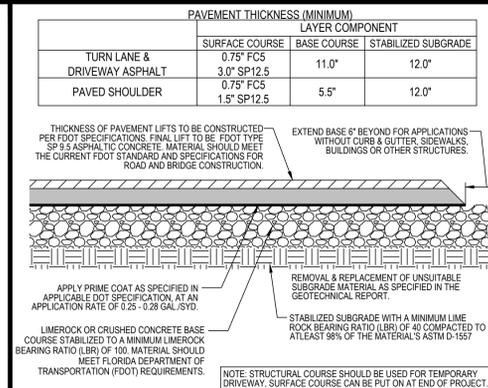


6 ASPHALT PAVING SECTION NTS
 (SE 92 LOOP RIGHT OF WAY)

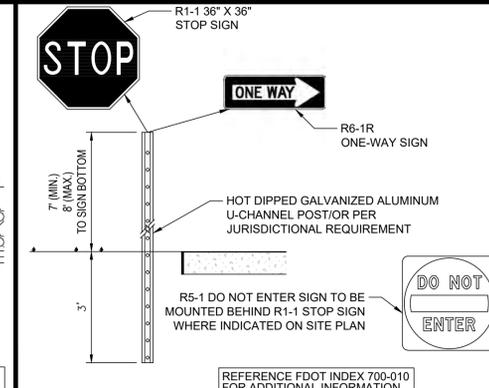


7 SIGNAGE/POST NTS

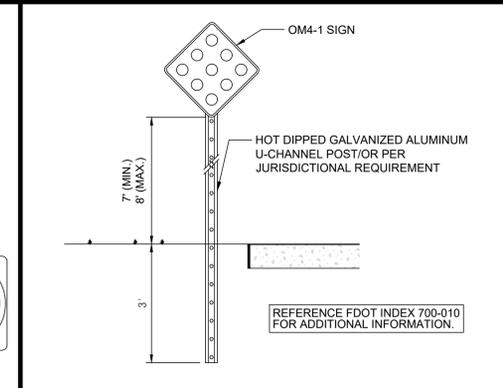


8 SITE SIGNAGE/POST NTS

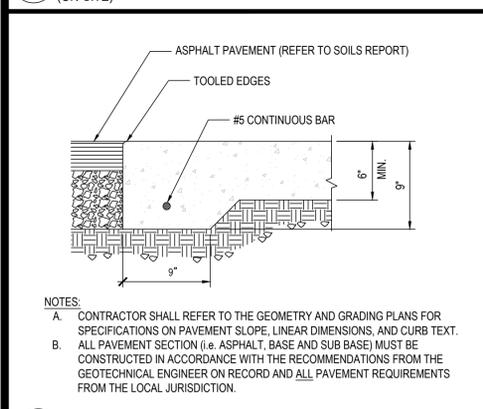


9 CONCRETE APRON NTS
 CONCRETE 28 DAY STRENGTH SHALL BE 4,000 PSI (MIN)

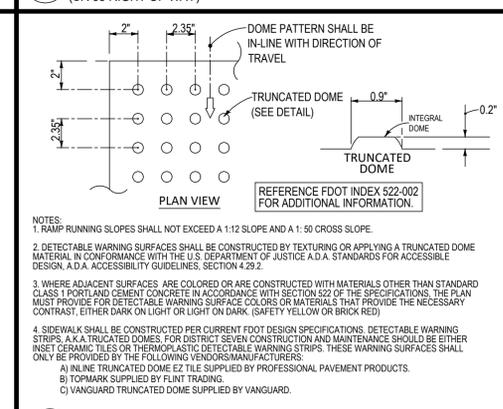


10 TRUNCATED DOME NTS

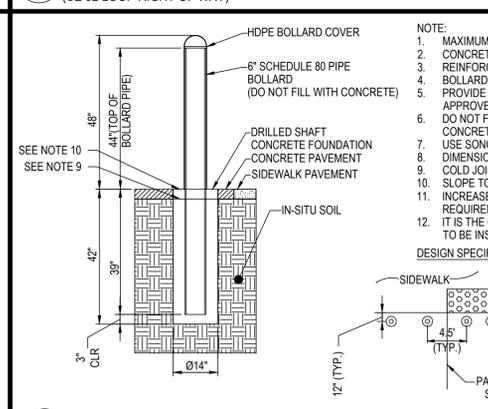


11 DEEP MOUNT BOLLARD NTS

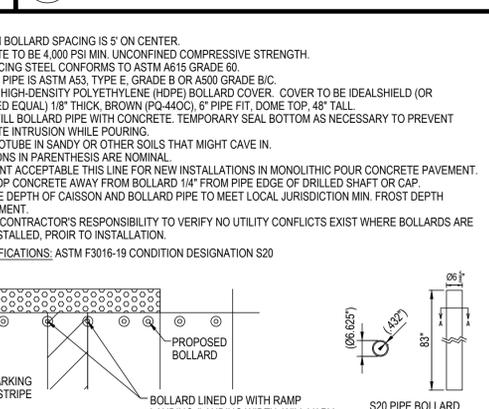


16 RIGHT TURN ONLY SIGN NTS

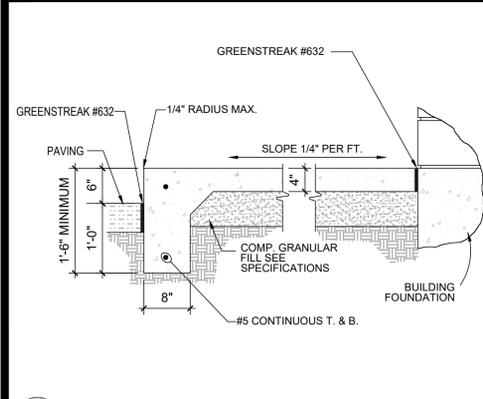


13 MONOLITHIC CURB & SIDEWALK NTS
 CONCRETE 28 DAY STRENGTH SHALL BE 3,000 PSI (MIN)

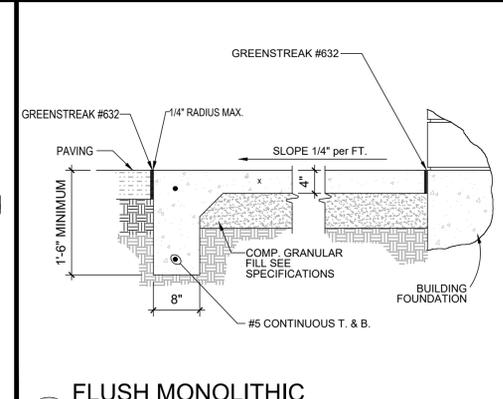


14 FLUSH MONOLITHIC CURB & SIDEWALK NTS
 CONCRETE 28 DAY STRENGTH SHALL BE 3,000 PSI (MIN)

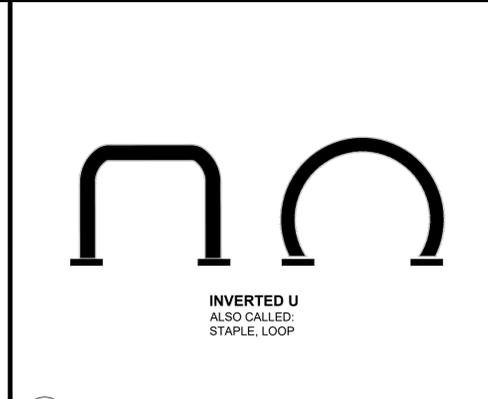

15 BIKE RACK NTS

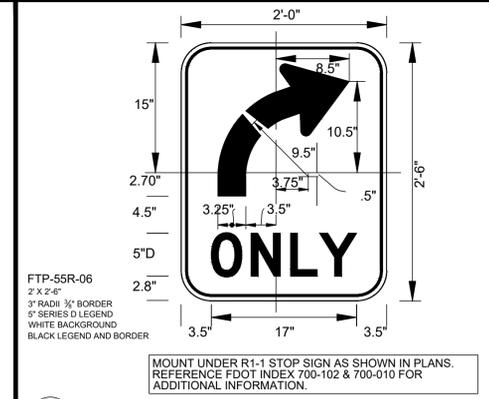

16 RIGHT TURN ONLY SIGN NTS

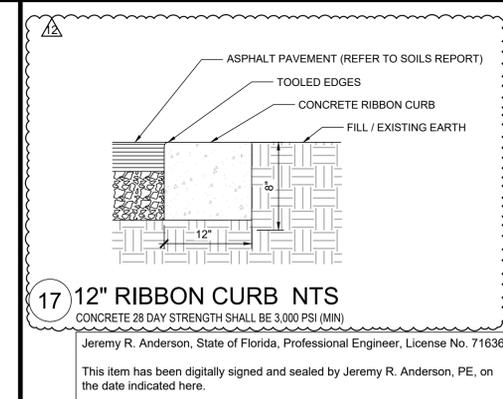

17 12" RIBBON CURB NTS
 CONCRETE 28 DAY STRENGTH SHALL BE 3,000 PSI (MIN)

R.K.M. DEVELOPMENT CORP.

COMMON OAK ENGINEERING

COMMON OAK ENGINEERING
 4016 EDGEWATER DRIVE
 ORLANDO, FL 32804
 (407) 951-5915
 CERTIFICATE OF AUTHORIZATION: 32644

MAJOR SITE PLAN
 7-ELEVEN
 AT SEC OF SE 92ND LP
 SE 58TH AVE
 BELLEVUE, FL
 MARION COUNTY

NO.	DATE	REVISION/ISSUE	BY	JR	JA	JR
1	12/05/2024	PILOT ACCESS COMMENTS	JR			
2	04/22/2024	PILOT ACCESS COMMENTS	JR			
12	04/22/2024	MARION COUNTY COMMENTS	JR			

ENGINEER'S NAME & PE#
 JEREMY R. ANDERSON, P.E.
 P.E. LICENSE NO. 71636

PROJECT #
 222.108

DATE
 05/13/2024

SHEET
 SCALE
 N.T.S.

SITE PLAN DETAILS

Printed copies of this document are not considered signed and sealed and the signature must be verified on any electronic copies.




COMMON OAK ENGINEERING
4016 EDGEWATER DRIVE
ORLANDO, FL 32804
(407) 951-5915
CERTIFICATE OF AUTHORIZATION: 32644

MAJOR SITE PLAN
7-ELEVEN
AT SEC OF SE 92ND LP
&
SE 58TH AVE
BELLEVUE, FL
MARION COUNTY


NO.	DATE	REVISION / ISSUE	DESCRIPTION
2	12/05/2024	FDOT ACCESS COMMENTS	

ENGINEER'S NAME & PE#	JEREMY R. ANDERSON, P.E. P.E. LICENSE NO. 71636
PROJECT #	222.108
DATE	05/13/2024
SHEET	1
SCALE	N.T.S.
FDOT DETAILS	


Jeremy R. Anderson, State of Florida, Professional Engineer, License No. 71636
This item has been digitally signed and sealed by Jeremy R. Anderson, PE, on the date indicated here.
Printed copies of this document are not considered signed and sealed and the signature must be verified on any electronic copies.

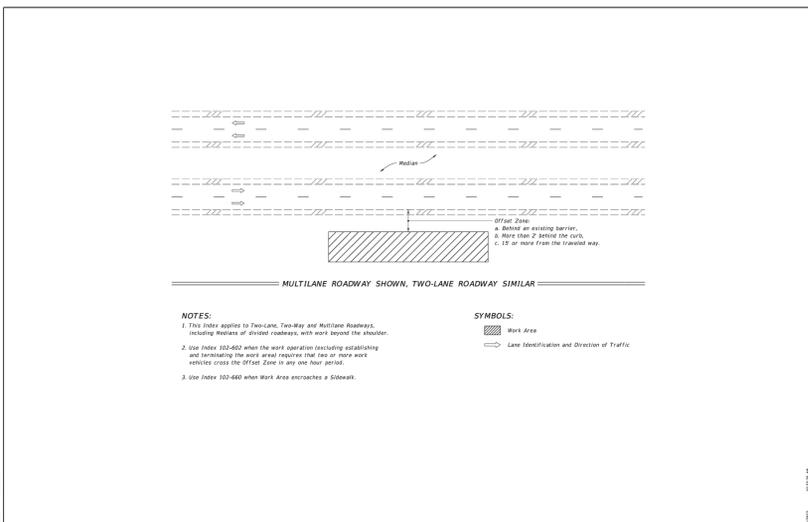


LAST REVISION	DESCRIPTION	FDOT	FY 2023-24 STANDARD PLANS	TWO-LANE AND MULTILANE ROADWAY, WORK BEYOND THE SHOULDER	INDEX	SHEET
11/01/20					102-601	1 of 1

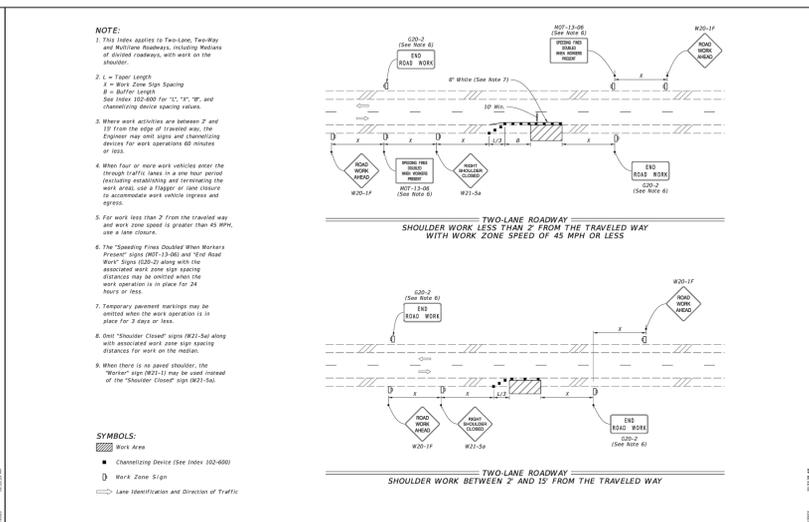


LAST REVISION	DESCRIPTION	FDOT	FY 2023-24 STANDARD PLANS	TWO-LANE AND MULTILANE, WORK ON SHOULDER	INDEX	SHEET
11/01/21					102-602	1 of 2

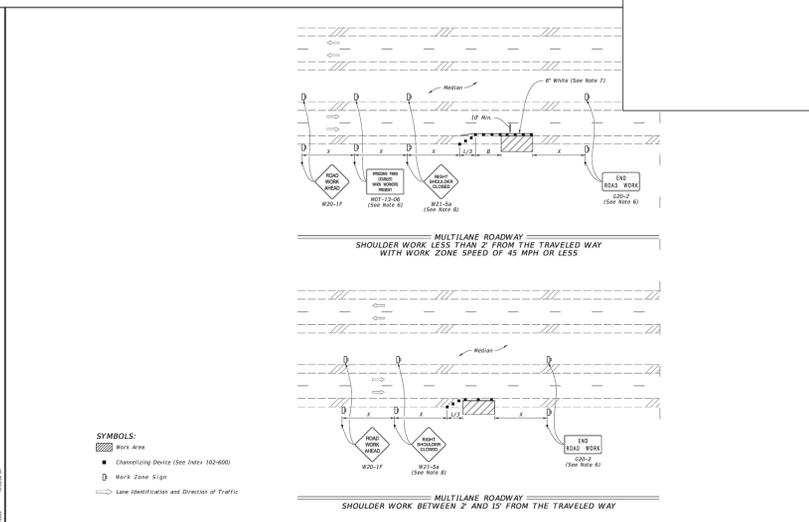


LAST REVISION	DESCRIPTION	FDOT	FY 2023-24 STANDARD PLANS	TWO-LANE AND MULTILANE, WORK ON SHOULDER	INDEX	SHEET
11/01/21					102-602	2 of 2

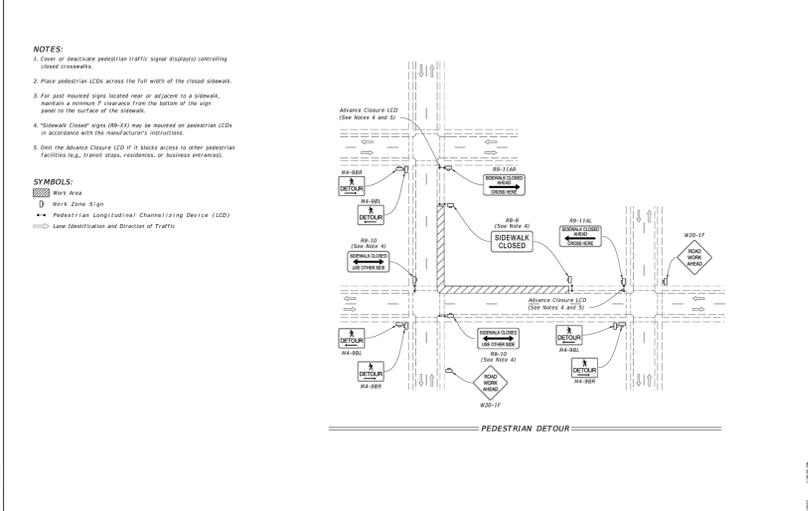


LAST REVISION	DESCRIPTION	FDOT	FY 2023-24 STANDARD PLANS	SIDEWALK CLOSURE	INDEX	SHEET
11/01/20					102-660	1 of 2

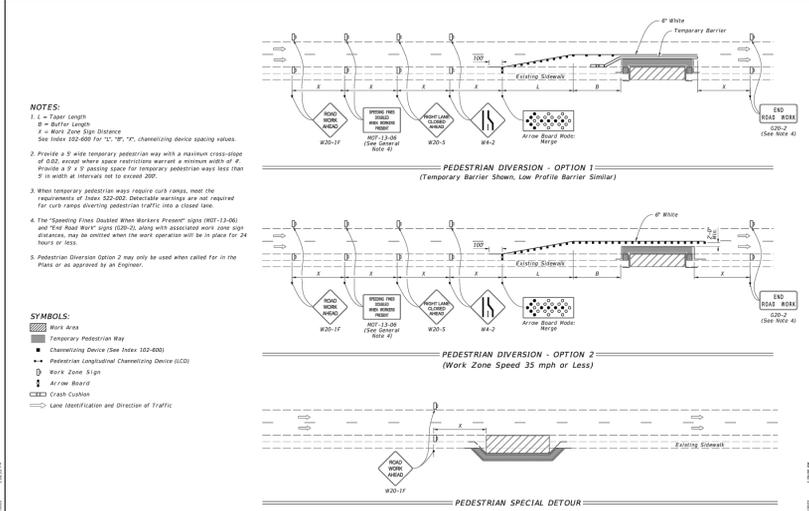

LAST REVISION	DESCRIPTION	FDOT	FY 2023-24 STANDARD PLANS	SIDEWALK CLOSURE	INDEX	SHEET
11/01/21					102-660	2 of 2

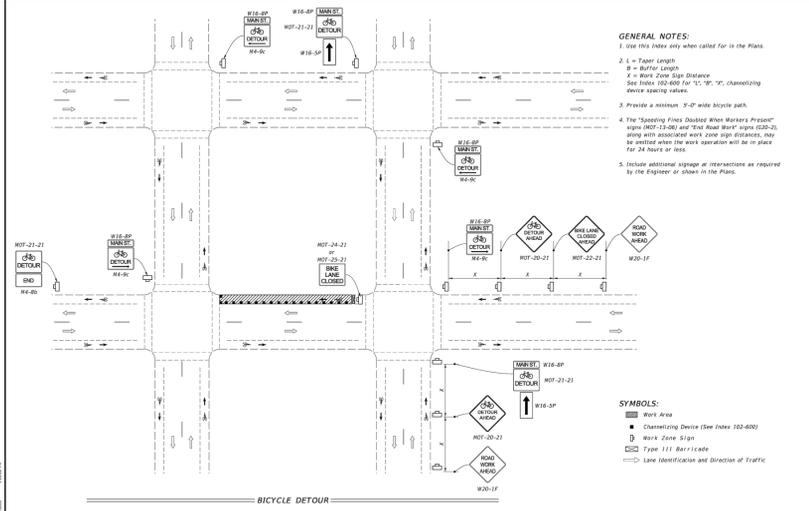


LAST REVISION	DESCRIPTION	FDOT	FY 2023-24 STANDARD PLANS	BICYCLE FACILITY CLOSURES	INDEX	SHEET
11/01/21					102-661	1 of 2

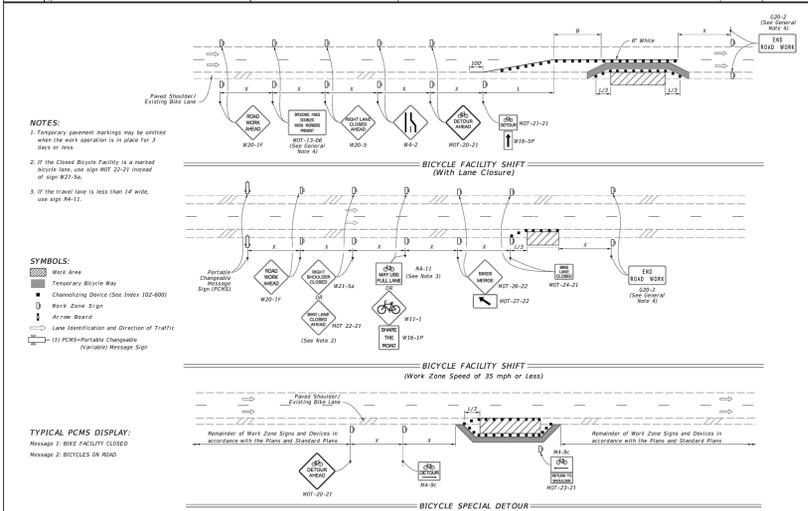


LAST REVISION	DESCRIPTION	FDOT	FY 2023-24 STANDARD PLANS	BICYCLE FACILITY CLOSURES	INDEX	SHEET
11/01/21					102-661	2 of 2


ENGINEER'S NAME & PE#	JEREMY R. ANDERSON, P.E. P.E. LICENSE NO. 71636
PROJECT #	222.108
DATE	05/13/2024
SHEET	1
SCALE	N.T.S.
FDOT DETAILS	

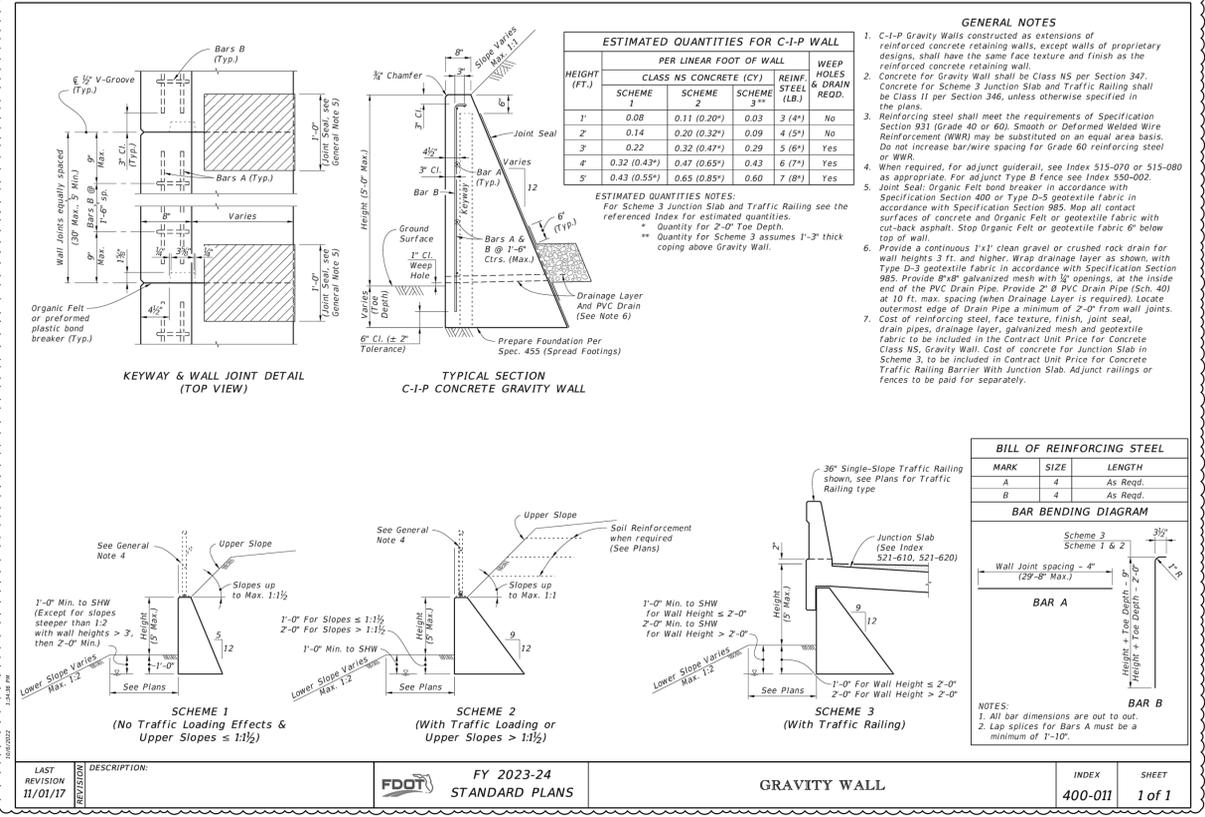


LAST REVISION: 11/01/17	DESCRIPTION: FY 2023-24 STANDARD PLANS	INDEX: 400-011	SHEET: 1 of 1
-------------------------	--	----------------	---------------

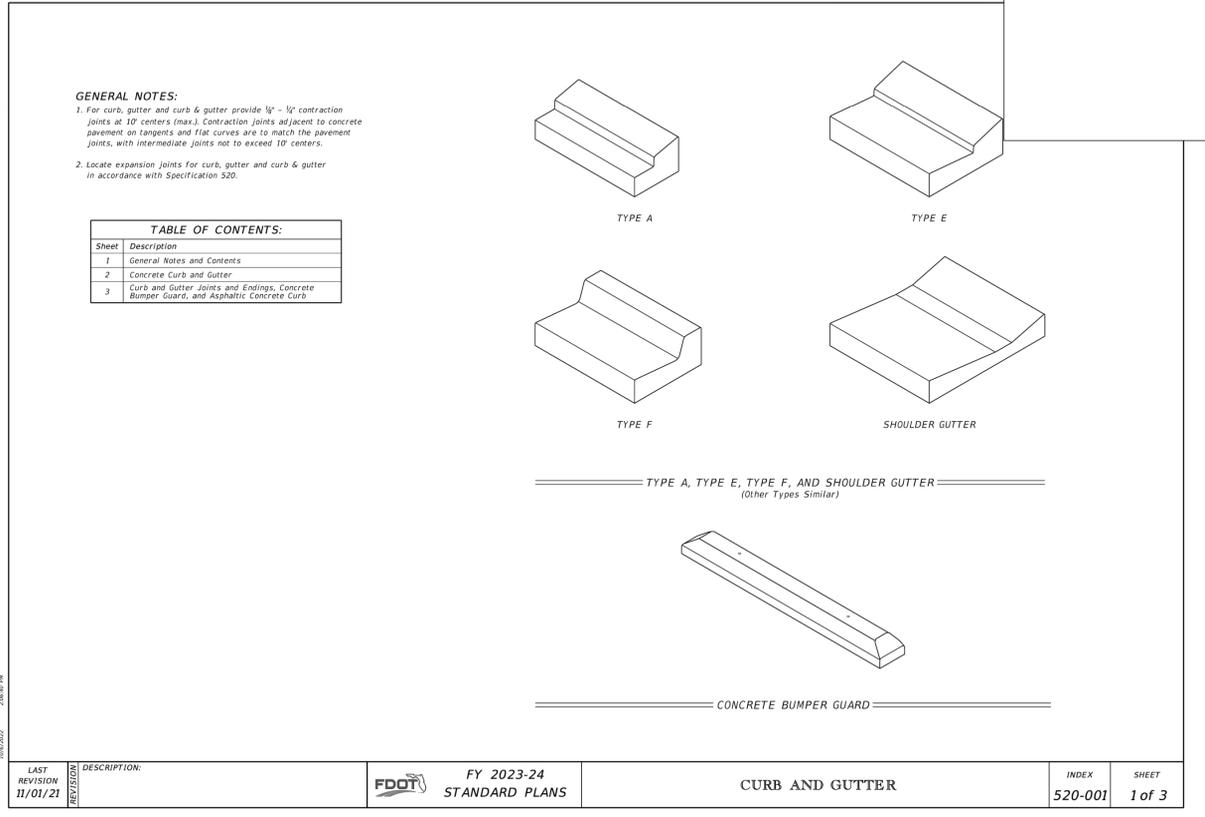

LAST REVISION: 11/01/21	DESCRIPTION: FY 2023-24 STANDARD PLANS	INDEX: 520-001	SHEET: 1 of 3
-------------------------	--	----------------	---------------

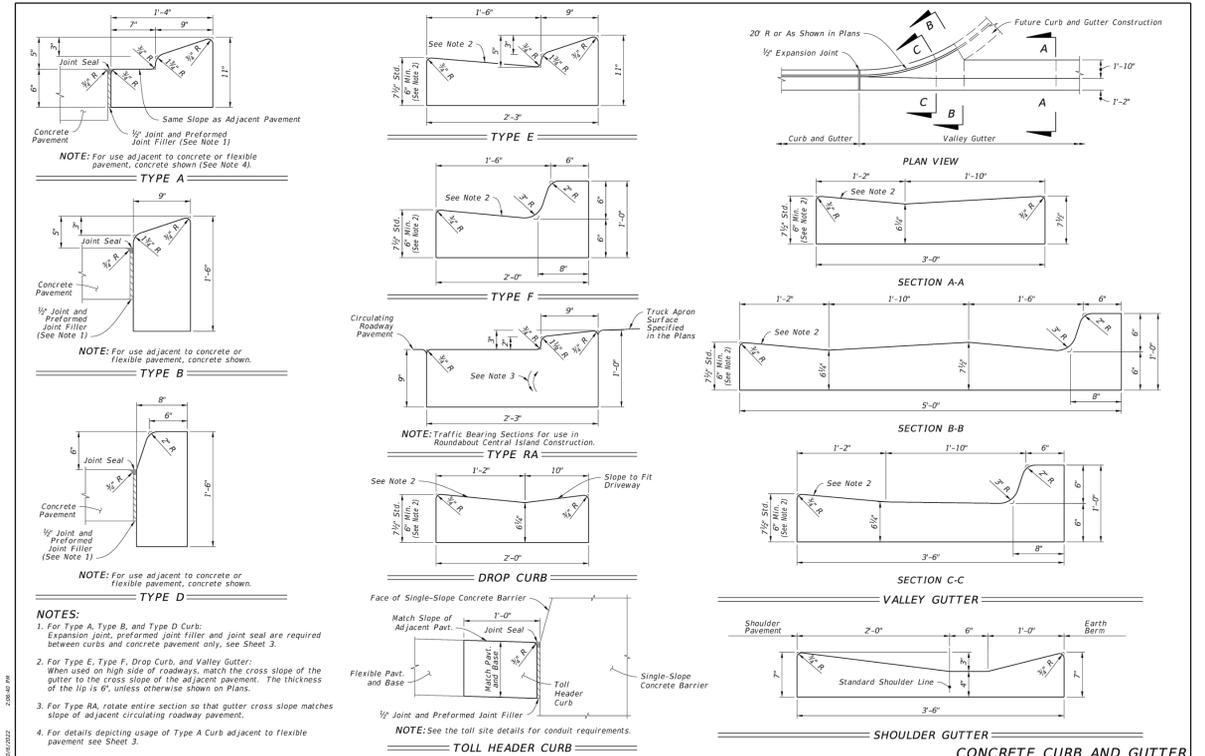

LAST REVISION: 11/01/21	DESCRIPTION: FY 2023-24 STANDARD PLANS	INDEX: 520-001	SHEET: 2 of 3
-------------------------	--	----------------	---------------

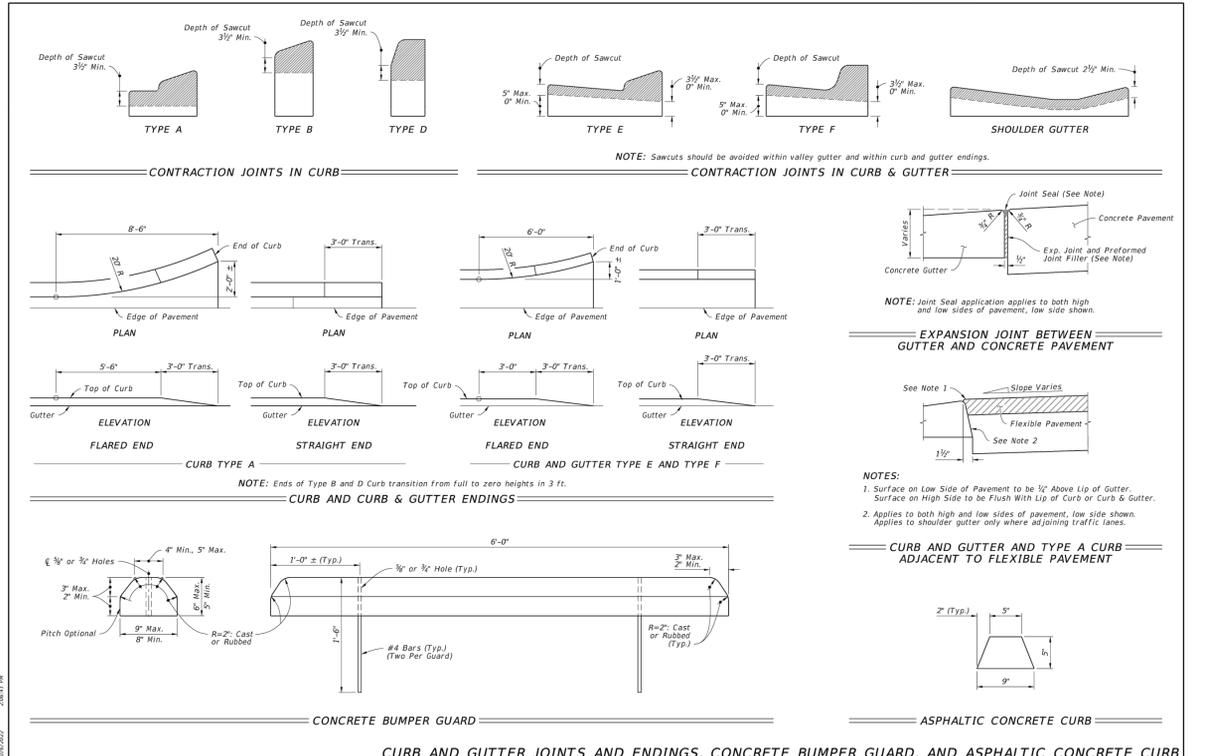

LAST REVISION: 11/01/21	DESCRIPTION: FY 2023-24 STANDARD PLANS	INDEX: 520-001	SHEET: 3 of 3
-------------------------	--	----------------	---------------

R.K.M. DEVELOPMENT CORP.

COMMON OAK ENGINEERING

COMMON OAK ENGINEERING
4016 EDGEWATER DRIVE
ORLANDO, FL 32804
(407) 951-5915
CERTIFICATE OF AUTHORIZATION: 32644

MAJOR SITE PLAN

7-ELEVEN
&
AT SEC OF SE 92ND LP
BELLEVUE, FL
MARION COUNTY

BY: JR

REVISION/ISSUE: MARION COUNTY COMMENTS

DATE: 04/22/2024

NO: 12

ENGINEER'S NAME & PE#

JEREMY R. ANDERSON, P.E.
P.E. LICENSE NO. 71636

PROJECT # **222.108**

DATE SHEET: 05/13/2024

SCALE: N.T.S.


D1.2

FDOT DETAILS


Jeremy R. Anderson, State of Florida, Professional Engineer, License No. 71636

This item has been digitally signed and sealed by Jeremy R. Anderson, PE, on the date indicated here.


Printed copies of this document are not considered signed and sealed and the signature must be verified on any electronic copies.

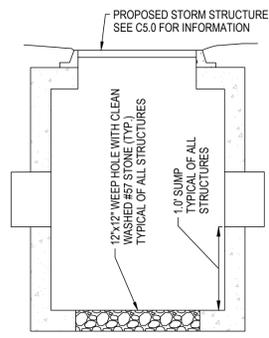


1 STORM STRUCTURE WEEP HOLE NTS

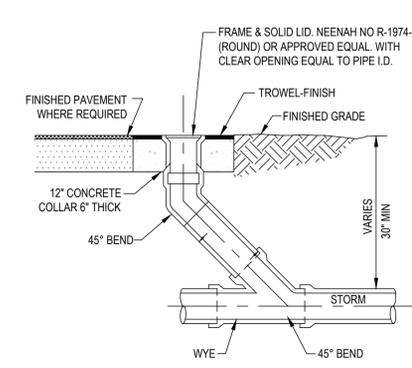


2 CLEANOUT NTS

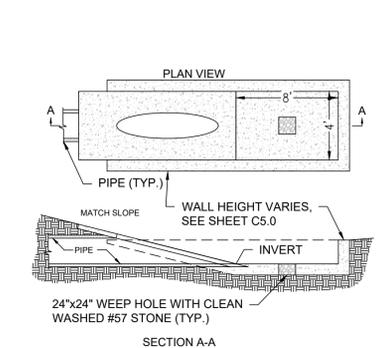


3 MITERED END SECTION SUMP NTS

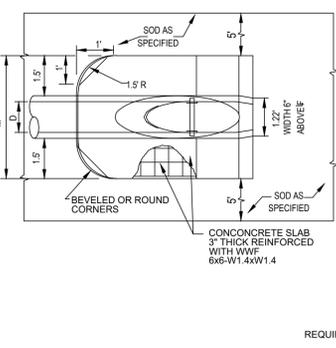


4 MITERED END SECTION NTS

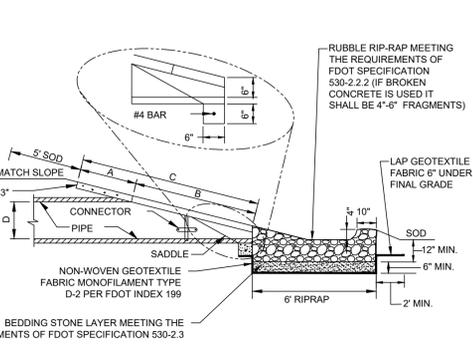


5 CONTROL STRUCTURE NO. 1 NTS

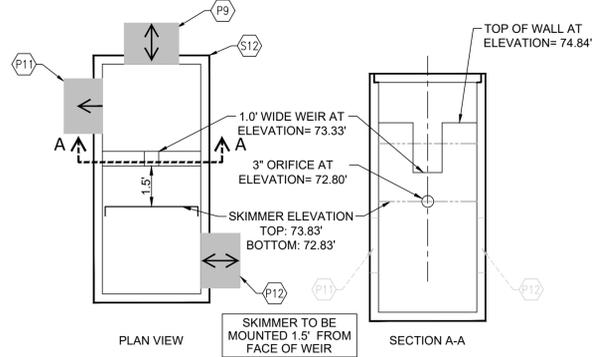


6 CONTROL STRUCTURE NO. 2 NTS

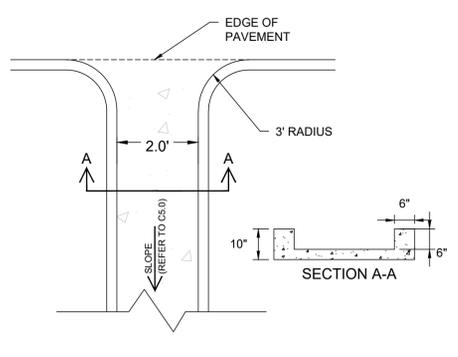


7 CONCRETE FLUME NTS
CONCRETE 28 DAY STRENGTH SHALL BE 3,000 PSI (MIN)

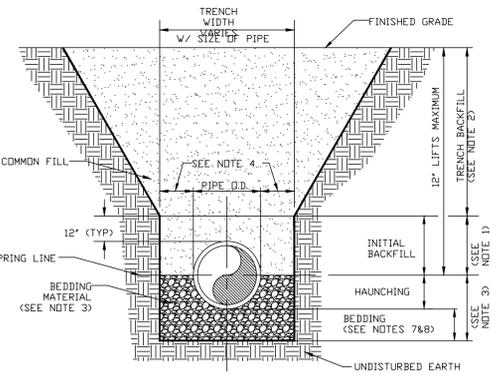


- NOTES:
- INITIAL BACKFILL: COMMON FILL COMPACTED TO 95% (98% UNDER PAVEMENT) OF THE MAXIMUM DENSITY AS PER AASHTO T-100.
 - TRENCH BACKFILL: COMMON FILL COMPACTED TO 95% (98% UNDER PAVEMENT) OF THE MAXIMUM DENSITY AS PER AASHTO T-100.
 - BEDDING MATERIAL SHALL CONFORM TO FDOT NO. 57 AGGREGATE.
 - 15" MAX. (12" MIN) FOR PIPE DIAMETER LESS THAN 24" AND 24" MAX (12" MIN) FOR PIPE DIAMETER 24" AND LARGER.
 - WATER SHALL NOT BE PERMITTED IN THE TRENCH DURING CONSTRUCTION.
 - ALL PIPE TO BE INSTALLED WITH BELL FACING UPSTREAM TO THE DIRECTION OF THE FLOW.
 - BEDDING DEPTH SHALL BE 4" MINIMUM FOR PIPE DIAMETER UP TO 12" AND 6" MINIMUM FOR PIPE DIAMETER 16" AND LARGER.
 - DEPTH FOR REMOVAL OF UNSUITABLE MATERIAL SHALL GOVERN DEPTH OF BEDDING ROCK BELOW THE PIPE. UTILITIES SHALL DETERMINE IN THE FIELD REQUIRED REMOVAL OF UNSUITABLE MATERIAL TO REACH SUITABLE FOUNDATION.
 - FINAL RESTORATION IN IMPROVED AREAS SHALL BE IN COMPLIANCE WITH ALL APPLICABLE REGULATIONS OF GOVERNING AGENCIES. SURFACE RESTORATION WITHIN MARION COUNTY RIGHT-OF-WAY SHALL COMPLY WITH REQUIREMENTS OF RIGHT-OF-WAY UTILIZATION REGULATIONS AND ROAD CONSTRUCTION SPECIFICATIONS.
 - ONE COMPACTION TEST SHALL BE REQUIRED FOR EACH LIFT NOT TO EXCEED 200'.

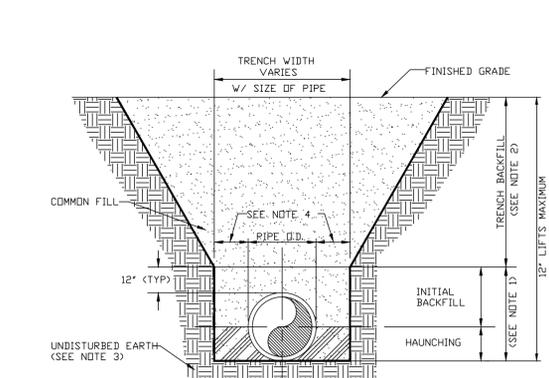

- NOTES:
- INITIAL BACKFILL AND HAUNCHING: SELECT COMMON FILL COMPACTED TO 95% (98% UNDER PAVEMENT) OF THE MAXIMUM DENSITY AS PER AASHTO T-100.
 - TRENCH BACKFILL: COMMON FILL COMPACTED TO 95% (98% UNDER PAVEMENT) OF THE MAXIMUM DENSITY AS PER AASHTO T-100.
 - PIPE BEDDING UTILIZING SELECT COMMON FILL OR BEDDING ROCK IN ACCORDANCE WITH BEDDING AND TRENCHING 1 DETAIL MAY BE REQUIRED AS DIRECTED BY MCL.
 - 15" MAX. (12" MIN) FOR PIPE DIAMETER LESS THAN 24" AND 24" MAX (12" MIN) FOR PIPE DIAMETER 24" AND LARGER.
 - WATER SHALL NOT BE PERMITTED IN THE TRENCH DURING CONSTRUCTION.
 - ALL PIPE TO BE INSTALLED WITH BELL FACING UPSTREAM TO THE DIRECTION OF THE FLOW.
 - FINAL RESTORATION IN IMPROVED AREAS SHALL BE IN COMPLIANCE WITH ALL APPLICABLE REGULATIONS OF GOVERNING AGENCIES. SURFACE RESTORATION WITHIN MARION COUNTY RIGHT-OF-WAY SHALL COMPLY WITH REQUIREMENTS OF RIGHT-OF-WAY UTILIZATION REGULATIONS AND ROAD CONSTRUCTION SPECIFICATIONS.
 - ONE COMPACTION TEST SHALL BE REQUIRED FOR EACH LIFT NOT TO EXCEED 200'.

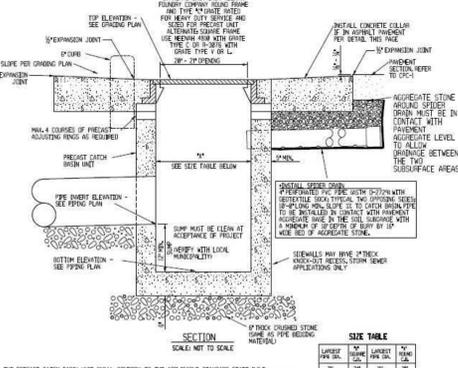

B STANDARD DUTY CATCH BASIN
TO BE USED IN NORMAL STRENGTH PAVEMENT AREAS ONLY

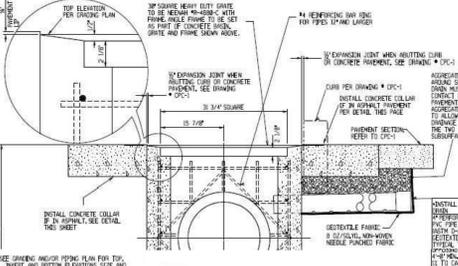

C HEAVY DUTY CATCH BASIN
FOR OUTLETS UP TO 18\"/>



1. CORE A HOLE PERPENDICULAR TO THE HOST PIPE USING THE RECOMMENDED HOLE SAW. REMOVE THE COUPON FROM THE SAW. DEBURR THE CORED HOLE.



3. INSERT THE RUBBER SLEEVES INTO THE CORED HOLE, WITH THE GOLD LINES PERPENDICULAR TO THE PIPE. ONCE IN PLACE, PULL UP ON THE INNER SLEEVE AND PUSH DOWN ON THE OUTER SLEEVE UNTIL FITTED TO THE HOSE PIPE.



5. DRIVE THE PLASTIC HUB INTO THE RUBBER SLEEVES WITH A 4 LB. Mallet and Block of Wood. STOP WHEN THE RUBBER SLEEVE MEETS THE RED LINE.

ADS INSERTA TEE OFFERS AIR-TIGHT RELIABILITY AND GROUND-BREAKING VERSATILITY THAT IS DESIGNED FOR VIRTUALLY ANY TYPE OF LATERAL CONNECTION INCLUDING: NYOPLAST STRUCTURES, PRECAST, MAN-HOLES AND VAULTS, STORMTECH CHAMBERS, ROOF DRAIN LEADERS, AGRICULTURAL DRAINAGE, TURF & RECREATION, RETENTION/DETENTION SYSTEMS, WATER QUALITY SYSTEMS


2. USE THE COUPON TO ESTIMATE THE SEPARATION BETWEEN THE TWO SLEEVES AND FIT THE TWO SLEEVES TOGETHER. BE SURE THE GOLD LINES ON THE SLEEVES ARE LINED UP.

4. APPLY SOAP SOLUTION TO INSIDE OF THE INNER SLEEVE AND ON THE PVC HUB. INSERT THE PVC HUB INTO THE SLEEVE BY HAND UNTIL SNUG FIT, ALIGNING THE RED LINE ON THE HUB WITH THE GOLD LINES ON THE RUBBER SLEEVES.


6. PLACE AND TIGHTEN THE STAINLESS-STEEL BAND.

8 ADS INSERTA-TEE DETAIL NTS

NOTE:
1. DETAILS B, C, F PROVIDED FOR CONCRETE COLLAR ONLY (DISREGARD PAVEMENT SPECIFICATIONS)

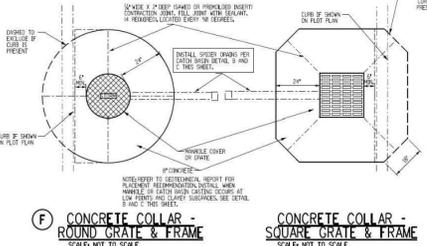

F CONCRETE COLLAR - ROUND GRATE & FRAME
SCALE: NOT TO SCALE

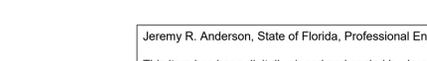

G CONCRETE COLLAR - SQUARE GRATE & FRAME
SCALE: NOT TO SCALE

		DIMENSIONS									
		D	A	B	C	E	F	G	H	M	
1:4 SLOPE	8"	1.5'	2.25'	3.75'	2.2'	4'	0.60'	1.8'	2.0'		
	12"	2.0'	3.10'	5.10'	3.0'	6'	1.00'	3.0'	3.0'		
	15"	2.27'	4.09'	6.36'	4.03'	8'	1.22'	4.0'	4.63'		
	18"	2.36'	5.12'	7.48'	5.03'	9'	1.41'	4.0'	4.92'		
	24"	2.53'	7.18'	9.71'	7.03'	11'	1.73'	4.0'	5.50'		
1:2 SLOPE	30"	2.70'	9.25'	11.95'	9.03'	13'	2.00'	4.0'	6.08'		
	24"	2.06'	3.85'	5.91'	3.56'	7'	1.73'	3.4'	5.50'		

REFERENCE FDOT INDEX 430-022 FOR ADDITIONAL INFORMATION.

9 CONCRETE COLLAR NTS

Jeremy R. Anderson, State of Florida, Professional Engineer, License No. 71636
This item has been digitally signed and sealed by Jeremy R. Anderson, PE, on the date indicated here.
Printed copies of this document are not considered signed and sealed and the signature must be verified on any electronic copies.

R.K.M. DEVELOPMENT CORP.

COMMON OAK ENGINEERING

COMMON OAK ENGINEERING
4016 EDGEWATER DRIVE
ORLANDO, FL 32804
(407) 951-5915
CERTIFICATE OF AUTHORIZATION: 32644

MAJOR SITE PLAN
7-ELEVEN
&
AT SEC OF SE 92ND LP
SE 58TH AVE
BELLEVUE, FL
MARION COUNTY

NO.	DATE	REVISION / ISSUE	BY	FOR
1	12/07/2024	CITY OF BELLEVUE UTILITY COMMENTS	JR	JR
2	12/10/2024	CITY OF BELLEVUE UTILITY COMMENTS	JR	JR
3	03/18/2024	FEEDBACK COMMENTS	JR	JR
4	04/08/2024	FEEDBACK COMMENTS	JR	JR



ENGINEER'S NAME & PE#
JEREMY R. ANDERSON, P.E.
P.E. LICENSE NO. 71636

PROJECT # 222.108

DATE 05/13/2024
SCALE N.T.S.
SHEET D2.0
GRADING DETAILS


Frame Type	2'-0" OPENING			3'-0" OPENING		
	Frame	Frame Cover (Std.)	Frame	Frame	Frame Cover (Std.)	Frame
I	155	190	220	190	220	410
II	145	190	255	190	220	410
III	90	190	190	190	220	410

NOTE:
Frame Type I in Table 1, includes Adjustable frames.

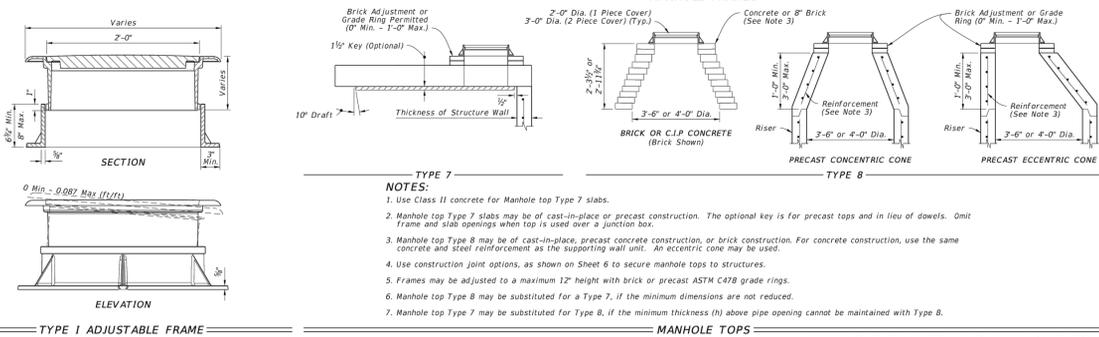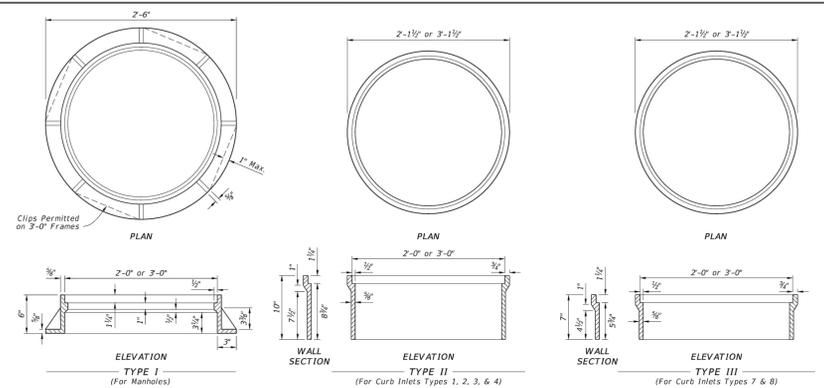

- NOTES:**
- Use Class II concrete for Manhole top Type 7 slabs.
 - Manhole top Type 7 slabs may be of cast-in-place or precast construction. The optional key is for precast tops and in lieu of dowels. Omit frame and slab openings when top is used over a junction box.
 - Manhole top Type 8 may be of cast-in-place, precast concrete construction, or brick construction. For concrete construction, use the same concrete and steel reinforcement as the supporting wall unit. An eccentric cone may be used.
 - Use construction joint options, as shown on Sheet 6 to secure manhole tops to structures.
 - Frames may be adjusted to a maximum 12" height with brick or precast ASTM C478 grade rings.
 - Manhole top Type 8 may be substituted for a Type 7, if the minimum thickness (h) above pipe opening cannot be maintained with Type 8.
 - Manhole top Type 7 may be substituted for Type 8, if the minimum thickness (h) above pipe opening cannot be maintained with Type 8.

LAST REVISION 11/01/20	DESCRIPTION: FY 2023-24 STANDARD PLANS	INDEX 425-001	SHEET 2 of 8
---------------------------	--	------------------	-----------------

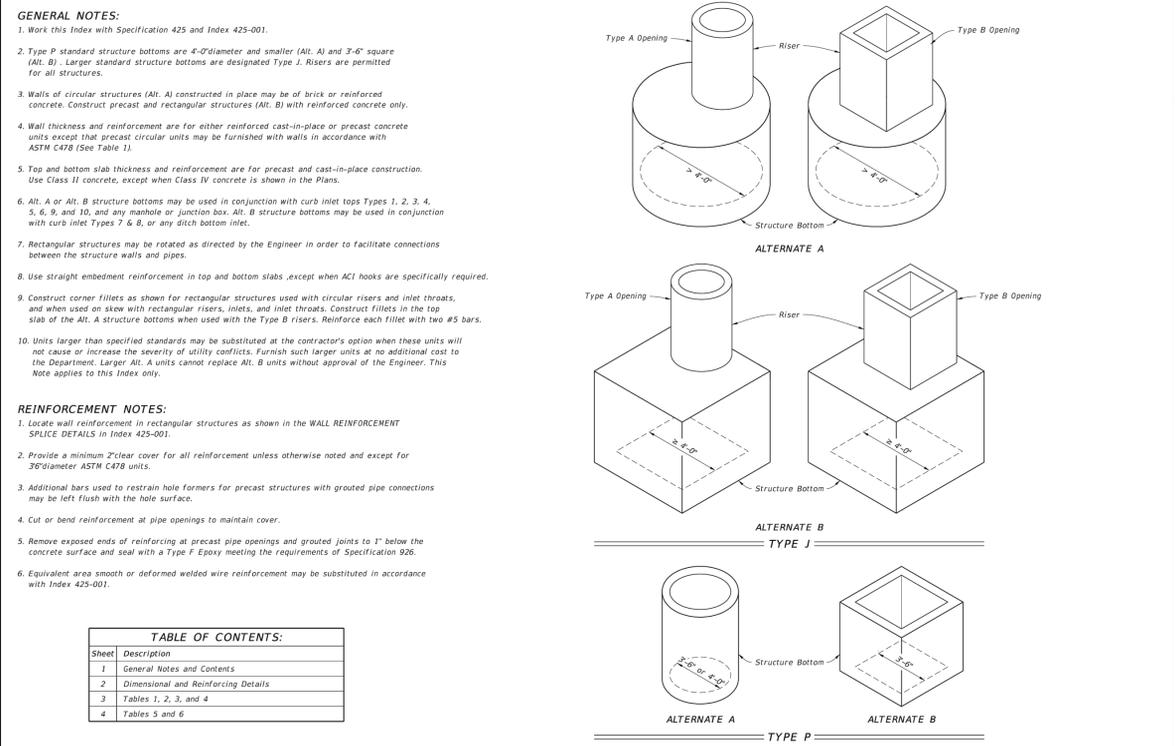

- GENERAL NOTES:**
- Work this Index with Specification 425 and Index 425-001.
 - Type P standard structure bottoms are 4'-0" diameter and smaller (Alt. A) and 3'-6" square (Alt. B). Larger standard structure bottoms are designated Type J. Risers are permitted for all structures.
 - Walls of circular structures (Alt. A) constructed in place may be of brick or reinforced concrete. Construct precast and rectangular structures (Alt. B) with reinforced concrete only. Construct precast and rectangular structures (Alt. B) with reinforced concrete only.
 - Wall thickness and reinforcement are for either reinforced cast-in-place or precast concrete units except that precast circular units may be furnished with walls in accordance with ASTM C478 (See Table 1).
 - Top and bottom slab thickness and reinforcement are for precast and cast-in-place construction. Use Class II concrete, except when Class IV concrete is shown in the Plans.
 - Alt. A or Alt. B structure bottoms may be used in conjunction with curb inlet tops Types 1, 2, 3, 4, 5, 6, 9, and 10, and any manhole or junction box. Alt. B structure bottoms may be used in conjunction with curb inlet Types 7 & 8, or any ditch bottom inlet.
 - Rectangular structures may be rotated as directed by the Engineer in order to facilitate connections between the structure walls and pipes.
 - Use straight embedment reinforcement in top and bottom slabs, except when ACI hooks are specifically required.
 - Construct corner fillets as shown for rectangular structures used with circular risers and inlet throats, and when used on skew with rectangular risers, inlets, and inlet throats. Construct fillets in the top slab of the Alt. A structure bottoms when used with the Type B risers. Reinforce each fillet with two #5 bars.
 - Units larger than specified standards may be substituted at the contractor's option when these units will not cause or increase the severity of utility conflicts. Furnish such larger units at no additional cost to the Department. Larger Alt. A units cannot replace Alt. B units without approval of the Engineer. This Note applies to this Index only.



- REINFORCEMENT NOTES:**
- Locate wall reinforcement in rectangular structures as shown in the WALL REINFORCEMENT SPLICE DETAILS in Index 425-001.
 - Provide a minimum 2" clear cover for all reinforcement unless otherwise noted and except for 30" diameter ASTM C478 units.
 - Additional bars used to restrain hole formers for precast structures with grouted pipe connections may be left flush with the hole surface.
 - Cut or bend reinforcement at pipe openings to maintain cover.
 - Remove exposed ends of reinforcing at precast pipe openings and grouted joints to 1" below the concrete surface and seal with a Type F Epoxy meeting the requirements of Specification 926.
 - Equivalent area smooth or deformed welded wire reinforcement may be substituted in accordance with Index 425-001.

Sheet	Description
1	General Notes and Contents
2	Dimensional and Reinforcing Details
3	Tables 1, 2, 3, and 4
4	Tables 5 and 6


LAST REVISION 11/01/20	DESCRIPTION: FY 2023-24 STANDARD PLANS	INDEX 425-010	SHEET 1 of 4
---------------------------	--	------------------	-----------------

- GENERAL NOTES:**
- Use a 1-piece cover, unless the 2-piece cover is called for in the Plans, except at inlets and manholes with sump bottoms. Use the 2-piece cover when the sump depth exceeds 2', unless otherwise noted.
 - Include "Adjustable" on the cover for Type I manhole adjustable frames.
 - For square or rectangular precast drainage structures, use either deformed or smooth WWR meeting the requirements of Specification 931. WWR must be continuous around the box and lapped in accordance with Option 1 or 3 as shown in the Wall Reinforcing Splice Details.
 - Lap splice horizontal steel in the walls of rectangular structures in accordance with Option 1, 2 or 3 as shown in the Wall Reinforcing Splice Details.
 - Welding of splices and laps is permitted. Use AASHTO M259 requirements and restrictions on welds.
 - Rebar straight end embedment of peripheral reinforcement may be used in lieu of ACI standard hooks for top and bottom slabs, except when hooks are specifically called for in the Plans.
 - Precast opening for pipe must be the pipe OD plus 4" (± 2" tolerance). Use mortar to seal the pipe into the opening of a mix that shrinkage will not cause leakage into or out of the structure. Dry-pack mortar may be used to seal openings less than 2 1/2" wide.

Sheet	Description
1	General Notes, Contents, Manhole Top Overview, and Manhole Covers
2	Manhole Frames and Manhole Tops
3	Inlet Locking Grates, Subgrade and Base Temporary Drains, and Pipe to Structure Filter Fabric Wrap
4	Drainage Structure Invert, Sump Bottom, Wall Reinforcing Splice Details, and Typical Slab to Wall Details
5	Precast Option and Equivalent Reinforcement substitution
6	Construction Joints and Minimum Box Riser Segment Dimensions
7	Skewed Pipe in Rectangular Structures
8	Miscellaneous Pipe Connection Details

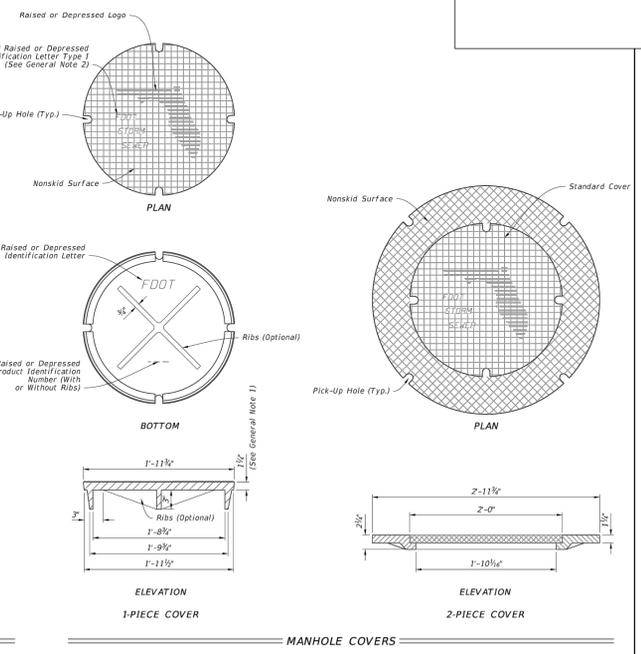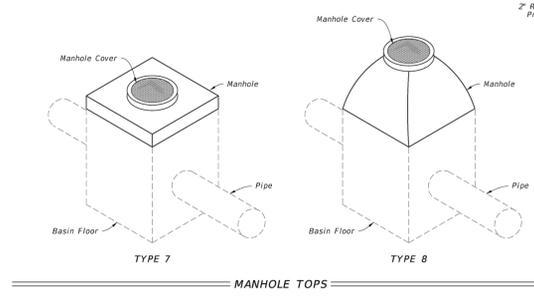

LAST REVISION 11/01/20	DESCRIPTION: FY 2023-24 STANDARD PLANS	INDEX 425-001	SHEET 1 of 8
---------------------------	--	------------------	-----------------

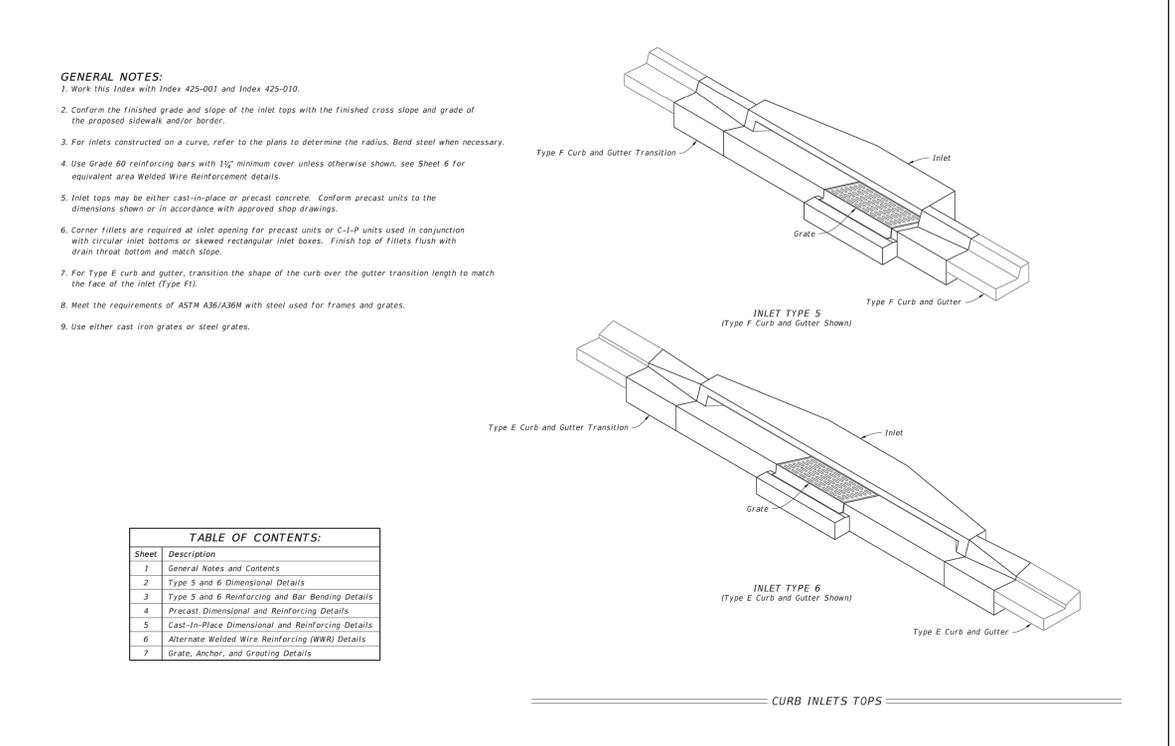

- GENERAL NOTES:**
- Work this Index with Index 425-001 and Index 425-010.
 - Conform the finished grade and slope of the inlet tops with the finished cross slope and grade of the proposed sidewalk and/or border.
 - For inlets constructed on a curve, refer to the plans to determine the radius. Bend steel when necessary.
 - Use Grade 60 reinforcing bars with 1 1/2" minimum cover unless otherwise shown. See Sheet 6 for equivalent area Welded Wire Reinforcement details.
 - Inlet tops may be either cast-in-place or precast concrete. Conform precast units to the dimensions shown or in accordance with approved shop drawings.
 - Corner fillets are required at inlet opening for precast units or C-I-P units used in conjunction with circular inlet bottoms or skewed rectangular inlet boxes. Finish top of fillets flush with drain throat bottom and match slope.
 - For Type E curb and gutter, transition the shape of the curb over the gutter transition length to match the face of the inlet (Type F1).
 - Meet the requirements of ASTM A36/AS6M with steel used for frames and grates.
 - Use either cast iron grates or steel grates.

Sheet	Description
1	General Notes and Contents
2	Type 5 and 6 Dimensional Details
3	Type 5 and 6 Reinforcing and Bar Bending Details
4	Precast Dimensional and Reinforcing Details
5	Cast-In-Place Dimensional and Reinforcing Details
6	Alternate Welded Wire Reinforcing (WWR) Details
7	Grate, Anchor, and Grouting Details

LAST REVISION 11/01/20	DESCRIPTION: FY 2023-24 STANDARD PLANS	INDEX 425-021	SHEET 1 of 7
---------------------------	--	------------------	-----------------

R.K.M. DEVELOPMENT CORP.



COMMON OAK ENGINEERING
4016 EDGEWATER DRIVE
ORLANDO, FL 32804
(407) 951-5915
CERTIFICATE OF AUTHORIZATION: 32644

MAJOR SITE PLAN
7-ELEVEN
AT SEC OF SE 92ND LP
&
SE 58TH AVE
BELLEVUE, FL
MARION COUNTY

BY:	REVISION/ISSUE:
DATE:	
NO.:	


ENGINEER'S NAME & PE#

JEREMY R. ANDERSON, P.E.
P.E. LICENSE NO. 71636
PROJECT # 222.108


Jeremy R. Anderson, State of Florida, Professional Engineer, License No. 71636
This item has been digitally signed and sealed by Jeremy R. Anderson, PE, on the date indicated here.
Printed copies of this document are not considered signed and sealed and the signature must be verified on any electronic copies.

DATE SHEET
05/13/2024
SCALE
N.T.S.
D2.1
GRADING DETAILS


- NOTES:**
- Steel Grates are required on inlets with traversable sides and on inlets where bicycle traffic is anticipated.
 - Cast Iron Grates are not permitted on Inlet Type D.

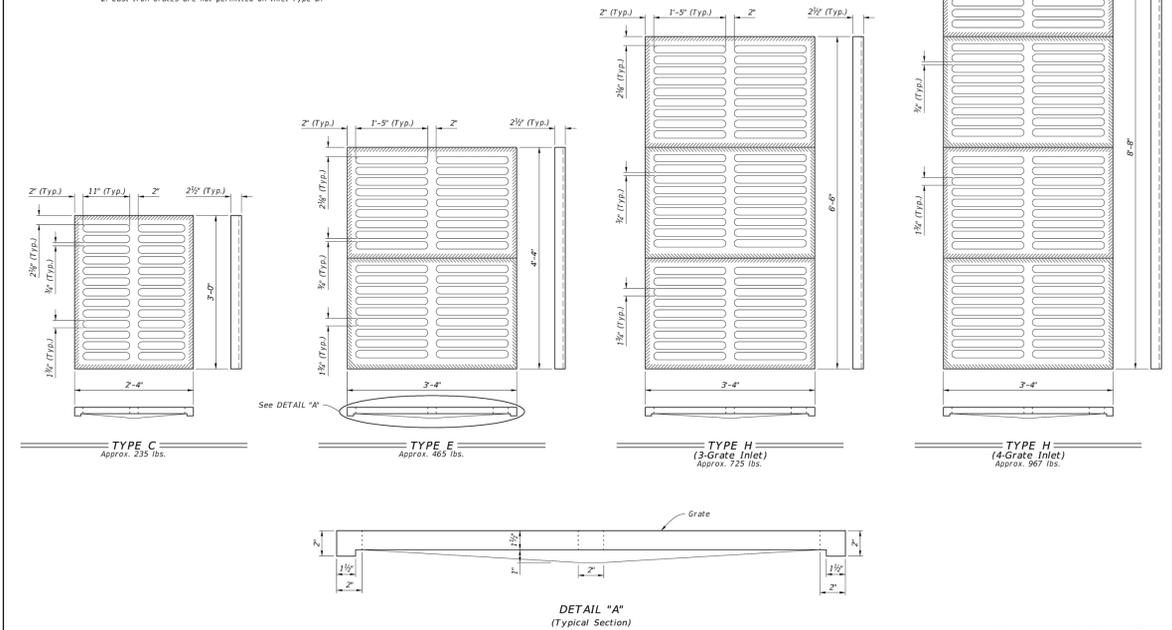


LAST REVISION	DESCRIPTION:	FDOT	FY 2023-24	DITCH BOTTOM INLET TYPES C, D, E, AND H	INDEX	SHEET
10/01/20			STANDARD PLANS		425-052	7 of 14

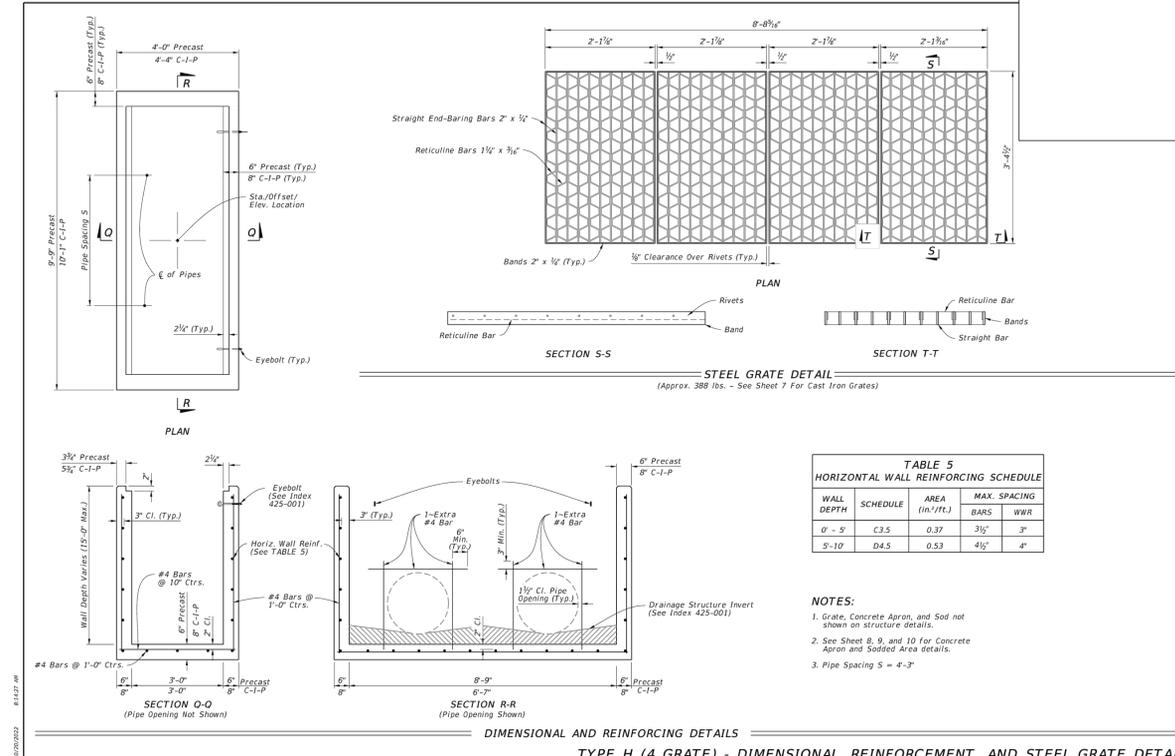

LAST REVISION	DESCRIPTION:	FDOT	FY 2023-24	DITCH BOTTOM INLET TYPES C, D, E, AND H	INDEX	SHEET
10/01/20			STANDARD PLANS		425-052	6 of 14

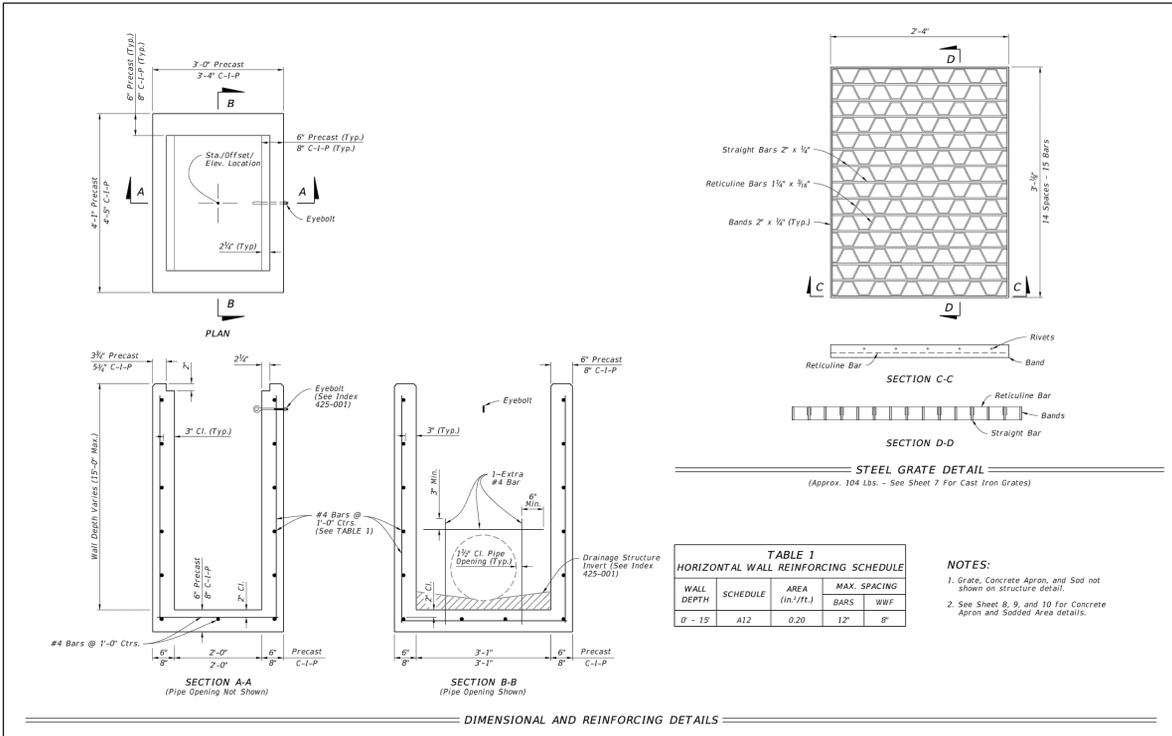

LAST REVISION	DESCRIPTION:	FDOT	FY 2023-24	DITCH BOTTOM INLET TYPES C, D, E, AND H	INDEX	SHEET
10/01/20			STANDARD PLANS		425-052	2 of 14

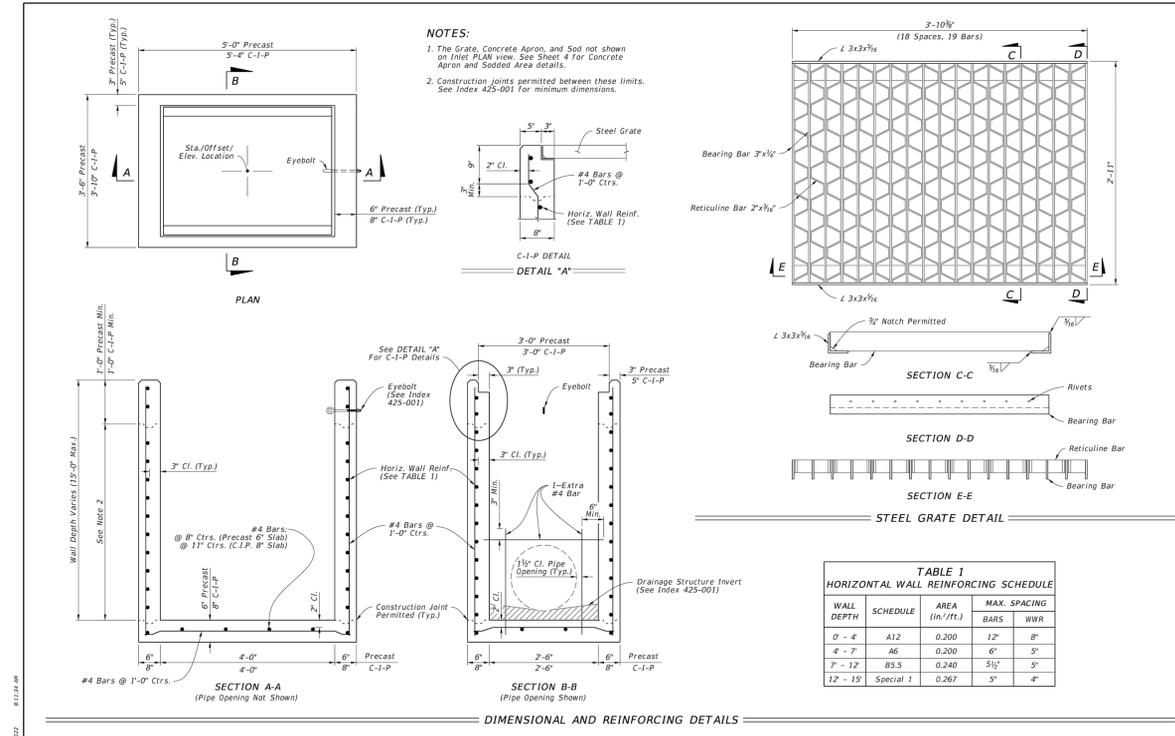

LAST REVISION	DESCRIPTION:	FDOT	FY 2023-24	DITCH BOTTOM INLET TYPES F AND G	INDEX	SHEET
10/01/20			STANDARD PLANS		425-053	2 of 4

Jeremy R. Anderson, State of Florida, Professional Engineer, License No. 71636
 This item has been digitally signed and sealed by Jeremy R. Anderson, PE, on the date indicated here.
 Printed copies of this document are not considered signed and sealed and the signature must be verified on any electronic copies.

R.K.M. DEVELOPMENT CORP.

COMMON OAK ENGINEERING

COMMON OAK ENGINEERING
4016 EDGEWATER DRIVE
ORLANDO, FL 32804
(407) 951-5915
CERTIFICATE OF AUTHORIZATION: 32644

BY: MAJOR SITE PLAN
7-ELEVEN
AT SEC OF SE 92ND LP
&
SE 58TH AVE
BELLEVUE, FL
MARION COUNTY

NO.	DATE	REVISION/ISSUE

ENGINEER'S NAME & PE#

PROJECT # **222.108**

DATE SHEET
05/13/2024
SCALE **D2.2**
N.T.S.

GRADING DETAILS



COMMON OAK ENGINEERING
4016 EDGEWATER DRIVE
ORLANDO, FL 32804
(407) 951-5915
CERTIFICATE OF AUTHORIZATION: 32644

MAJOR SITE PLAN
7-ELEVEN
&
SE 58TH AVE
BELLEVUE, FL
MARION COUNTY

BY: JR

NO.	DATE	REVISION / ISSUE
2	12/05/2024	PDOT ACCESS COMMENTS


ENGINEER'S NAME & PE#

JEREMY R. ANDERSON, P.E.
P.E. LICENSE NO. 71636

PROJECT # 222.108



DATE 05/13/2024
SCALE N.T.S.

PROFILES

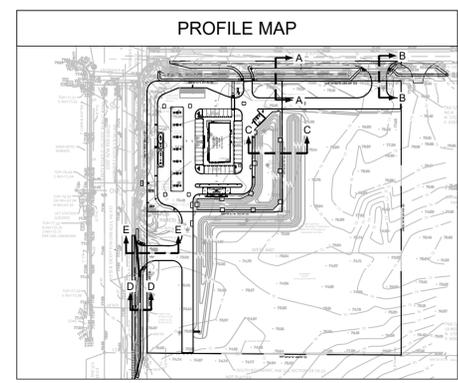


LEGEND



- EXISTING EARTH
- ASPHALT PAVEMENT
- CONCRETE

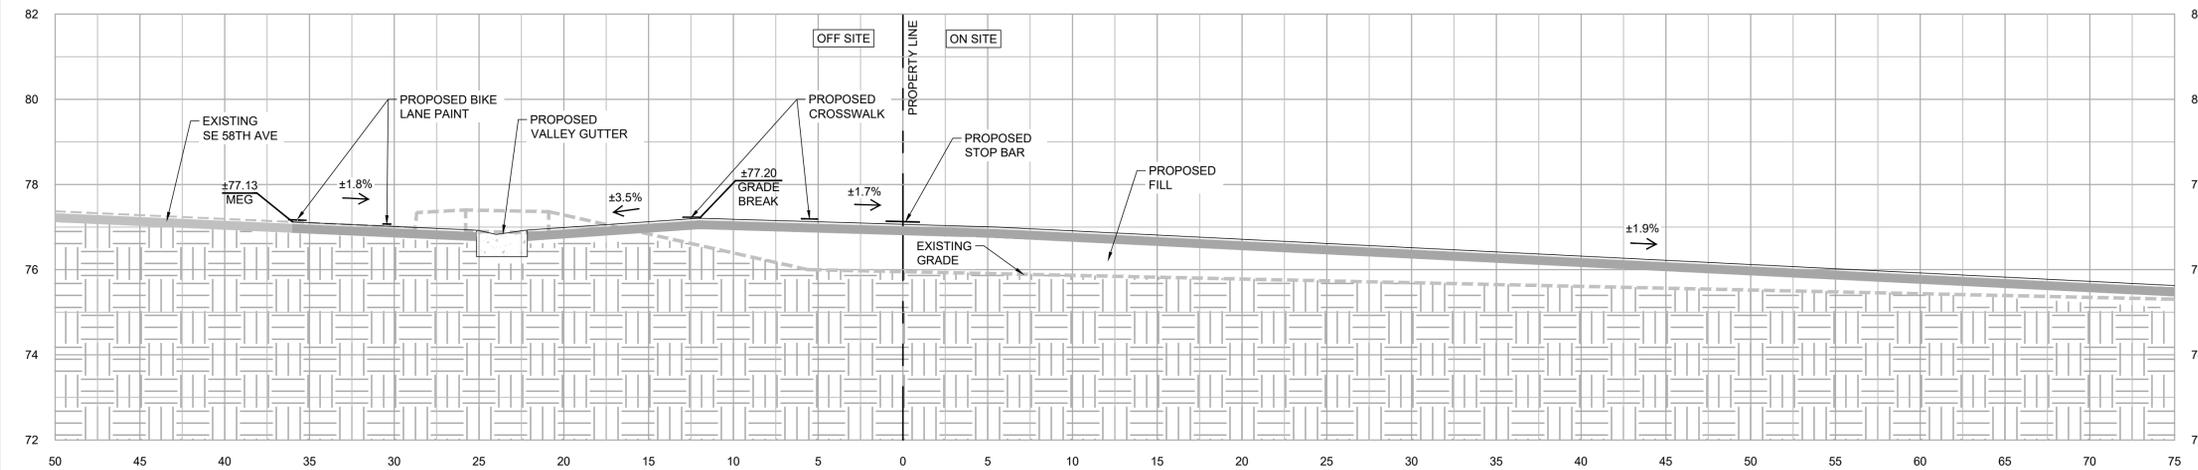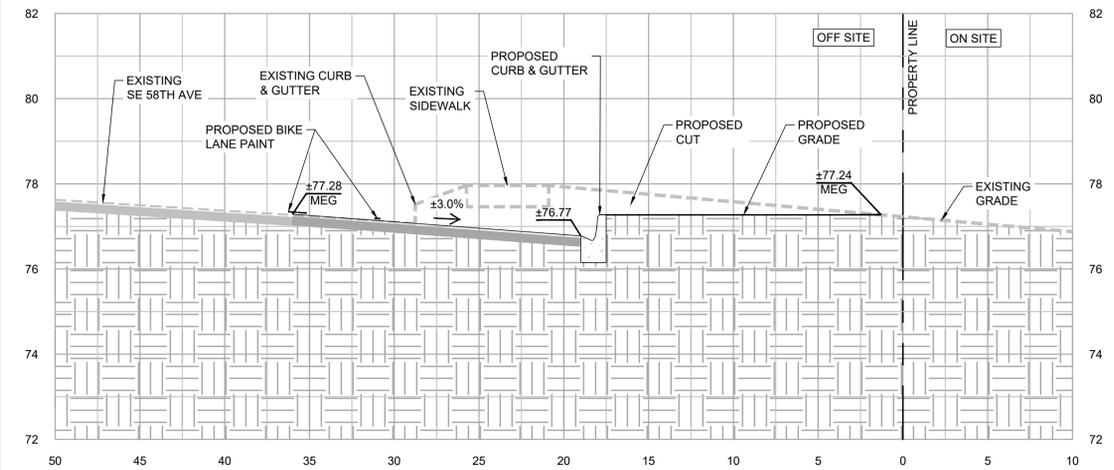


Jeremy R. Anderson, State of Florida, Professional Engineer, License No. 71636
This item has been digitally signed and sealed by Jeremy R. Anderson, PE, on the date indicated here.
Printed copies of this document are not considered signed and sealed and the signature must be verified on any electronic copies.

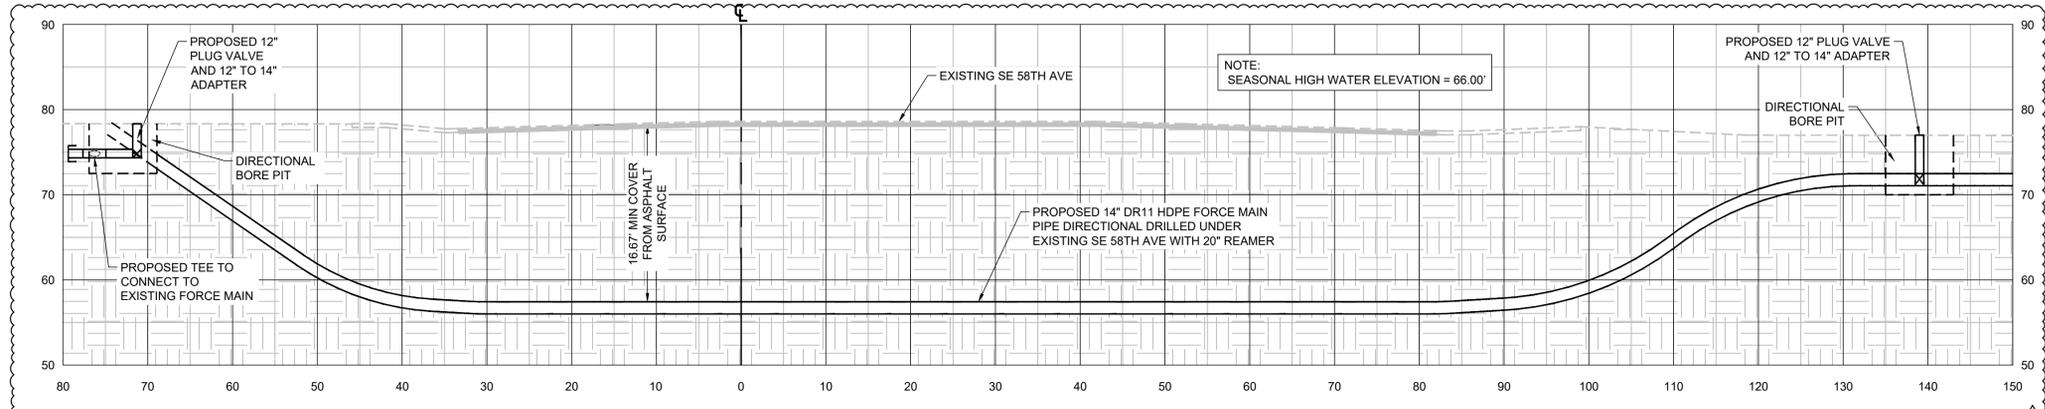


PROFILE FM-FM (FORCE MAIN DIRECTIONAL BORE UNDER SE 58TH AVE)
 SCALE: 1" IS 10' (VERTICAL) 1" IS 10' (HORIZONTAL)
 NOTE: ELEVATIONS BASED NAVD 88 VERTICAL DATUM

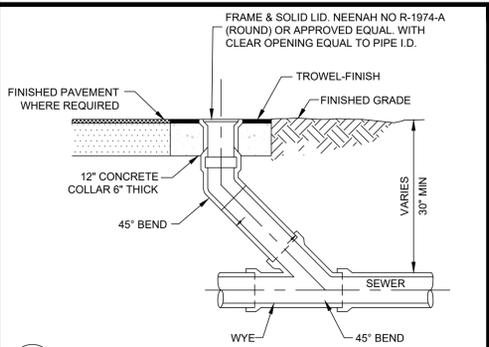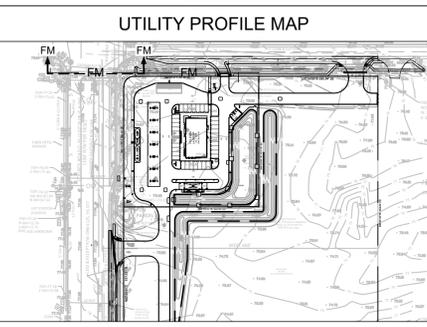

1 CLEANOUT NTS

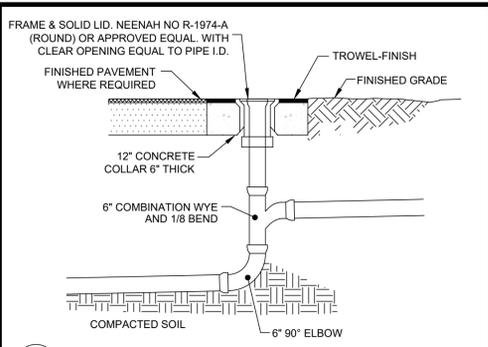

2 DROP CLEANOUT NTS

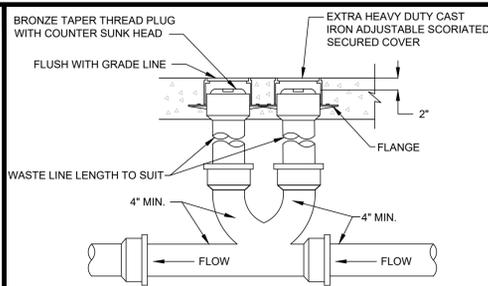

3 2-WAY CLEANOUT NTS

GREASE DRAINAGE FIXTURE UNITS

PLUMBING FIXTURE	DFU (EACH)	DFU (TOTAL)
3" FLOOR SINK	5	5
MOP SINK (2)	2	4
TOTAL	7	9

DRAINAGE FIXTURE UNIT PER FLORIDA PLUMBING CODE

HYDROMECHANICAL GREASE TRAP SIZING

FIXTURE	QTY	LENGTH (IN)	WIDTH (IN)	DEPTH (IN)	VOLUME (CU. IN.)	GALLONS
WASH SINK COMPARTMENT	1	12	19	12	2736	11.8
RINSE SINK COMPARTMENT	1	12	19	12	2736	11.8
SANITIZE SINK COMPARTMENT	1	12	19	12	2736	11.8
3-COMP SINK (S2) TOTAL						35.5
MOP SINK (MS)	2	24	24	10	5760	49.9
TOTAL GALLONS						85.4
REDUCTION VALUE [5]					0.75	
TOTAL REDUCED GALLONS						64.1
DRAIN TIME (MIN) [5]					2	
FLOW THROUGH RATING (GPM) [5]						32.0

[1] PER FBC, PLUMBING TABLE 709.1 DRAINAGE FIXTURE UNIT VALUES
 [2] PER FBC, PLUMBING TABLE 709.2 (3" TRAP = 5 DFU)
 [3] PER FBC, PLUMBING SECTION 709.3 (1 GPM = 2 DFU)
 [4] PER FBC, PLUMBING SECTION 709.4 VALUES FOR INDIRECT WASTE RECEPTOR
 [5] PER FBC, PLUMBING SECTION 1003.3.4 & PD1 TABLE 8.3.2




COMMON OAK ENGINEERING
 4016 EDGEWATER DRIVE
 ORLANDO, FL 32804
 (407) 951-5915
 CERTIFICATE OF AUTHORIZATION: 32644

MAJOR SITE PLAN
 7-ELEVEN
 AT SEC OF SE 92ND LP
 &
 SE 58TH AVE
 BELLEVUE, FL
 MARION COUNTY

NO.	DATE	REVISION / ISSUE	BY	FOR
1	12/07/2024	CITY OF BELLEVUE UTILITY COMMENTS	JR	JR
2	03/13/2024	CITY OF BELLEVUE UTILITY COMMENTS	JR	JR
3	05/02/2024	FDOT UTILITY COMMENTS	JR	JR

ENGINEER'S NAME & PE#
 JEREMY R. ANDERSON, P.E.
 P.E. LICENSE NO. 71636

PROJECT # **222.108**
 SHEET **D3.0**
 DATE **05/13/2024**
 SCALE **N.T.S.**
 UTILITY DETAILS

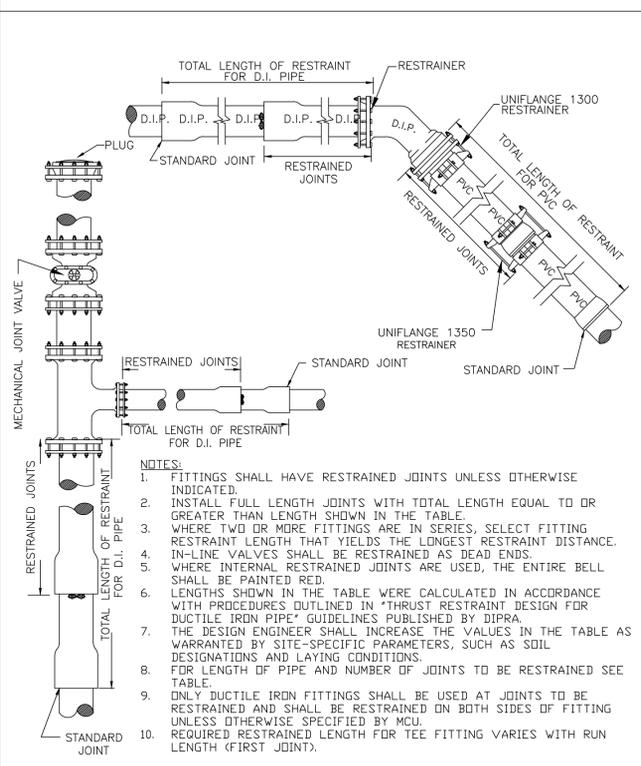

5 CAR WASH RECLAIM SYSTEM NTS

MINIMUM RESTRAINED LENGTH (FT)
 EACH SIDE OF FITTING AND VALVE
 FOR DIP, PE ENCASED DIP OR BARE PVC VD=VERTICAL-DOWN
 WATER MAIN: PRESSURE: 150 PSI. DEPTH OF COVER: 3.0

REQUIRED RESTRAINED LENGTH ON WATER MAIN

Bend Type	Pipe Length (ft)					
	4"	6"	8"	10"	12"	24"
11-1/4"	H	2	3	4	5	6
	VU	2	3	4	5	6
	VD	6	9	11	13	16
22-1/2"	H	4	6	7	9	10
	VU	4	6	7	9	10
	VD	12	17	22	27	31
45°	H	8	11	15	17	20
	VU	8	11	15	17	20
	VD	25	35	46	55	65
90°	H	19	27	35	41	48
	VU	19	27	35	41	48
	VD	61	85	111	132	155

REQUIRED RESTRAINED LENGTH ON TEE BRANCH

TEE FITTING	Pipe Length (ft)					
	4"	6"	8"	10"	12"	24"
11-1/4"	H	2	3	4	5	6
	VU	2	3	4	5	6
	VD	6	9	11	13	16
22-1/2"	H	4	6	7	9	10
	VU	4	6	7	9	10
	VD	12	17	22	27	31
45°	H	8	11	15	17	20
	VU	8	11	15	17	20
	VD	25	35	46	55	65
90°	H	19	27	35	41	48
	VU	19	27	35	41	48
	VD	61	85	111	132	155

REQUIRED RESTRAINED LENGTH ON LARGER PIPE

REDUCER FITTING	Pipe Length (ft)					
	4"	6"	8"	10"	12"	24"
11-1/4"	H	2	3	4	5	6
	VU	2	3	4	5	6
	VD	6	9	11	13	16
22-1/2"	H	4	6	7	9	10
	VU	4	6	7	9	10
	VD	12	17	22	27	31
45°	H	8	11	15	17	20
	VU	8	11	15	17	20
	VD	25	35	46	55	65
90°	H	19	27	35	41	48
	VU	19	27	35	41	48
	VD	61	85	111	132	155

REQUIRED RESTRAINED LENGTH ON FORCE MAIN

Bend Type	Pipe Length (ft)					
	4"	6"	8"	10"	12"	24"
11-1/4"	H	2	3	4	5	6
	VU	2	3	4	5	6
	VD	6	9	11	13	16
22-1/2"	H	4	6	7	9	10
	VU	4	6	7	9	10
	VD	12	17	22	27	31
45°	H	8	11	14	16	20
	VU	8	11	14	16	20
	VD	20	27	36	43	50
90°	H	15	21	27	32	38
	VU	15	21	27	32	38
	VD	46	65	85	102	121


REQUIRED RESTRAINED LENGTH ON TEE BRANCH

TEE FITTING	Pipe Length (ft)					
	4"	6"	8"	10"	12"	24"
11-1/4"	H	2	3	4	5	6
	VU	2	3	4	5	6
	VD	6	9	11	13	16
22-1/2"	H	4	6	7	9	10
	VU	4	6	7	9	10
	VD	12	17	22	27	31
45°	H	8	11	14	16	20
	VU	8	11	14	16	20
	VD	20	27	36	43	50
90°	H	15	21	27	32	38
	VU	15	21	27	32	38
	VD	46	65	85	102	121


REQUIRED RESTRAINED LENGTH ON LARGER PIPE

REDUCER FITTING	Pipe Length (ft)					
	4"	6"	8"	10"	12"	24"
11-1/4"	H	2	3	4	5	6
	VU	2	3	4	5	6
	VD	6	9	11	13	16
22-1/2"	H	4	6	7	9	10
	VU	4	6	7	9	10
	VD	12	17	22	27	31
45°	H	8	11	14	16	20
	VU	8	11	14	16	20
	VD	20	27	36	43	50
90°	H	15	21	27	32	38
	VU	15	21	27	32	38
	VD	46	65	85	102	121


FORCE MAIN:
 PRESSURE: 100 PSI.
 DEPTH OF COVER: 4.0 ft.

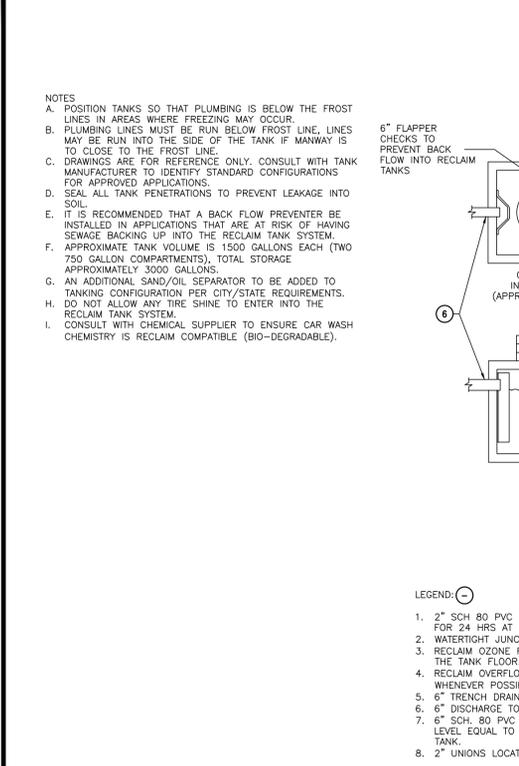


5 CAR WASH RECLAIM SYSTEM NTS

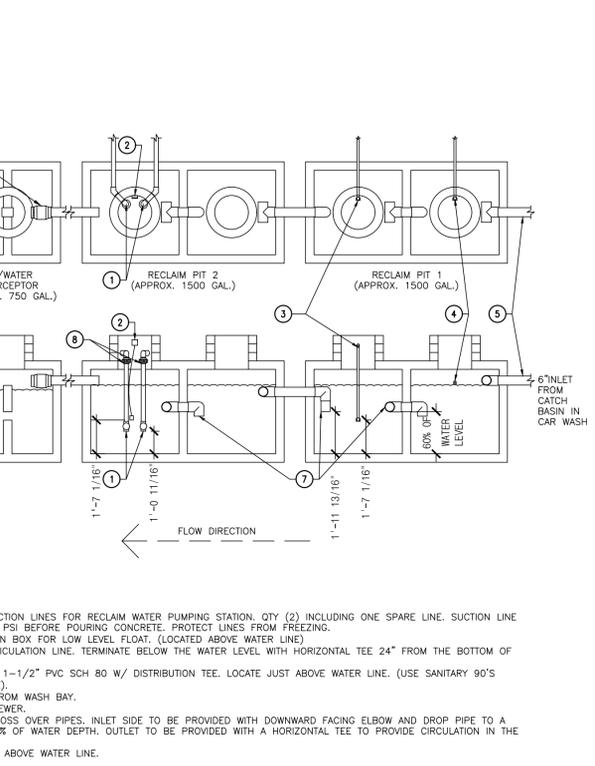


5 CAR WASH RECLAIM SYSTEM NTS

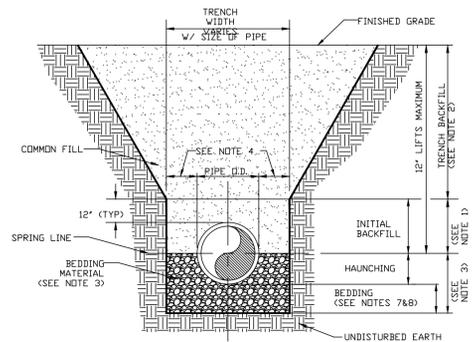


- NOTES:**
1. INITIAL BACKFILL: COMMON FILL COMPACTED TO 95% (98% UNDER PAVEMENT) OF THE MAXIMUM DENSITY AS PER AASHTO T-100.
 2. TRENCH BACKFILL: COMMON FILL COMPACTED TO 95% (98% UNDER PAVEMENT) OF THE MAXIMUM DENSITY AS PER AASHTO T-100.
 3. BEDDING MATERIAL SHALL CONFORM TO FDOT NO. 57 AGGREGATE.
 4. 15" MAX. (12" MIN) FOR PIPE DIAMETER LESS THAN 24" AND 24" MAX (12" MIN) FOR PIPE DIAMETER 24" AND LARGER.
 5. WATER SHALL NOT BE PERMITTED IN THE TRENCH DURING CONSTRUCTION.
 6. ALL PIPE TO BE INSTALLED WITH BELL FACING UPSTREAM TO THE DIRECTION OF THE FLOW.
 7. BEDDING DEPTH SHALL BE 4" MINIMUM FOR PIPE DIAMETER UP TO 12" AND 6" MINIMUM FOR PIPE DIAMETER 16" AND LARGER.
 8. DEPTH FOR REMOVAL OF UNSUITABLE MATERIAL SHALL GOVERN DEPTH OF BEDDING ROCK BELOW THE PIPE. UTILITIES SHALL DETERMINE IN THE FIELD REQUIRED REMOVAL OF UNSUITABLE MATERIAL TO REACH SUITABLE FOUNDATION.
 9. FINAL RESTORATION IN IMPROVED AREAS SHALL BE IN COMPLIANCE WITH ALL APPLICABLE REGULATIONS OF GOVERNING AGENCIES. SURFACE RESTORATION WITHIN MARION COUNTY RIGHT-OF-WAY SHALL COMPLY WITH REQUIREMENTS OF RIGHT-OF-WAY UTILIZATION REGULATIONS AND ROAD CONSTRUCTION SPECIFICATIONS.
 10. ONE COMPACTION TEST SHALL BE REQUIRED FOR EACH LIFT NOT TO EXCEED 200'.

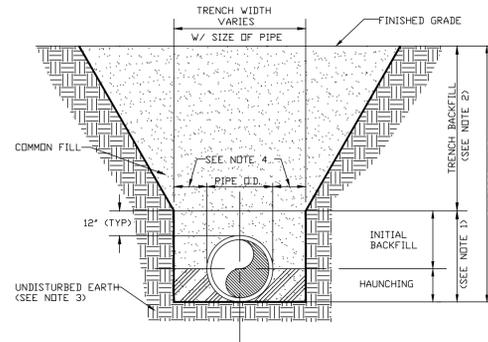

- NOTES:**
1. INITIAL BACKFILL AND HAUNCHING: SELECT COMMON FILL COMPACTED TO 95% (98% UNDER PAVEMENT) OF THE MAXIMUM DENSITY AS PER AASHTO T-100.
 2. TRENCH BACKFILL: COMMON FILL COMPACTED TO 95% (98% UNDER PAVEMENT) OF THE MAXIMUM DENSITY AS PER AASHTO T-100.
 3. PIPE BEDDING UTILIZING SELECT COMMON FILL OR BEDDING ROCK IN ACCORDANCE WITH BEDDING AND TRENCHING 1 DETAIL MAY BE REQUIRED AS DIRECTED BY M.C.U.
 4. 15" MAX. (12" MIN) FOR PIPE DIAMETER LESS THAN 24" AND 24" MAX (12" MIN) FOR PIPE DIAMETER 24" AND LARGER.
 5. WATER SHALL NOT BE PERMITTED IN THE TRENCH DURING CONSTRUCTION.
 6. ALL PIPE TO BE INSTALLED WITH BELL FACING UPSTREAM TO THE DIRECTION OF THE FLOW.
 7. FINAL RESTORATION IN IMPROVED AREAS SHALL BE IN COMPLIANCE WITH ALL APPLICABLE REGULATIONS OF GOVERNING AGENCIES. SURFACE RESTORATION WITHIN MARION COUNTY RIGHT-OF-WAY SHALL COMPLY WITH REQUIREMENTS OF RIGHT-OF-WAY UTILIZATION REGULATIONS AND ROAD CONSTRUCTION SPECIFICATIONS.
 8. ONE COMPACTION TEST SHALL BE REQUIRED FOR EACH LIFT NOT TO EXCEED 200'.

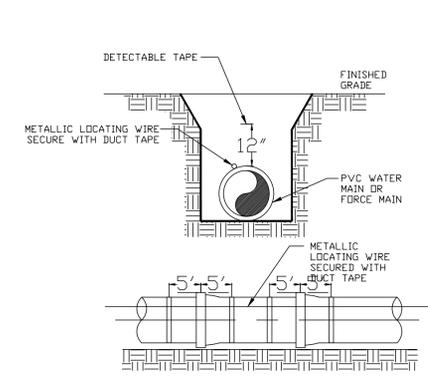

- NOTES:**
1. PVC PIPE SHALL REQUIRE INSULATED METALLIC LOCATING WIRE (10 GAUGE COPPER) CAPABLE OF DETECTION BY A CABLE LOCATOR AND SHALL BE BURIED ON TOP OF THE PIPE.
 2. LOCATING WIRE SHALL TERMINATE AT EACH VALVE BOX AND BE CAPABLE OF EXTENDING 12" ABOVE TOP OF BOX IN SUCH A MANNER SO AS NOT TO INTERFERE WITH VALVE OPERATION PER UT 112.
 3. ALL WIRE CONNECTIONS SHALL BE SPLICED TOGETHER USING WATERTIGHT WIRE NUTS.
 4. FOR HORIZONTAL DIRECTIONAL DRILLING, UTILIZE 2 LOCATING WIRES EACH WITH A BREAK LOAD OF 2032 POUNDS.
 5. DETECTABLE TAPE SHALL BE 1" ABOVE THE CENTERLINE OF THE PIPE.

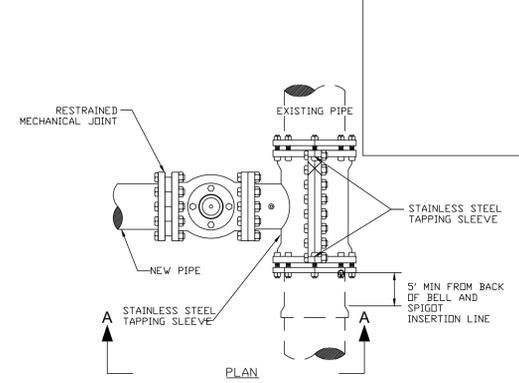


- NOTES:**
1. PRIOR TO BEGINNING THE TAPPING OPERATION, THE SLEEVE AND VALVE SHALL BE PRESSURE TESTED AT 150 PSI FOR A MINIMUM OF 30 MINUTES TO ENSURE THAT NO LEAKAGE WILL OCCUR.
 2. CONTRACTOR SHALL PROVIDE M.C.U. PROOF OF PRESSURE TEST IN THE FORM OF A TAPPING TEST LOG WITH THE CONTRACTOR'S SIGNATURE.
 3. CONTRACTOR MUST CONFIRM RESTRAINTS IN ALL DIRECTIONS AND INSTALL ADDITIONAL RESTRAINTS AS NECESSARY TO COMPLY WITH LAND DEVELOPMENT CODE.
 4. ALL TAPS MUST BE LOCATED A MINIMUM OF 5' AWAY FROM ANY BELL AND/OR FITTING.
 5. STAINLESS STEEL TAPPING SLEEVE SHALL BE MADE OF 316SS.

Marion County Florida UTILITIES
 MCBC EFFECTIVE 04/13/2023
 REVISION # 2
BEDDING AND TRENCHING 1
 7.3.2
 UT 102

Marion County Florida UTILITIES
 MCBC EFFECTIVE 04/13/2023
 REVISION # 2
BEDDING AND TRENCHING 2
 7.3.2
 UT 103


Marion County Florida UTILITIES
 MCBC EFFECTIVE 04/13/2023
 REVISION # 2
PIPE LOCATING WIRE AND DETECTABLE TAPE
 7.3.2
 UT 104

Marion County Florida UTILITIES
 MCBC EFFECTIVE 04/13/2023
 REVISION # 1
TAPPING SLEEVE AND GATE VALVE ASSEMBLY
 7.3.2
 UT 108

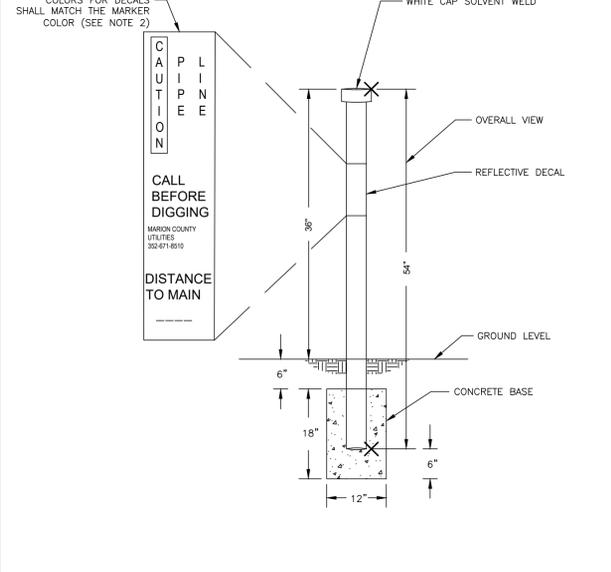


- NOTES:**
1. MARKERS ARE REQUIRED WHEN UTILITY MAIN IS LOCATED OVER 30 FEET FROM EDGE OF PAVEMENT OR IN AN EASEMENT NOT ADJACENT TO THE RIGHT-OF-WAY.
 2. MARKERS SHALL BE 4" DIAMETER SCH80 DR DRIB PVC: BLUE FOR WATER; GREEN FOR WASTEWATER; AND PANTONE PURPLE 220C FOR RECLAIMED WATER.
 3. MARKERS SHALL BE PLACED AT ALL VALVES THAT MEET NOTE 1 EXCEPT WATER VALVES NEAR FIRE HYDRANTS.
 4. ADDITIONAL MARKERS SHALL BE INSTALLED AS NEEDED SO THAT THE DISTANCE BETWEEN MARKERS DOES NOT EXCEED 1,000 FEET.

Marion County Florida UTILITIES
 MCBC EFFECTIVE 04/13/2023
 REVISION # 2
UTILITY MAIN MARKER
 7.3.2
 UT 109

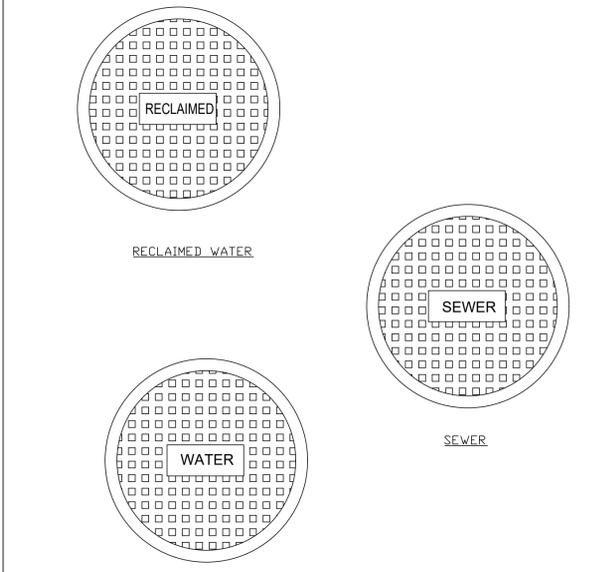


Marion County Florida UTILITIES
 MCBC EFFECTIVE 04/13/2023
 REVISION # NA
TYPICAL VALVE BOX COVER
 7.3.2
 UT 110

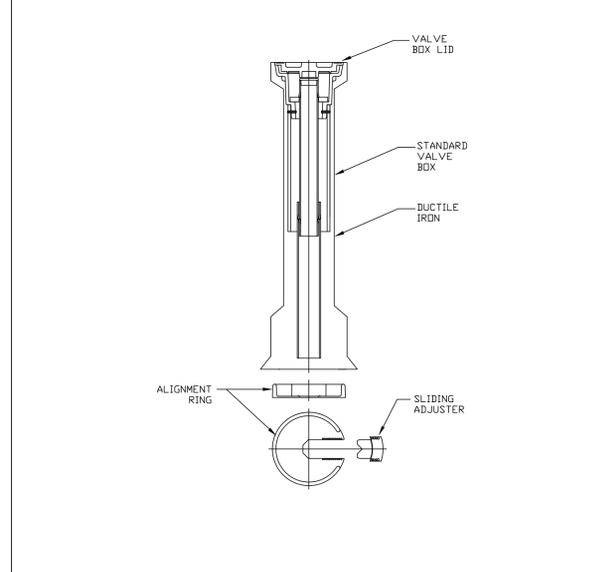

- NOTES:**
1. FOR ALL MAINS 60" DEEP OR GREATER, PVC PIPE EXTENSIONS SHALL BE USED ON VALVE BOX INSTALLATION.

Marion County Florida UTILITIES
 MCBC EFFECTIVE 04/13/2023
 REVISION # 1
SEALED VALVE BOX, ADJUSTABLE
 7.3.2
 UT 111

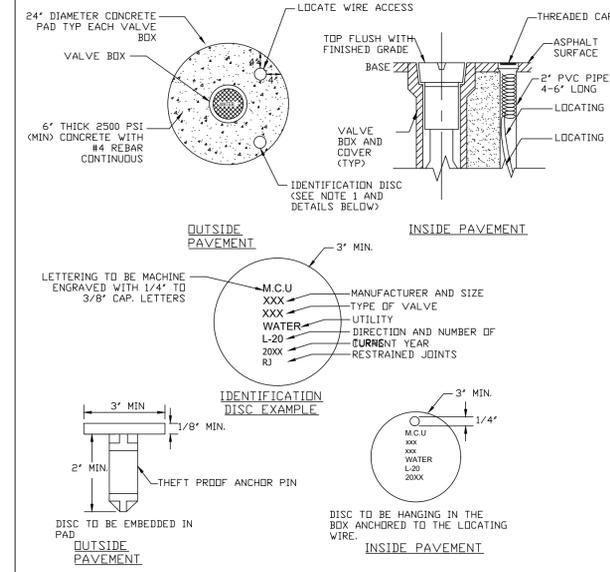

- NOTES:**
1. BRONZE (OR STAINLESS STEEL) IDENTIFICATION DISC SHALL BE REQUIRED FOR ALL VALVES, EXCEPT HYDRANT VALVES.
 2. LOCATING WIRE SHALL TERMINATE AT EACH VALVE BOX AND BE CAPABLE OF EXTENDING 12" ABOVE TOP OF BOX IN SUCH A MANNER SO AS NOT TO INTERFERE WITH VALVE OPERATION.

Marion County Florida UTILITIES
 MCBC EFFECTIVE 04/13/2023
 REVISION # 1
VALVE BOX PAD
 7.3.2
 UT 112

R.K.M. DEVELOPMENT CORP.

COMMON OAK ENGINEERING

COMMON OAK ENGINEERING
 4016 EDGEWATER DRIVE
 ORLANDO, FL 32804
 (407) 951-5915
 CERTIFICATE OF AUTHORIZATION: 32844

MAJOR SITE PLAN
 7-ELEVEN
 AT SEC OF SE 92ND LP
 SE 58TH AVE
 BELLEVUE, FL
 MARION COUNTY

BY: JR	REVISION/ISSUE:	DATE:	NO.:
	CITY OF BELLEVUE UTILITY COMMENTS	12/07/2024	3

ENGINEER'S NAME & PE#
 JEREMY R. ANDERSON, P.E.
 P.E. LICENSE NO. 71636
 PROJECT # 222.108

Jeremy R. Anderson, State of Florida, Professional Engineer, License No. 71636
 This item has been digitally signed and sealed by Jeremy R. Anderson, PE, on the date indicated here.
 Printed copies of this document are not considered signed and sealed and the signature must be verified on any electronic copies.

DATE: 05/13/2024
 SCALE: N.T.S.
UTILITY DETAILS



COMMON OAK ENGINEERING
4016 EDGEWATER DRIVE
ORLANDO, FL 32804
(407) 951-5915
CERTIFICATE OF AUTHORIZATION: 32844

MAJOR SITE PLAN
7-ELEVEN
AT SEC OF SE 92ND LP
&
SE 58TH AVE
BELLEVUE, FL
MARION COUNTY

NO.	DATE	REVISION / ISSUE	BY: / JR	REVISION / ISSUE	BY: / JR
1	12/07/2024	CITY OF BELLEVUE UTILITY COMMENTS	JR		
2	12/15/2024	MARION COUNTY COMMENTS	JR		

ENGINEER'S NAME & PE#

JEREMY R. ANDERSON, P.E.
P.E. LICENSE NO. 71636
PROJECT # 222.108

DATE SHEET
05/13/2024
SCALE D3.3
N.T.S.
UTILITY DETAILS

RILEY & Company, Inc. (H-20 GP)

w/ BATTERY BACK-UP FOR AUDIO AND VISUAL ALARMS ©

PUMPS: **SPECIFICATION**
Submersible grinder pumps shall be Manufacturer FLGYT - Model RCMP3127-263.
The pumps shall be installed in the FRP wetwell utilizing a dual slide rail system.
The grinder system shall be capable of grinding the waste materials normally found in domestic and commercial sewage into a fine slurry which will pass through the pump and discharge piping.
Stator winding shall be open type with Class H insulation and shall be heat shrink fitted into the stator housing. Shall withstand a continuous operating temperature of 155° C.
A heat sensor (2) thermal switches shall be attached to the motor windings.
The pump motor grinder shaft shall be EN 1.4301 / AISI 304SS connection to take the pump impeller and the grinder assembly.
Semi Axial Centrifugal Impeller shall be Cast Iron EN-GJL-200 / ASTM A48 30B.
Cutter/Grinder Assembly shall be Stainless Steel EN 1.4301 / AISI 304.
Double mechanical cartridge shaft seals shall be provided. The seal springs located inside the oil housing should be fully protected from the pumped liquid. The mechanical seals should be able to withstand rotation on either side.
Moisture sensor (2) shall be included in the motor housing assembly.
Power and Control cables shall be clamped against tensile loads and have a serviceable inlet to the motor, with hermetically sealed polyurethane filled, stainless steel cable plug connection. The pump and electric cables shall be capable of continuance submergence, without loss of waterproof integrity to a depth of 65 ft.

CONTROL PANEL: **SPECIFICATION**
The Enclosure shall be NEMA 4X, minimum 30" high x 20" wide x 10" deep with 3 point latching system.
The enclosure shall have external mounting feet to allow for wall mounting.
The following components shall be mounted through the enclosure:
1- ea. Red Alarm Beacon (Light) LED 360 Degree viewable range
1- ea. Alarm Horn (minimum 95 DCB)
1- ea. Generator Receptacle w/ weatherproof cover 60A Minimum. Shall meet UL 1682 and UL 1686 Configuration.
The back panel shall be fabricated from .125, 5052-H32 marine alloy aluminum. All components shall be mounted by machined stainless steel screws.
The following components shall be mounted to back panel:
2- ea. IEC style Motor Contactors
1- ea. Volt Monitor (1 Ph) Phase Monitor (3 Ph) w/2 N/O & 1 N/C Contacts
1- ea. Alternator
1- ea. Control Transformer (480 Volt Only) (Min. 500VA)
1- ea. Model RCBS5AH Battery Back-Up w/ Smart Charger (UPS)
20- ea. Terminals For Field Connections
6- ea. Terminals For Motor Connections (Single Phase Only)
7- ea. Grounding Lugs
1- ea. Lightning and Surge Protection shall meet the UL 1449 2nd Edition
The inner door shall be fabricated from .080, 5052-H32 marine alloy aluminum. The inner door shall have a continuous aluminum piano hinge.
The following components shall be mounted through the inner door:
1- ea. Main Circuit Breaker
1- ea. Emergency Circuit Breaker
1- ea. Mechanical Interlock For Emergency And Main Breakers (UL Listed)
2- ea. Short Circuit Protectors w/ Auxiliary Contacts
1- ea. Control Circuit Breaker
1- ea. GFI Duplex Convenience Outlet
MISCELLANEOUS: All wiring on the back panel shall be contained within the wiring duct. All wiring between the inner door and the back panel shall be contained within a plastic spiral wrap.
Each wire shall have a wire number at each end to correspond to the as built drawing for field troubleshooting.
The control panel must be manufactured in-house by lift station supplier and be a TUV (UL508A Certified) facility.
INSPECTION & TESTING: A factory representative shall be provide for a one (1) time start-up and shall have complete knowledge of the proper operation and maintenance of complete system. Megger the motors. The pump motors shall be megged out prior to the start-up to ensure that the insulation of the pump motor/cable is intact. The pump controls and pumps shall be checked for mechanical reliability and proper operation.

- NOTES:**
- DRAWING NOT TO SCALE
 - ALL ELECTRICAL WORK SHALL BE IN ACCORDANCE WITH LOCAL CODES
 - ELECTRICIAN SHALL SEAL OFF CONDUIT RUNS
 - CONTRACTOR SHALL VERIFY POWER SOURCE PRIOR TO ORDERING EQUIPMENT
 - NEUTRAL TO BE SUPPLIED FOR 230V-3 PHASE OR 230V-SINGLE PHASE POWER.

18"

**PRIVATE
SANITARY SEWER
PUMP STATION**

IN CASE OF EMERGENCY CONTACT THE
FOLLOWING NUMBERS:

FACILITY OWNED BY: _____

NAME: _____

PHONE NUMBER: _____

FACILITY MAINTAINED BY: _____

NAME: _____

PHONE NUMBER: _____

STATION NUMBER: _____

24"

NOTE: CONTRACTOR MUST SUPPLY
INFORMATION SIGN AT START-UP.

LIFT STATION WILL BE PRIVATELY OWNED AND MAINTAINED.

THIS IS A COPYRIGHTED DRAWING. ANY CHANGES OR MODIFICATIONS WITHOUT WRITTEN APPROVAL FROM RILEY & COMPANY IS STRICTLY PROHIBITED. ©

NO SUBSTITUTIONS - NO ALTERNATES

Jeremy R. Anderson, State of Florida, Professional Engineer, License No. 71636
This item has been digitally signed and sealed by Jeremy R. Anderson, PE, on the date indicated here.
Printed copies of this document are not considered signed and sealed and the signature must be verified on any electronic copies.

STATION DESIGN CONDITION	
PRIMARY PUMP CAPACITY	24.5 GPM
PRIMARY TDH	129 'TDH
RUN-OUT PUMP CAPACITY	102.7 GPM
RUN-OUT TDH	41 'TDH
PUMP MODEL #	FLYGT RCMP3127-263
R.P.M.	3455
HORSEPOWER	6.0
ELECTRICAL/ VOLTS / PHASE	230V/3
PUMP DISCHARGE SIZE	2"





STATION ELEVATIONS AND DIMENSIONS	
WETWELL DIAMETER (A)	48"
INVERT DIAMETER (B)	PER EOR
TOP OF WETWELL (C)	76.50'
INLET / INVERT (D)	65.68'
HIGH LEVEL ALARM (HLA) (E)	65.18'
2nd PUMP ON (LAG) (F)	64.68'
1st PUMP ON (LEAD) (G)	64.18'
PUMPS OFF (OFF) (H)	63.68'
BOTTOM OF WETWELL (I)	62.00'
DISCHARGE PIPE DIAMETER (J)	2"
GUIDE RAIL DIAMETER (K)	1"
F.M. PIPE DIAMETER (L)	2"

STATION MANUFACTURING MATERIALS	
DISCHARGE PIPE	HDPE
INLET PIPE	PER EOR
GUIDE RAIL	304 SS
WET WELL	FRP ASTM D-3753
WET WELL HATCH COVER	300 LBS. PSI ALUM.
CABLE BRACKET	304 SS
LIFTING CHAIN	304 SS
BALL VALVE	304 SS
SWING CHECK VALVE	304 SS
VALVE BOX	FRP
VALVE BOX HATCH COVER	300 LBS. PSI ALUM.

STATION VALVE BOX SIZES	
(32" x 30" x 24" DEEP)	FOR 2" DISCHARGE
(36" x 36" x 36" DEEP)	FOR 3" DISCHARGE

STATION HATCH OPENINGS	
WETWELL DIA.	36" 48" 60"
	27" x 20" 36" x 24" 40" x 30"

CONCRETE BALLAST REQUIREMENTS	
CUBIC YARDS OF CONCRETE REQUIRED (V)	4.13 yds ³
CIRCUMFERENCE DIMENSION - WIDTH (W)	18.0"
CIRCUMFERENCE DIMENSION - HEIGHT (X)	24.0"
BASE SLAB DIMENSION - HEIGHT (Y)	18.0"
BASE SLAB DIMENSION - LENGTH & WIDTH (Z)	84.0"

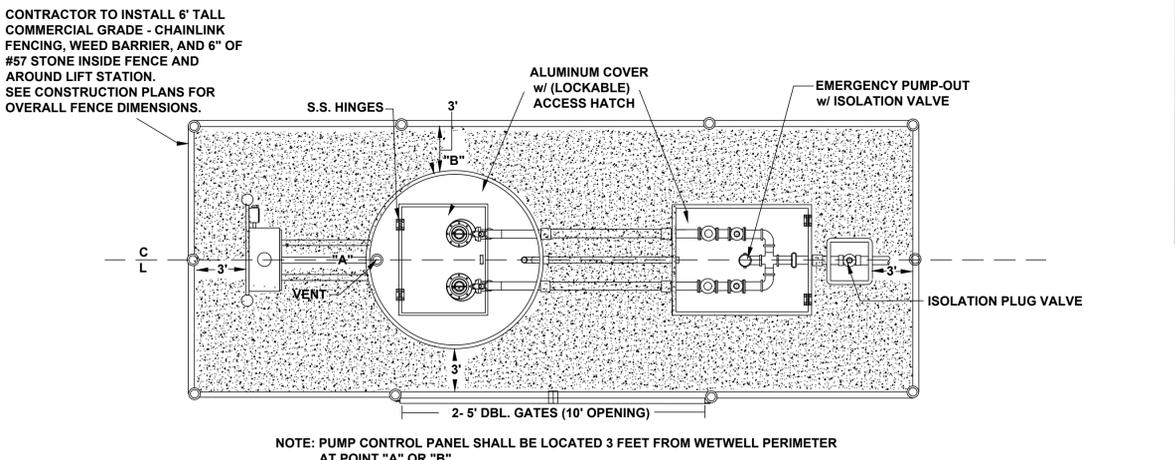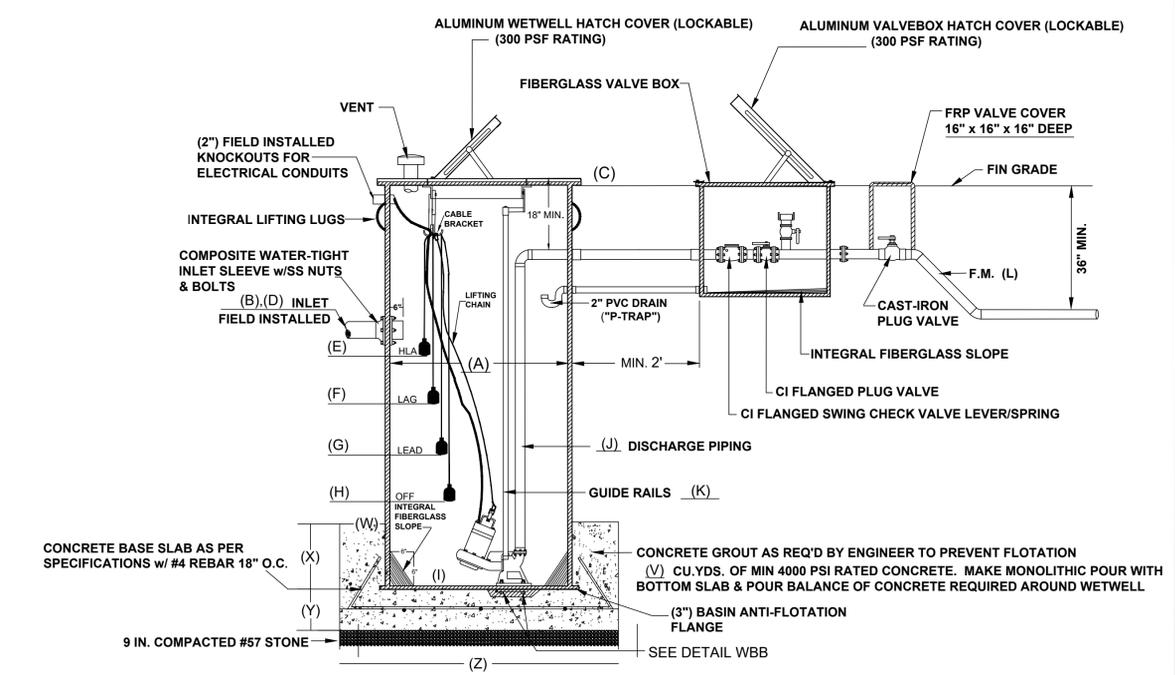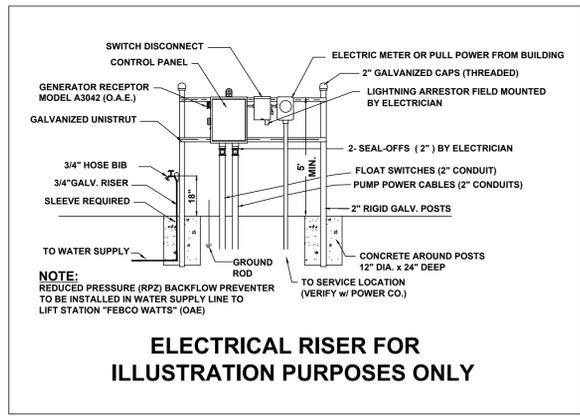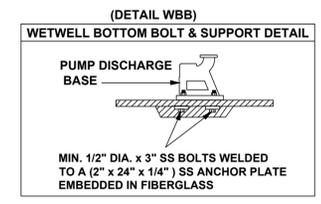

WETWELL: **SPECIFICATION**
Wet well FRP Wall Laminate must be designed to withstand wall collapse or buckling based on these assumptions and Third party specifications.
Hydrostatic Pressure 62.4 lbs. Per SQ Ft.
Saturated soil weight 120 lbs. Per Cubic Ft.
Soil Modulus of 700 lbs Per SQ Ft.
Pipe Stiffness As specified in ASTM D 3753
The wet well FRP laminate must be constructed to with stand or exceed two times the assumed loading on any depth of the wet well.
The cover shall be constructed of 1/4 inch thick material finish aluminum diamond plate pattern with 300 series stainless steel hardware. The hatch shall have a positive means of holding door open in the vertical position (Locking hold open arm) made of non-corrosive material. The cover shall be mounted with minimum of six 300 series stainless steel fasteners. The access hatch cover shall have a lift handle and a means of locking.
The prefabricated FRP lift station manufacture shall guarantee the prefabricated lift station as approved drawings for a period of One year from the date of delivery.
EXECUTION:
Installation shall be in strict accordance with the manufacturer's recommendations in the locations shown on the drawing.

02/02/24 SR

PLUMBING FIXTURE	DFU (EACH)	DFU
DRINKING FOUNTAIN	0.5	0.5
3" FLOOR DRAIN (3)	2	6
LAVATORY (5)	1	5
URINAL (2)	2	4
WATER CLOSET (3)	4	12
HAND SINK/DUMP SINK (3)	1	5
3" FLOOR SINK (3)	5	15
TOTAL		47.5

DRAINAGE FIXTURE UNIT PER FLORIDA PLUMBING CODE

PLUMBING FIXTURE	DFU (EACH)	DFU (TOTAL)
3" FLOOR SINK	5	5
MOP SINK (2)	2	4
TOTAL		9

DRAINAGE FIXTURE UNIT PER FLORIDA PLUMBING CODE

FIXTURE	QTY	LENGTH (IN)	WIDTH (IN)	DEPTH (IN)	VOLUME (CU. IN.)	GALLONS
WASH SINK COMPARTMENT	1	12	19	12	2736	11.8
RINSE SINK COMPARTMENT	1	12	19	12	2736	11.8
SANITIZE SINK COMPARTMENT	1	12	19	12	2736	11.8
3-COMP SINK (S2) TOTAL						35.5
MOP SINK (MS)	2	24	24	10	5760	49.9
TOTAL GALLONS						85.4
REDUCTION VALUE [5]						0.75
TOTAL REDUCED GALLONS						64.1
DRAIN TIME (MIN) [5]						2
FLOW THROUGH RATING (GPM) [5]						32.0

[1] PER FBC, PLUMBING TABLE 709.1 DRAINAGE FIXTURE UNIT VALUES
 [2] PER FBC, PLUMBING TABLE 709.2 (3" TRAP = 5 DFU)
 [3] PER FBC, PLUMBING SECTION 709.3 (1 GPM = 2 DFU)
 [4] PER FBC, PLUMBING SECTION 709.4 VALUES FOR INDIRECT WASTE RECEPTOR
 [5] PER FBC, PLUMBING SECTION 1003.3.4 & PDI TABLE 8.3.2

PLUMBING NOTES


- A. NOTES APPLY TO ALL PLUMBING SHEETS.
- B. EACH CONTRACTOR IS RESPONSIBLE FOR HAVING THOROUGH KNOWLEDGE OF ALL DRAWINGS AND SPECIFICATIONS AS THEY RELATE TO THIS WORK. NO ADDITIONAL COMPENSATION SHALL BE ALLOWED DUE TO LACK OF THIS KNOWLEDGE.
- C. PROVIDE ALL MATERIALS FOR A COMPLETE INSTALLATION IN ALL RESPECTS READY FOR INTENDED USE AND IN STRICT ACCORDANCE WITH STATE AND LOCAL CODES AND MANUFACTURER'S RECOMMENDATIONS.
- D. COORDINATE SEWER AND WATER CONNECTIONS WITH CIVIL AND A.H.J. PROVIDE PRESSURE REDUCING VALVE AND BACKFLOW PREVENTER AS SHOWN OR REQUIRED BY A.H.J. VERIFY INVERT AND SLOPE OF INCOMING SANITARY SEWER BEFORE TRENCHING.
- E. REFER TO RISER DIAGRAMS AND PLUMBING FIXTURE SCHEDULE FOR ALL PIPING AND PIPE SIZES NOT SHOWN ON PLAN.
- F. SANITARY AND STORM SEWER PIPING SHOWN IS BASED ON 1/4" PER FOOT FALL FOR ALL PIPE. NOTIFY 7-11 CM IF THE SLOPE CANNOT BE ACHIEVED.
- G. ALL SEWER PIPING BELOW SLAB TO BE 2" DIAMETER MINIMUM.
- H. PROVIDE ACCESS DOORS TO ALL CONCEALED VALVES AND CLEAN-OUTS; AND NOT ABOVE AN ACCESSIBLE CEILING.
- I. PROVIDE TRAP SEAL PRIMERS AND 1/2" COPPER TUBING CONNECTION TO ALL FLOOR DRAINS AS SHOWN OR AS REQUIRED BY A.H.J. CONTRACTOR SHALL VERIFY REQUIREMENTS.
- J. INSTALL VTR'S, EXHAUST FANS, AND FLUES A MINIMUM 5'-0" FROM PARAPET OR OUTSIDE WALL AND 10'-0" MINIMUM FROM EQUIPMENT WITH OUTSIDE AIR INTAKE.
- K. INSTALL WATER PIPE ON INSIDE OF EXTERIOR WALL INSULATION TO PREVENT FREEZING.
- L. WHEN DEEP FROST LOCATIONS ARE ENCOUNTERED, ROUTE SANITARY LINES UNDER BUILDING AS MUCH AS POSSIBLE.
- M. PROVIDE PVC SLEEVE FOR ALL COLD/HOT WATER FLOOR PIPE PENETRATIONS. MAKE SLEEVE LARGE ENOUGH FOR INSULATION. SEAL WITH GRAY MASTIC AND ENSURE OF NO WATER PENETRATIONS.
- N. PROVIDE AND INSTALL WATTS BA VACUUM BREAKER ON ANY THREADED EXTERIOR OR INTERIOR FAUCETS.
- O. ALL WATER SHUT-OFF VALVES SHALL BE "BALL LOCK" TYPE. PROVIDE SHUT-OFF VALVES AT EACH TERMINATION POINT OF ASSOCIATED EQUIPMENT.
- P. PROVIDE SEISMIC BRACING BASED ON APPROPRIATE SEISMIC ZONE REQUIREMENTS PER LOCAL AND NATIONAL CODES. CONTRACTOR'S RESPONSIBILITY INCLUDES STRUCTURAL ENGINEER'S CERTIFICATION ON DETAILS SUBMITTED FOR PERMITTING.

KEY NOTES

1. PLUMBING CONTRACTOR TO PROVIDE FULL SIZE DRAINS FROM BEVERAGE EQUIPMENT TO FS WITH AIR GAP (TYP).
2. ROUTE CONDENSATE DRAIN FROM COOLER/FREEZER EVAPORATOR TIGHT TO HUB DRAIN. FREEZER AND BEER CAVE CONDENSATE PIPING SHALL HAVE HEAT TRACE. SEE ELECTRICAL SPECIFICATIONS 3.5.12 FOR HEAT TRACE REQUIREMENTS.
3. ROUTE FULL SIZE DRAIN FROM DUMP SINK (S4) TO FS WITH AN APPROVED AIR GAP.
4. ROUTE FULL SIZE SCH 80 PVC DRAINS FROM 3 COMPARTMENT SINK (S2) TO FS WITH AN APPROVED AIR GAP. SEE DETAIL 3/P2.0 FOR MORE INFORMATION.
5. PLACE CLEANOUT AT EVERY CHANGE OF DIRECTION IN CONDENSATE PIPING (TYPICAL).
6. PROVIDE HUB DRAIN WITH P-TRAP FOR CONDENSATE DISPOSAL ROUTE AS SHOWN ON PLAN. COORDINATE FINAL CONNECTION WITH CIVIL SITE UTILITY PLANS.
7. 4" SEWER, REFER TO CIVIL DRAWINGS FOR CONTINUATION.
8. REFER TO CIVIL SITE DRAWINGS FOR DISTANCE AND EXACT LOCATION FOR POINTS OF CONNECTION.

PLUMBING SYMBOLS

SS	SANITARY SEWER
GW	GREASE WASTE
—	DOMESTIC COLD WATER
—	DOMESTIC HOT WATER
—	DOMESTIC HOT WATER RETURN
FW	FILTERED WATER
G	NATURAL GAS
CD	CONDENSATE DRAIN
—	PLUMBING VENT
—	UNION
—	ELBOW - TURNED DOWN
—	ELBOW - TURNED UP
—	TEE - TURNED DOWN
—	TEE - TURNED UP
—	BALL VALVE
—	SHUT-OFF VALVE IN VERTICAL LINE
—	BACKFLOW PREVENTER
FD	FLOOR DRAIN
FS	FLOOR SINK
FCO	FLOOR CLEANOUT
YCO	YARD CLEANOUT
FPWH	FREEZE PROOF WALL HYDRANT
HB	HOSE BIBB
WCO	WALL CLEANOUT
—	GAS PRESSURE REGULATOR
—	GAS COCK

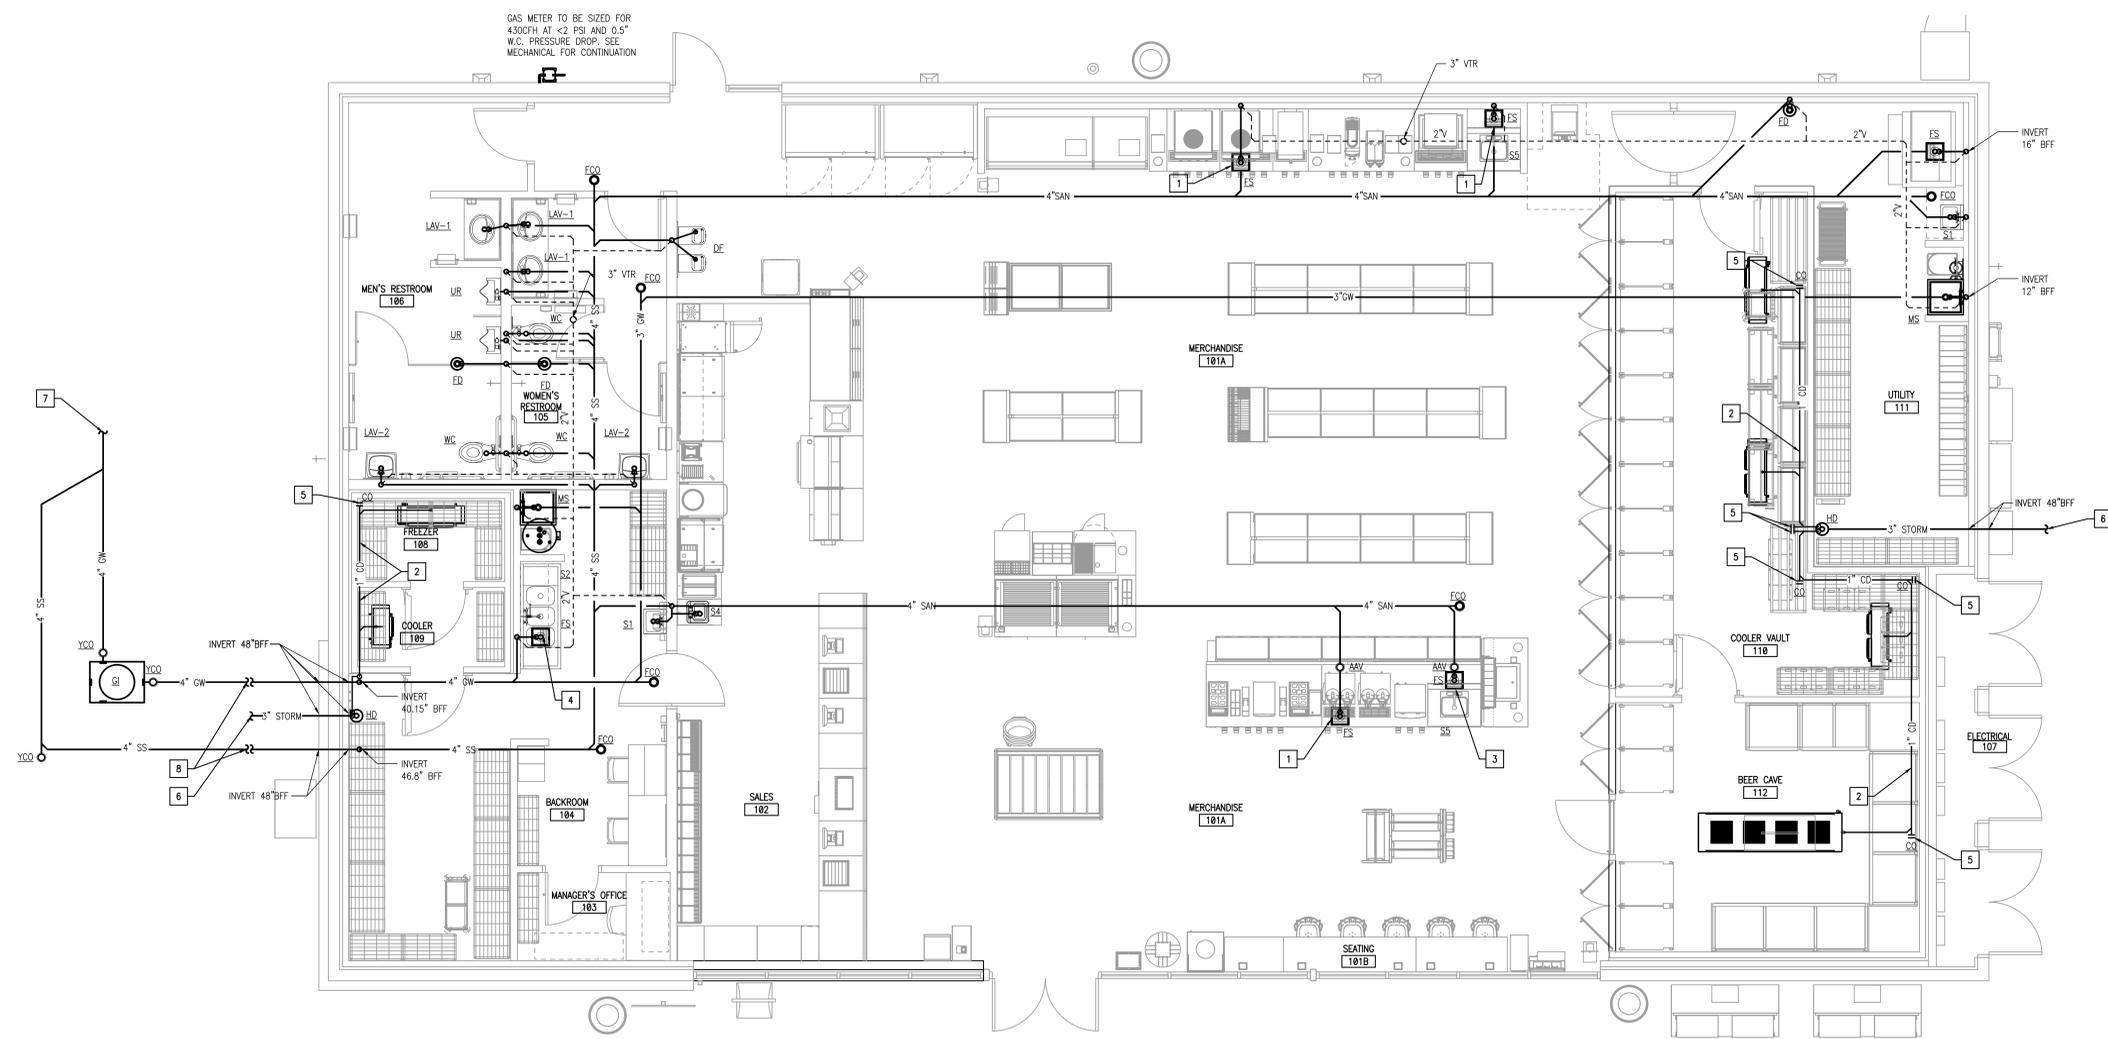

1 PLUMBING SANITARY PLAN 1/4" = 1'-0"



NO DATE REMARKS
REVISIONS




7-ELEVEN
STORE #42379

SEC 58TH AVE AND 92ND LOOP
BELLEVUE FL 34480


PROJECT NO: 2022.0783
DATE: FEBRUARY 26, 2024

P1.0
DRAIN PIPING PLAN


CHECKED: DAK DRAWN: IC
ANGMEN - 04/02/2024 12:36:49 PM

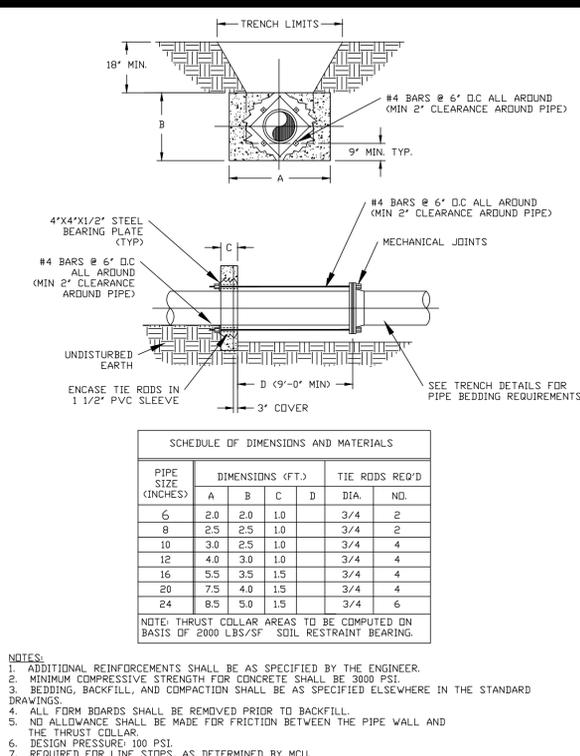


NOTES:
 1. ADDITIONAL REINFORCEMENTS SHALL BE AS SPECIFIED BY THE ENGINEER.
 2. MINIMUM COMPRESSIVE STRENGTH FOR CONCRETE SHALL BE 3000 PSI.
 3. BEDDING, BACKFILL, AND COMPACTION SHALL BE AS SPECIFIED ELSEWHERE IN THE STANDARD DRAWINGS.
 4. ALL FORM BOARDS SHALL BE REMOVED PRIOR TO BACKFILL.
 5. NO ALLOWANCE SHALL BE MADE FOR FRICTION BETWEEN THE PIPE WALL AND THE THRUST COLLAR.
 6. DESIGN PRESSURE: 100 PSI.
 7. REQUIRED FOR LINE STOPS, AS DETERMINED BY MCI.

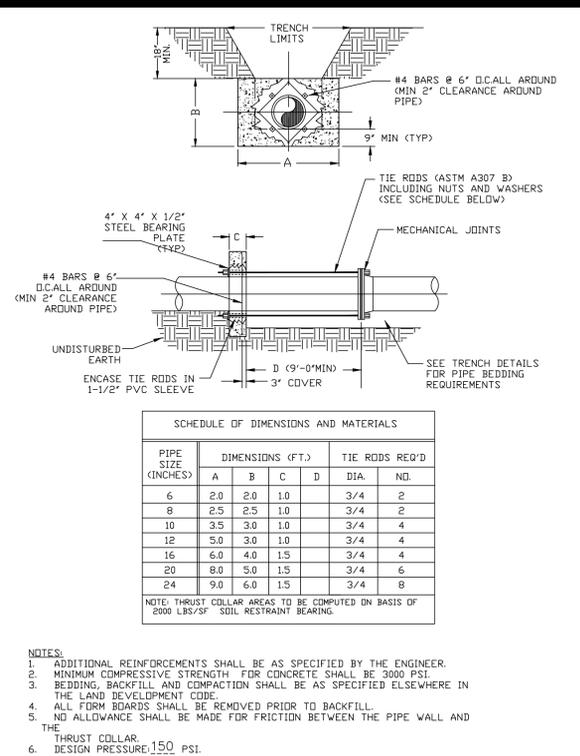


NOTES:
 1. ADDITIONAL REINFORCEMENTS SHALL BE AS SPECIFIED BY THE ENGINEER.
 2. MINIMUM COMPRESSIVE STRENGTH FOR CONCRETE SHALL BE 3000 PSI.
 3. BEDDING, BACKFILL, AND COMPACTION SHALL BE AS SPECIFIED ELSEWHERE IN THE STANDARD DRAWINGS.
 4. ALL FORM BOARDS SHALL BE REMOVED PRIOR TO BACKFILL.
 5. NO ALLOWANCE SHALL BE MADE FOR FRICTION BETWEEN THE PIPE WALL AND THE THRUST COLLAR.
 6. DESIGN PRESSURE: 150 PSI.

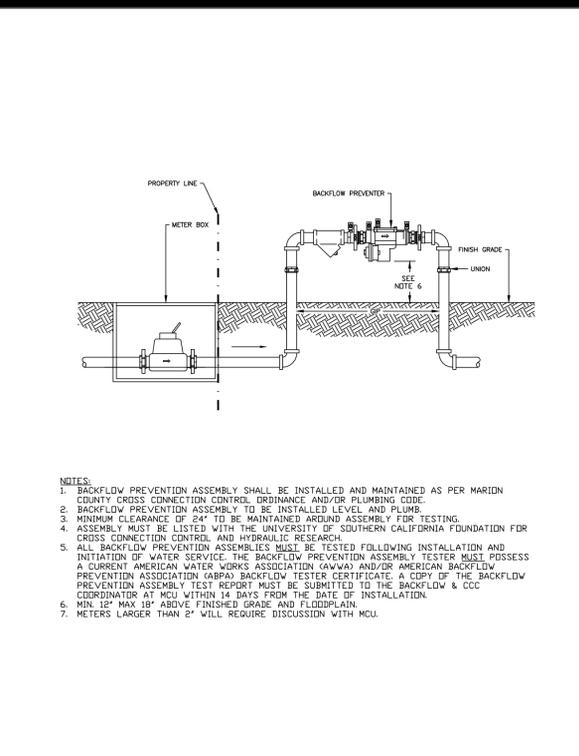


7.3.2
 UT 201

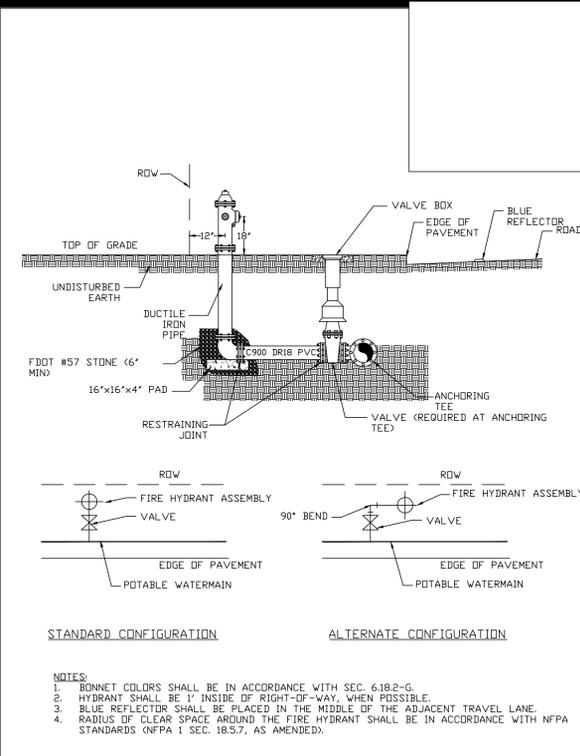


7.3.2
 UT 209

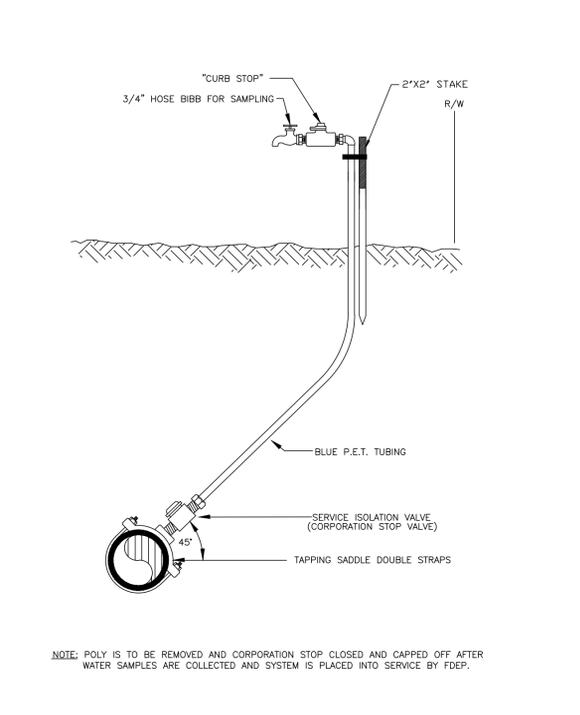


7.3.2
 UT 211

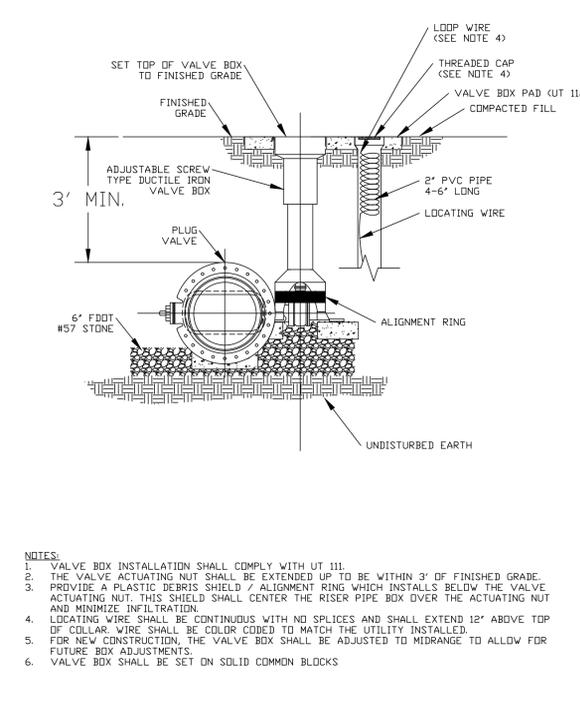

7.3.2
 UT 304

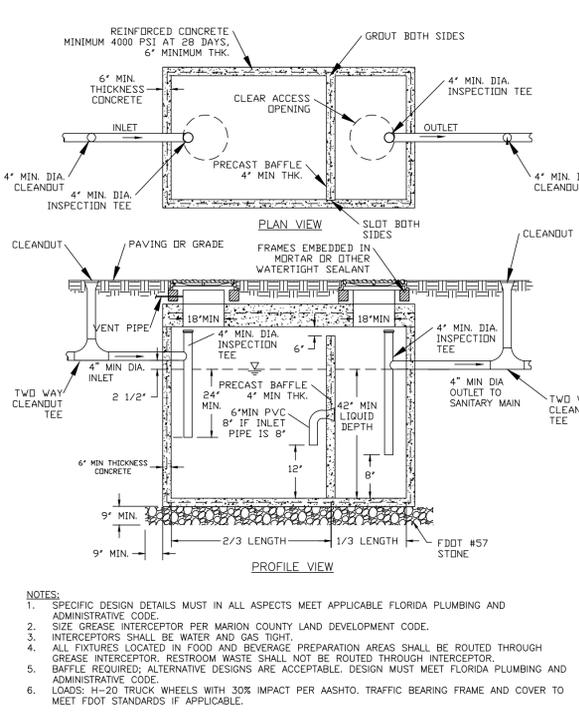

7.3.2
 UT 310

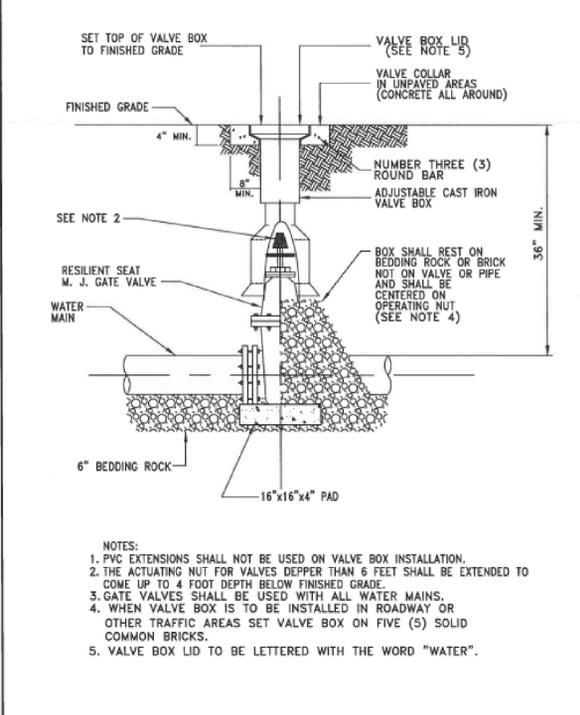

7.3.2
 UT 200

R.K.M. DEVELOPMENT CORP.

COMMON OAK ENGINEERING
 4016 EDGEWATER DRIVE
 ORLANDO, FL 32804
 (407) 951-5915
 CERTIFICATE OF AUTHORIZATION: 32644

MAJOR SITE PLAN
 7-ELEVEN
 AT SEC OF SE 92ND LP
 SE 58TH AVE
 BELLEVUE, FL
 MARION COUNTY

NO.	DATE	REVISION / ISSUE	CITY OF BELLEVUE UTILITY COMMENTS
3	12/07/2024		

ENGINEER'S NAME & PE#
 JEREMY R. ANDERSON, P.E.
 P.E. LICENSE NO. 71636

PROJECT #
 222.108

DATE SHEET
 05/13/2024
 SCALE
 N.T.S.

UTILITY DETAILS

Jeremy R. Anderson, State of Florida, Professional Engineer, License No. 71636
 This item has been digitally signed and sealed by Jeremy R. Anderson, PE, on the date indicated here.
 Printed copies of this document are not considered signed and sealed and the signature must be verified on any electronic copies.

