



SUBMITTAL SUMMARY REPORT PrelimPlat-000069-2025

PLAN NAME: Calesa Township - Sabino (Grove)	LOCATION:
APPLICATION DATE: 11/21/2025	PARCEL: 35300-000-14
DESCRIPTION: Pre-Plat for a single-family development phase. Applies to a portion of the parcel - once platted, new parcel numbers will be assigned for the new resulting properties.	

CONTACTS	NAME	COMPANY
Applicant	Kimley Horn	KIMLEY-HORN AND ASSOCIATES, INC
Applicant	Kimley Horn	KIMLEY-HORN AND ASSOCIATES, INC
Engineer of Record	Gene Losito	Kimley-Horn and Associates, Inc.

SUBMITTAL	STARTED	DUE	COMPLETE	STATUS
OCE: Plan Review (DR) v.				Not Received
OCE: Plan Review (DR) v.	12/09/2025	12/23/2025	01/20/2026	Requires Re-submit

SUBMITTAL DETAILS

OCE: Plan Review (DR) v.1				
ITEM REVIEW NAME (DEPARTMENT)	ASSIGNED TO	DUE	COMPLETE	STATUS
911 Management (DR) (911 Management)	Kristie Wright	12/23/2025	12/19/2025	Requires Re-submit
<i>Corrections</i>	2.12.28 - Road identification (Not Resolved) - 2.12.28 - Road identification: All roads shall be identified by quadrant number as assigned by Marion County 911 Management. Road names have been labeled on Sheet C002. SW 73rd Court Rd is labeled incorrectly as SW 73rd St on Sheets C002 & C004			
Environmental Health (Plans) (Environmental Health)	Evan Searcy	12/23/2025	01/08/2026	Approved
Fire Marshal (Plans) (Fire)	Jonathan Kenning	12/23/2025	12/09/2025	Approved
Growth Services Planning & Zoning (DR) (GS Planning and Zoning)	Kenneth Odom	12/23/2025	12/24/2025	Approved
Landscape (Plans) (Parks and Recreation)	Susan Heyen	12/23/2025	12/10/2025	Approved
OCE Design (Plans) (Office of the County Engineer)	Jack Dingman	12/23/2025	01/16/2026	Approved
<i>Corrections</i>	6.2.1.B.-F. - Requirements (Resolved) - 6.2.1.B.-F. - Requirements: Technical standards and requirements as listed in Section 6.2.1.B. through F. of the LDC			
<i>Corrections</i>	2.12.4.I & 6.2.1.D - Index of sheets and numbering (Resolved) - 2.12.4.I & 6.2.1.D - Index of sheets and numbering: Index of sheets; All sheets shall indicate each sheet number and the total number of sheets. Cross references between sheets is required			
<i>Corrections</i>	Additional Design Comments (Resolved) - Additional Comments:			
<i>Corrections</i>	2.1.3 - Order of plan approval (Resolved) - 2.1.3 - Order of plan approval: Plans listed may be reviewed concurrently, but must be approved in the order listed at the link below, when applicable and when the proper land use and zoning are in place			
<i>Corrections</i>	2.12.3 - Title block (Resolved) - 2.12.3 - Title block: Title block on all sheets denoting type of application; project name, location, county, and state; and date of original and all revisions			
<i>Corrections</i>	Rezoning to PUD with master plan (Resolved) - Rezoning to PUD with master plan:			
<i>Corrections</i>	2.12.4 - Front page of the plan (Resolved) - 2.12.4 - Front page of the plan: Front page of the plan shall minimally include A through L of this section of the LDC.			
<i>Corrections</i>	2.12.4.E & 6.2.1.A - Licensed Professional (Resolved) - 2.12.4.E & 6.2.1.A - Licensed Professional: 2.12.4.E & 6.2.1.A - The name, address, phone number, signature, date, license number, and seal of the responsible professional shall be shown on each plan sheet			

SUBMITTAL SUMMARY REPORT (PrelimPlat-000069-2025)

ITEM REVIEW NAME (DEPARTMENT)	ASSIGNED TO	DUE	COMPLETE	STATUS
OCE Property Management (Plans) (Office of the County Engineer)		12/23/2025	01/06/2026	Informational
<i>Comments</i>	IF APPLICABLE: Sec. 2.18.1.I - Show connections to other phases. Sec.2.19.2.H – Legal Documents Legal documents such as Declaration of Covenants and Restrictions, By-Laws, Articles of Incorporation, ordinances, resolutions, etc. Sec. 6.3.1.B.1 – Required Right of Way Dedication (select as appropriate) For Public Streets. "[All streets and rights-of-way shown on this plat or name specifically if less than all] are hereby dedicated for the use and benefit of the public." Sec. 6.3.1.B.2 – Required Right of Way Dedication For Non-Public Streets. "[All streets and rights-of-way shown on this plat or name specifically if less than all] are hereby dedicated privately to the [entity name]. All public authorities and their personnel providing services to the subdivision are granted an easement for access. The Board of County Commissioners of Marion County, Florida, shall have no responsibility, duty, or liability whatsoever regarding such streets. Marion County is granted an easement for emergency maintenance in the event of a local, state, or federal state of emergency wherein the declaration includes this subdivision or an emergency wherein the health, safety, or welfare of the public is deemed to be at risk." Sec. 6.3.1.D.3 - Cross Access Easements For Cross Access Easements. "All parallel access easements shown on this plat are hereby dedicated for the use and benefit of the public, and maintenance of said easements is the responsibility of [entity name]." Sec. 6.3.1.C.1 - Utility Easements (select as appropriate) "[All utility easements shown or noted or name specifically if less than all] are dedicated [private or to the public] for the construction, installation, maintenance, and operation of utilities by any utility provider." Sec. 6.3.1.C.2 – Utility Easements "[All utility tracts or identify each tract as appropriate] as shown are dedicated [private or to the public] for the construction and maintenance of such facilities." Sec.6.3.1.D(c)(1)(2)(3) - Stormwater easements and facilities, select as appropriate: 1. "[All stormwater and drainage easements as shown or noted or name specifically if less than all] are dedicated [private or to the public] for the construction and maintenance of such facilities." 2. "[All stormwater management tracts or identify each tract as appropriate] as shown are dedicated [private or to the public] for the construction and maintenance of such facilities." 3. When any stormwater easement and/or management tract is not dedicated to the public or Marion County directly, the following statement shall be added to the dedication language: "Marion County is granted the right to perform emergency maintenance on the [stormwater easement and/or management tract, complete accordingly] in the event of a local, state, or federal state of emergency wherein the declaration includes this subdivision or an emergency wherein the health, safety, or welfare of the public is deemed to be at risk." Sec.6.3.1.D(f) – If a Conservation Easement is required the following shall be provided: "A conservation easement [as shown or on tract and identify the tract, complete accordingly] is dedicated to [the Board of County Commissioners of Marion County, Florida or entity name, if not Marion County] for the purpose of preservation of [listed species, habitat, Karst feature and/or native vegetation, complete accordingly]." 			
OCE Stormwater (Permits & Plans) (Office of the County Engineer)	Alexander Turnipseed	12/23/2025	12/11/2025	Informational
<i>Comments</i>	Please ensure the criteria of LDC Section 6.13 is satisfied with the Improvement Plan.			
OCE Survey (Plans) (Office of the County Engineer)	Theresa Smail	12/23/2025	12/17/2025	Requires Re-submit
<i>Corrections</i>	6.2.1.A. - Licensed Professional (Not Resolved) - 6.2.1.A. - Licensed Professional: Plans shall be prepared by a professional licensed by the State of Florida. The name, street address, signature, date, license number, and seal of the responsible professional shall be shown on each plan sheet. The same shall be provided on the cover page of any supporting documents and calculations.			
<i>Corrections</i>	6.2.1.F - North Arrow (Not Resolved) - 6.2.1.F - North Arrow: Provide north arrow and graphic drawing and written scale			
<i>Corrections</i>	2.12.8 - Current boundary and topographic survey (Not Resolved) - 2.12.8 - Current boundary and topographic survey: Current boundary and topographic survey (one foot contour intervals extending 100 feet beyond the project boundary) based upon accepted vertical datum. Surveys will be less than 12 months old and accurately reflect current site conditions, meeting standards set forth in Ch. 5J-17 FAC. Alternate topographic data may be accepted if pre-approved by the Marion County Land Surveyor.			
<i>Corrections</i>	6.2.1.E - Drawing legend (Not Resolved) - 6.2.1.E - Drawing legend: Provide a drawing legend as needed.			
<i>Corrections</i>	6.4.3 - Preliminary Plat Requirements (Not Resolved) - 6.4.3 - Preliminary Plat Requirements: All plats and surveys shall adhere to the minimum plan requirements in Division 2 and the requirements listed in Section 6.4.3.A. through M. of the LDC.			
<i>Corrections</i>	Additional Survey Comments (Not Resolved) - Additional Survey Comments			
OCE Traffic (Permits & Plans) (Office of the County Engineer)	Chris Zeigler	12/23/2025	12/10/2025	Requires Re-submit
<i>Corrections</i>	6.12.9 - Subdivision roads (Not Resolved) - 6.12.9 - Subdivision roads : Subdivision roads must meet the design requirements in Section 6.12.9.			
<i>Corrections</i>	Additional Traffic Comments (Not Resolved) - Additional Traffic Comments			
<i>Corrections</i>	6.12.2 - Right-of-way (Not Resolved) - 6.12.2 - Right-of-way: Show the right-of-way width.			
<i>Corrections</i>	6.11.5.D - Residential driveway requirements (Not Resolved) - 6.11.5.D - Residential driveway requirements: Show the residential driveway requirements			
<i>Corrections</i>	2.17.2.I - Road geometrics (Not Resolved) - 2.17.2.I - Road geometrics : Show bearings, distances, curve data, length of tangents, radii, arcs, chords and central angles for all rights-of-way, and centerline curves on streets.			
Utilities (OCE Plans) (Utilities)	Heather Proctor	12/23/2025	12/30/2025	Informational
<i>Comments</i>	The project is located within the Bay Laurel Center Community Development District. Please provide a letter confirming that the Bay Laurel Center Community Development District has the capacity and availability within its system to serve this project.			

SUBMITTAL SUMMARY REPORT (PrelimPlat-000069-2025)

eREVIEW SESSION FILES:

- 01- Aerial Map.pdf
- 02-Location Map.pdf
- 03-Quad Map.pdf
- 04-FEMA Map.pdf
- 05-Soils Map.pdf
- 06-National Wetland Map.pdf
- Calesa PUD Mstr Pln MC Appr 2018010024 #28323 10_24_24.pdf
- Calesa Township Sabino Pre-Plat - 2025-11-21.pdf
- Geo-Tech Report No. 25-1167.5815.1 - Sabino.pdf
- L.00A.pdf

REVIEWER	MARKUP	DATE/TIME	FILE NAME	PG #
Chris Zeigler	The minimum right-of-way width approved in the master plan is 40'	12/10/2025 3:28	PMCalesa Township Sabino Pre-Plat - 2025-11-21.pdf	2
Chris Zeigler	The design speed is required to be 30mph unless otherwise waived. A 15 mph speed limit is not allowed under Florida Statutes.	12/10/2025 3:29	PMCalesa Township Sabino Pre-Plat - 2025-11-21.pdf	2
Chris Zeigler	A 4 lane divided roadway is not a subdivision street. This should be classified as a Major Local at the least and must meet Major Local roadway design requirements. The design speed is required to be 40mph. Speed limits less than 20 mph are not allowed under Florida Statutes	12/10/2025 3:33	PMCalesa Township Sabino Pre-Plat - 2025-11-21.pdf	2
Chris Zeigler	The typical section on the previous sheet shows 120' right-of-way. There is also not an approved typical section in the Master Plan with 100' right-of-way.	12/10/2025 3:43	PMCalesa Township Sabino Pre-Plat - 2025-11-21.pdf	3
Chris Zeigler	See comments on typical section regarding 30' right-of-way.	12/10/2025 3:44	PMCalesa Township Sabino Pre-Plat - 2025-11-21.pdf	3
Chris Zeigler	Label right-of-way width	12/10/2025 3:51	PMCalesa Township Sabino Pre-Plat - 2025-11-21.pdf	3
Chris Zeigler	Centerline curve data is missing	12/10/2025 3:54	PMCalesa Township Sabino Pre-Plat - 2025-11-21.pdf	8
Kristie W	SW 52ND PL	12/16/2025 8:39	PMCalesa Township Sabino Pre-Plat - 2025-11-21.pdf	2
Kristie W	SW 74TH AVE	12/16/2025 8:42	PMCalesa Township Sabino Pre-Plat - 2025-11-21.pdf	2
Kristie W	SW 74TH TERRACE RD	12/16/2025 8:46	PMCalesa Township Sabino Pre-Plat - 2025-11-21.pdf	2
Kristie W	SW 52ND LN	12/16/2025 8:50	PMCalesa Township Sabino Pre-Plat - 2025-11-21.pdf	2
Kristie W	SW 52ND LOOP	12/16/2025 8:51	PMCalesa Township Sabino Pre-Plat - 2025-11-21.pdf	2
Kristie W	SW 52ND ST	12/16/2025 8:51	PMCalesa Township Sabino Pre-Plat - 2025-11-21.pdf	2
Kristie W	SW 52ND LOOP	12/16/2025 8:52	PMCalesa Township Sabino Pre-Plat - 2025-11-21.pdf	2
Kristie W	SW 52ND LOOP	12/16/2025 8:52	PMCalesa Township Sabino Pre-Plat - 2025-11-21.pdf	2
Kristie W	SW 75TH TER	12/16/2025 8:53	PMCalesa Township Sabino Pre-Plat - 2025-11-21.pdf	2
Kristie W	SW 75TH COURT RD	12/16/2025 8:55	PMCalesa Township Sabino Pre-Plat - 2025-11-21.pdf	2
Kristie W	SW 75TH COURT RD	12/16/2025 8:59	PMCalesa Township Sabino Pre-Plat - 2025-11-21.pdf	2
Kristie W	SW 76TH AVENUE RD	12/16/2025 9:00	PMCalesa Township Sabino Pre-Plat - 2025-11-21.pdf	2
Kristie W	SW 54TH LN	12/16/2025 9:02	PMCalesa Township Sabino Pre-Plat - 2025-11-21.pdf	2
Kristie W	SW 73RD COURT RD	12/16/2025 9:07	PMCalesa Township Sabino Pre-Plat - 2025-11-21.pdf	2
Kristie W	SW 73RD COURT RD	12/16/2025 9:11	PMCalesa Township Sabino Pre-Plat - 2025-11-21.pdf	4
Kristie W	SW 73RD COURT RD	12/16/2025 9:12	PMCalesa Township Sabino Pre-Plat - 2025-11-21.pdf	7
Kristie W	SW 74TH CT	12/16/2025 9:26	PMCalesa Township Sabino Pre-Plat - 2025-11-21.pdf	2
Kristie W	SW 53RD LN	12/16/2025 9:27	PMCalesa Township Sabino Pre-Plat - 2025-11-21.pdf	2



**Marion County
Board of County Commissioners**

Office of the County Engineer

412 SE 25th Ave.
Ocala, FL 34471
Phone: 352-671-8686
Fax: 352-671-8687

DEVELOPMENT REVIEW COMMITTEE WAIVER REQUEST FORM

Date: 2/19/2026 Parcel Number(s): 35300-000-14 Permit Number: 000069

A. PROJECT INFORMATION: Fill in below as applicable:

Project Name: Calesa Township - Sabino Commercial Residential
Subdivision Name (if applicable): _____
Unit _____ Block _____ Lot _____ Tract _____

B. PROPERTY OWNER'S AUTHORIZATION: The property owner's signature authorizes the applicant to act on the owner's behalf for this waiver request. The signature may be obtained by email, fax, scan, a letter from the property owner, or original signature below.

Name (print): Colen Built Developments, LLC
Signature: _____
Mailing Address: 8445 SW 80th St Rd City: Ocala
State: FL Zip Code: 33481 Phone # 352-387-7480
Email address: _____

C. APPLICANT INFORMATION: The applicant will be the point of contact during this waiver process and will receive all correspondence.

Firm Name (if applicable): Kimley-Horn and Associates, Inc. Contact Name: Gene Losito
Mailing Address: 1700 SE 17th Street, Suite 200 City: Ocala
State: FL Zip Code: 34471 Phone # 352-438-3000
Email address: _____


D. WAIVER INFORMATION:

Section & Title of Code (be specific): 6.12.9.K - Subdivision Road Design Speed
Reason/Justification for Request (be specific): Waiver request to reduce the design speed of the subdivision roads to 20mph. Curve warning signage to be installed for curves that do not meet the 20mph design speed.

DEVELOPMENT REVIEW USE:




Received By: _____ Date Processed: _____ Project # _____ AR # _____

ZONING USE: Parcel of record: Yes No Eligible to apply for Family Division: Yes No
Zoned: _____ ESOZ: _____ P.O.M. _____ Land Use: _____ Plat Vacation Required: Yes No
Date Reviewed: _____ Verified by (print & initial): _____

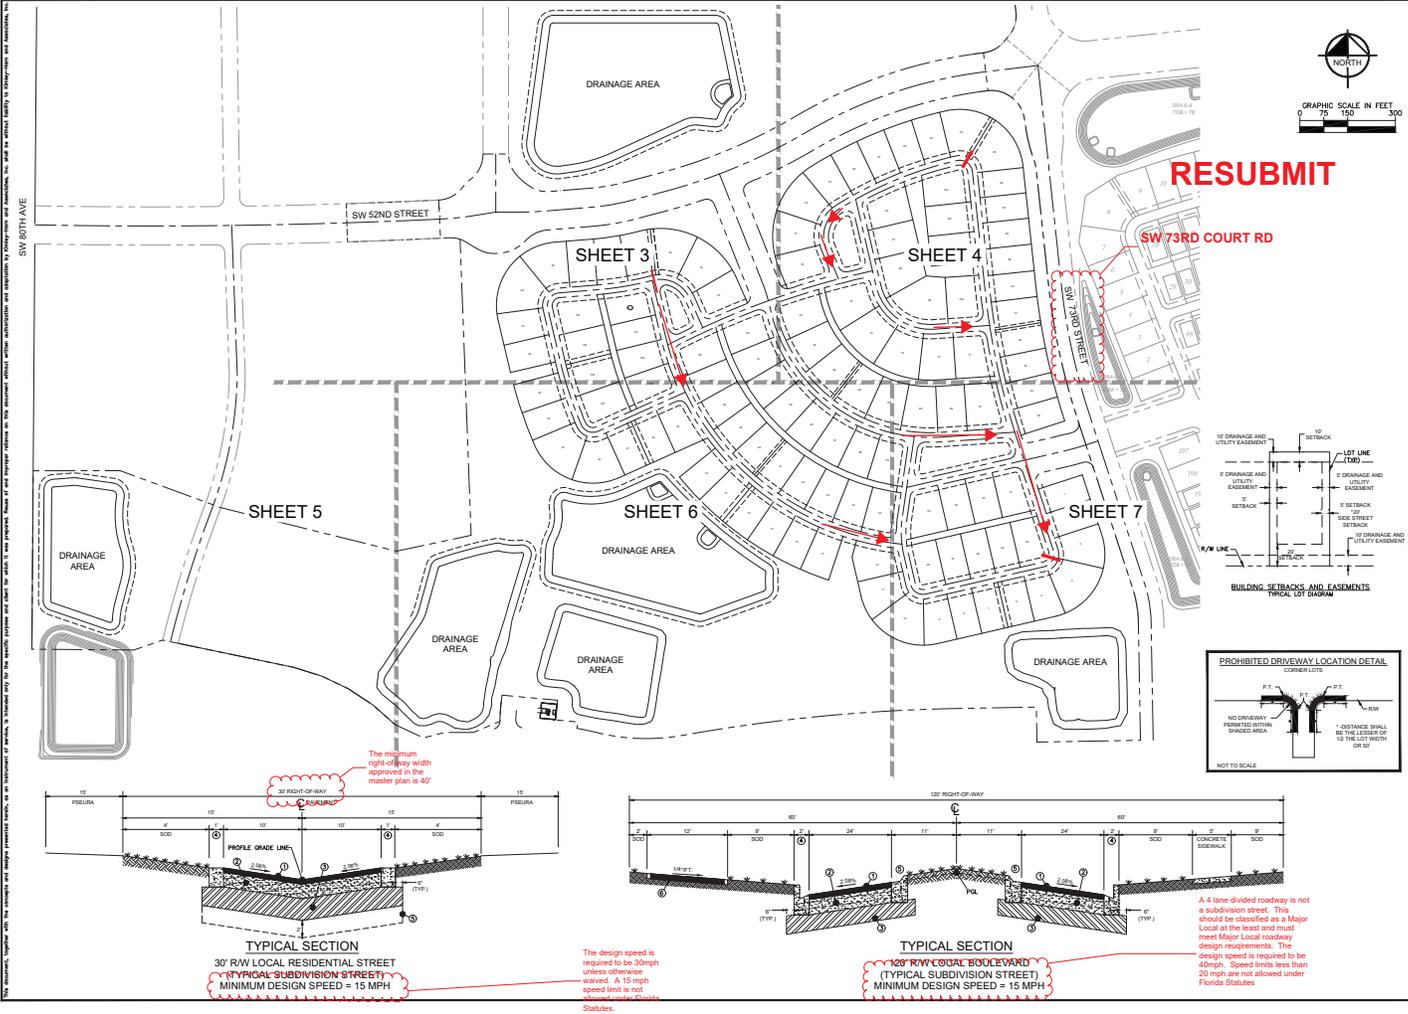


RESUBMIT

SW 73RD COURT RD

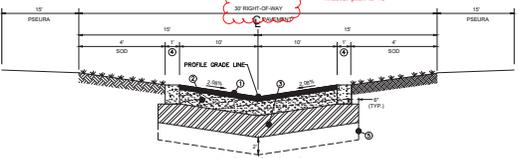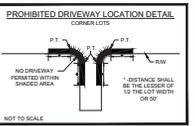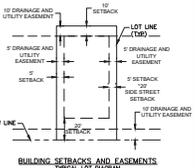

TYPICAL SECTION
 30' RW LOCAL RESIDENTIAL STREET
 (TYPICAL SUBDIVISION STREET)
 MINIMUM DESIGN SPEED = 15 MPH

The minimum right-of-way width approved in the master plan is 40'

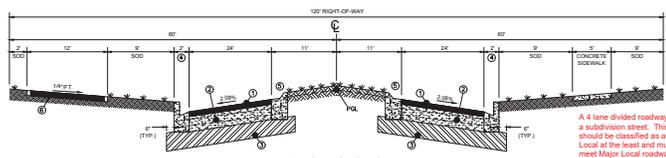

TYPICAL SECTION
 60' RW LOCAL BOULEVARD
 (TYPICAL SUBDIVISION STREET)
 MINIMUM DESIGN SPEED = 15 MPH


The design speed is required to be 30mph unless otherwise waived. A 15 mph speed limit is not allowed under Florida Statutes.

A 4-lane divided roadway is not a subdivision street. This should be classified as a Major Local at the least and must meet Major Local roadway design requirements. The design speed is required to be 40mph. Speed limits less than 20 mph are not allowed under Florida Statutes.


THIS DOCUMENT, TOGETHER WITH THE STREETS AND UTILITY PLANS, IS A PRELIMINARY DESIGN. IT IS SUBJECT TO THE APPROVAL OF THE LOCAL AGENCY AND THE STATE DEPARTMENT OF TRANSPORTATION. THE USER SHALL BE RESPONSIBLE FOR VERIFYING THE ACCURACY OF THE INFORMATION PROVIDED HEREIN. THE USER SHALL BE RESPONSIBLE FOR OBTAINING ALL NECESSARY PERMITS AND APPROVALS FROM THE APPROPRIATE AGENCIES. THE USER SHALL BE RESPONSIBLE FOR OBTAINING ALL NECESSARY PERMITS AND APPROVALS FROM THE APPROPRIATE AGENCIES. THE USER SHALL BE RESPONSIBLE FOR OBTAINING ALL NECESSARY PERMITS AND APPROVALS FROM THE APPROPRIATE AGENCIES.

PROJECT: 2427401015 DATE: 11/15/2024 DRAWING NO.: 74247	CLIENT: KIMLEY-HORN PROJECT: 2427401015 DATE: 11/15/2024 DRAWING NO.: 74247
INDEX OF SHEETS	
CALESA TOWNSHIP SABINO PREPARED FOR COLEN BUILT DEVELOPMENTS, LLC HAWKINS COUNTY, FLORIDA	
SHEET NUMBER C002	

RESUBMIT

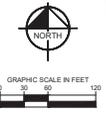

MATCHLINE - SEE SHEET C004
 MATCHLINE - SEE SHEET C003

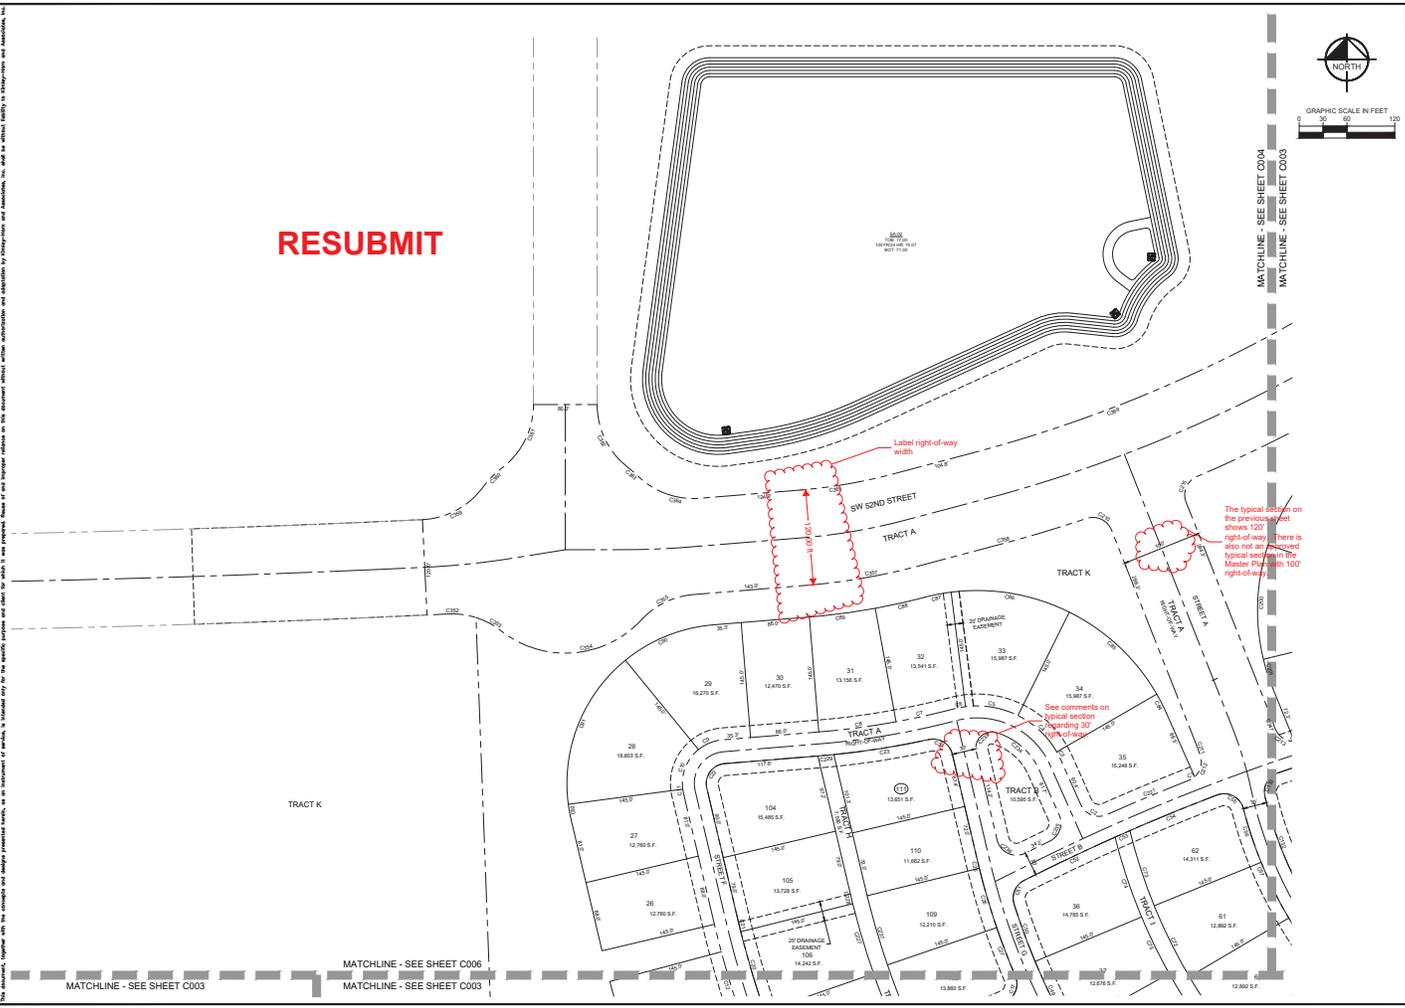


The typical section on the previous sheet shows 120' right-of-way. There is also not a proposed typical section in the Master Plan with 100' right-of-way.

See comments on typical section regarding 100' right-of-way.

<p>© 2020 Kimley-Horn and Associates, Inc. 1700 SE 17TH STREET, SUITE 200, OAKLAND, FL 32061 WWW.KIMLEY-HORN.COM RESUBMITTING 2020</p>	
PROJECT NUMBER 242740010	LICENSED PROFESSIONAL ENGINEER NOVEMBER 2020
SCALE AS SHOWN	FLORIDA LICENSE NUMBER 72477
DRAWN BY JAC	CHECKED BY JAC
DATE 11/11/20	DATE 11/11/20
PRELIMINARY PLAT	
CALESA TOWNSHIP SABINO PREPARED FOR COLEN BUILT DEVELOPMENTS, LLC BAYSON COUNTY, FLORIDA	
SHEET NUMBER C003	

THIS DOCUMENT, TOGETHER WITH THE SURVEY AND DESIGN INSTRUMENTS, IS THE SOLE PROPERTY OF KIMLEY-HORN AND ASSOCIATES, INC. NO PART OF THIS DOCUMENT IS TO BE REPRODUCED OR TRANSMITTED IN ANY FORM OR BY ANY MEANS, ELECTRONIC OR MECHANICAL, INCLUDING PHOTOCOPYING, RECORDING, OR BY ANY INFORMATION STORAGE AND RETRIEVAL SYSTEM, WITHOUT THE WRITTEN PERMISSION OF KIMLEY-HORN AND ASSOCIATES, INC.

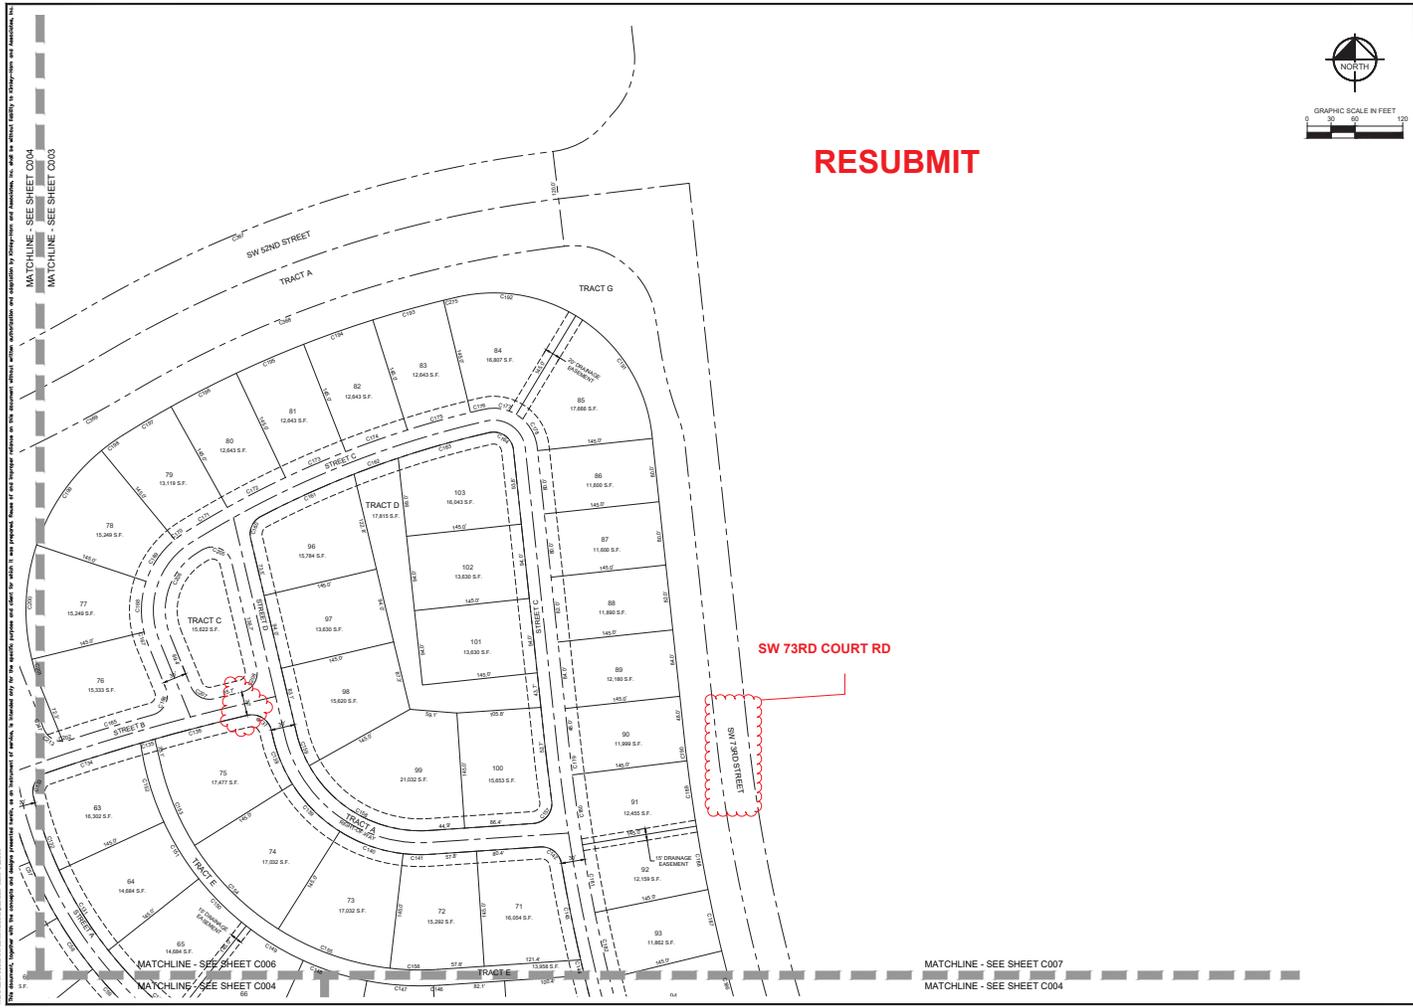


RESUBMIT

SW 73RD COURT RD


SW 73RD STREET

		GRAPHIC SCALE IN FEET 0 30 60 90 120	
Kimley Horn <small>© 2020 KIMLEY-HORN AND ASSOCIATES, INC. 1700 SE 17TH STREET, SUITE 200, OAKLAND, FLORIDA 32061 WWW.KIMLEY-HORN.COM RESUBMIT NO. 2020</small>		FLORIDA PROJECT NO. 242740010 DATE: 08/20/20 SCALE: AS SHOWN DRAWN BY: RHA CHECKED BY: JEC PROJECT NO.: 73477	
PRELIMINARY PLAT		CALESA TOWNSHIP SABINO PREPARED FOR COLEN BUILT DEVELOPMENT S, LLC MARION COUNTY, FLORIDA	
SHEET NUMBER C004		DATE: 11/21/20	


THIS DOCUMENT, TOGETHER WITH THE PLANS AND SPECIFICATIONS, IS THE PROPERTY OF KIMLEY-HORN AND ASSOCIATES, INC. IT IS TO BE USED ONLY FOR THE PROJECT AND SITE FOR WHICH IT WAS PREPARED. REUSE OF ANY PORTION HEREIN IN ANY MANNER WITHOUT THE WRITTEN CONSENT OF KIMLEY-HORN AND ASSOCIATES, INC. IS STRICTLY PROHIBITED.

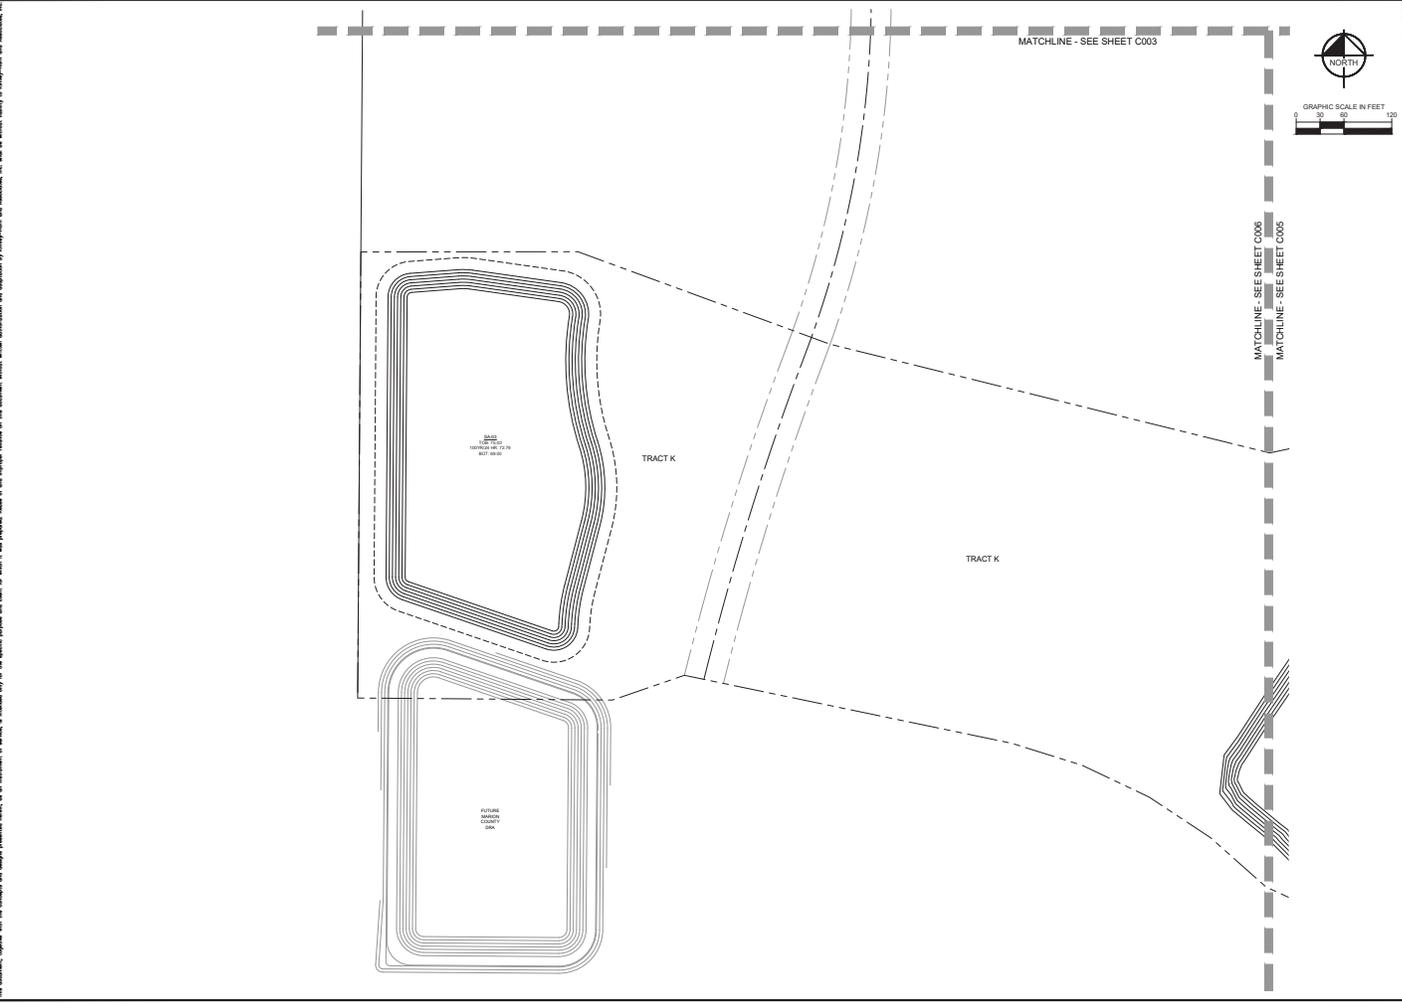

CALESA TOWNSHIP SABINO PREPARED FOR COLEN BUILT DEVELOPMENTS, LLC BARCELON COUNTY FLORIDA	PRELIMINARY PLAT	KIMLEY-HORN PROJECT 2427401016 DATE: NOVEMBER 2025 SCALE: AS SHOWN DRAWN BY: RHA CHECKED BY: JEC PROJECT NO.: 74247	LICENSED PROFESSIONAL ENGINEER LICENSE # FLORIDA LICENSE NUMBER 74247 DATE:
		1700 BEECH STREET, SUITE 200, COLUMBIA, SOUTH CAROLINA 29925 WWW.KIMLEY-HORN.COM REGISTRATION NO. 2006	
		SHEET NUMBER C005	
		DATE: 11/11/25	

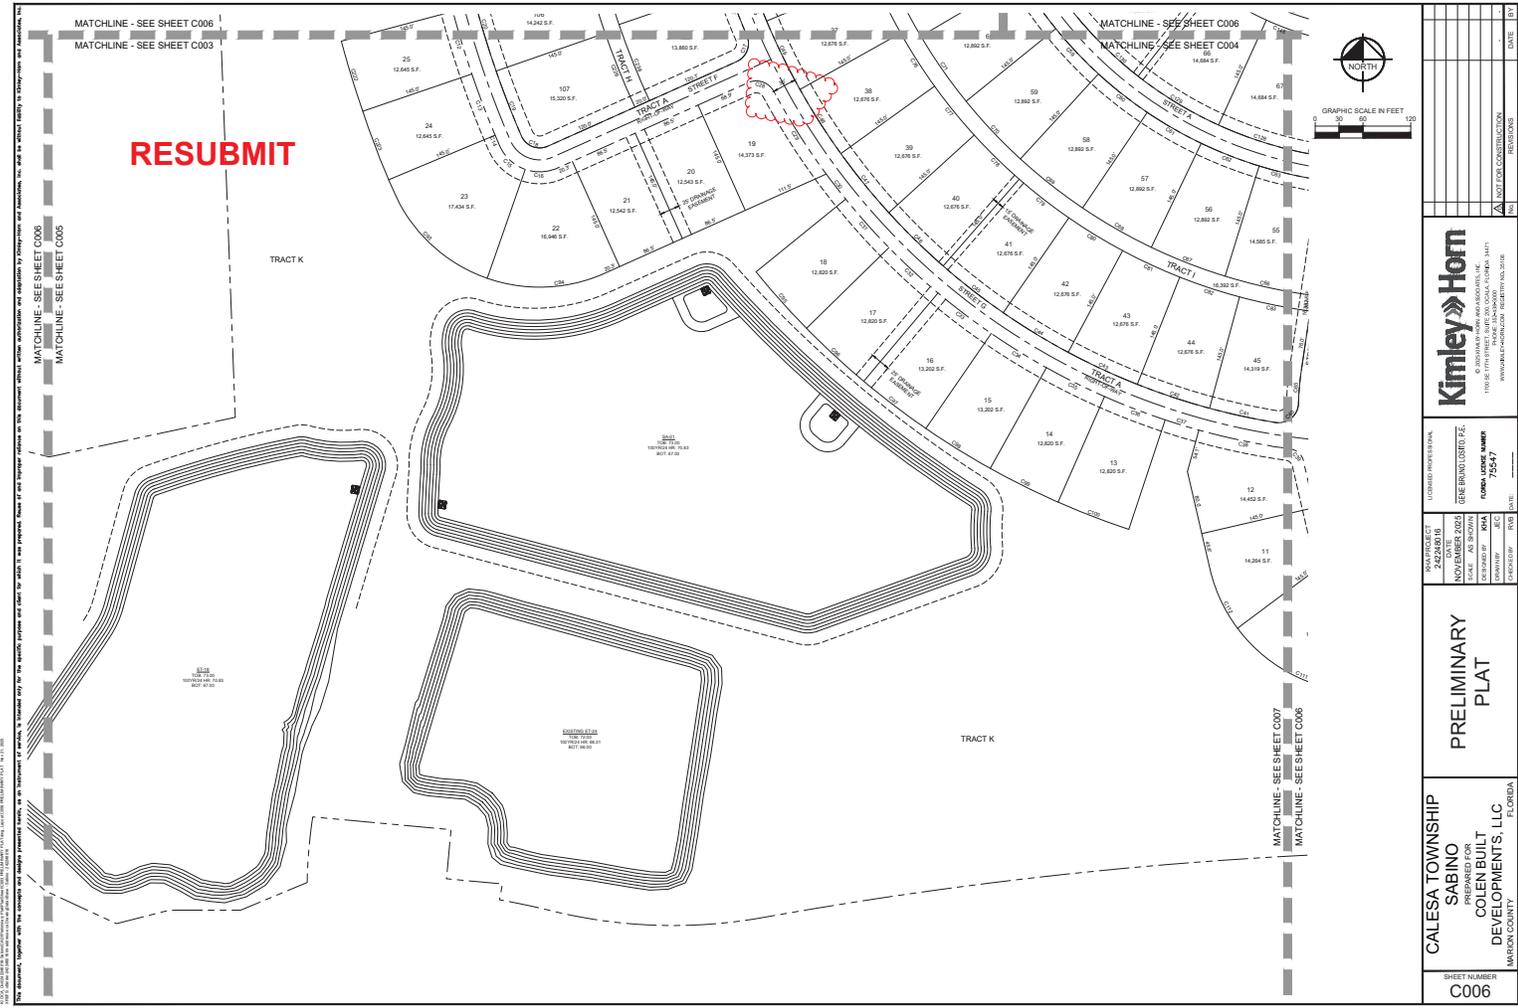

RESUBMIT

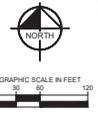

<p>CALESA TOWNSHIP SABINO PREPARED FOR COLEN BUILT DEVELOPMENT'S, LLC MARION COUNTY FLORIDA</p>		<p>PRELIMINARY PLAT</p>		<p>NOVA PROJECT 2427401015 NOVEMBER 2020 SCALE AS SHOWN DRAWN BY: RHA CHECKED BY: JEC PROJECT NO. 72477</p>		<p>LICENSURE PROFESSIONAL ENGINEER LICENSE NO. NOVEMBER 2020 SCALE AS SHOWN DRAWN BY: RHA CHECKED BY: JEC PROJECT NO. 72477</p>		<p>Kimley»Horn 1700 SE 17TH AVENUE, SUITE 200, GAINESVILLE, FL 32609 WWW.KIMLEY-HORN.COM</p>		<p>DATE: 11/11/20</p>
---	--	---	--	---	--	---	--	---	--	-----------------------

THIS DOCUMENT, TOGETHER WITH THE SURVEY AND ENGINEERING PLANS, IS THE PROPERTY OF KIMLEY-HORN AND ASSOCIATES, INC. AND IS NOT TO BE REPRODUCED OR TRANSMITTED IN ANY FORM OR BY ANY MEANS, ELECTRONIC OR MECHANICAL, INCLUDING PHOTOCOPYING, RECORDING, OR BY ANY INFORMATION STORAGE AND RETRIEVAL SYSTEM, WITHOUT THE WRITTEN PERMISSION OF KIMLEY-HORN AND ASSOCIATES, INC.

RESUBMIT

Centerline curve data is missing

Table with 6 columns: CURVE, RADIUS, LENGTH, CHORD BEARING, CHORD, DELTA, TANGENT. Contains curve data for curves C1 through C53.

Table with 6 columns: CURVE, RADIUS, LENGTH, CHORD BEARING, CHORD, DELTA, TANGENT. Contains curve data for curves C64 through C118.

Table with 6 columns: CURVE, RADIUS, LENGTH, CHORD BEARING, CHORD, DELTA, TANGENT. Contains curve data for curves C127 through C186.

Table with 6 columns: CURVE, RADIUS, LENGTH, CHORD BEARING, CHORD, DELTA, TANGENT. Contains curve data for curves C190 through C369.

Project information block including: CALESA TOWNSHIP, SABINO PREPARED FOR, COLEEN BUILT DEVELOPMENTS S, LLC, KIMLEY-HORN & ASSOCIATES, INC., and various project details.