

Prepared by and return to:

S. Denay Brown, Esq.
Stearns Weaver Miller Weissler
Alhadeff & Sitterson, P.A.
106 E. College Avenue, Suite 720
Tallahassee, FL 32301
Property Appraiser's Parcel ID (Folio)
Number: 35300-000-10

-----SPACE ABOVE THIS LINE RESERVED FOR RECORDING DATA-----

TEMPORARY CONSTRUCTION EASEMENT AGREEMENT

THIS TEMPORARY CONSTRUCTION EASEMENT AGREEMENT (this “**Easement Agreement**”) is granted this ____ day of _____, 2026 (“**Effective Date**”), by and between BAY LAUREL CENTER COMMUNITY DEVELOPMENT DISTRICT, a Florida community development district, whose address is 219 E. Livingston Street Orlando, Florida 32801 (“**BLCCDD**”), to and for the benefit of MARION COUNTY, a political subdivision of the State of Florida, whose address is 601 SE 25th Ave., Ocala, FL 34471 (“**County**”). BLCCDD and County may each be referred to as a “**Party**” and may be collectively referred to herein as the “**Parties**.”

RECITALS

WHEREAS, BLCCDD is the fee owner of certain real property located in Marion County, Florida (“**County**”), described and depicted on **Exhibit A** attached hereto and made a part hereof (“**Temporary Easement Area**”);

WHEREAS, the County is widening SW 80th Avenue from two lanes to four lanes from SW 90th Street (present terminus of four lanes) to one-half mile north of SW 38th Street, or further north as determined by the County during the design phase, and along SW 38th Street to approximately 3,000 feet east of the intersection of SW 80th Avenue and SW 38th Street (approximately SW 74th Avenue) (“**SW 80th Ave 4-Laning Project**”);

WHEREAS, County desires to obtain from BLCCDD, and BLCCDD has agreed to grant to County, a temporary, non-exclusive construction easement over the Temporary Easement Area to accommodate construction activities related to the SW 80th Ave 4-Laning Project that cannot be performed by the County within the dedicated 120 feet wide right-of-way;

WHEREAS, BLCCDD owns a portion of SW 63rd St Rd by virtue of a Quit Claim Deed recorded in OR Book 04504, Pages 0574-0577, Public Records of Marion County, Florida;

WHEREAS, BLCCDD adopted Resolution 2007-05 on May 29, 2007 confirming its acceptance of SW 63rd St Rd., including acceptance of maintenance of the landscaping and irrigation within the impacted area; and

WHEREAS, on May 27, 2008, the Circle Square Ranch Master Association (“**CSRMA**”) adopted a resolution, which is recorded in OR Book 05044, Pages 1411-1414, Public Records of Marion County, Florida, electing to maintain the improvements within the impacted area.

NOW, THEREFORE, in consideration of the premises, agreements, and covenants set forth herein, and for other good and valuable consideration, the receipt and sufficiency of which are hereby acknowledged, the Parties agree as follows:

1. Recitals; Exhibits. The foregoing recitals are true and correct and, together with all Exhibits attached hereto, are incorporated into and form a part of this Easement Agreement. As used herein, the term “Permittees” shall mean all contractors, subcontractors, managers, officers, directors, employees, agents, vendors, licensees, suppliers, and invitees, of County, insofar as their activities relate to the use of the Temporary Easement Area.

2. Grant of Temporary Easement. BLCCDD hereby creates, grants, declares, and conveys to County and its Permittees (collectively, the “County Parties”), a non-exclusive, temporary easement for the purpose of completing the SW 80th Ave 4-Laning Project on, over, and across the Temporary Easement Area for the purpose of: (1) ingress and egress; (2) performing improvements to the median and crosswalk; (3) performing improvements to the curb and gutter; and (4) performing milling and resurfacing. It is understood and agreed that the foregoing easement is non-exclusive and BLCCDD reserves the right for itself, and its respective successors, assigns, and designated users, to utilize the Temporary Easement Area for any purpose not inconsistent with the uses granted to County hereunder. Prior to commencing any activities within the Temporary Easement Area, County shall provide BLCCDD with twenty (20) days advance written notice of its intended commencement of such activities.

3. Automatic Termination of Easement Agreement. This Easement Agreement is temporary in nature and shall automatically terminate and become null and void without further action upon the completion of the SW 80th Ave 4-Laning Project, notice from the County of final acceptance of such completion, and the BLCCDD’s acceptance of the County’s repair and maintenance obligations under paragraph 5 herein (“Termination Date”). In furtherance of the foregoing, but without limiting the automatic termination described above, at any time following the Termination Date, BLCCDD shall have the right to unilaterally execute a termination of this Easement Agreement. If requested by BLCCDD or a title company, County shall promptly execute and deliver any documents confirming the automatic termination of this Easement Agreement.

4. Reservation of Rights. BLCCDD hereby reserves unto itself, and its successors and assigns, its employees, guests and invitees, all rights accruing from its ownership of the Temporary Easement Area, including, without limitation, the right to landscape the Temporary Easement Area or engage in or permit, invite or grant to others the right to engage in any and all uses of the Temporary Easement Area, which does not unreasonably interfere with the rights granted herein.

5. Utilities Conflicts. As part of the SW 80th Ave 4-Laning Project, the County proposes to install certain stormwater infrastructure that conflicts with or impacts existing infrastructure owned or maintained by BLCCDD, as more fully described herein. The County and BLCCDD wish to set forth their respective obligations and understandings regarding the resolution of these conflicts. Plans and specifications depicting the improvements to be made pursuant this Section are attached hereto as **Composite Exhibit B.**

a. Conflict 1 – Existing Force Main Crossing at STA 26+80.00.

- i. BLCCDD owns and operates an existing 8-inch Polyvinyl Chloride (“**PVC**”) Force Main, as shown on Composite Exhibit B located at approximately Station 26+80.00. The County will install a 24-inch Reinforced Concrete Pipe (“**RCP**”) between Storm Structure S2A-03 and Storm Structure S2A-03A and shall maintain a minimum vertical separation of 0.5 feet (6 inches) from the existing force main. The County shall notify and coordinate with BLCCDD at least seventy-two (72) hours prior to performing the proposed work to allow BLCCDD to inspect the required utility separation and compaction between utilities.
- ii. In the event the County is unable to maintain a minimum separation of 0.5 foot (6 inches), the County and BLCCDD shall each be responsible for fifty percent (50%) of the costs necessary to deflect the existing 8-inch PVC force main to avoid conflict with the proposed 24-inch RCP. Such costs shall include all required appurtenances, including but not limited to pipe, fittings, bell restraints in accordance with Marion County Detail UT-300, and air-release valves, if necessary. BLCCDD’s contractor shall perform this additional utility work in coordination with the County’s contractor. Ideally, BLCCDD will contract for this work with the County’s contractor’s underground subcontractor, if possible.

b. Conflict 2 – Existing Water Main Crossing at STA 30+15.00.

- i. BLCCDD owns and operates an existing 16-inch Ductile Iron Pipe (“**DIP**”) Water Main, as shown on Composite Exhibit B located at approximately Station 30+15.00. The County will install a 24-inch RCP between Storm Structure S2A-03B and Storm Structure S2A-05 and shall maintain a minimum vertical separation of 1.0 feet (12 inches) from the existing water main. The County shall notify and coordinate with BLCCDD at least seventy-two (72) hours prior to performing the proposed work to allow BLCCDD to inspect the required utility separation and compaction between utilities.
- ii. In the event the County is unable to maintain a minimum separation of 1.0 foot (12 inches), the County and BLCCDD shall each be responsible for fifty percent (50%) of the costs necessary to deflect the existing 16-inch DIP water main to avoid conflict with the proposed 24-inch RCP. Such costs shall include all required appurtenances, including but not limited to pipe, fittings, and bell restraints in accordance with Marion County Detail UT-200. BLCCDD’s contractor shall perform this additional utility work in coordination with the County’s contractor. Ideally, BLCCDD will contract for this work with the County’s contractor’s underground subcontractor, if possible.

- c. Conflict 3 – Multiple Conflicts at Intersection of SW 80th Street and 80th Ave.
- i. Station 52+15.70 Improvements.
 1. BLCCDD owns and operates an existing 16-inch DIP water main, as shown on Composite Exhibit B located at approximate Station 52+15.70. The County will install a 30-inch RCP between Storm Structure S2A-18 and Storm Structure S2A-18A that will require the deflection of the existing 16-inch DIP water main.
 2. The County and BLCCDD shall each be responsible for fifty percent (50%) of the costs necessary to deflect the existing 16-inch DIP water main to avoid conflict with the proposed 30-inch RCP. Such costs include all required appurtenances, including but not limited to pipe, fittings and bell restraints in accordance with Marion County Detail UT-200. The County shall notify and coordinate with BLCCDD at least seventy-two (72) hours prior to performing the proposed work to allow BLCCDD to inspect the work performed, required utility separation, and compaction between utilities.
 - ii. Station 79+48.02 Improvements.
 1. BLCCDD owns and operates an existing 12-inch PVC water main, as shown on Composite Exhibit B located at approximate Station 79+48.02. The County intends to install a 24-inch RCP between Storm Structure S2A-18A and Storm Structure S2A-18B that will require the deflection of the existing 12-inch PVC water main.
 2. The County and BLCCDD shall each be responsible for fifty percent (50%) of the costs necessary to deflect the existing 12-inch PVC water main to avoid conflict with the proposed 24-inch RCP. Such costs include all required appurtenances, including but not limited to pipe, fittings and bell restraints in accordance with Marion County Detail UT-200. The County shall notify and coordinate with BLCCDD at least seventy-two (72) hours prior to performing the proposed work to allow BLCCDD to inspect the work performed, required utility separation, and compaction between utilities.
 - iii. Station 53+71.00 Improvements.
 1. BLCCDD owns and operates an existing 12-inch PVC water main, as shown on Composite Exhibit B located at approximate Station 53+71.00. The County intends to install an 18-inch RCP between Storm Structure S2A-20 and Storm Structure S2A-20A that will require the deflection of the existing 12-inch PVC water main.
 2. The County and BLCCDD shall each be responsible for fifty percent (50%) of the costs necessary to deflect the existing 12-inch PVC water main to avoid conflict with the proposed 18-

inch RCP. Such costs include all required appurtenances, including but not limited to pipe, fittings and bell restraints in accordance with Marion County Detail UT-200. The County shall notify and coordinate with BLCCDD at least seventy-two (72) hours prior to performing the proposed work to allow BLCCDD to inspect the work performed, required utility separation, and compaction between utilities.

- iv. Coordination Regarding Completion of Improvements. For the improvements discussed in this subsection c., BLCCDD's contractor shall perform this work in coordination with the County's contractor. Ideally, BLCCDD will contract for this work with the County's contractor's underground subcontractor, if possible.
- d. Conflict 4 – Existing Water Main at STA 112+30.29.
 - i. BLCCDD owns and operates an existing 12-inch PVC water main installed inside a 24-inch steel casing pipe, as shown on Composite Exhibit B located at approximate Station 112+30.29. The County will install a 30-inch RCP between Storm Structure S4A-12 and Storm Structure S4A-14 and shall maintain a minimum vertical separation of 0.5 foot (6 inches) from the existing water main. The County shall notify and coordinate with BLCCDD at least seventy-two (72) hours prior to performing the proposed work to allow BLCCDD to inspect the required utility separation and compaction between utilities.
 - ii. In the event the County is unable to maintain a minimum separation of 0.5 foot (6 inches), the County and BLCCDD shall each be responsible for fifty percent (50%) of the costs necessary to deflect the existing 12-inch PVC water main to avoid conflict with the proposed 30-inch RCP. Such costs shall include all required appurtenances, including but not limited to pipe, fittings and bell restraints in accordance with Marion County Detail UT-200. BLCCDD's contractor shall perform this additional utility work in coordination with the County's contractor. Ideally, BLCCDD will contract for this work with the County's contractor's underground subcontractor, if possible.
- e. Conflict 5 – Multiple Conflicts at Intersection of SW 63rd St Rd and 80th Ave.
 - i. Existing Water Main at STA 121+87.97.
 - 1. BLCCDD owns and operates an existing 24-inch PVC water main installed inside a 42-inch steel casing pipe, as shown on Composite Exhibit B located at approximate Station 121+87.97. The County will install a 36-inch RCP between Storm Structure S4A-20 and Storm Structure S4A-21 and shall maintain a minimum vertical separation of one (1) foot (12 inches) from the existing water main. The County shall notify and coordinate with BLCCDD at least seventy-two (72) hours prior to performing the proposed work to allow BLCCDD to inspect the required utility separation and compaction between utilities.
 - 2. In the event the County is unable to maintain a minimum separation of one (1) foot (12 inches), the County and BLCCDD

shall each be responsible for fifty percent (50%) of the costs necessary to deflect the existing 24-inch PVC water main to avoid conflict with the proposed 36-inch RCP. Such costs shall include all required appurtenances, including but not limited to pipe, fittings and bell restraints in accordance with Marion County Detail UT-200.

ii. Existing Force Main at STA 124+40.00.

1. BLCCDD owns and operates an existing 12-inch PVC force main installed inside a 24-inch steel casing pipe, as shown on Composite Exhibit B located at approximate Station 124+40.00. The County will install a 48-inch RCP between Storm Structure S4A-31 to Storm Structure S4A-32 and shall maintain a minimum vertical separation of one (1) foot (12 inches) from the existing force main. The County shall notify and coordinate with BLCCDD at least seventy-two (72) hours prior to performing the proposed work to allow BLCCDD to inspect the required utility separation and compaction between utilities.
2. In the event the County is unable to maintain a minimum separation of one (1) foot (12 inches), the County and BLCCDD shall each be responsible for fifty percent (50%) of the costs necessary to deflect the existing 12-inch PVC force main to avoid conflict with the proposed 48-inch RCP. Such costs shall include all required appurtenances, including but not limited to pipe, fittings and bell restraints in accordance with Marion County Detail UT-300.

iii. Existing Force Main at STA 124+71.28.

1. BLCCDD owns and operates an existing 12-inch PVC force main installed inside a 24-inch steel casing pipe, as shown on Composite Exhibit B located at approximate Station 124+71.28. The County will install a 18-inch RCP between Storm Structure S4A-28 to Storm Structure S4A-28A and shall maintain a minimum vertical separation of one (1) foot (12 inches) from the existing force main. The County shall notify and coordinate with BLCCDD at least seventy-two (72) hours prior to performing the proposed work to allow BLCCDD to inspect the required utility separation and compaction between utilities.
2. In the event the County is unable to maintain a minimum separation of one (1) foot (12 inches), the County and BLCCDD shall each be responsible for fifty percent (50%) of the costs necessary to deflect the existing 12-inch PVC force main to avoid conflict with the proposed 18-inch RCP. Such costs shall include all required appurtenances, including but not limited to pipe, fittings and bell restraints in accordance with Marion County Detail UT-300.

- iv. Existing Force Main at STA 124+71.28.
 - 1. BLCCDD owns and operates an existing 12-inch PVC force main installed inside a 24-inch steel casing pipe, as shown on Composite Exhibit B located at approximate Station 124+71.28. The County will install a 18-inch RCP between Storm Structure S4A-31 to Storm Structure S4A-30 and shall maintain a minimum vertical separation of one (1) foot (12 inches) from the existing force main. The County shall notify and coordinate with BLCCDD at least seventy-two (72) hours prior to performing the proposed work to allow BLCCDD to inspect the required utility separation and compaction between utilities.
 - 2. In the event the County is unable to maintain a minimum separation of one (1) foot (12 inches), the County and BLCCDD shall each be responsible for fifty percent (50%) of the costs necessary to deflect the existing 12-inch PVC force main to avoid conflict with the proposed 18-inch RCP. Such costs shall include all required appurtenances, including but not limited to pipe, fittings and bell restraints in accordance with Marion County Detail UT-300.
- v. Coordination Regarding Completion of Improvements. For the improvements discussed in this subsection e., BLCCDD's contractor shall perform this work in coordination with the County's contractor. Ideally, BLCCDD will contract for this work with the County's contractor's underground subcontractor, if possible.

6. County's Repair and Maintenance Obligations. During the course of County's exercise of its rights hereunder, County shall take all reasonable steps to ensure against any damage to the Temporary Easement Area caused by or resulting from the County Parties', including, without limitation, damage to any improvements located on the Temporary Easement Area. County agrees to repair, at its own expense, any damage to the Temporary Easement Area and any improvements located thereon or thereunder, caused by or resulting from the County Parties' utilization of the Temporary Easement Area. The repair work includes, without limitation, the repair of any structures, utility lines, irrigation lines/sprinklers, or other improvements on the Temporary Easement Area that were damaged, removed or destroyed by the County Parties. The County will coordinate with CSRMA and BLCCDD regarding the impacted landscaping pursuant to that certain Agreement (SW 80th Ave 4-Laning Project) entered into by and between the County and CSRMA. In addition, County further covenants and agrees that County, at County's sole cost and expense, shall remove all debris and garbage located on the Temporary Easement Area on a daily basis.

7. Environmental Indemnity. County shall indemnify, defend, protect, and hold BLCCDD and BLCCDD's officers, shareholders, members, directors, partners, agents, attorneys and employees (collectively "**BLCCDD Parties**") harmless from and against any and all actual or potential claims, proceedings, lawsuits, liabilities, damages, losses, fines, penalties, judgments, awards, costs and expenses, including, notwithstanding Paragraph 19 herein, without limitation,

reasonable attorneys' fees and costs, that arise out of or relate in any way to any use, storage, transfer, generation, disposal, or discharge of Hazardous Materials in connection with the use of the Temporary Easement Area by the County Parties. As used in this Easement Agreement, "Hazardous Materials" means:

- (a) All substances, wastes, pollutants, contaminants, and materials now or hereafter regulated, or defined or designated as hazardous, extremely or imminently hazardous, dangerous, or toxic, under the following federal statutes and their state counterparts, as well as these statutes' implementing regulations: the Comprehensive Environmental Response, Compensation, and Liability Act of 1980, 42 U.S.C. '9601 et seq.; the Federal Insecticide, Fungicide, and Rodenticide Act, 7 U.S.C. '136 et seq.; the Atomic Energy Act of 1954, 42 U.S.C. '2011 et seq.; and the Hazardous Materials Transportation Act, 49 U.S.C. '5101 et seq.;
- (b) Any additional hazardous substances or materials that are now or become defined as "hazardous substances," "hazardous waste," "toxic substances," or "toxic waste" under any other federal law or under any state, county, municipal, or other law applicable to the Temporary Easement Area or under any regulations promulgated under any such law;
- (c) Petroleum and petroleum products including crude oil and any fractions thereof;
- (d) Asbestos; and
- (e) Natural gas, synthetic gas, and any mixtures thereof.

The Parties herein will not cause or give permission for any Hazardous Materials to be used, placed, misused or disposed of upon, above, under, or transported to or from the Temporary Easement Area in violation of any applicable law. The obligations of the Parties in this Section that accrued prior to the Termination Date, including without limitation breach, shall survive the termination of this Easement Agreement, as well as the BLCCDD Self Help Remedy set forth in Section 7 with regard thereto.

8. BLCCDD Self Help Remedy. If County fails to perform any obligation set forth in this Easement Agreement and fails to cure the non-performance of the obligation within thirty (30) calendar days after receiving written notice from BLCCDD (however, no notice to County shall be required in an emergency), BLCCDD shall have the right, but not the obligation, to perform the obligation and be reimbursed for the cost of that performance by County within thirty (30) days after receipt of a written demand thereof by BLCCDD.

9. Indemnification by County. County will defend, indemnify and hold BLCCDD, its successors and assigns, harmless from and against any and all actions, causes of action, claims, demands, liabilities, losses, judgments, costs and expenses whatsoever (including, notwithstanding Paragraph 19 herein, without limitation, reasonable attorneys' fees at trial and appellate levels), arising out of or as a result of the exercise by County (or any individual or entity claiming by, through or under County), of County's rights or obligations hereunder. The obligations of the Parties in this Section that accrued prior to the Termination Date, including without limitation breach, shall survive the termination of this Easement Agreement, as well as the BLCCDD Self Help Remedy set forth in Section 7 with regard thereto.

10. No Liens. County shall not permit (and shall promptly satisfy or bond) any construction, mechanic's lien or other lien or encumbrance against the Temporary Easement Area

if such lien or encumbrance shall arise in connection with any work or materials related directly or indirectly to the exercise by County (or any individual or entity claiming by, through or under County) of its rights or obligations hereunder. The filing of any such lien shall constitute a default by County under this Easement Agreement. This section shall survive the termination of this Easement Agreement.

11. No Waiver of Immunity. Nothing in this Easement Agreement shall be deemed as a waiver of sovereign immunity or limits of liability of either County or BLCCDD, including their supervisors, officers, agents and employees and independent contractors, beyond any statutory limited waiver of sovereign immunity or limits of liability which may have been adopted by the Florida Legislature in Section 768.28, Florida Statutes, or other statute, and nothing in this Easement Agreement shall inure to the benefit of any third party for the purpose of allowing any claim which would otherwise be barred under the Doctrine of Sovereign Immunity or by operation of law.

12. Insurance Required to be Maintained by County. In connection with the rights granted by BLCCDD to County hereunder, County agrees to maintain or cause to be maintained in full force and effect comprehensive general liability insurance, including personal injury liability insurance and contractual liability insurance, with a financially responsible insurance company or companies licensed in the State of Florida. Such insurance shall provide for aggregate coverage of not less than One Million Dollars (\$1,000,000.00) for public liability and property damage, naming BLCCDD as an additional insured. Said policy shall provide for at least thirty (30) days' notice of non-payment of premiums or cancellation.

13. Subrogation. All insurance required by this Easement Agreement shall include provisions denying to the insurer subrogation rights against the other Parties to the extent such rights have been waived by the insured prior to the occurrence of damage or loss. Each Party to this Easement Agreement waives any rights against the other Party for any damage or consequential losses covered by such policies, against which such person is protected by insurance, but only to the extent of the proceeds actually paid to such person under such policies, whether or not such damage or loss shall have been caused by any acts or omissions of the other parties or its agents, employees, representatives, invitees, guests, successors or assigns.

14. No Public Dedication. This Easement Agreement shall not be construed, expressly or by implication, as a dedication to the public for public use and the Parties may, by mutual agreement, terminate or modify their respective rights and obligations hereunder without the consent of any third party.

15. Governing Law; No Venture: This Easement Agreement shall be interpreted, construed and enforced in accordance with the laws of the State of Florida and venue for any litigation arising hereunder shall be in Marion County. Nothing contained in this Easement Agreement shall be deemed or construed, either by the Parties hereto or by any third party, to create the relationship of principal and agent or to create any partnership, joint venture or other association between the Parties.

16. Notices. Except as otherwise expressly provided herein, notices may only be delivered by either (i) hand delivery (ii) by certified mail, return receipt requested, or (iii) delivery by overnight delivery service such as UPS or FedEx, to the addressee at the address set forth above, and shall be deemed to have been delivered on the date of receipt of such notice, if hand-delivered, or, if mailed on the date the receipt for which the certified mail is signed by the addressee or its authorized agent or employee, or if sent by overnight delivery service, the day such notice is received. Either Party may change the address for notice to that Party by delivering written notice of such change in the manner provided above, such change to be effective not sooner than three (3) days after the date of notice of change, addressed as provided herein.

17. Entire Agreement. This Easement Agreement contains the entire agreement of the Parties pertaining to the subject matter hereof and there are no representations, inducements, promises or agreements, oral or otherwise, not embodied herein or in writing.

18. Binding Effect. This Easement Agreement and all conditions, obligations, and covenants granted and created herein shall be deemed covenants running with the land and shall be binding and benefit not only the BLCCDD and County but also their assigns and successors in title until the Termination Date, except as otherwise provided herein.

19. Modification and Waiver. Except as otherwise expressly provided herein, this Easement Agreement may not be amended, waived, or terminated, except by an instrument in writing executed by County and BLCCDD, which written document shall be recorded in the Public Records of Marion County, Florida. No delay or omission in the exercise of any right accruing upon any default shall impair such right or be construed to be a waiver thereof, and every such right may be exercised at any time during the continuance of such default. A waiver of a breach of, or a default in, any of the terms and conditions of this Easement Agreement by a Party shall not be construed to be a waiver of any subsequent breach of or default in the same or any other provision of this Easement Agreement.

20. Attorneys' Fees. In the event of any dispute, litigation, or other proceeding between BLCCDD and County to enforce any of the provisions of this Easement Agreement or any right of either BLCCDD or County hereunder, each Party to such dispute, litigation, or other proceeding shall pay its own costs and expenses, including reasonable attorneys' fees, incurred at trial, on appeal, and in any arbitration, administrative or other proceedings.

21. Remedies. In the event of a breach or threatened breach of any Party's obligations under this Agreement, a cause of action shall immediately accrue to the non-breaching Party and such non-breaching Party shall be entitled to pursue all remedies described in this Agreement or provided at law and equity. The Parties further agree that the waiver of a Party's breach or threatened breach of any obligations under this Agreement shall not be construed as a waiver of any subsequent breach by that Party.

22. Estoppel Certificates. BLCCDD and County, within ten (10) days of its receipt of a written request from the other shall, from time to time, provide the other party a certificate binding upon such Party stating: (a) to the best of the such Party's knowledge, whether any Party to this Easement Agreement is in default or violation of this Easement Agreement and if so

identifying such default or violation, and (b) that this Easement Agreement is in full force and effect and identifying any amendments to this Easement Agreement as of the date of such certificate.

23. WAIVER OF JURY TRIAL. BLCCDD AND COUNTY HEREBY KNOWINGLY, VOLUNTARILY, AND INTENTIONALLY WAIVE THE RIGHT TO A TRIAL BY JURY WITH RESPECT TO ANY LITIGATION BASED HEREON, ARISING OUT OF, UNDER, OR IN CONNECTION WITH THIS EASEMENT AGREEMENT OR ANY DOCUMENTS CONTEMPLATED TO BE EXECUTED IN CONNECTION HEREWITH, OR ANY COURSE OF CONDUCT, COURSE OF DEALINGS, STATEMENTS (WHETHER ORAL OR WRITTEN), OR ANY ACTIONS OF EITHER BLCCDD OR COUNTY, ARISING OUT OF, OR RELATED IN ANY MANNER WITH, THIS EASEMENT AGREEMENT (INCLUDING, WITHOUT LIMITATION, ANY ACTION TO RESCIND OR CANCEL THIS EASEMENT AGREEMENT OR ANY CLAIMS OR DEFENSES ASSERTING THAT THIS EASEMENT AGREEMENT WAS FRAUDULENTLY INDUCED OR IS OTHERWISE VOID OR VOIDABLE). THIS WAIVER IS A MATERIAL INDUCEMENT FOR BLCCDD AND COUNTY TO ENTER INTO THIS EASEMENT AGREEMENT. BLCCDD AND COUNTY ACKNOWLEDGE THAT THIS WAIVER HAS BEEN FREELY GIVEN AFTER CONSULTATION WITH COMPETENT COUNSEL.

24. Severability. If any provision of this Easement Agreement or the application thereof to any person or circumstance shall, for any reason and to any extent, be invalid or unenforceable, the remainder of this Easement Agreement and the application of such provision to other persons or circumstances shall not be affected thereby, but rather shall be enforced to the greatest extent permitted by law. It is the intention of the Parties that if any such provision is held to be illegal, invalid, or unenforceable, the parties shall negotiate in good faith to add in lieu thereof a legal, valid and enforceable provision that is as similar as possible in terms to the illegal, invalid or unenforceable provision.

25. Construction. The captions and headings in this Easement Agreement are for reference only and shall not be deemed to define or limit the scope or intent of any of the terms, covenants, conditions, or agreements contained herein.

26. Time is of Essence. BLCCDD and County acknowledge time is of the essence under this Easement Agreement.

27. Drafting. Each of the Parties have participated fully in the negotiation and preparation of this Easement Agreement with full benefit of counsel. Accordingly, this Easement Agreement shall not be more strictly construed against any of the Parties, and shall be interpreted as if the Parties hereto jointly prepared it.

28. Cooperation. The Parties shall execute in good faith such other and further documents as may be required to effectuate the terms of this Easement Agreement. However, nothing herein shall be interpreted to require the County to take or abstain from taking any regulatory, legislative, or quasi-judicial action.

29. Counterparts. This Easement Agreement may be executed in counterparts. It shall be sufficient that the signatures of the persons required to bind any Party appear on one or more of such counterparts. All counterparts shall collectively constitute a single agreement.

[Signatures on Following Page]

IN WITNESS WHEREOF, BLCCDD has caused these presents to be duly executed in its name by the undersigned as of the date first above written.

WITNESSES:

“BLCCDD”

BAY LAUREL CENTER COMMUNITY DEVELOPMENT DISTRICT, a Florida community development district

Print Name:

Address of Witness 1:

By:

Its:

Print Name:

Address of Witness 2:

STATE OF FLORIDA)
COUNTY OF _____)

The foregoing instrument was acknowledged before me by means of physical presence or online notarization, this ___ day of _____, 2026, by _____ as _____ of BAY LAUREL CENTER COMMUNITY DEVELOPMENT DISTRICT, a Florida community development district, who acknowledges that he/she executes the foregoing on behalf of the company. He/She is personally known to me or has produced _____ as identification.

Notary Public

Print Name

My commission expires:_____

IN WITNESS WHEREOF, County has caused these presents to be duly executed in its name by the undersigned as of the date first above written.

ATTEST:

**BOARD OF COUNTY COMMISSION OF
MARION COUNTY, FLORIDA**

Gregory C. Harrell, Clerk




By: _____
Carl Zalak, III, Chairman

For Use of Marion County Only,
Approved as to Form



Matthew G. Minter
County Attorney

COMPOSITE EXHIBIT B

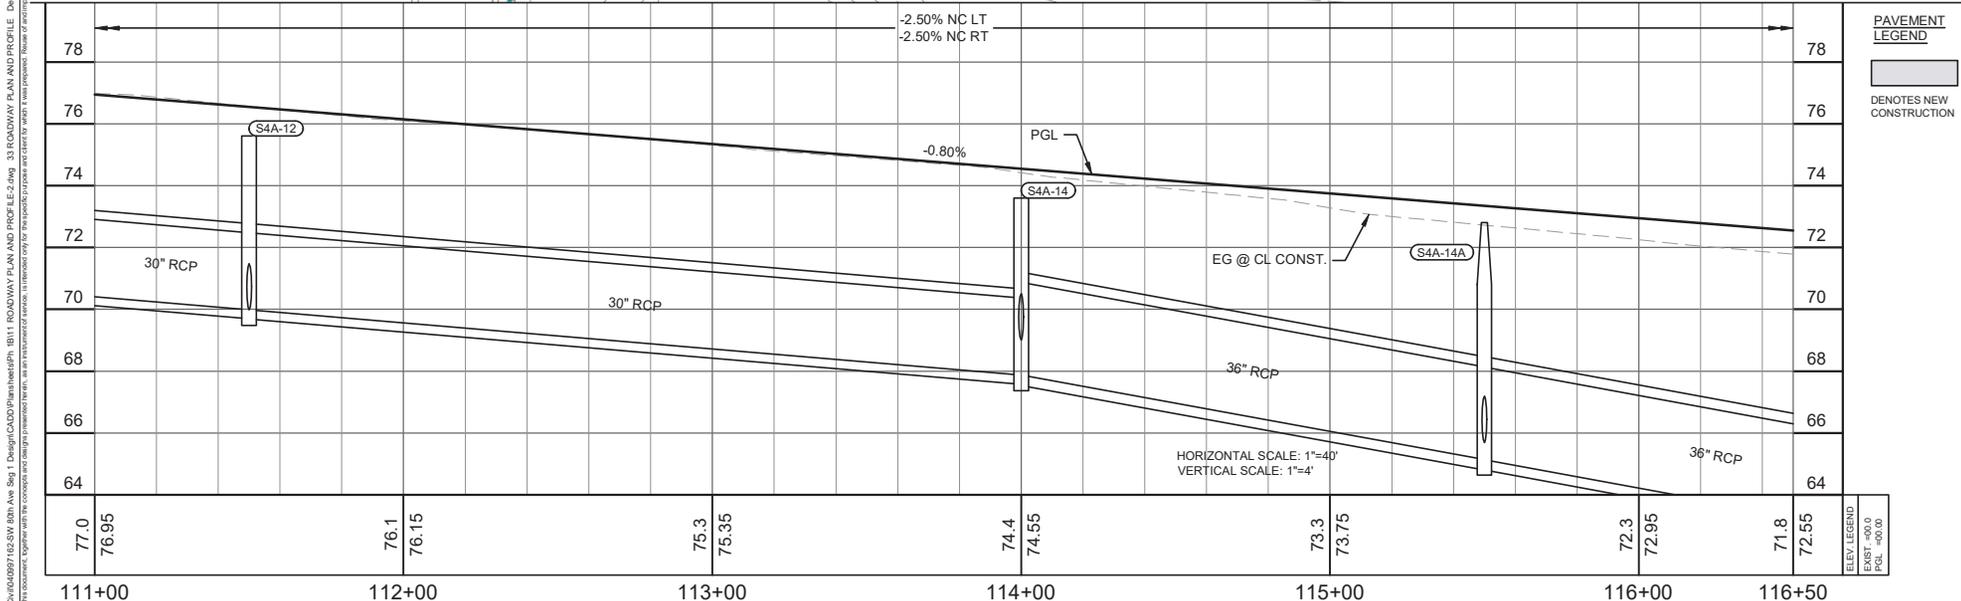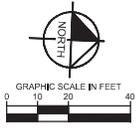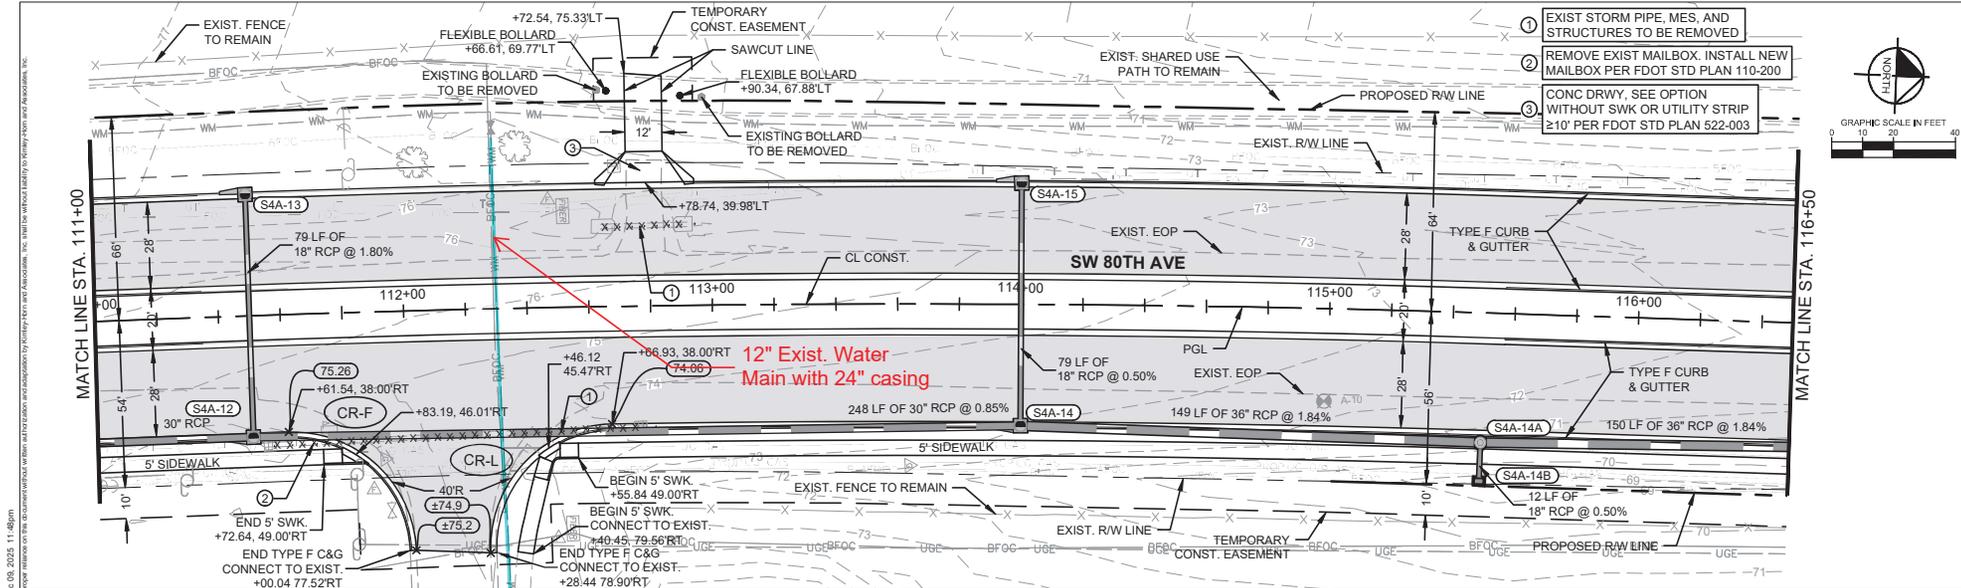

PAVEMENT LEGEND
 [Shaded Area] DENOTES NEW CONSTRUCTION

ELEV. LEGEND
 EXIST. =0.0
 PGL. =0.0

REVISIONS					
NO.	DATE	DESCRIPTION	NO.	DATE	DESCRIPTION

Kimley Horn
 © 2025 KIMLEY HORN AND ASSOCIATES, INC.
 MOHAMMAD A. ANSARI, P.E.
 P.E. LICENSE NO. 88833
 1700 SE 17TH STREET, SUITE 200, OCALA, FL 34471
 PHONE: 352-436-3000, REGISTRY 35108






BOARD OF COUNTY COMMISSIONERS
 MARION COUNTY, FLORIDA
 OFFICE OF THE COUNTY ENGINEER
 412 SE 25TH AVENUE
 OCALA, FL 34471

SW 80TH AVE SEGMENT 1B
ROADWAY PLAN AND PROFILE
SHEET 33

Drawing name: K:\OC\2025\0829\1025\SW 80th Ave Seg 1\Drawings\CADD\PlanAndProfile.dwg, 3D ROADWAY PLAN AND PROFILE, Dec 09, 2025, 11:48am
 This document, together with the computer and digital printout thereon, is the property of Kimley-Horn and Associates, Inc. and is loaned to the client for the specific project and purpose only. It is not to be distributed, copied, or used for any other project or purpose without the written consent of Kimley-Horn and Associates, Inc.

THE OFFICIAL RECORD OF THIS SHEET IS THE ELECTRONIC FILE DIGITALLY SIGNED AND SEALED UNDER RULE 61G15-3.004, F.A.C.

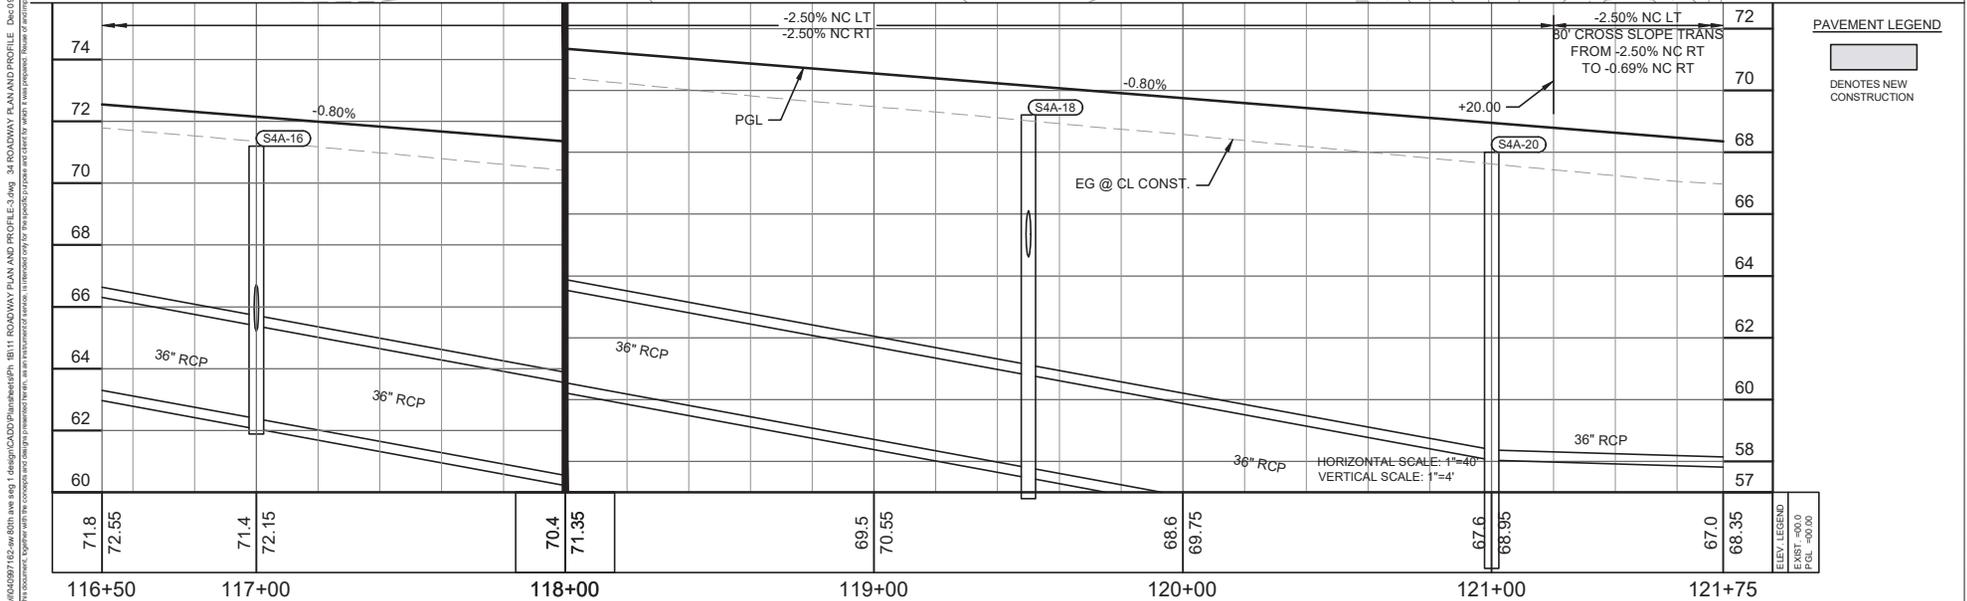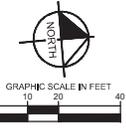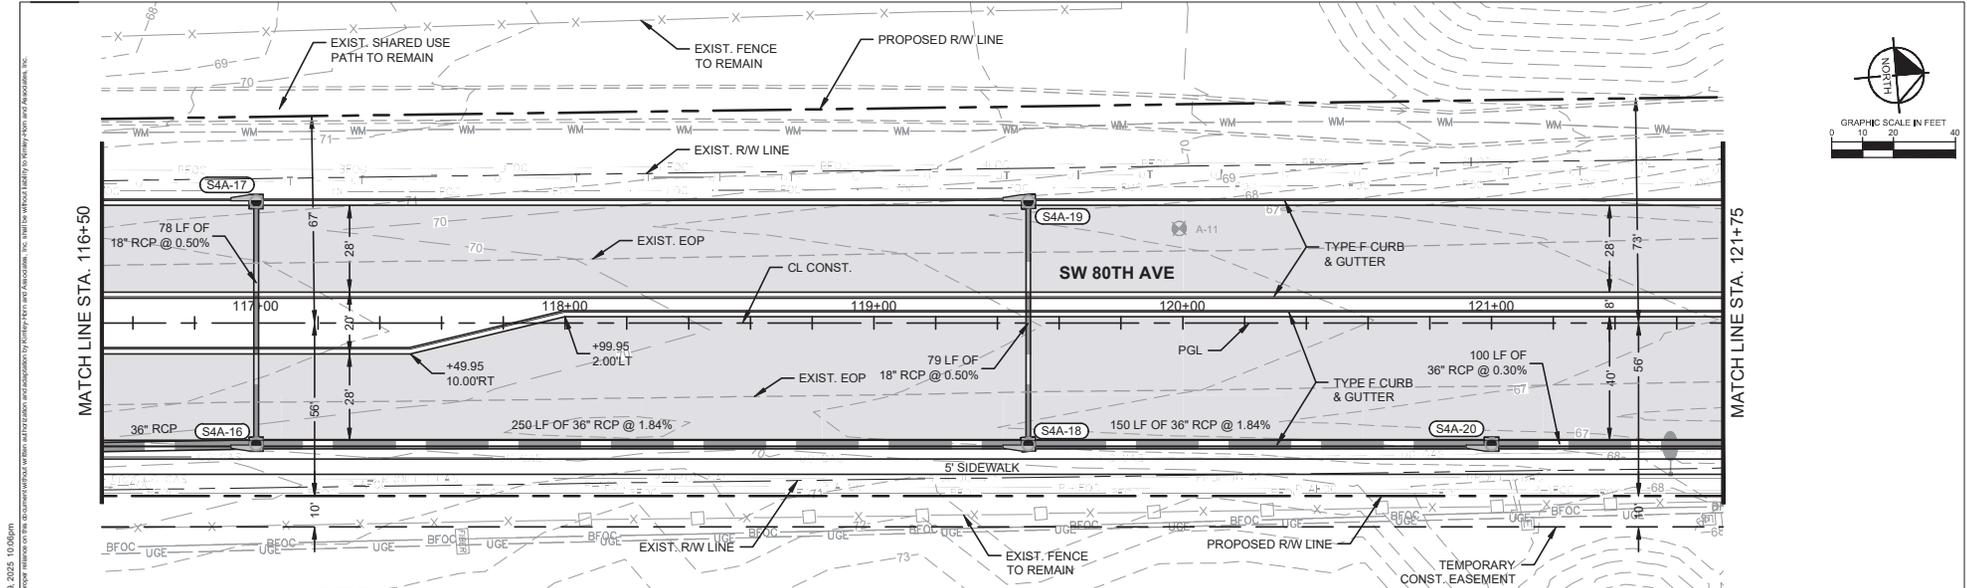

PAVEMENT LEGEND

	DENOTES NEW CONSTRUCTION
--	--------------------------

NO.		DATE	DESCRIPTION	REVISIONS	
NO.	DATE	DESCRIPTION	NO.	DATE	DESCRIPTION

Kimley Horn

© 2025 KIMLEY-HORN AND ASSOCIATES, INC.
 MOHAMMAD A. ANSARI, P.E.
 P.E. LICENSE NO. 88833
 1700 SE 17TH STREET, SUITE 200, OCALA, FL 34471
 PHONE: 352-438-3000, REGISTRY 35108

BOARD OF COUNTY COMMISSIONERS
 MARION COUNTY, FLORIDA
 OFFICE OF THE COUNTY ENGINEER
 412 SE 25TH AVENUE
 OCALA, FL 34471

SW 80TH AVE SEGMENT 1B


ROADWAY PLAN AND PROFILE

SHEET

34



Drawing name: K:\cs\24042897162-sw 80th ave 1b.dwg | Design\CADD\Planwidth\19\ 1B11 ROADWAY PLAN AND PROFILE.dwg | 34 ROADWAY PLAN AND PROFILE.dwg | Dec 08, 2025, 10:06am
 This document is the property of Kimley-Horn and Associates, Inc. and is intended for the use of the client only. It is not to be distributed, copied, or otherwise used without the written consent of Kimley-Horn and Associates, Inc. All rights reserved.

THE OFFICIAL RECORD OF THIS SHEET IS THE ELECTRONIC FILE DIGITALLY SIGNED AND SEALED UNDER RULE 61G15-23.004, F.A.C.

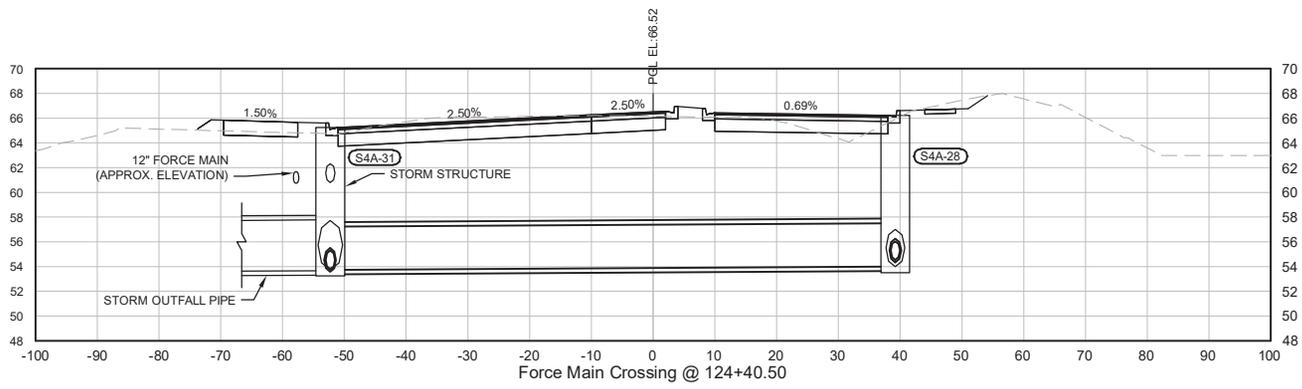


SW 80TH AVE


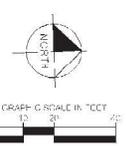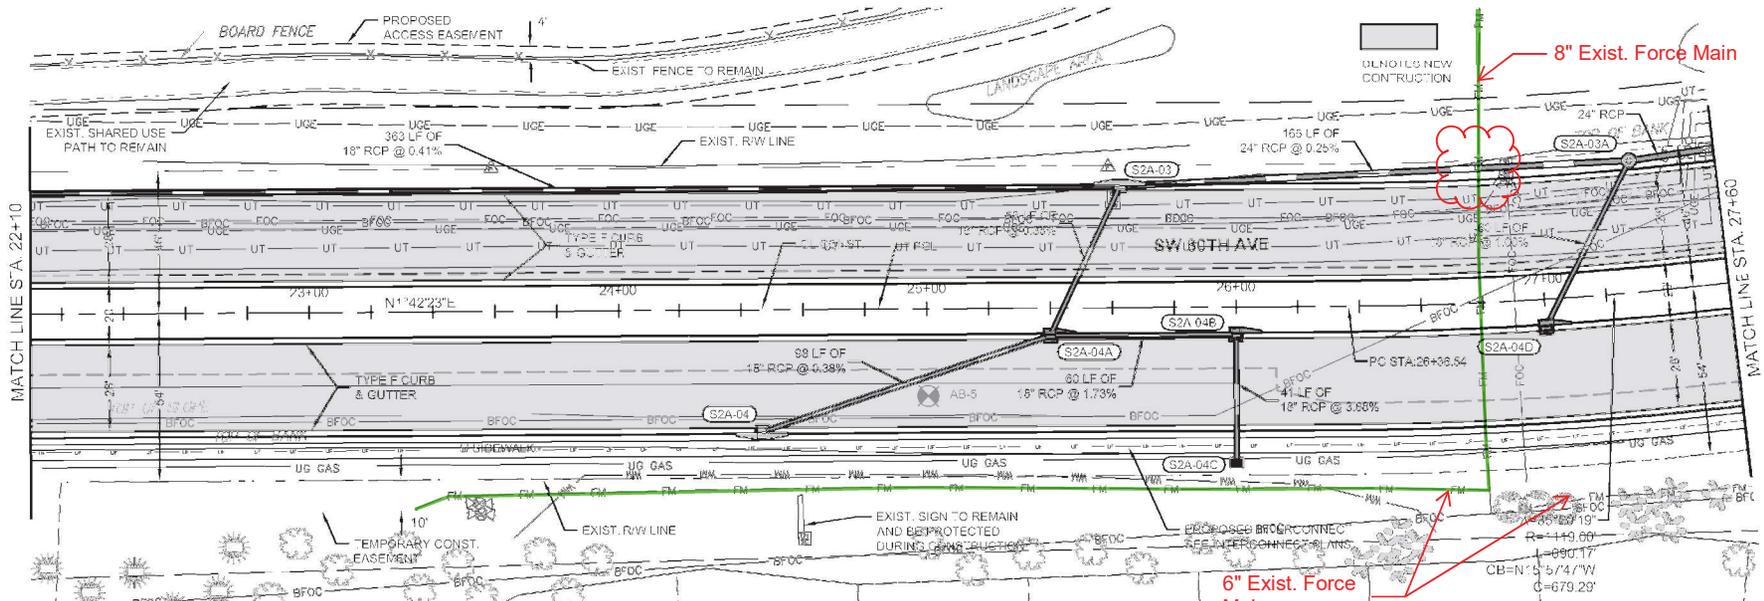

SHEET LOCATION

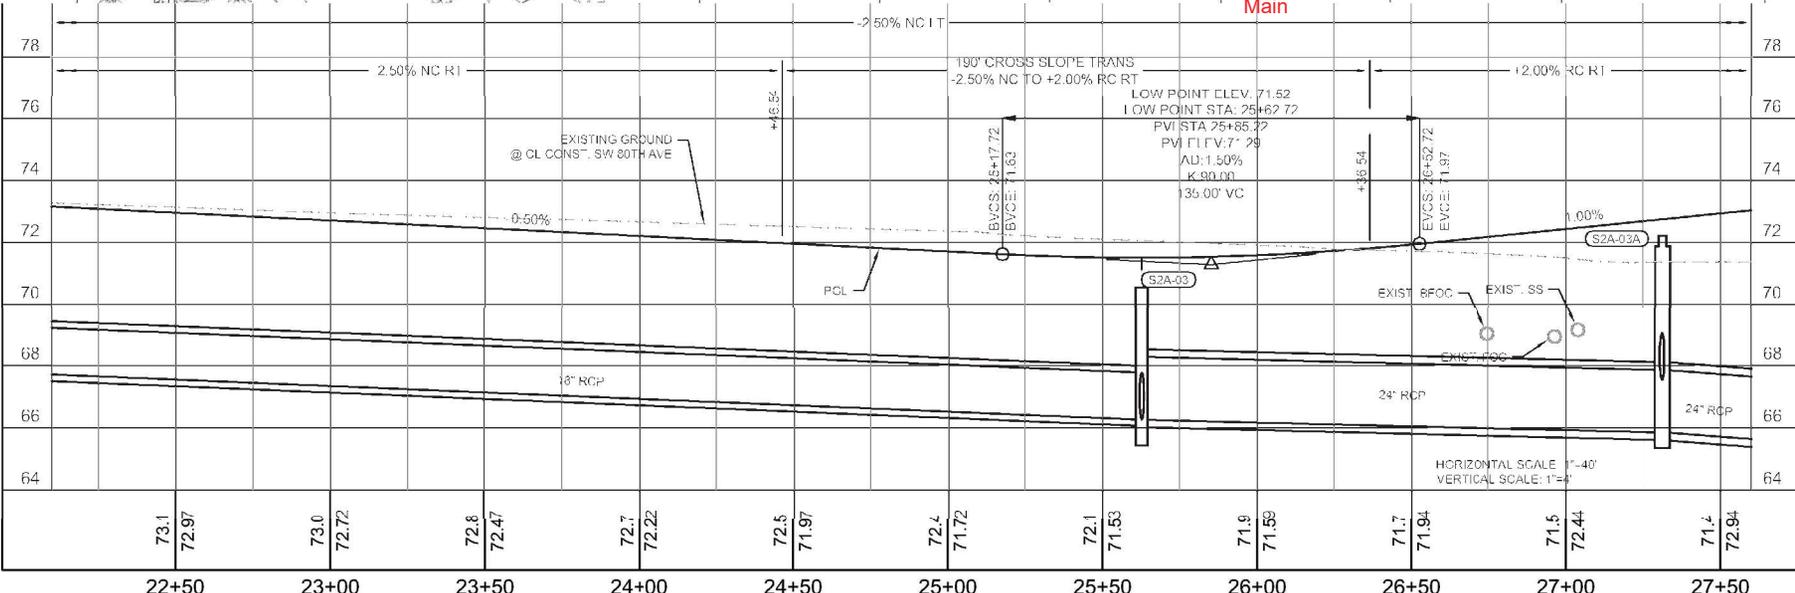

REVISIONS			
NO.	DATE	DESCRIPTION	

Kimley-Horn
 © 2025 KIMLEY-HORN AND ASSOCIATES, INC.
 MOHAMMAD A. ANSARI, P.E.
 P.E. LICENSE NO. 89933
 1700 SE 17TH STREET, SUITE 200, OCALA, FL 34471
 PHONE: 352-438-9300, REGISTRY 35108



BOARD OF COUNTY COMMISSIONERS
 MARION COUNTY, FLORIDA
 OFFICE OF THE COUNTY ENGINEER
 412 SE 25TH AVENUE
 OCALA, FL 34471



SW 80TH AVE SEGMENT 1A
ROADWAY PLAN AND PROFILE

SHEET
20



ELEV. LEGEND
 EXIST. = 0.00'
 PGL. = 0.00'

THE OFFICIAL RECORD OF THIS SHEET, THE ELECTRONIC FILED DIGITALLY SIGNED AND TIME STAMPED FILE, SHALL PREVAIL OVER ANY PRINTED COPY.


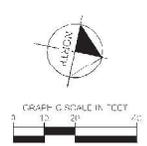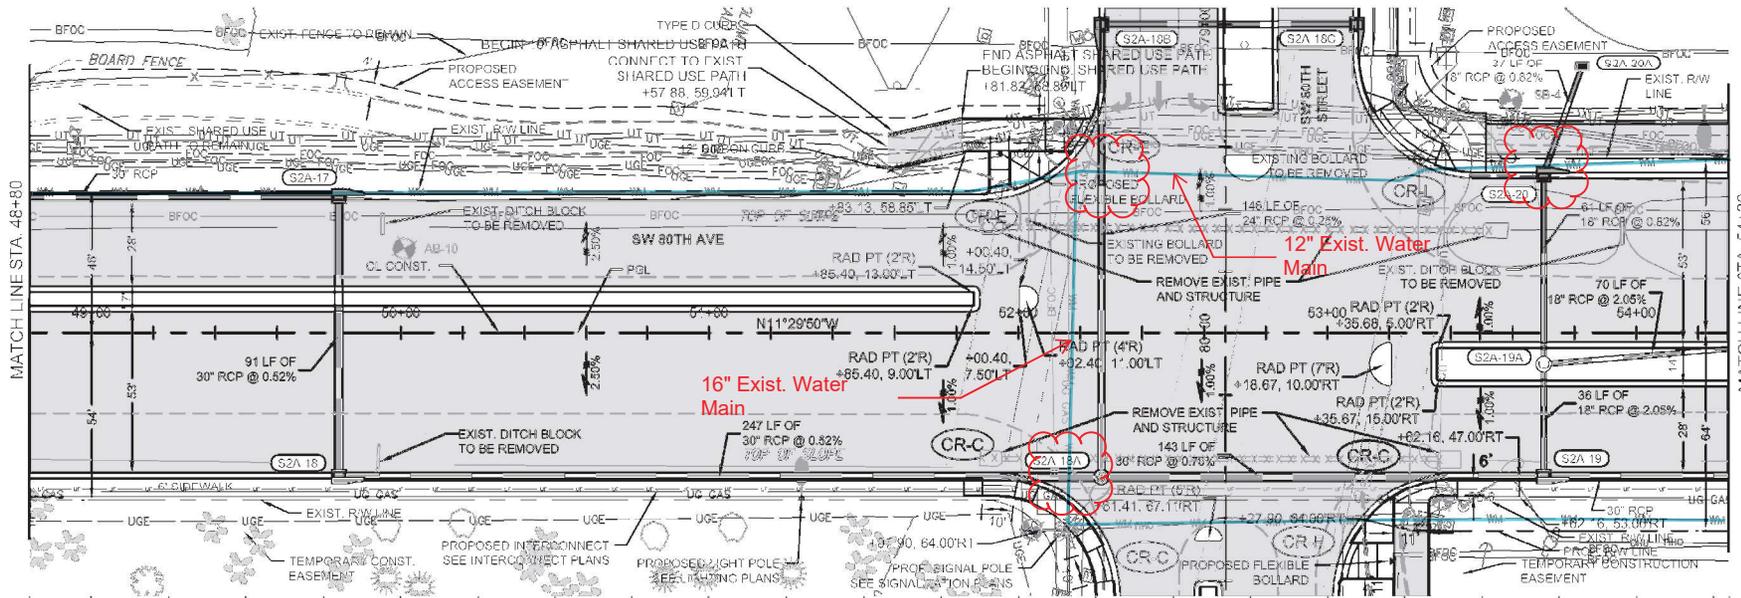

SHEET LOCATION

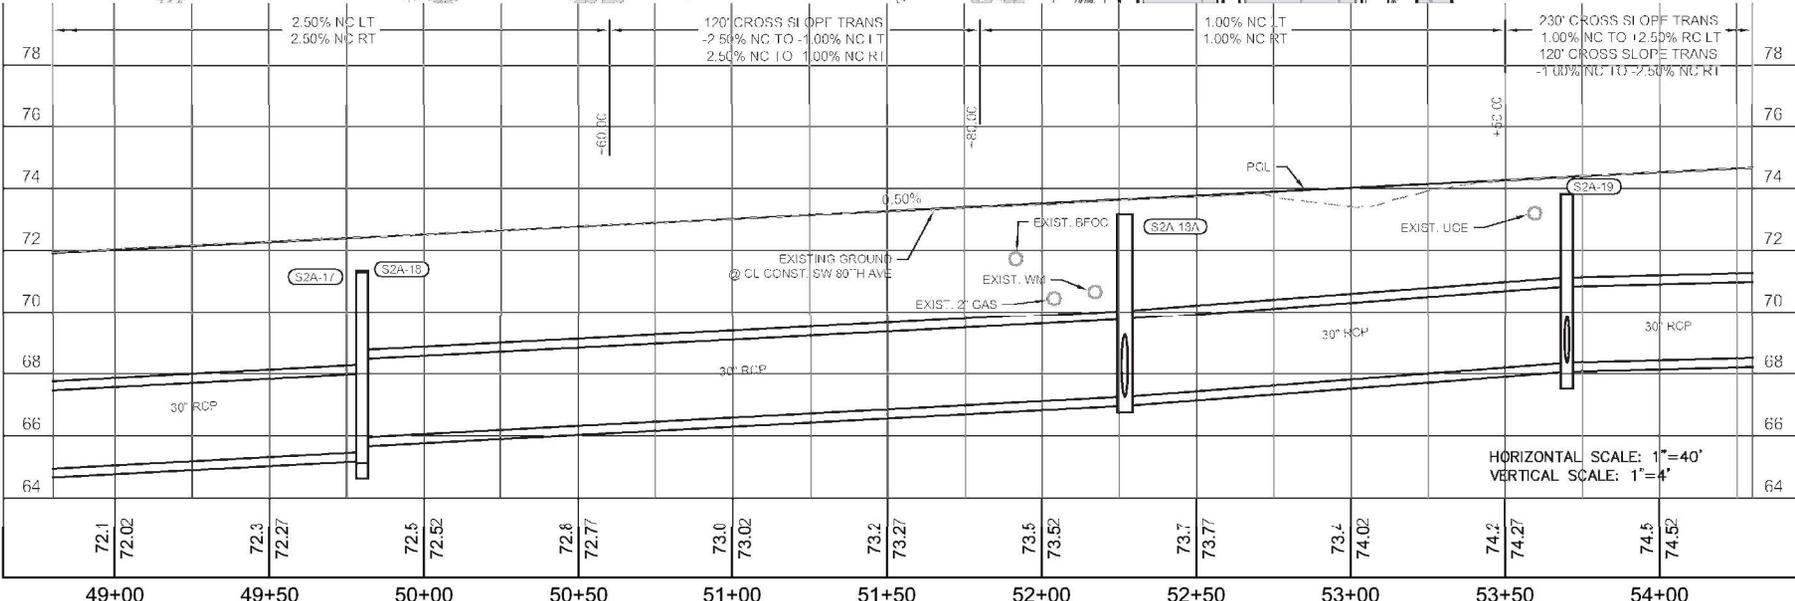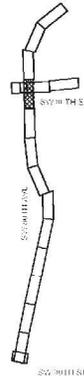

DLNO 'LS NEW CONSTRUCTION

HORIZONTAL SCALE: 1"=40'
VERTICAL SCALE: 1"=4'

ELEV. LEGEND
EXIST. = 0.0'
PCL = 0.00'

REVISIONS					
NO.	DATE	DESCRIPTION	NO.	DATE	DESCRIPTION

Kimley-Horn
 © 2023 KIMLEY-HORN AND ASSOCIATES, INC.
 MOHAMMAD A. ANSARI, P.E.
 P.E. LICENSE NO. 89933
 1700 SE 17TH STREET, SUITE 200, Ocala, FL 34471
 PHONE: 352-438-3300, REGISTRY: 35138







BOARD OF COUNTY COMMISSIONERS
 MARION COUNTY, FLORIDA
 OFFICE OF THE COUNTY ENGINEER
 412 SE 25TH AVENUE
 Ocala, FL 34471

SW 80TH AVE SEGMENT 1A
 ROADWAY PLAN AND PROFILE


SHEET
 25

THE OFFICIAL RECORD OF THIS SHEET, THE ELECTRONIC FILED DIGITALLY SIGNED AND IMPRINTED DRAWING FILES SHALL PREVAIL.

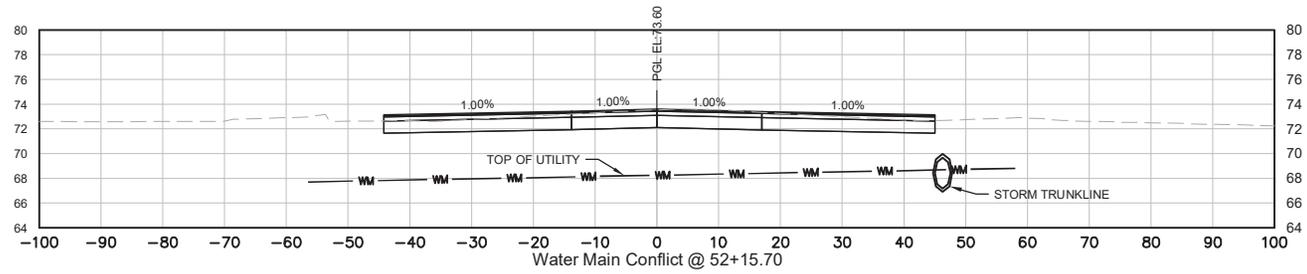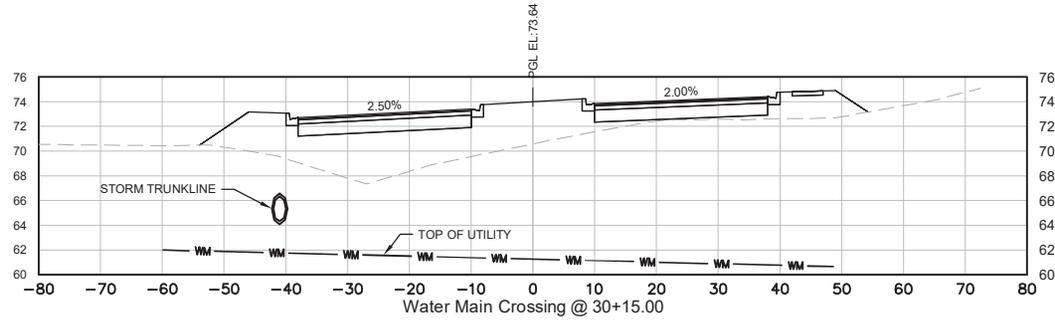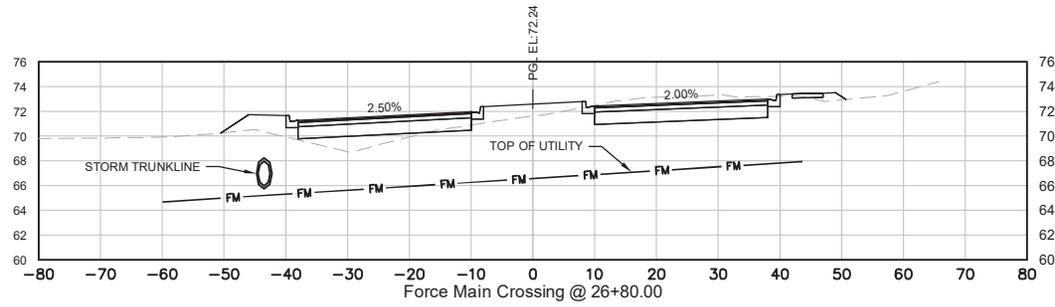

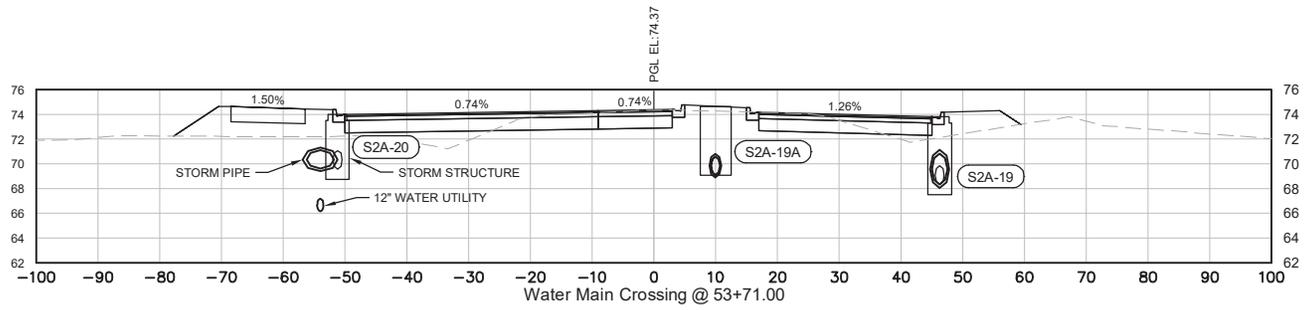

SW 80TH AVE

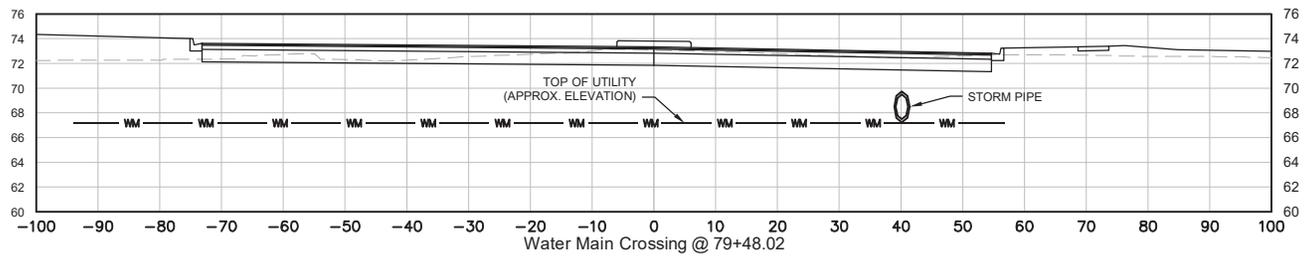

SW 80TH ST